

O.D.O.T. DISTRICT 2 SURVEY OFFICE (USE ONLY)

PERSONNEL

REFERENCE NO. 6A

SHEET 14 OF 28

NOTES ASTON

DATE 4/22/2024

ROUTE SR 105

H.C. MILLER

WEATHER BREEZY

COUNTY WOOD

R.C. NIESE

TEMP. 30°

TOWNSHIP CENTER

SECTION 22

DWG BY _____ PID NO PID

T 5 N R 11 E

TYPE MONUMENT MAG/ WASHER

ON SURFACE - BELOW ON

OFFSET Q PAVEMENT 0.7' ~~LT~~ : RT

9.5' TO RT EDGE PAVEMENT


STATION: 121+11

HORIZ.DATUM: LDP:WOOD

GEOID: 18


GRID: NORTHING: 625224.776

EASTING: 1672576.407

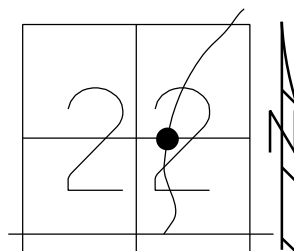

LDP
N: 447332.9
E: 183716.6

RECORD:
ORIGIN UNKNOWN
FD BOAT SPIKE
2" DOWN
4/15/02, MB
SET P.K./WASHER
6/12/02, DCH
FD P.K.NAIL
REF A6
6/2/16, JFO
SET 1" MAG/WASHER
NEW REF A6
6/20/17, JFO
FD 1" MAG/W
REF 6A
4-22-24, TDN

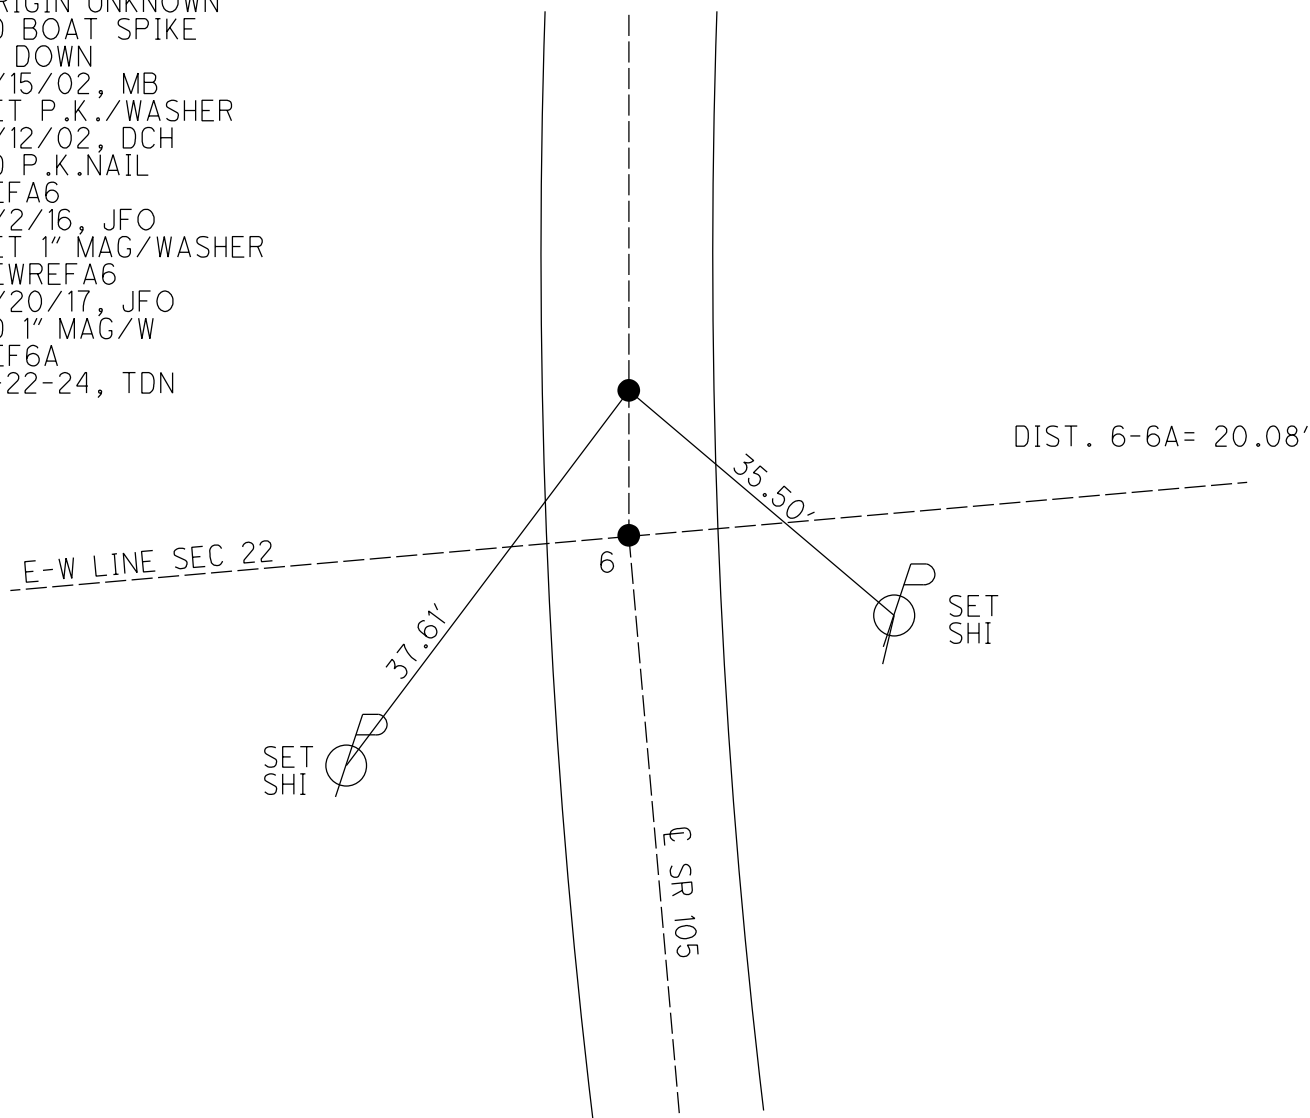

O.D.O.T. DISTRICT 2 SURVEY OFFICE (USE ONLY)

PERSONNEL	REFERENCE NO. <u>6 A</u>	SHEET <u>14</u> OF <u>28</u>
NOTES <u>RHOADES</u>	DATE <u>9/9/16</u>	ROUTE <u>SR 105</u>
H.C. <u>O'DONNELL</u>	WEATHER <u>CLOUDY</u>	COUNTY <u>WOOD</u>
R.C. <u>RHOADES</u>	TEMP. <u>82°</u>	TOWNSHIP <u>CENTER</u>
		SECTION <u>22</u>
		T <u>5</u> N R <u>11</u> E

TYPE MONUMENT P.K./WASHER


~~ON SURFACE~~ - BELOW ON

~~LEFT~~ - Q PAV'T - RIGHT 0.7'


9.5' TO RT EDGE PAVEMENT

S.L.M. 121+11

GRID: NORTHING: 625224.776 EASTING: 1672576.407

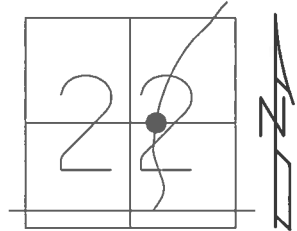


RECORD:
 ORIGIN UNKNOWN
 FD BOAT SPIKE
 2" DOWN
 4/15/02, MB
 SET P.K./WASHER
 6/12/02, DCH
 FD P.K.NAIL
 REFA6
 6/2/16, JFO
 SET 1" MAG/WASHER
 NEWREFA6
 6/20/17, JFO

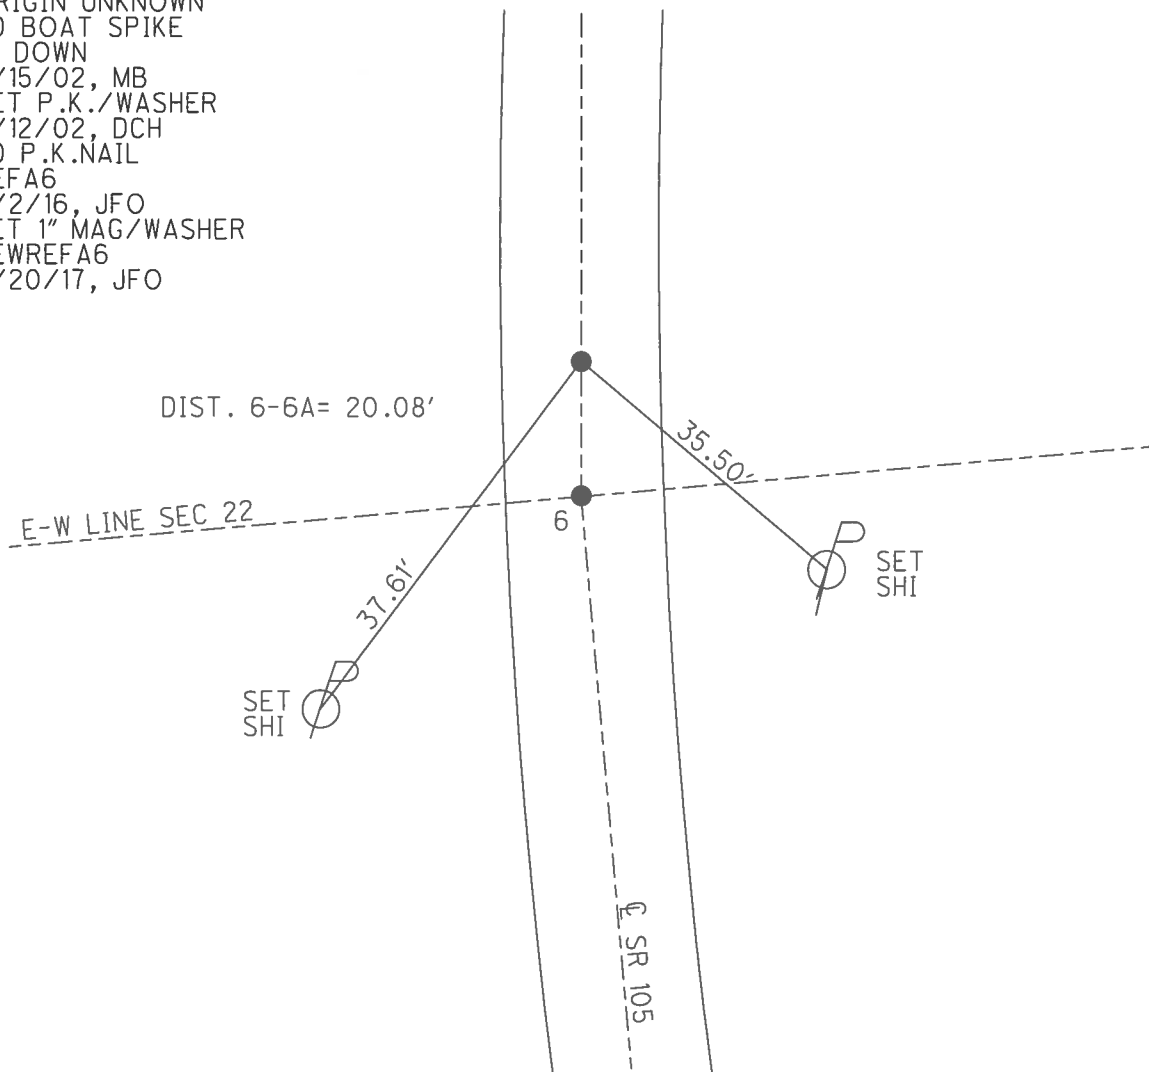

O.D.O.T. DISTRICT 2 SURVEY OFFICE (USE ONLY)


PERSONNEL	REFERENCE NO. <u>6A</u>	SHEET <u>14</u> OF <u>21</u>
NOTES	DATE <u>4/15/02</u>	ROUTE <u>SR 105</u>
H.C. <u>MOSER</u>	WEATHER <u>CLEAR</u>	COUNTY <u>WOOD</u>
R.C. <u>CANTERBURY</u>	TEMP. <u>65°</u>	TOWNSHIP <u>CENTER</u>
		SECTION <u>22</u>
		T <u>5</u> N R <u>11</u> E

TYPE MONUMENT BOAT SPIKE
~~ON SURFACE~~ - BELOW 2"
~~LEFT~~ - Q PAV'T - RIGHT 0.7'
9.5' TO RT EDGE PAVEMENT
 S.L.M. 121+11

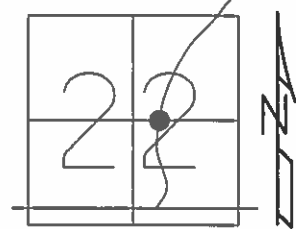

GRID: NORTHING: _____ EASTING: _____

RECORD:
 ORIGIN UNKNOWN
 FD BOAT SPIKE
 2" DOWN
 SET P.K./WASHER
 6/12/02, DCH

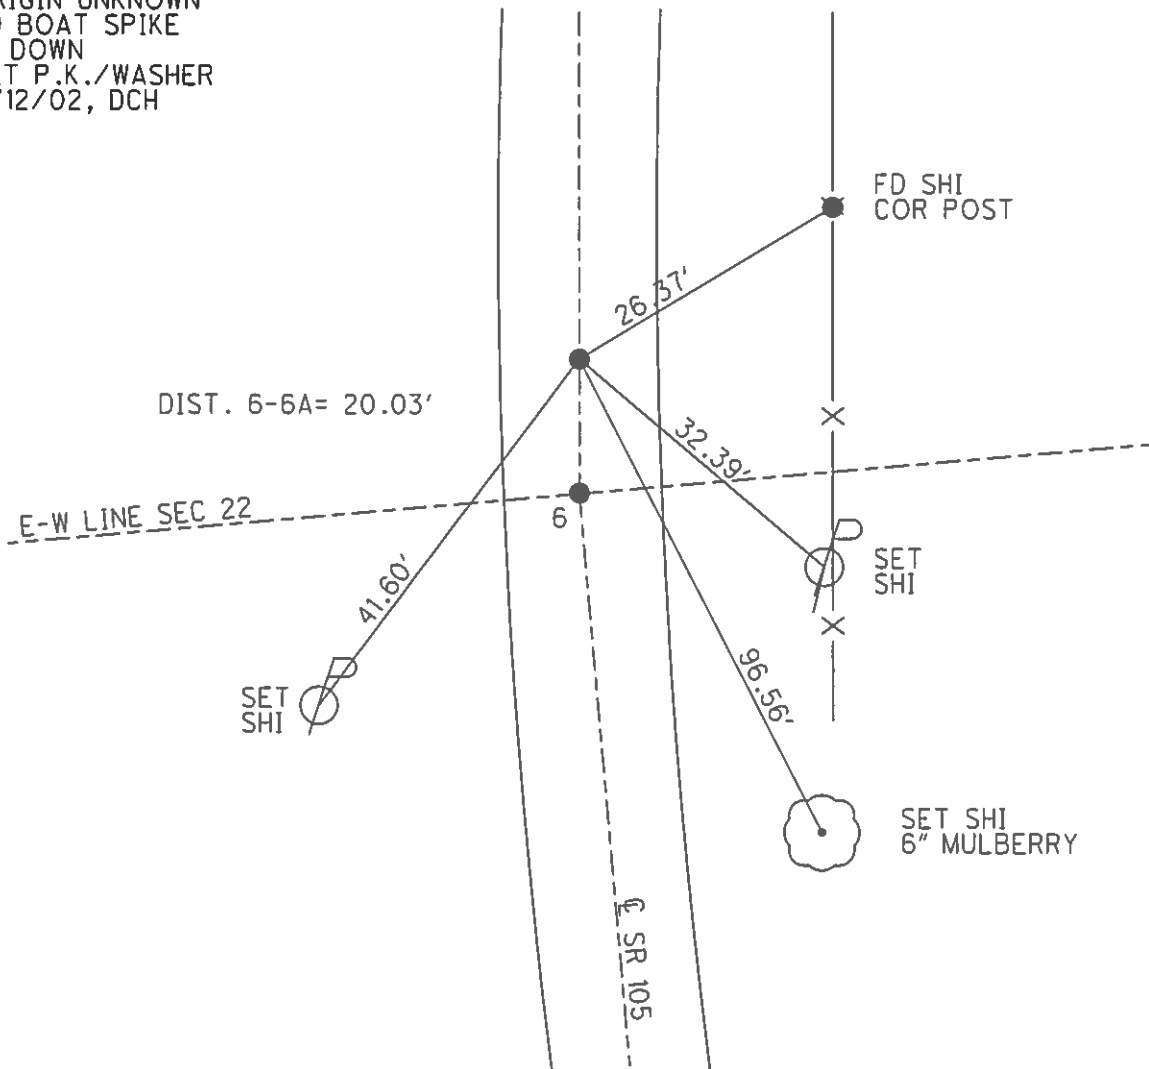

O.D.O.T. DISTRICT 2 SURVEY OFFICE

PERSONNEL

REFERENCE NO. 6

SHEET 11 OF 57

NOTES LONG

H.C. VAN DUSEN

R.C. _____

DATE 8-15-91

WEATHER CLEAR

TEMP. 85°

ROUTE 105

COUNTY WOOD

TOWNSHIP CENTER

SECTION 22

T 5 N R 11 E


TYPE MONUMENT P.K.'s & WASHER'S

ON SURFACE BELOW YES

LEFT - C PAV'T. - RIGHT 0.7' PT 1.0' B"

9.5 TO RT EDGE PAVEMENT

S.L.M. 120+91

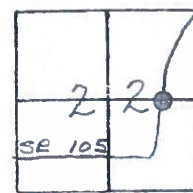


SET PK & WASHER
4-8-92
BVD

POINT "B"
ORIGINAL UNKNOWN
POSSIBLE OFFSET


A=6
B=6A

RECORD
PI.#5
121+36.38
 $\Delta = 1^{\circ} 54' 00''$ RT

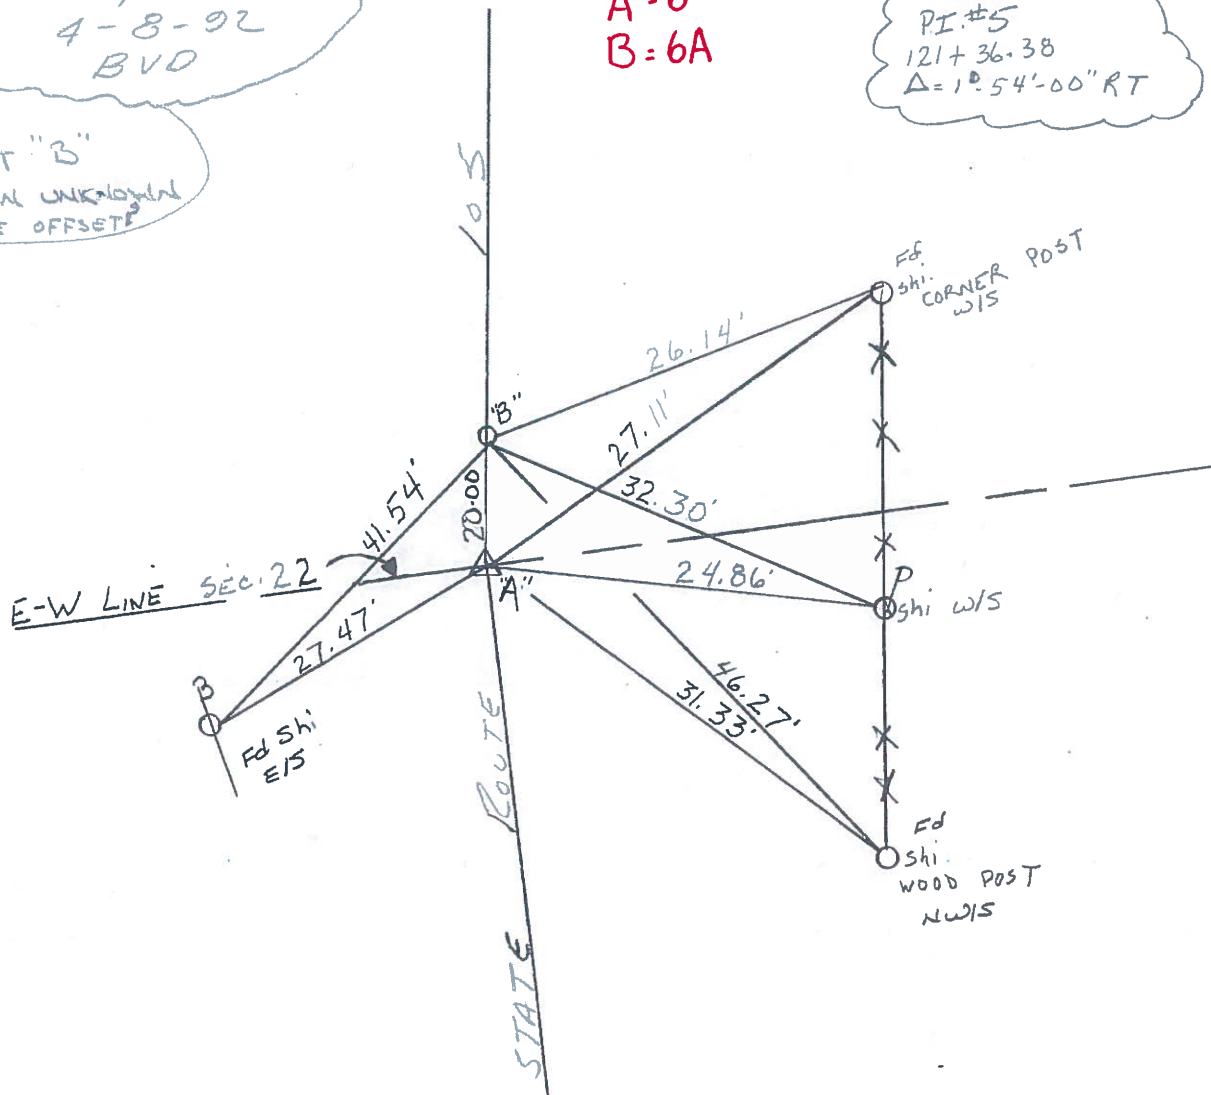

County WOOD S.R. 105Township CENTERSection 22T N, R EPersonnel HOFFMANHOUSEHOLDERLOEHRKE

#6

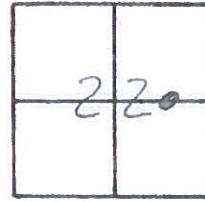Date 4-19-82Weather CLEARTemp. +65°

P.I. #5

121+36.38

 $\Delta = 10.54' - 00''$ RT.PT. "A" - SET P.K. / WASHER
5-24-82 S.W.H.DID NOT RESET PT. "B"
BELIEVE IT TO BE AN
OFFSET LINEA = 6
B = 6A