

O.D.O.T. DISTRICT 2 SURVEY OFFICE (USE ONLY)

PERSONNEL

REFERENCE NO. 9

SHEET 20 OF 28

NOTES ASTON

DATE 4/22/2024

ROUTE SR 105

H.C. MILLER

WEATHER BREEZY

COUNTY WOOD

R.C. NIESE

TEMP. 30°

TOWNSHIP CENTER

SECTION 22

DWG BY _____ PID NO PID

T 5 N R 11 E

TYPE MONUMENT IPIPE

ON SURFACE - BELOW 18"

OFFSET $\varnothing$ PAVEMENT 44.2' LT : ~~RT~~

_____ TO _____ EDGE PAVEMENT


STATION: 139.05

HORZ.DATUM: LDP:WOOD

GEOID: 18


GRID: NORTHING: _____

EASTING: _____

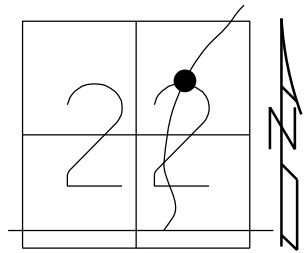

LDP
N: 448956.2
E: 184486.0


RECORD: P.I.
STA. 139+52.87
 $\Delta = 41^{\circ} 35' 40''$ RT
FD 1.5" IPIPE
18" DOWN
D.N.F.
6/2/16, JFO
FD IPIPE
18" DOWN
4-22-24, JAM

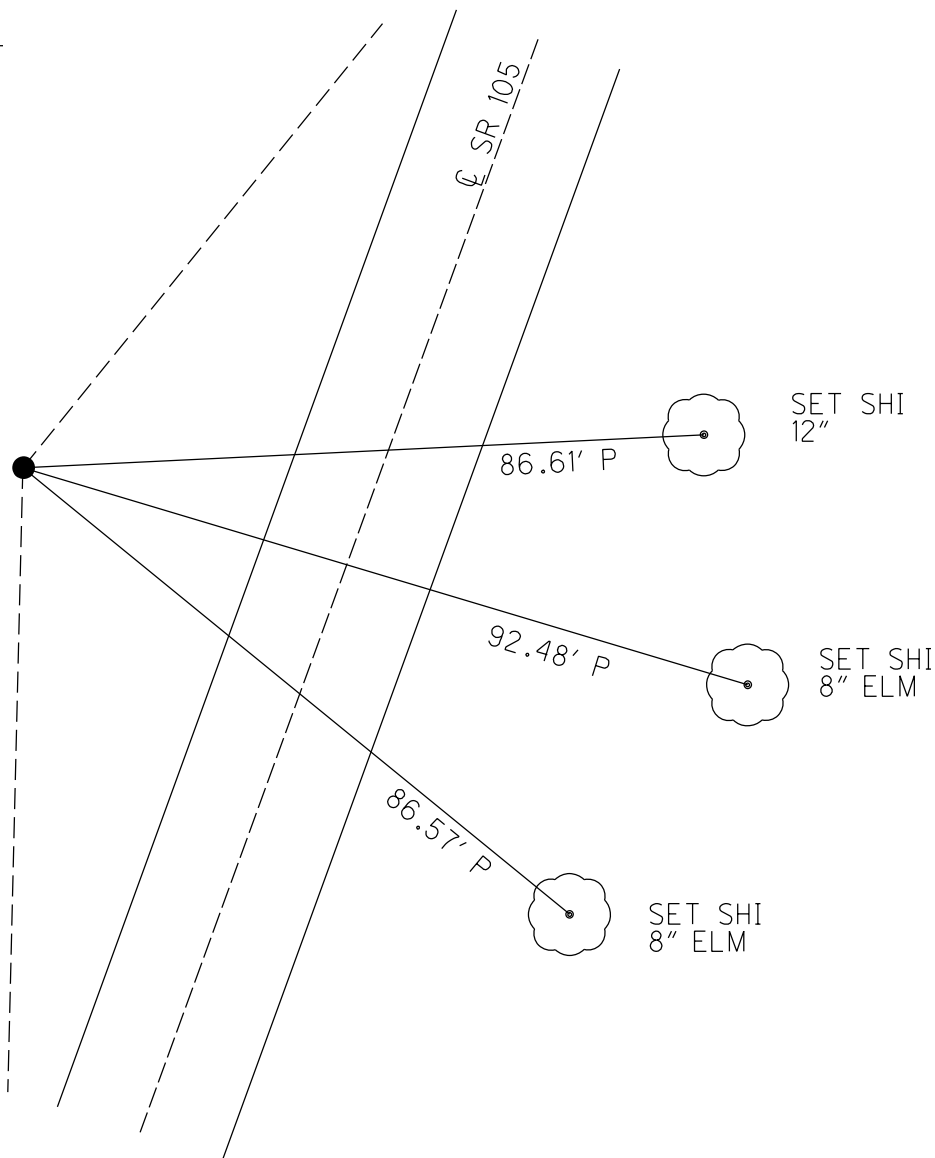


O.D.O.T. DISTRICT 2 SURVEY OFFICE (USE ONLY)

PERSONNEL _____ REFERENCE NO. 9 SHEET 17 OF 28
 NOTES BARNHISEL DATE 8/19/91 ROUTE SR 105
 H.C. VAN DUSEN WEATHER CLOUDY COUNTY WOOD
 R.C. BARNHISEL TEMP. 70° TOWNSHIP CENTER
 SECTION 22
 T 5 N R 11 E

TYPE MONUMENT IPIPE
~~ON SURFACE~~ - BELOW 18"
 LEFT - CL PAV'T - ~~RIGHT~~ 44.2'
 - TO - EDGE PAVEMENT
 S.L.M. 139+05

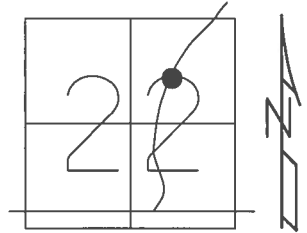


RECORD: P.I.
 STA. 139+52.87
 $\Delta = 41^\circ 35' 40''$ RT
 FD 1.5" IPIPE
 18" DOWN
 D.N.F.
 6/2/16, JFO

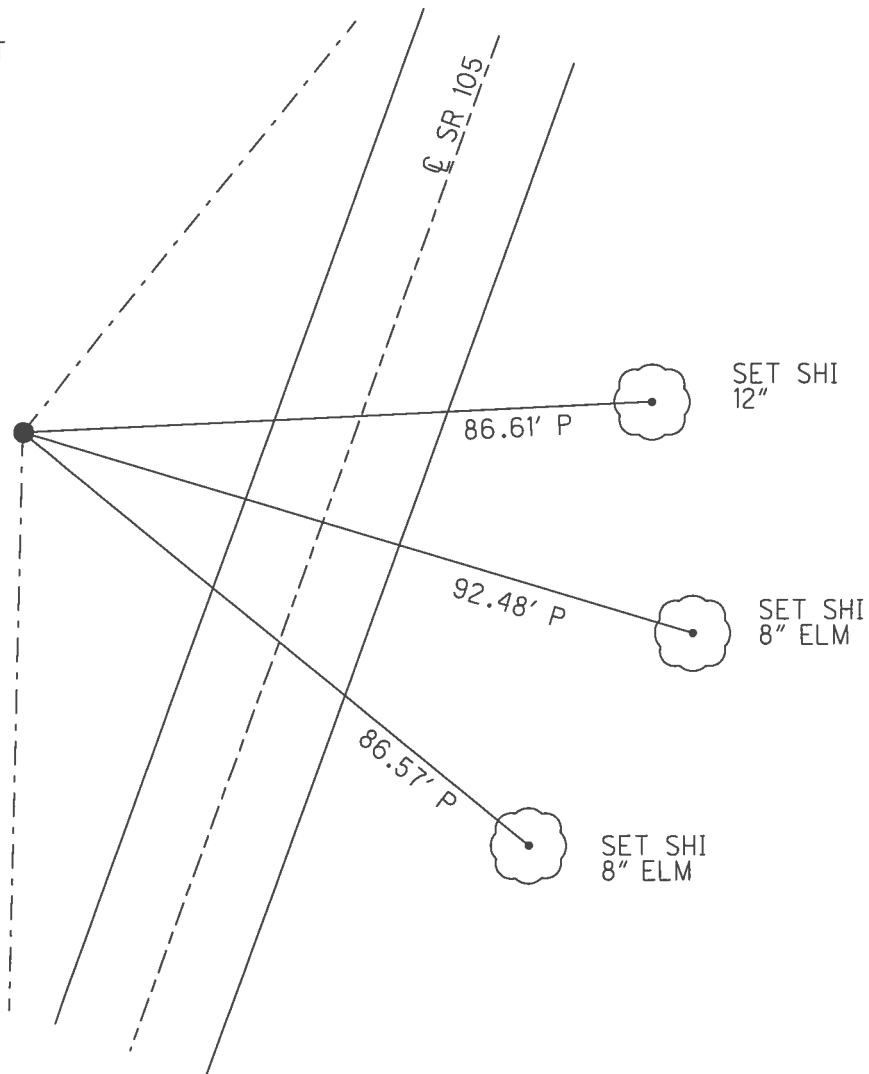

O.D.O.T. DISTRICT 2 SURVEY OFFICE (USE ONLY)


PERSONNEL	REFERENCE NO. <u>9</u>	SHEET <u>17</u> OF <u>21</u>
NOTES <u>BARNHISEL</u>	DATE <u>8/19/91</u>	ROUTE <u>SR 105</u>
H.C. <u>VAN DUSEN</u>	WEATHER <u>CLOUDY</u>	COUNTY <u>WOOD</u>
R.C. <u>BARNHISEL</u>	TEMP. <u>70°</u>	TOWNSHIP <u>CENTER</u>
		SECTION <u>22</u>
		T <u>5</u> N R <u>11</u> E

TYPE MONUMENT IPIPE
~~ON SURFACE~~ - BELOW 18"
 LEFT - ℄ PAV'T - ~~RIGHT~~ 44.2'
 - TO - EDGE PAVEMENT
 S.L.M. 139+05

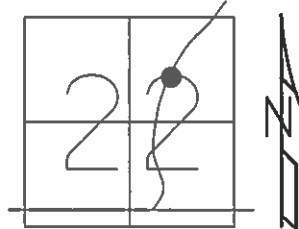

GRID: NORTHING: _____ EASTING: _____

RECORD: P.I.
 STA. 139+52.87
 $\Delta = 41^\circ 35' 40''$ RT
 FD 1.5" IPIPE
 18" DOWN

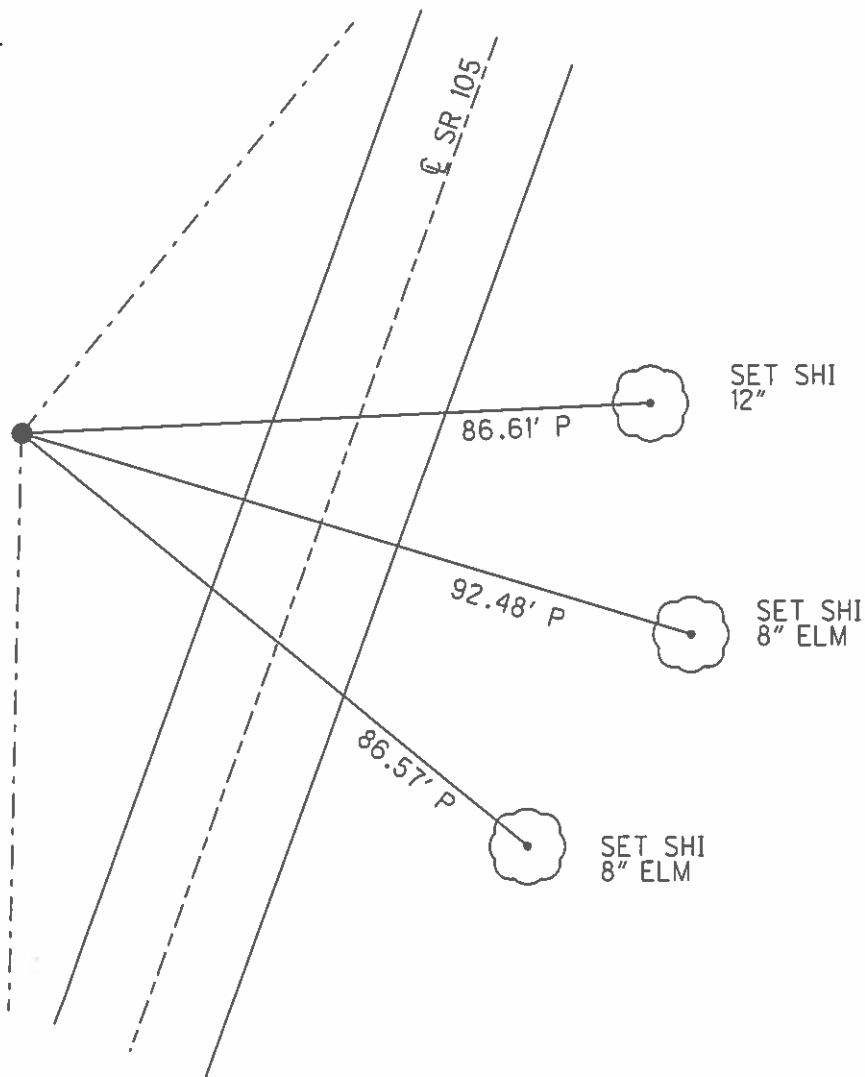

O.D.O.T. DISTRICT 2 SURVEY OFFICE

PERSONNEL

REFERENCE NO. 9

SHEET 14 OF 57

NOTES BARNHISEL

H.C. VAN DUSEN

R.C. BARNHISEL

DATE 8-19-91

WEATHER cloudy

TEMP. +70°

ROUTE 105

COUNTY WOOD

TOWNSHIP CENTER

SECTION 22

T. 5 N R. 11 E


TYPE MONUMENT IRON PIPE

~~ON~~ SURFACE - BELOW 18"

LEFT- & PAV'T. - ~~RIGHT~~ 44.2'

— TO — EDGE PAVEMENT

S.L.M. 139+05

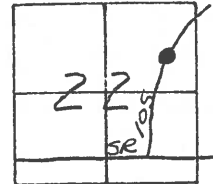

RECORD:


P.I. #8

STA: 139+52.87

$\Delta = 41^\circ - 35' - 40''$ RT

1 1/2" IRON PIPE

18" DOWN

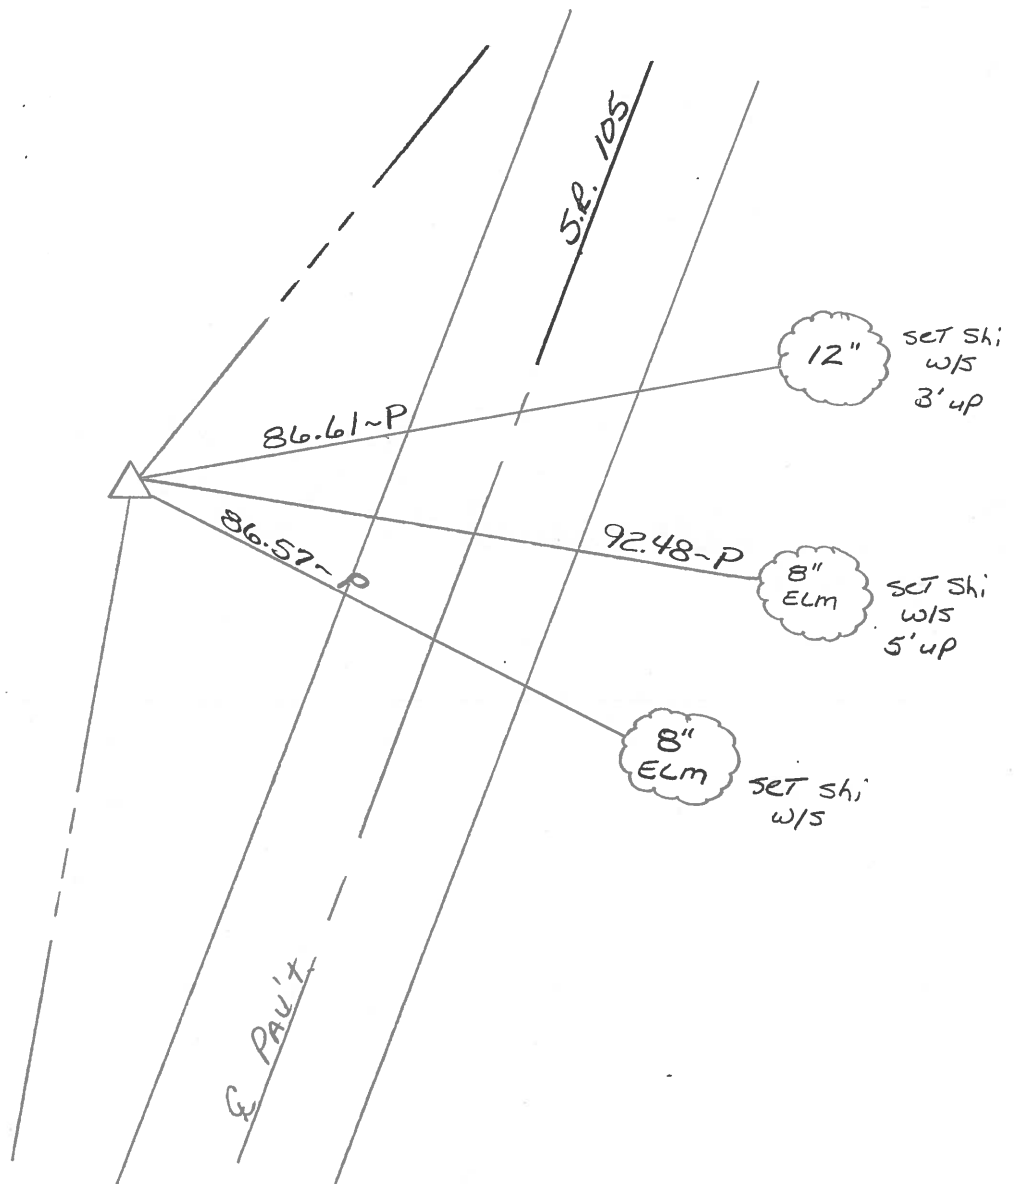

Q.D.O.T. DISTRICT 2 SURVEY OFFICE

SHEET _____ OF _____

County WOOD S.R. 105

Date 4-19-82

Township CENTER

Weather CLEAR

Section 22

Temp. +65°


T, N, R E

Personnel HOFFMAN

LOEHRKE

HOUSEHOLDER


#9

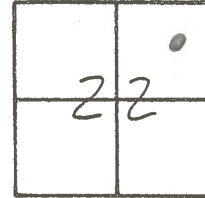

P.I. #8

139+52.87

$\Delta = 41^{\circ}-35'-40''$ RT.

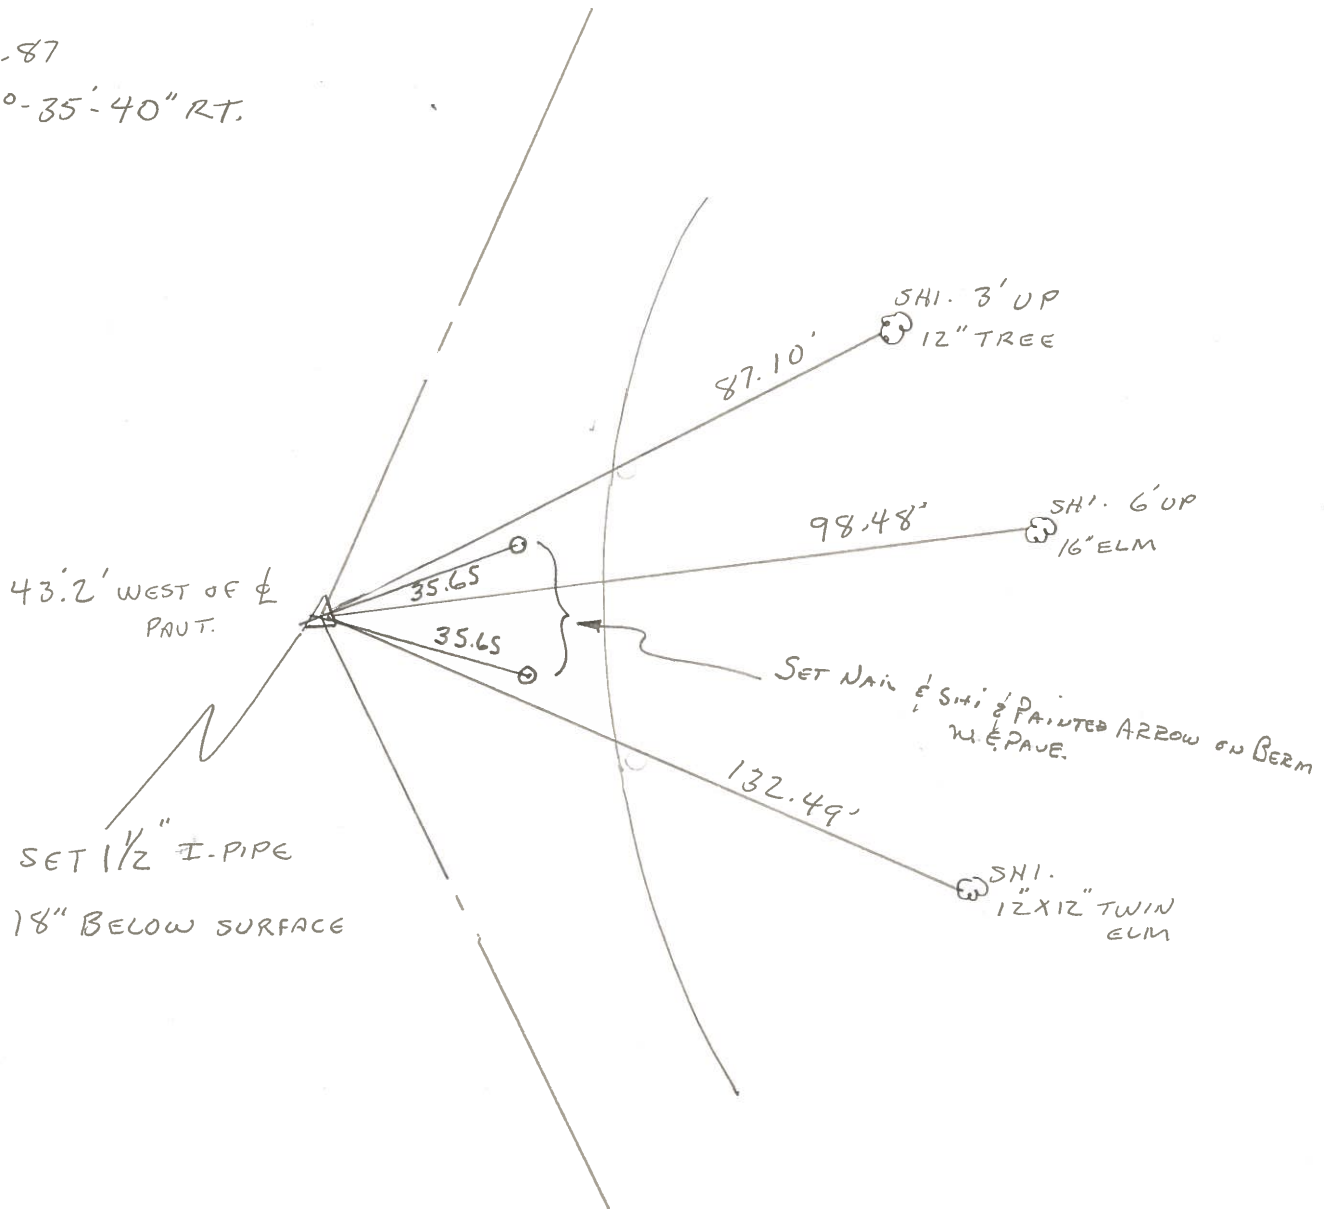

PERSONNEL	TITLE	PERSONNEL	TITLE	COUNTY	DATE	WEATHER	TEMP.
Stone	Notes			Wood	28 Aug. 72	Warm	80°
Drano	H.C.			S. R. 105			
Curtis	R.C.			SEC. 22			
Branner	As						

DESCRIPTION	References to Control Points	JOB NO.
	LEFT CENTER LINE RIGHT	

