

O.D.O.T. DISTRICT 2 SURVEY OFFICE (USE ONLY)

PERSONNEL

REFERENCE NO. 10

SHEET 21 OF 28

NOTES ASTON

DATE 4/22/2024

ROUTE SR 105

H.C. MILLER

WEATHER BREEZY

COUNTY WOOD

R.C. NIESE

TEMP. 30°

TOWNSHIP CENTER

SECTION 22

DWG BY _____ PID NO PID

T 5 N R 11 E

TYPE MONUMENT MAG/ WASHER

ON SURFACE - BELOW ON

OFFSET Q PAVEMENT 6.3' LT : RT

3.4' TO RT EDGE PAVEMENT


STATION: 143+51

HORIZ.DATUM: LDP:WOOD

GEOID: 18


GRID: NORTHING: 627011.679

EASTING: 1673797.642

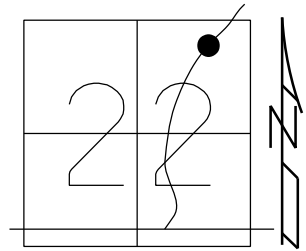

LDP
N: 449135.8
E: 184914.3


RECORD: P.I.
STA. 144+17.20
 $\Delta = 16^{\circ} 36' 20''$ LT
FD P.K./WASHER
4/15/02, MB
SET P.K./WASHER
6/12/02, DCH
FD P.K./WASHER
4" DOWN
REF10
6/2/16, JFO
SET MAG/WASHER
NEWREF10
10/5/19, JFO
FD MAG/W
REF10
4-22-24, TDN

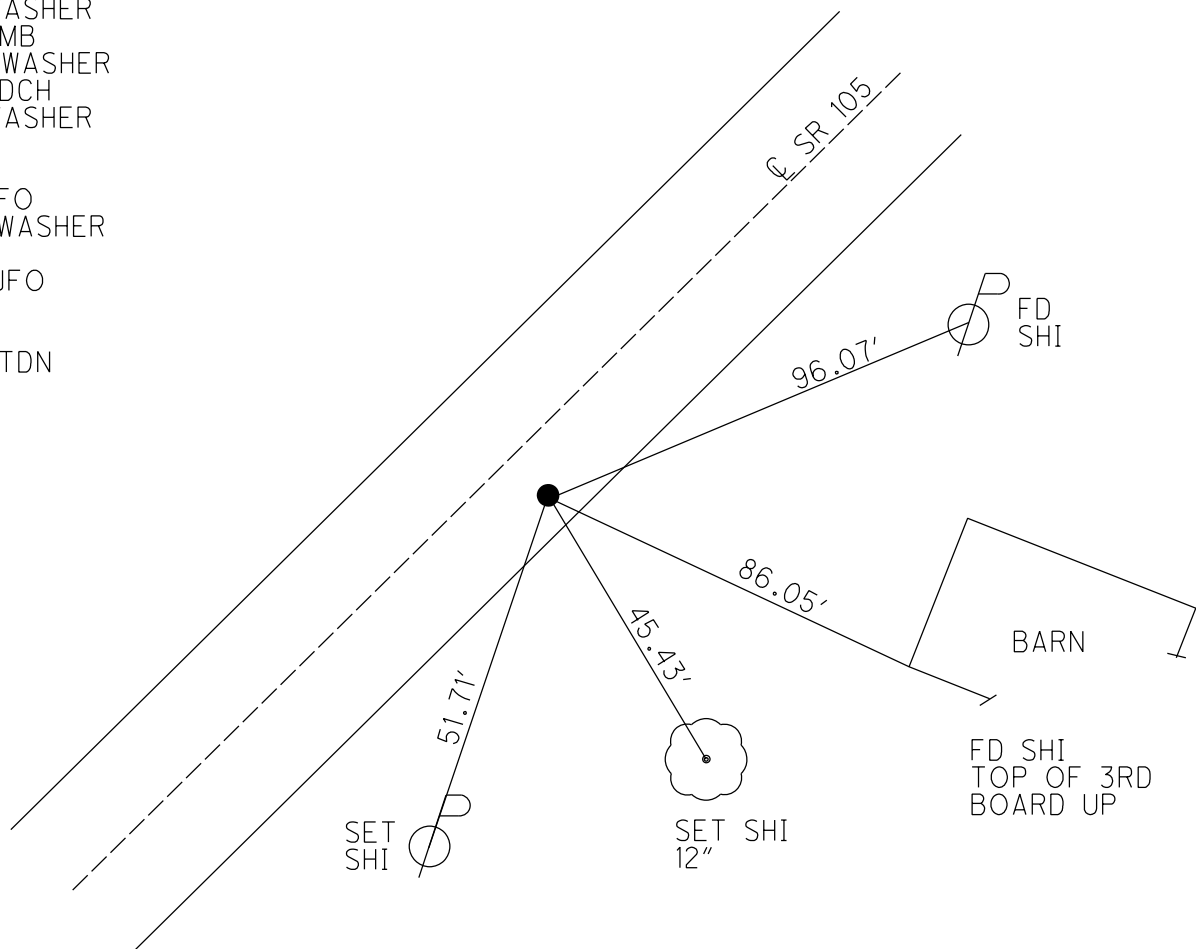

O.D.O.T. DISTRICT 2 SURVEY OFFICE (USE ONLY)


PERSONNEL	REFERENCE NO. <u>10</u>	SHEET <u>18</u> OF <u>28</u>
NOTES	DATE <u>9/12/16</u>	ROUTE <u>SR 105</u>
H.C. <u>RHOADES</u>	WEATHER <u>SUNNY</u>	COUNTY <u>WOOD</u>
R.C. <u>RHOADES</u>	TEMP. <u>55°</u>	TOWNSHIP <u>CENTER</u>
		SECTION <u>22</u>
		<u>T 5 N R 11 E</u>

TYPE MONUMENT P.K./WASHER
 ON SURFACE - ~~BELOW~~ ON
~~LEFT~~ - C PAV'T - RIGHT 6.3'
3.4' TO RT EDGE PAVEMENT
 S.L.M. 143+51

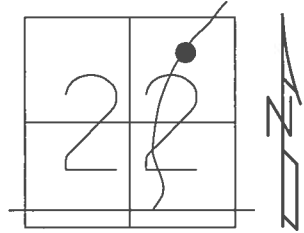

GRID: NORTHING: 627011.679 EASTING: 1673797.642


RECORD: P.I.
 STA. 144+17.20
 $\Delta = 16^\circ 36' 20''$ LT
 FD P.K./WASHER
 4/15/02, MB
 SET P.K./WASHER
 6/12/02, DCH
 FD P.K./WASHER
 4" DOWN
 REF10
 6/2/16, JFO
 SET MAG/WASHER
 NEWREF10
 10/5/19, JFO

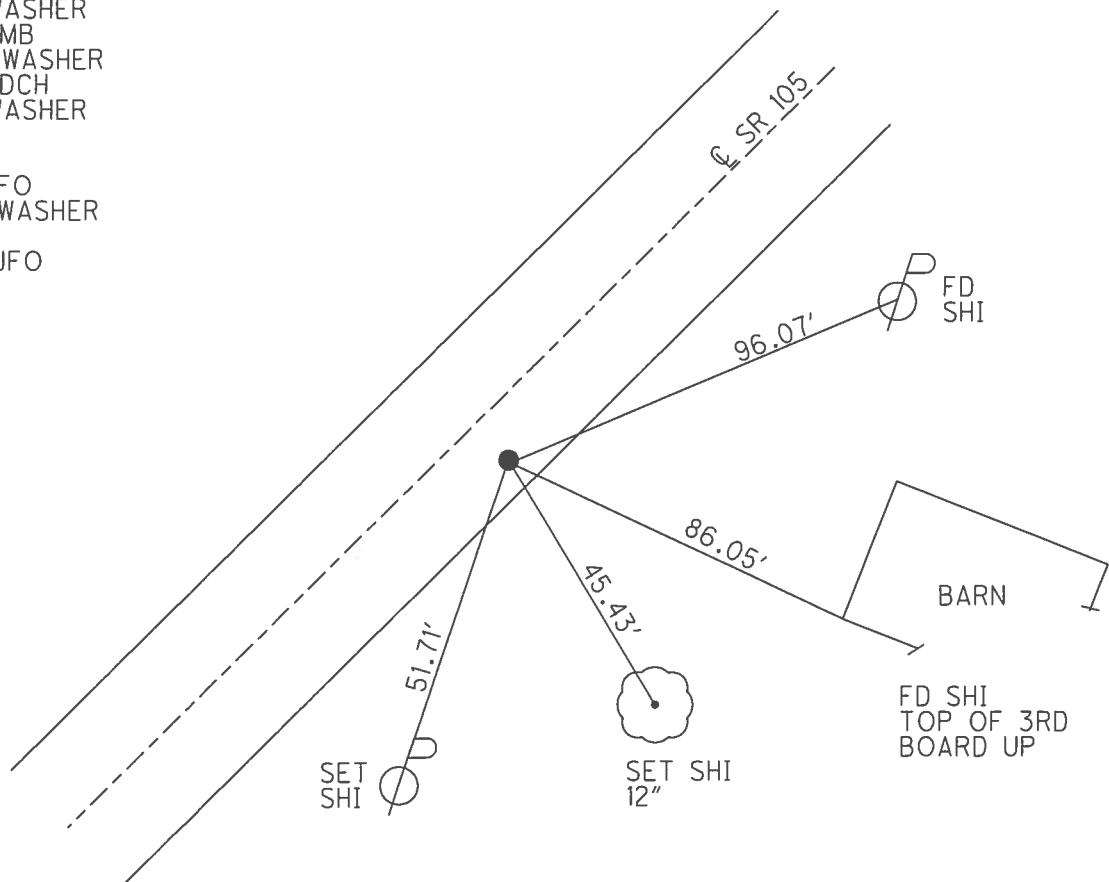


O.D.O.T. DISTRICT 2 SURVEY OFFICE (USE ONLY)

PERSONNEL _____ REFERENCE NO. 10 SHEET 18 OF 21
 NOTES MOSER DATE 4/15/02 ROUTE SR 105
 H.C. CANTERBURY WEATHER SUNNY COUNTY WOOD
 R.C. BARNHISEL TEMP. 70° TOWNSHIP CENTER
 SECTION 22
 T 5 N R 11 E

TYPE MONUMENT P.K./WASHER
 ON SURFACE - ~~BELOW~~ ON
~~LEFT~~ - Q PAV'T - RIGHT 6.3'
3.4' TO RT EDGE PAVEMENT
 S.L.M. 143+51
 GRID: NORTHING: _____ EASTING: _____

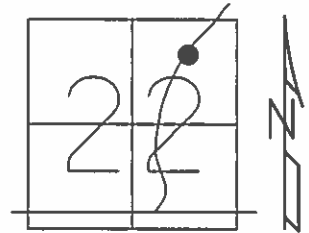

RECORD: P.I.
 STA. 144+17.20
 $\Delta = 16^{\circ} 36' 20''$ LT
 SET P.K./WASHER
 6/12/02, DCH

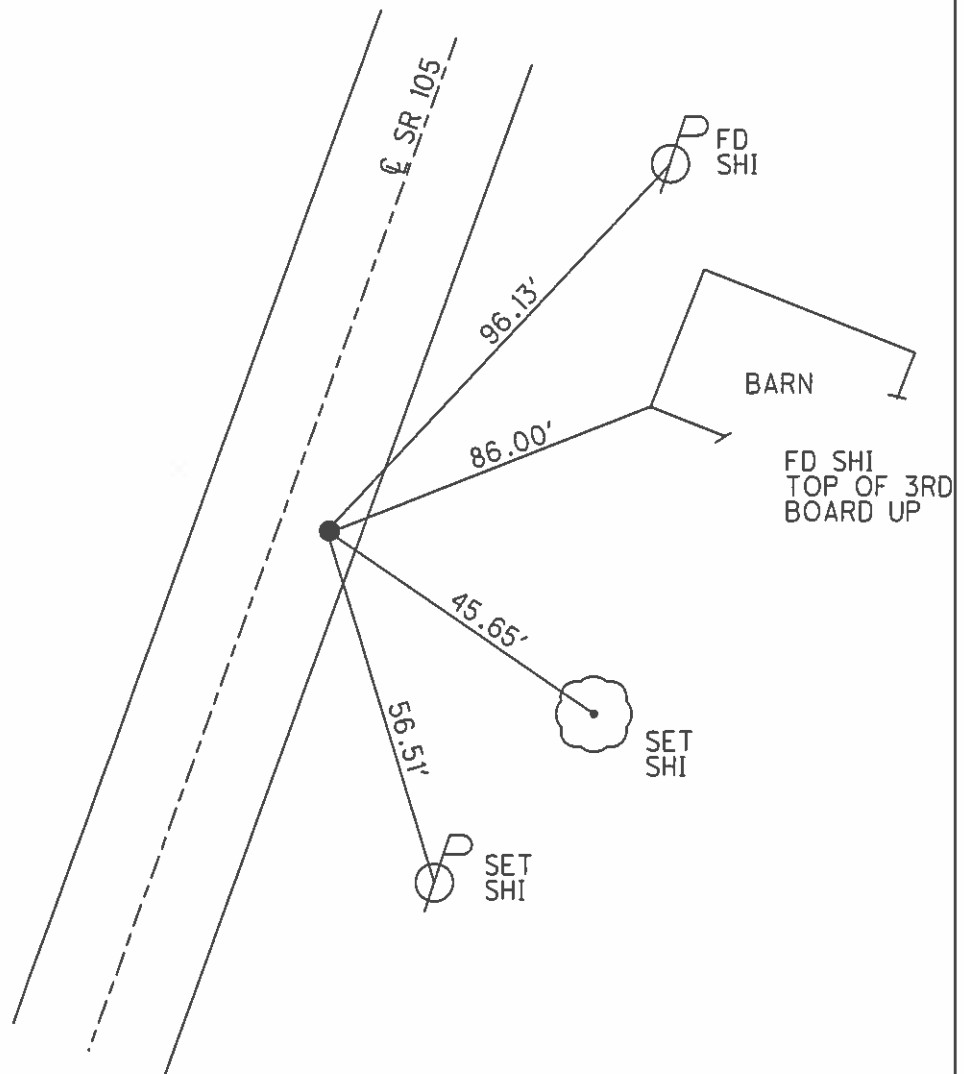

O.D.O.T. DISTRICT 2 SURVEY OFFICE

PERSONNEL

REFERENCE NO. 10

SHEET 15 OF 57

NOTES BARNHISEL

H.C. VAN DUSEN

R.C. BARNHISEL

DATE 8-19-91

WEATHER Cloudy

TEMP. +70°

ROUTE 105

COUNTY WOOD

TOWNSHIP CENTER

SECTION 22

T. 5 N R. 11 E


TYPE MONUMENT PK & WASHER

ON SURFACE - BELOW YES

~~LEFT~~ - & PAV'T. - RIGHT 6.0

4.5 TO RT EDGE PAVEMENT

S.L.M. 143+51

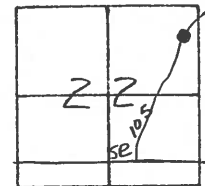

RECORD:

P.I. # 9


STA: 144+17.20


$\Delta = 16^\circ - 36' - 20''$ LT

SET PK & WASHER

4-8-92

BUD

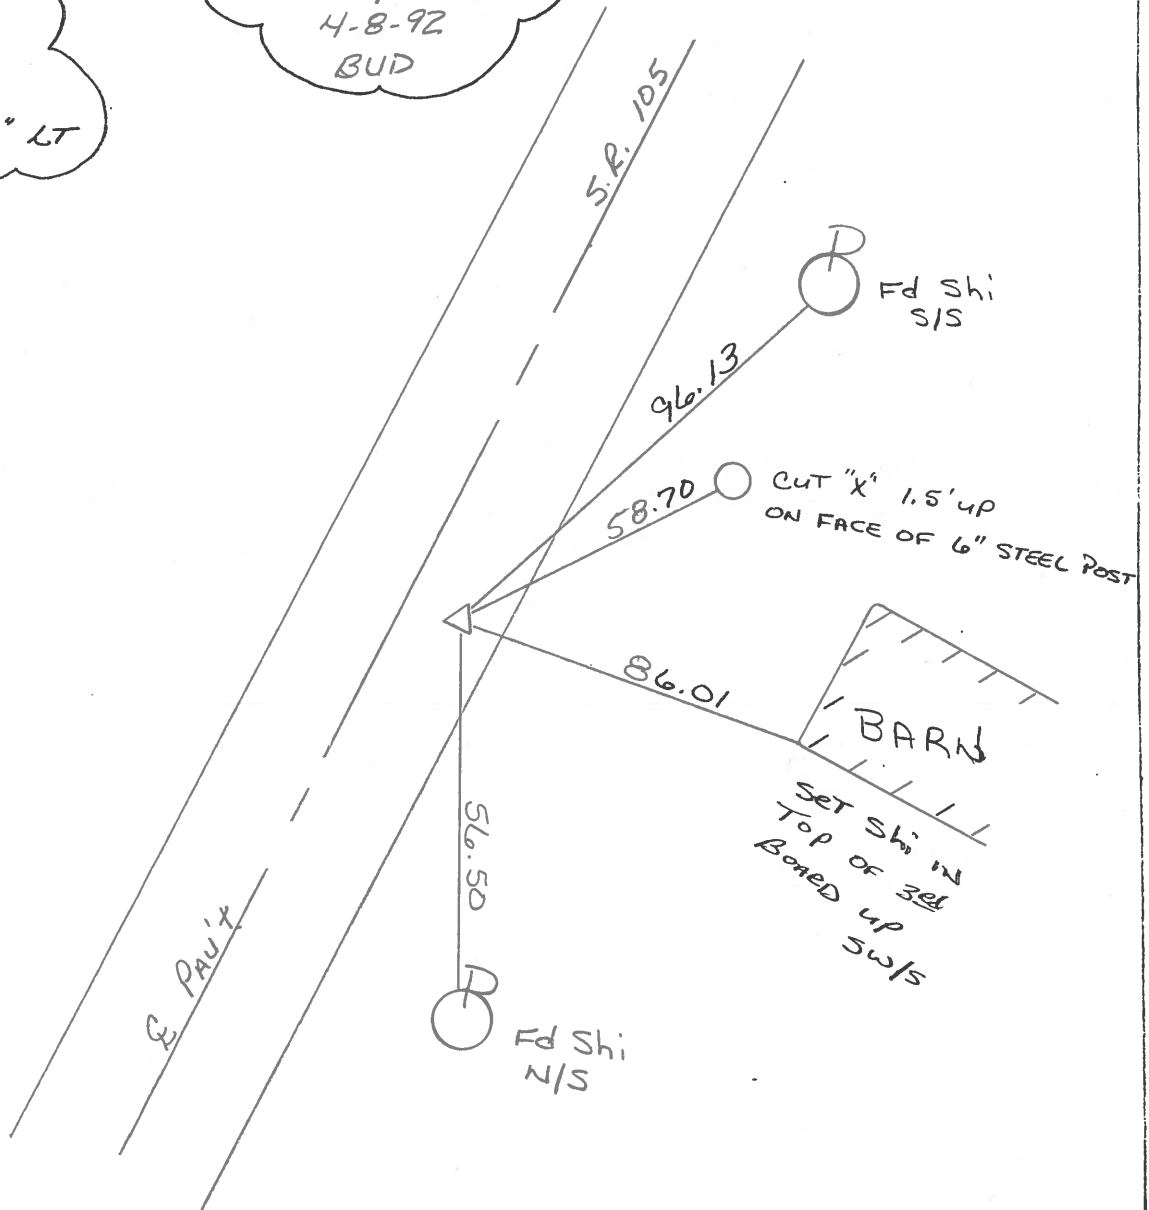

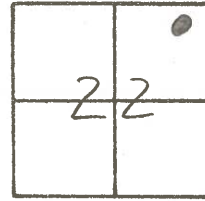County WOOD S.R. 105Township CENTERSection 22T N, R EPersonnel HOFFMANHOUSEHOLDERLOEHRKE# 10Date 4-19-82Weather CLEARTemp. +65°

P.I. #9


144+17.20

 $\Delta = 16^{\circ}-36'-20''$ LT.

SET PK/WASHER

5-24-82

S.W.H.

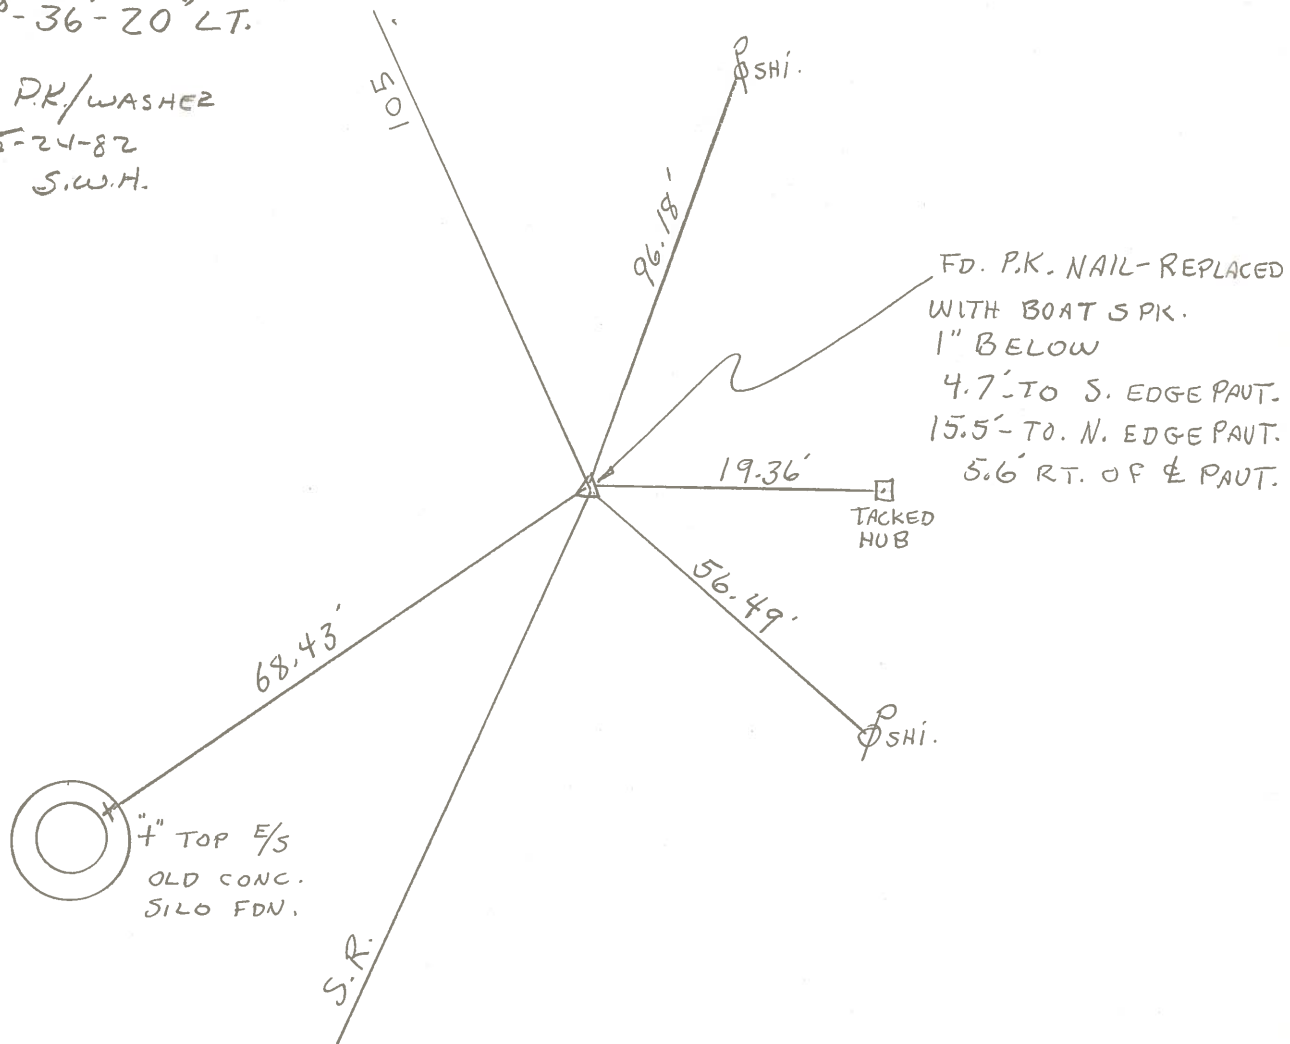

PERSONNEL	TITLE	PERSONNEL	TITLE	COUNTY	DATE
Stone	Notes			Wood	28 Aug. 72
Dennis	H.C.			S. R. 105	WEATHER Warm
Curtis	R.C.			SEC. 22	TEMP. 80°
Brannon	AS				

DESCRIPTION References to Control Points JOB NO. _____

LEFT CENTER LINE RIGHT

