

O.D.O.T. DISTRICT 2 SURVEY OFFICE (USE ONLY)

PERSONNEL

REFERENCE NO. 11

SHEET 22 OF 28

NOTES ASTON

DATE 4/22/2024

ROUTE SR 105

H.C. MILLER

WEATHER BREEZY

COUNTY WOOD

R.C. NIESE

TEMP. 30°

TOWNSHIP CENTER

SECTION 22

DWG BY _____ PID NO PID

T 5 N R 11 E

TYPE MONUMENT MAG/ WASHER

ON SURFACE - BELOW ON

OFFSET Q PAVEMENT 11.8' ± : RT

1.5' TO RT EDGE PAVEMENT


STATION: 149+98

HORIZ.DATUM: LDP:WOOD

GEOID: 18


GRID: NORTHING: 627416.352

EASTING: 1674304.651

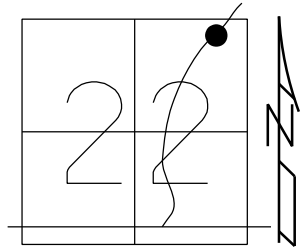

LDP
N: 449547.2
E: 185415.9


RECORD: P.I.
STA. 150+65.86
 $\Delta = 22^\circ 07' 20''$ LT
FD P.K./WASHER
4/15/02, MB
SET P.K./WASHER
5/28/02, DCH
FD P.K./WASHER
REF11
6/2/16, JFO
SET 1" MAG/WASHER
NEWREF11
6/20/17, JFO
FD MAG/W
REF11
4-22-24, TDN

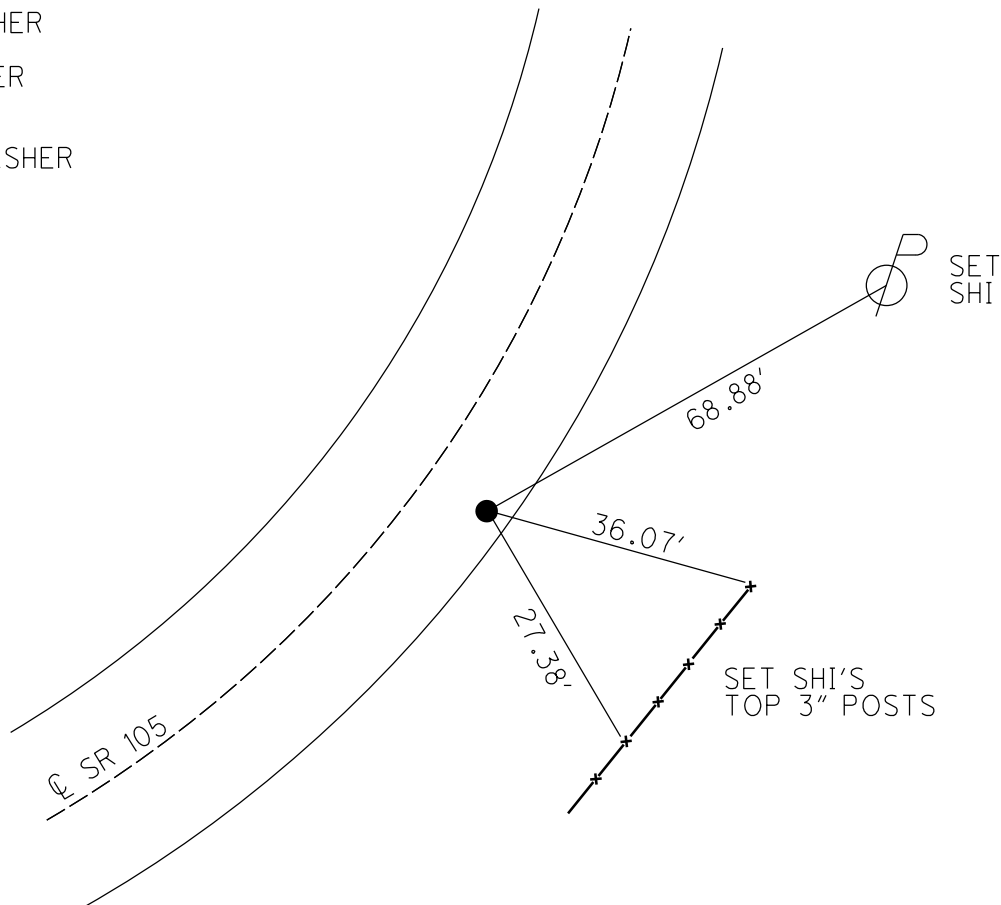

O.D.O.T. DISTRICT 2 SURVEY OFFICE (USE ONLY)


PERSONNEL	REFERENCE NO. <u>11</u>	SHEET <u>19</u> OF <u>28</u>
NOTES	DATE <u>9/12/16</u>	ROUTE <u>SR 105</u>
H.C. <u>RHOADES</u>	WEATHER <u>SUNNY</u>	COUNTY <u>WOOD</u>
R.C. <u>O'DONNELL</u>	TEMP. <u>55°</u>	TOWNSHIP <u>CENTER</u>
		SECTION <u>22</u>
		T <u>5</u> N R <u>11</u> E

TYPE MONUMENT P.K./WASHER
 ON SURFACE - ~~BELOW~~ ON
~~LEFT~~ - CL PAV'T - RIGHT 11.8'
1.5' TO RT EDGE PAVEMENT
 S.L.M. 149+98

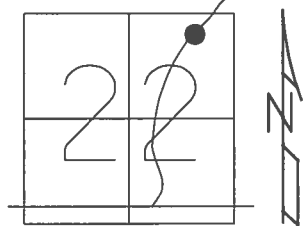

GRID: NORTHING: 627416.352 EASTING: 1674304.651


RECORD: P.I.
 STA. 150+65.86
 $\Delta = 22^\circ 07' 20''$ LT
 FD P.K./WASHER
 4/15/02, MB
 SET P.K./WASHER
 5/28/02, DCH
 FD P.K./WASHER
 REF11
 6/2/16, JFO
 SET 1" MAG/WASHER
 NEWREF11
 6/20/17, JFO

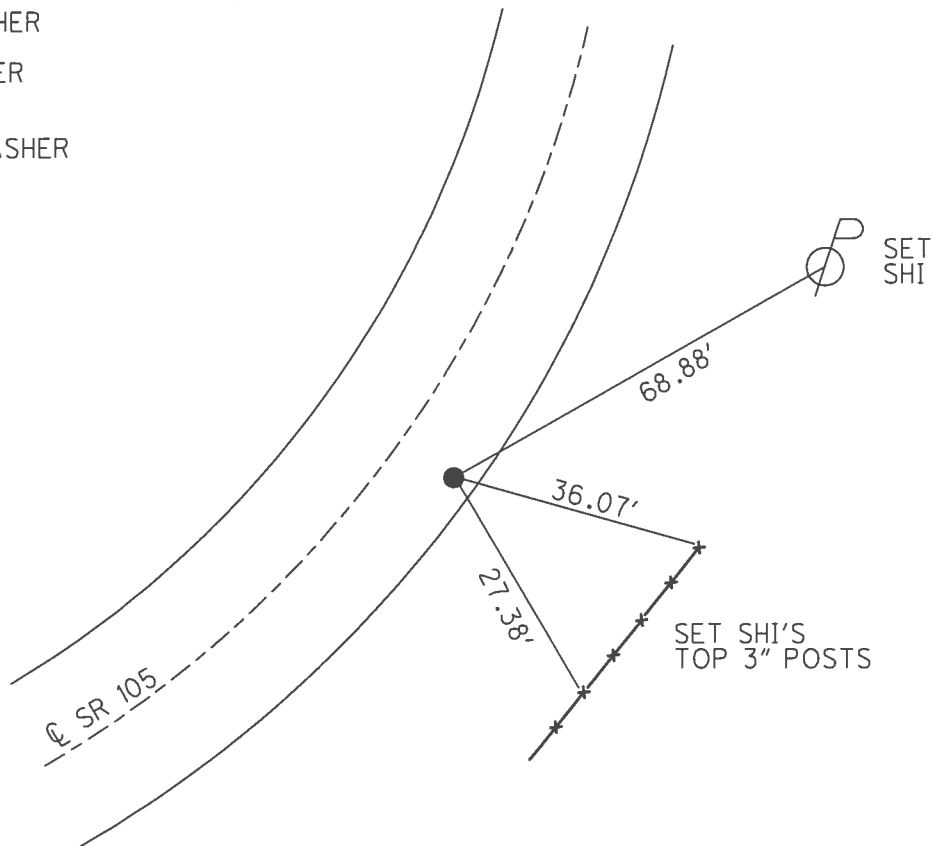

O.D.O.T. DISTRICT 2 SURVEY OFFICE (USE ONLY)


PERSONNEL	REFERENCE NO. <u>11</u>	SHEET <u>19</u> OF <u>21</u>
NOTES <u>MOSER</u>	DATE <u>4/15/02</u>	ROUTE <u>SR 105</u>
H.C. <u>CANTERBURY</u>	WEATHER <u>SUNNY</u>	COUNTY <u>WOOD</u>
R.C. <u>BARNHISEL</u>	TEMP. <u>70°</u>	TOWNSHIP <u>CENTER</u>
		SECTION <u>22</u>
		T <u>5</u> N R <u>11</u> E

TYPE MONUMENT P.K./WASHER
 ON SURFACE - ~~BELOW~~ ON
~~LEFT~~ - CL PAV'T - RIGHT 11.8'
2.1' TO RT EDGE PAVEMENT
 S.L.M. 149+98

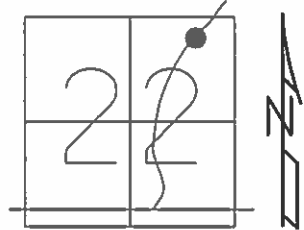

GRID: NORTHING: _____ EASTING: _____

RECORD: P.I.
 STA. 150+65.86
 $\Delta = 22^\circ 07' 20''$ LT
 SET P.K./WASHER
 5/28/02, DCH

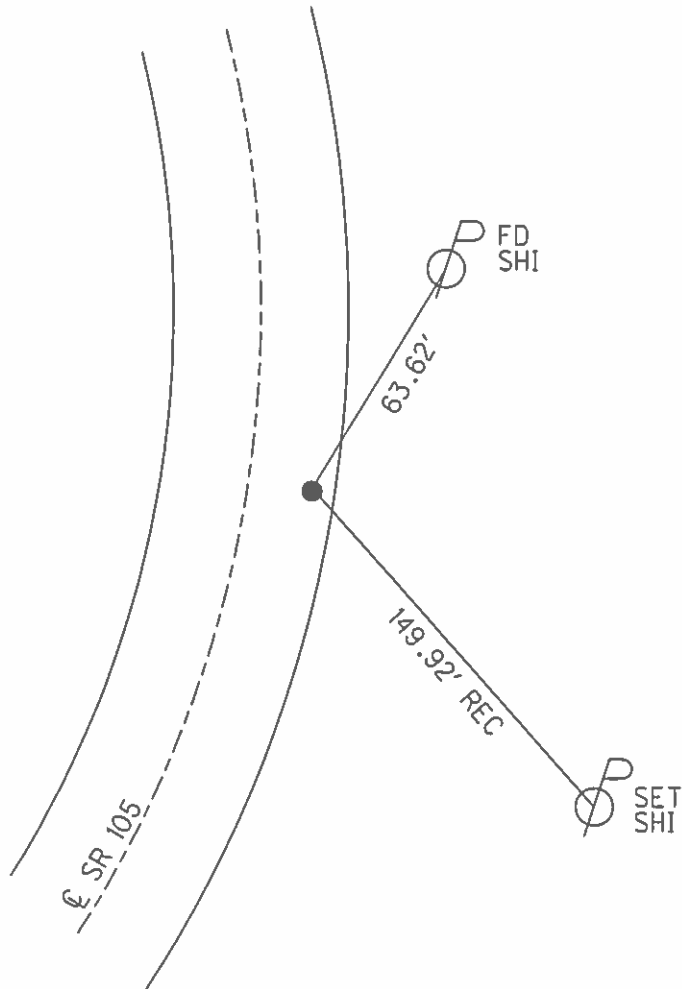

O.D.O.T. DISTRICT 2 SURVEY OFFICE

PERSONNEL

REFERENCE NO. 11


SHEET 16 OF 57

NOTES LONG
H.C. VANDUSEN
R.C. BARNHISEL

DATE 8-19-91
WEATHER cloudy
TEMP. 70°


ROUTE 105
COUNTY WOOD
TOWNSHIP CENTER
SECTION 22
T. 5 N. R. 11 E.


TYPE MONUMENT PK & WASHER
ON SURFACE - BELOW YES
~~LEFT~~ - C PAV'T. - RIGHT 11.4' RT.
1.6 TO RT EDGE PAVEMENT
S.L.M. 149+98

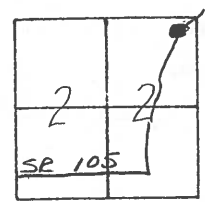

SET PK & WASHER
4-8-92
BVD

RECORD
P.I. #10
STA: 150+65.86
Δ = 22°-07'-20" LT.

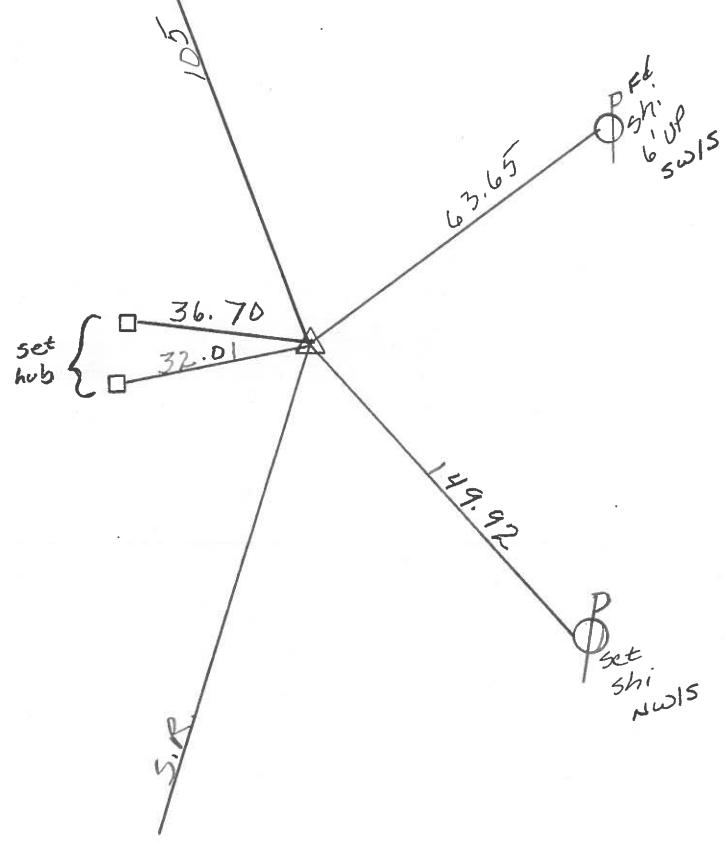

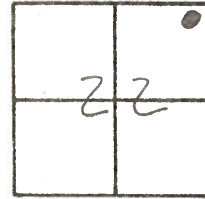County WOOD S.R. 105Township CENTERSection 22T N, R EPersonnel HOFFMANHOUSEHOLDERLOEHRKE# 11Date 4-19-82Weather CLEARTemp. +65°


P.I. #10

150+65.86

 $\Delta = 22^\circ - 07' - 20''$ LT.SET P.K./WASHER
5-24-82 S.W.H. $\frac{3}{4}$ " I. ROD @ SURFACE

1.2' - WEST TO EDGE PAVT.

11.4' RT. OF E PAVT.

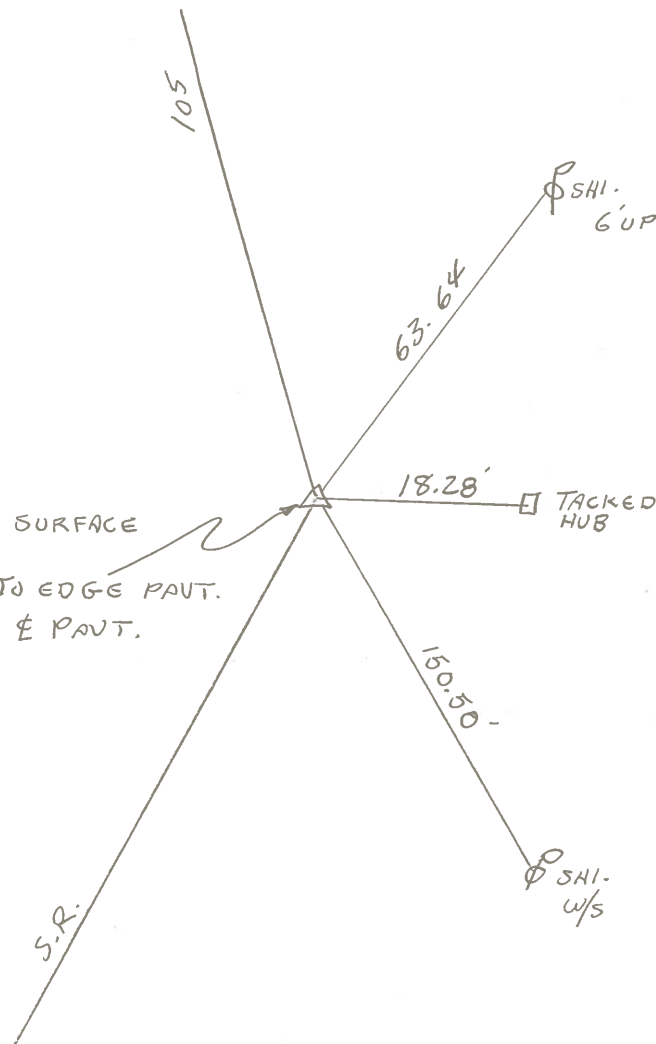


PERSONNEL	TITLE	PERSONNEL	TITLE	COUNTY	DATE
Stone	Notes			Wood	11 Sept. 72
Michalak	H.C.			S. R. #105	WEATHER Fair
Denno	P.C.			SEC. 22	TEMP. 75°
Curtis	RT				
DESCRIPTION				References to Control Points	JOB NO.
LEFT		CENTER LINE		RIGHT	

153+65.35
P.O.T.

9.4' - to E. edge Pnt.
9.8' - to W. edge Pnt.

COPIED

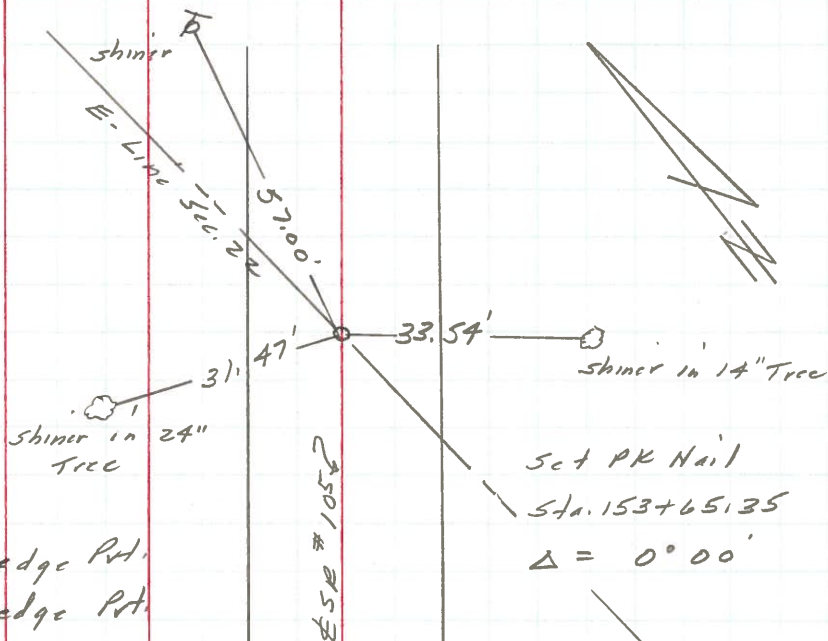


12

150+65.86
P.I. #10

Set $\frac{3}{4}$ " I. Rod
2" Below Surface
Sta. 150+65.86
 $\Delta = 22^\circ 07' 20''$ Lt.

COPIED

1.2' - W. to E. Edge
pvt.

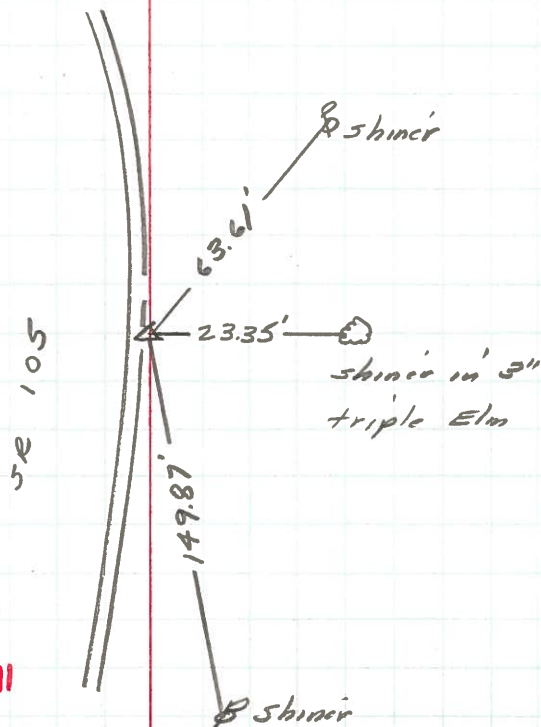

11