

O.D.O.T. DISTRICT 2 SURVEY OFFICE (USE ONLY)

PERSONNEL

REFERENCE NO. 12

SHEET 23 OF 28

NOTES ASTON

DATE 4/22/2024

ROUTE SR 105

H.C. MILLER

WEATHER BREEZY

COUNTY WOOD

R.C. NIESE

TEMP. 30°

TOWNSHIP CENTER

SECTION 22

DWG BY _____ PID NO PID

T 5 N R 11 E

TYPE MONUMENT MAG/ WASHER

ON SURFACE - BELOW ON

OFFSET Q PAVEMENT 0.45' ~~LT~~ : RT

9.4' TO LT EDGE PAVEMENT


STATION: 152+86

HORIZ.DATUM: LDP:WOOD

GEOID: 18


GRID: NORTHING: 627277.637

EASTING: 1674451.107

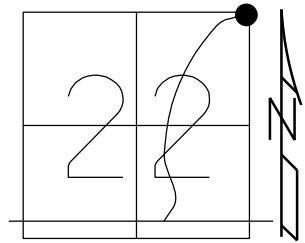

LDP
N: 449810.4
E: 185558.9

RECORD: P.O.T.
STA. 153+65.35
FD P.K./WASHER
4/15/02, MB
SET P.K./WASHER
6/12/02, DCH
FD P.K./WASHER
REF12
6/2/16, JFO
SET MAG/WASHER
NEWREF12
6/20/17, JFO
FD MAG/W
REF 12
4-22-24, JAM

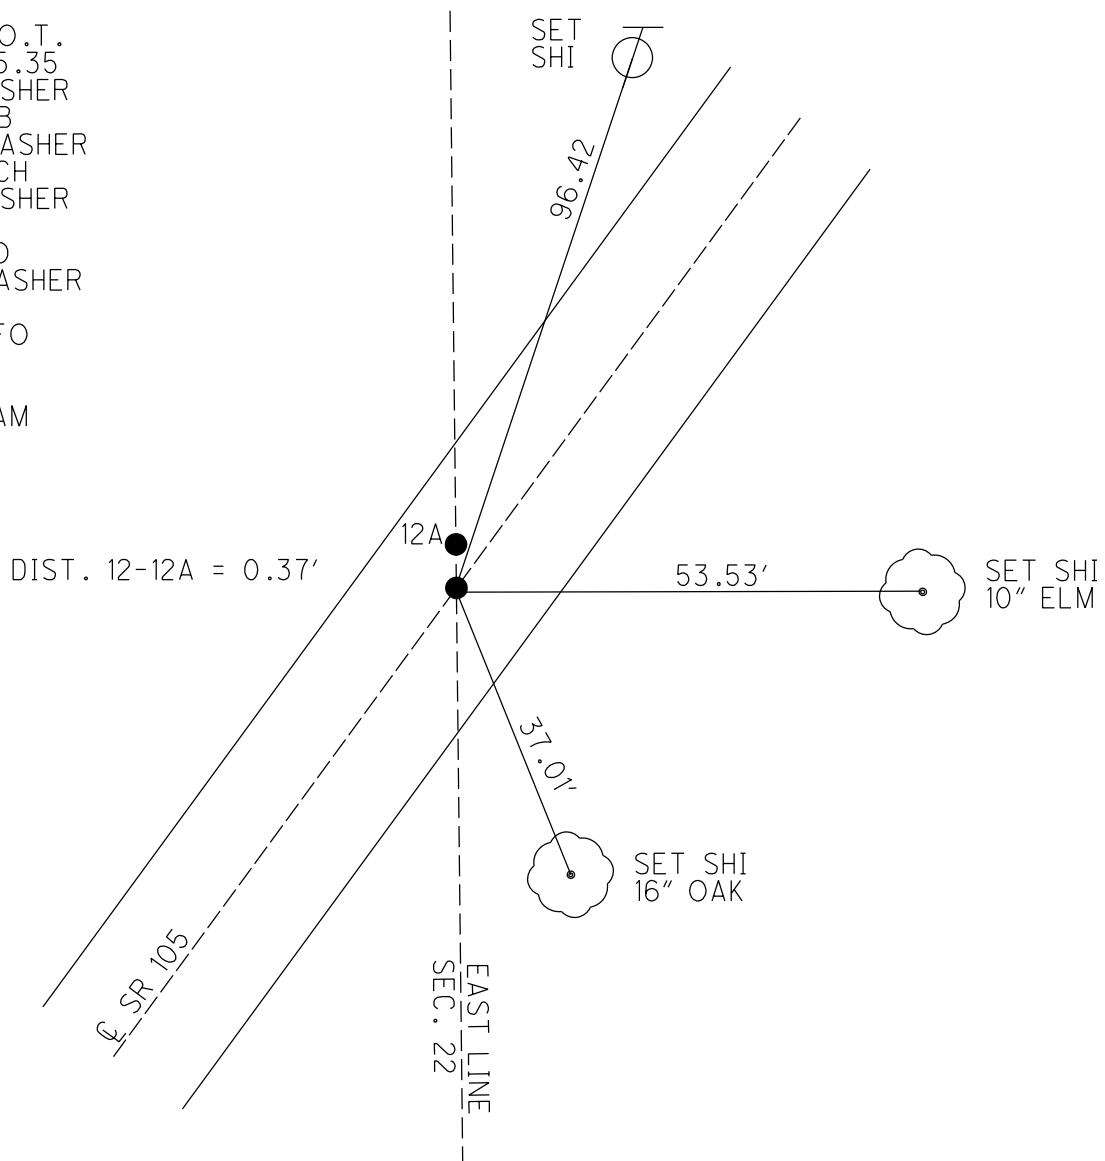


O.D.O.T. DISTRICT 2 SURVEY OFFICE (USE ONLY)


PERSONNEL	REFERENCE NO. <u>12</u>	SHEET <u>20</u> OF <u>28</u>	
NOTES	DATE <u>9/12/16</u>	ROUTE <u>SR 105</u>	
H.C. <u>RHOADES</u>	WEATHER <u>SUNNY</u>	COUNTY <u>WOOD</u>	
R.C. <u>RHOADES</u>	TEMP. <u>55°</u>	TOWNSHIP <u>CENTER</u>	
		SECTION <u>22</u>	
		T <u>5</u> N R <u>11</u> E	

TYPE MONUMENT P.K./WASHER
 ON SURFACE - ~~BELOW~~ ON
~~LEFT~~ - CL PAV'T - RIGHT 0.45'
9.4' TO LT EDGE PAVEMENT
 S.L.M. 152+86

GRID: NORTHING: 627677.637 EASTING: 1674451.107

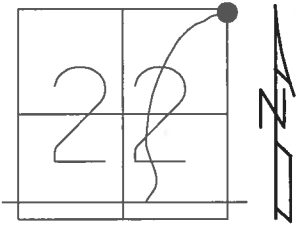


RECORD: P.O.T.
 STA. 153+65.35
 FD P.K./WASHER
 4/15/02, MB
 SET P.K./WASHER
 6/12/02, DCH
 FD P.K./WASHER
 REF12
 6/2/16, JFO
 SET MAG/WASHER
 NEWREF12
 6/20/17, JFO

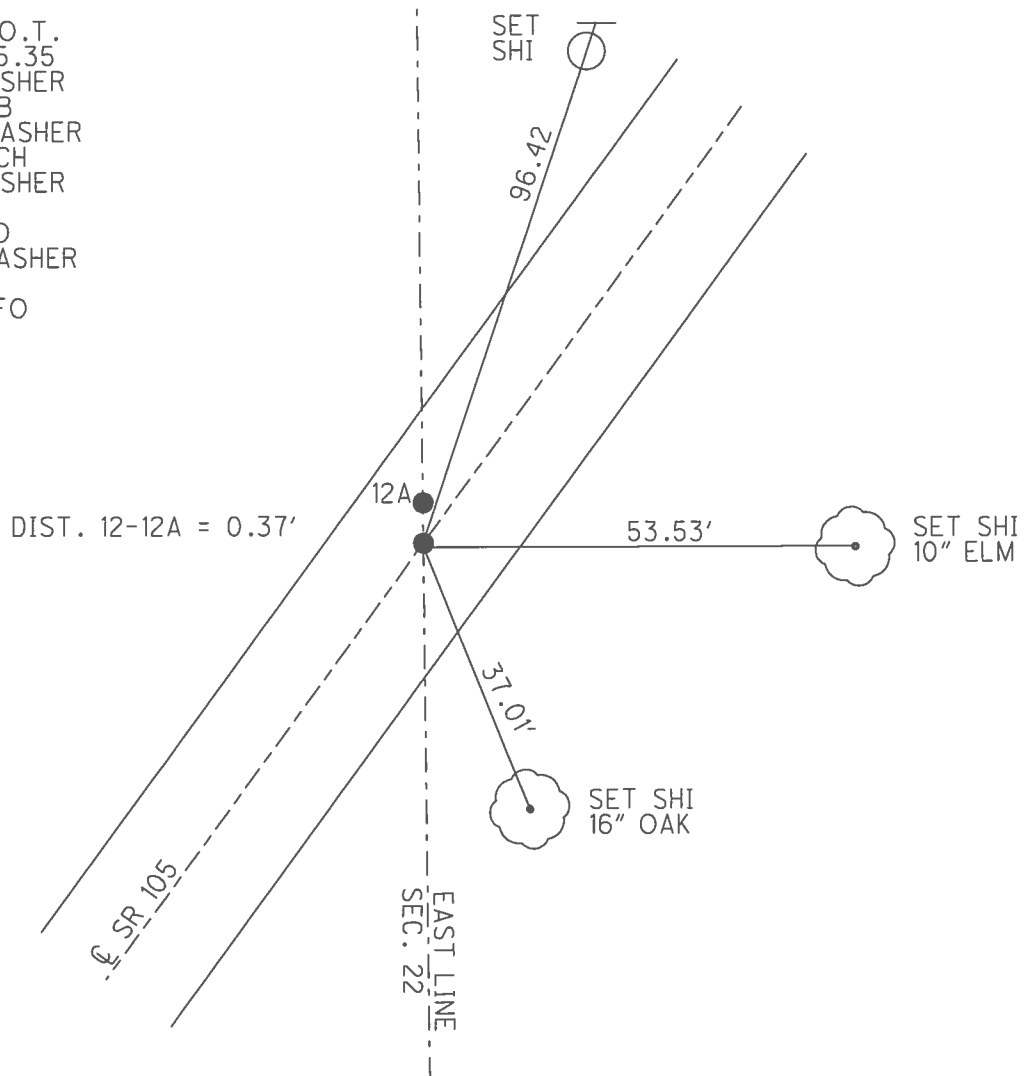


O.D.O.T. DISTRICT 2 SURVEY OFFICE (USE ONLY)

PERSONNEL	REFERENCE NO. <u>12</u>	SHEET <u>20</u> OF <u>21</u>
NOTES <u>MOSER</u>	DATE <u>4/15/02</u>	ROUTE <u>SR 105</u>
H.C. <u>CANTERBURY</u>	WEATHER <u>SUNNY</u>	COUNTY <u>WOOD</u>
R.C. <u>BARNHISEL</u>	TEMP. <u>70°</u>	TOWNSHIP <u>CENTER</u>
		SECTION <u>22</u>
		T <u>5</u> N R <u>11</u> E

TYPE MONUMENT P.K./WASHER
 ON SURFACE - ~~BELOW~~ ON
~~LEFT~~ - CL PAV'T - RIGHT 0.45'
9.4' TO LT EDGE PAVEMENT
 S.L.M. 152+96

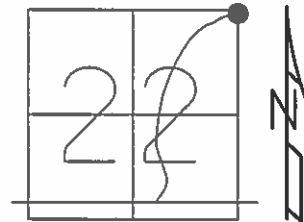

RECORD: P.O.T.
 STA. 153+65.35
 SET P.K./WASHER
 6/12/02, DCH

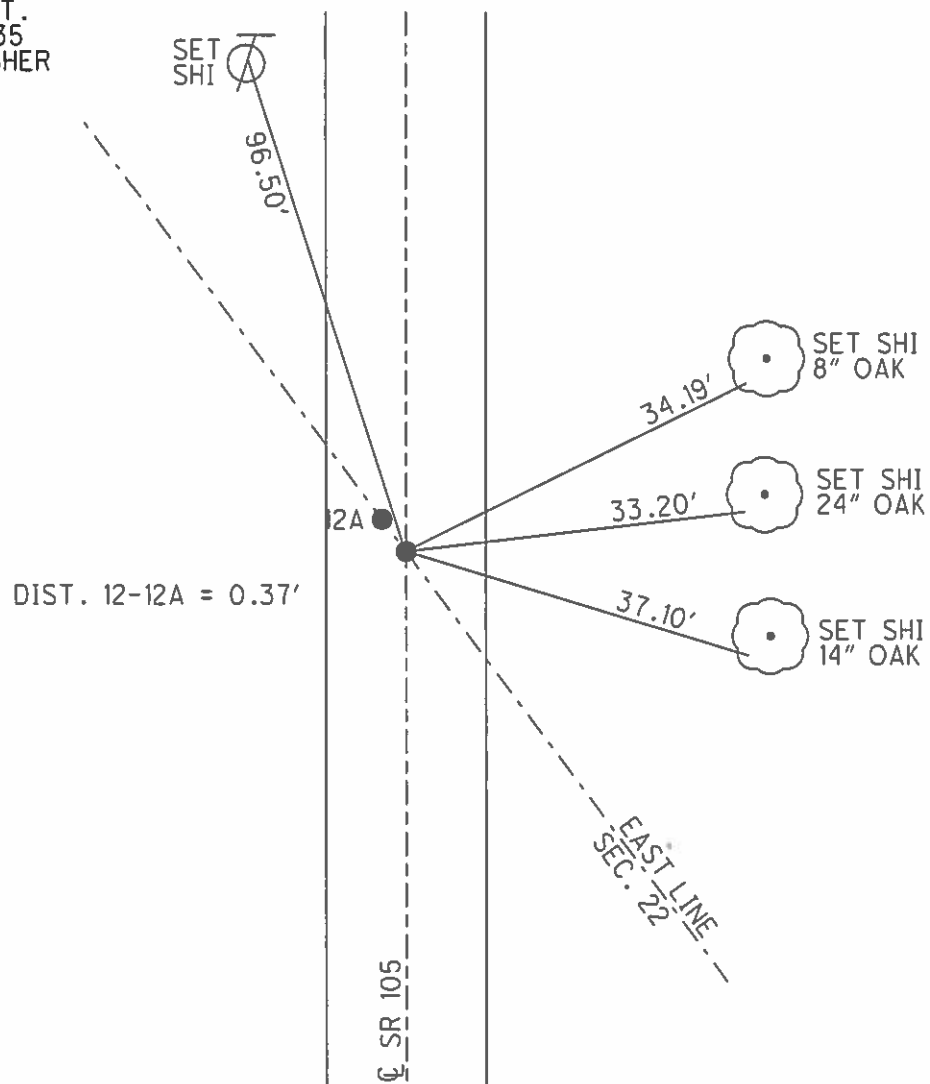

O.D.O.T. DISTRICT 2 SURVEY OFFICE

PERSONNEL

REFERENCE NO. 12

SHEET 17 OF 57

NOTES LONG

H.C. VANDUSEN

R.C. BARNHISEL

DATE 8-19-91

WEATHER cloudy

TEMP. 70°

ROUTE 105

COUNTY WOOD

TOWNSHIP CENTER

SECTION 22

T 5 N R 11 E

TYPE MONUMENT PK & WASHER



ON SURFACE - BELOW YES

~~LEFT~~ - C PAV'T. - RIGHT yes

10.5 TO RT EDGE PAVEMENT

S.L.M. 152+96

0.39 BETWEEN PTS

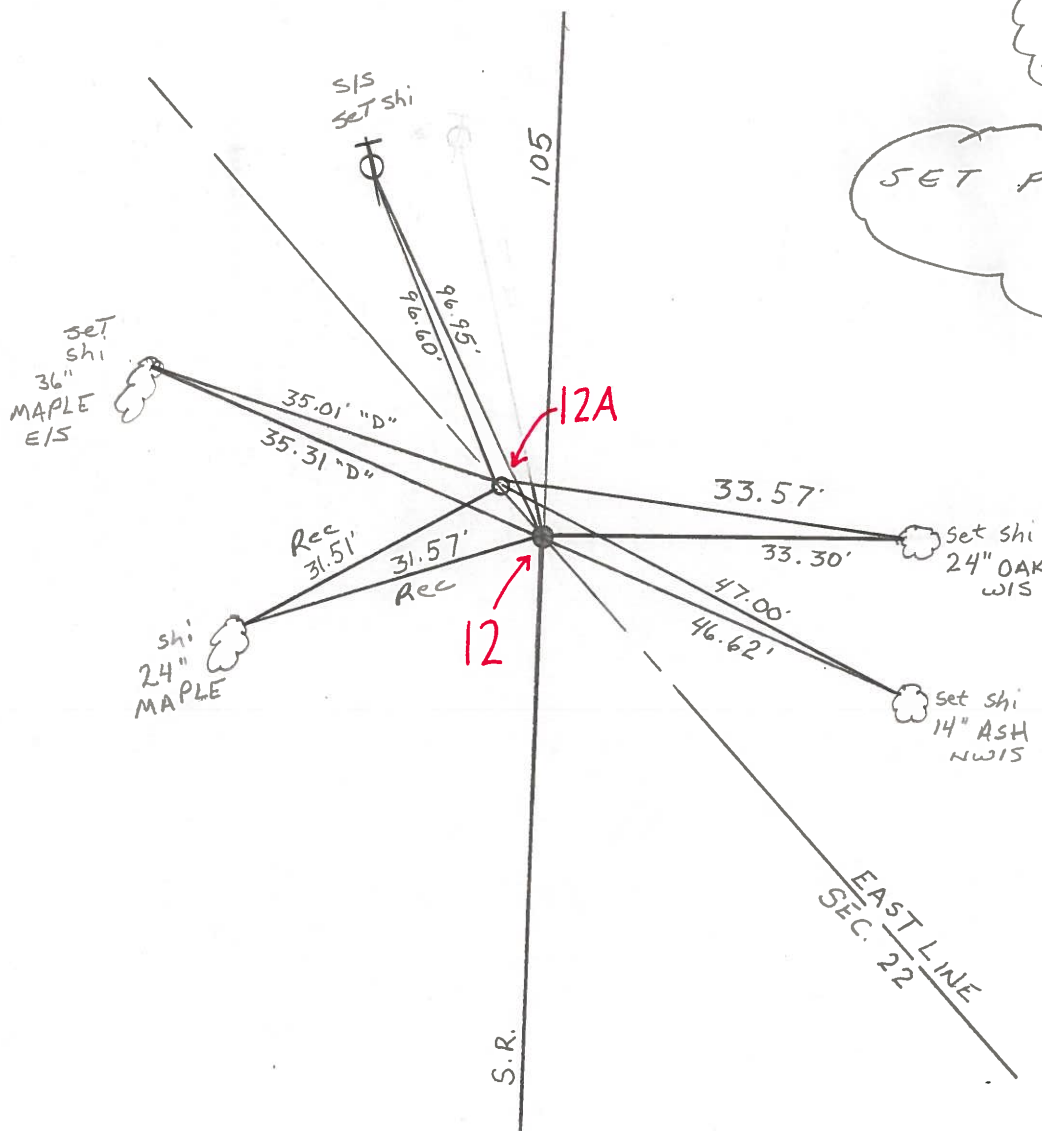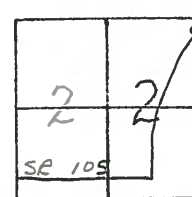

RECORD
P.O.T.
153+65.35

SET PK & WASHER
4-8-92
BVD

QD.O.T. DISTRICT 2 SURVEY OFFICE

SHEET _____ OF _____

County WOOD S.R. 105

Township CENTER

Section 22

T.N, R.E

Personnel HOFFMAN

HOUSEHOLDER


LOEHRKE

12

Date 4-19-82

Weather CLEAR

Temp. +72°

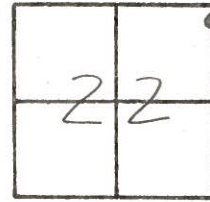

P.O.T.

153+65.35

12A

SET CONC. NAIL
5-25-82
S.W.H.

SHI.
36" MAPLE

SHI.
24" MAPLE

SHI.
57.00'

34.59'

34.82'

31.51'

31.57'

12

FD. P.K. NAIL @ SURFACE
9.7' - TO E. EDGE PAVT.
10.0' - TO W. EDGE PAVT.

SET P.K. WASHER
5-25-82 S.W.H.

33.67'

33.39'

47.03'

46.65'

SHI.
18" TREE

SHI.
14" TREE

EAST LINE
SEC. 22

105
S.R.

PERSONNEL	TITLE	PERSONNEL	TITLE	COUNTY	DATE
Stone	Notes			Wood	11 Sept. 72
Michalek	H.C.			S. R. #105	WEATHER Fair
Denno	P.C.				
Curtis	FI			SEC. 22	TEMP. 75°
DESCRIPTION	References to Control Points			JOB NO.	
	LEFT	CENTER LINE	RIGHT		

