

O.D.O.T. DISTRICT 2 SURVEY OFFICE (USE ONLY)

PERSONNEL

REFERENCE NO. 13

SHEET 25 OF 28

NOTES ASTON

DATE 4/22/2024

ROUTE SR 105

H.C. MILLER

WEATHER BREEZY

COUNTY WOOD

R.C. NIESE

TEMP. 30°

TOWNSHIP WEBSTER

SECTION 14

DWG BY PID NO PID

T 5 N R 11 E

TYPE MONUMENT MAG/ WASHER

ON SURFACE - BELOW ON

OFFSET Q PAVEMENT 6.6' ~~LT~~ : RT

4.0' TO RT EDGE PAVEMENT


STATION: 155+02.42

HORIZ.DATUM: LDP:WOOD

GEOID: 18


GRID: NORTHING: 627797.155

EASTING: 1674518.200

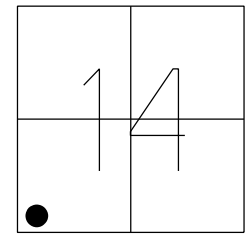

LDP
N: 449930.8
E: 185624.4

RECORD: P.I.
STA.155+02.42
DELTA= 11°37' LT
SET PK AND WASHER
6-12-02 DCH
FD MAG/WASHER
SV3
7/25/12, SDC
D.N.F.
6/2/16, JFO
SET MAG/WASHER
NEWREF13
11/21/16, JFO
FD MAG/W
REF13
4-22-24, JAM

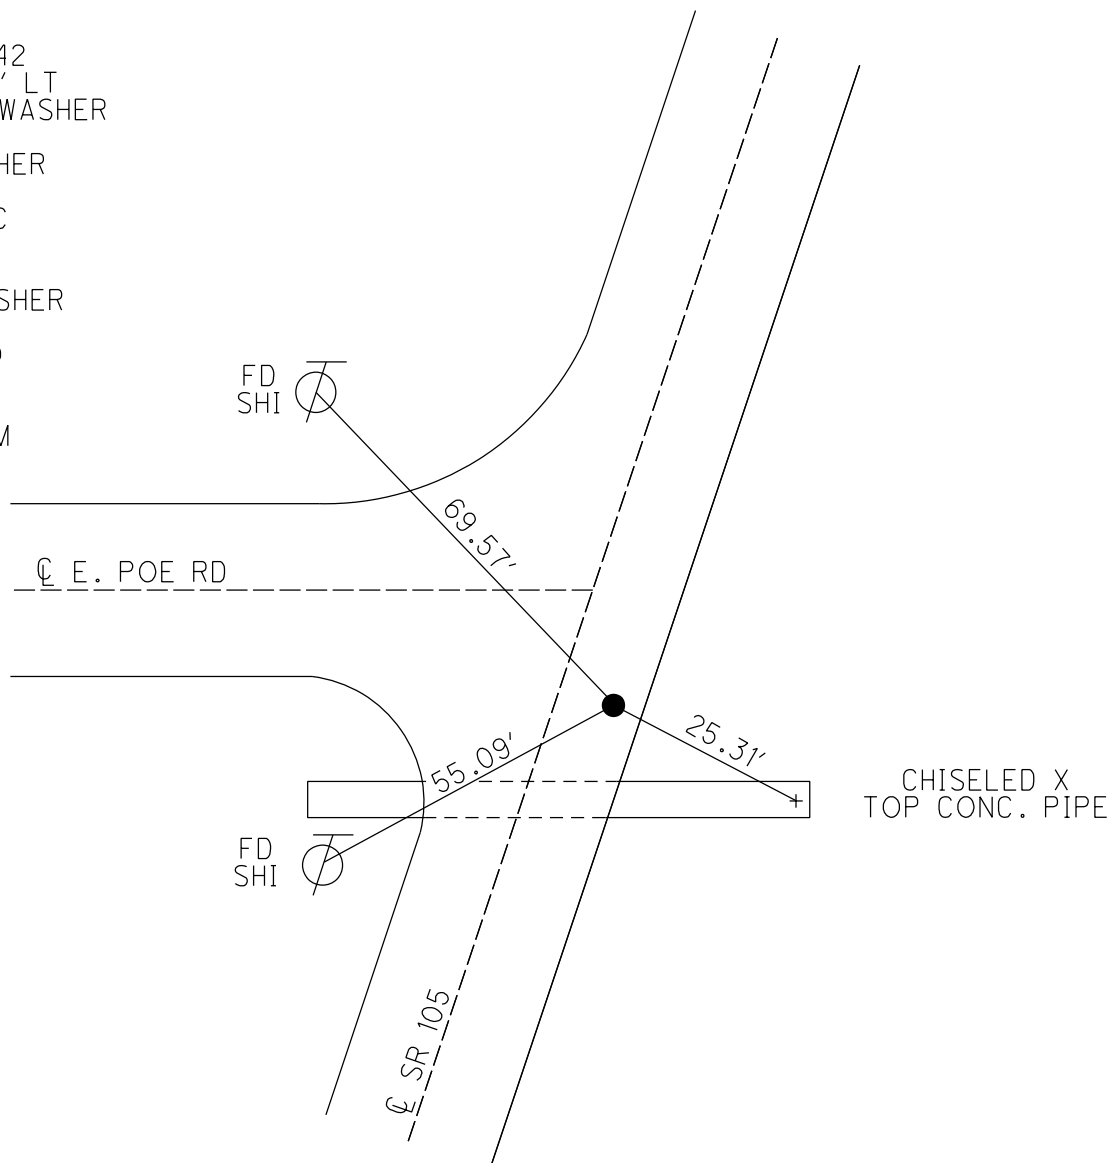


O.D.O.T. DISTRICT 2 SURVEY OFFICE (USE ONLY)


PERSONNEL	REFERENCE NO. <u>13</u>	SHEET <u>22</u> OF <u>28</u>	
NOTES	RHOADES	DATE <u>11/21/16</u>	ROUTE <u>SR 105</u>
H.C.	O'DONNELL	WEATHER <u>FAIR</u>	COUNTY <u>WOOD</u>
R.C.	RHOADES	TEMP. <u>30°</u>	TOWNSHIP <u>WEBSTER</u>
			SECTION <u>14</u>
			T <u>5</u> N R <u>11</u> E

TYPE MONUMENT MAG/WASHER
 ON SURFACE - ~~BELOW~~ ON
~~LEFT~~ - CL PAV'T - RIGHT 6.6'
4.0' TO RT EDGE PAVEMENT
 S.L.M. 155+02.42

GRID: NORTHING: 627797.155 EASTING: 1674518.200

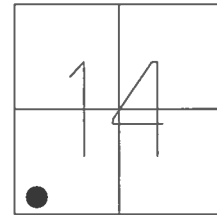

RECORD: P.I.
 STA. 155+02.42
 DELTA= 11°37' LT
 SET PK AND WASHER
 6-12-02 DCH
 FD MAG/WASHER
 SV3
 7/25/12, SDC
 D.N.F.
 6/2/16, JFO
 SET MAG/WASHER
 NEWREF13
 11/21/16, JFO

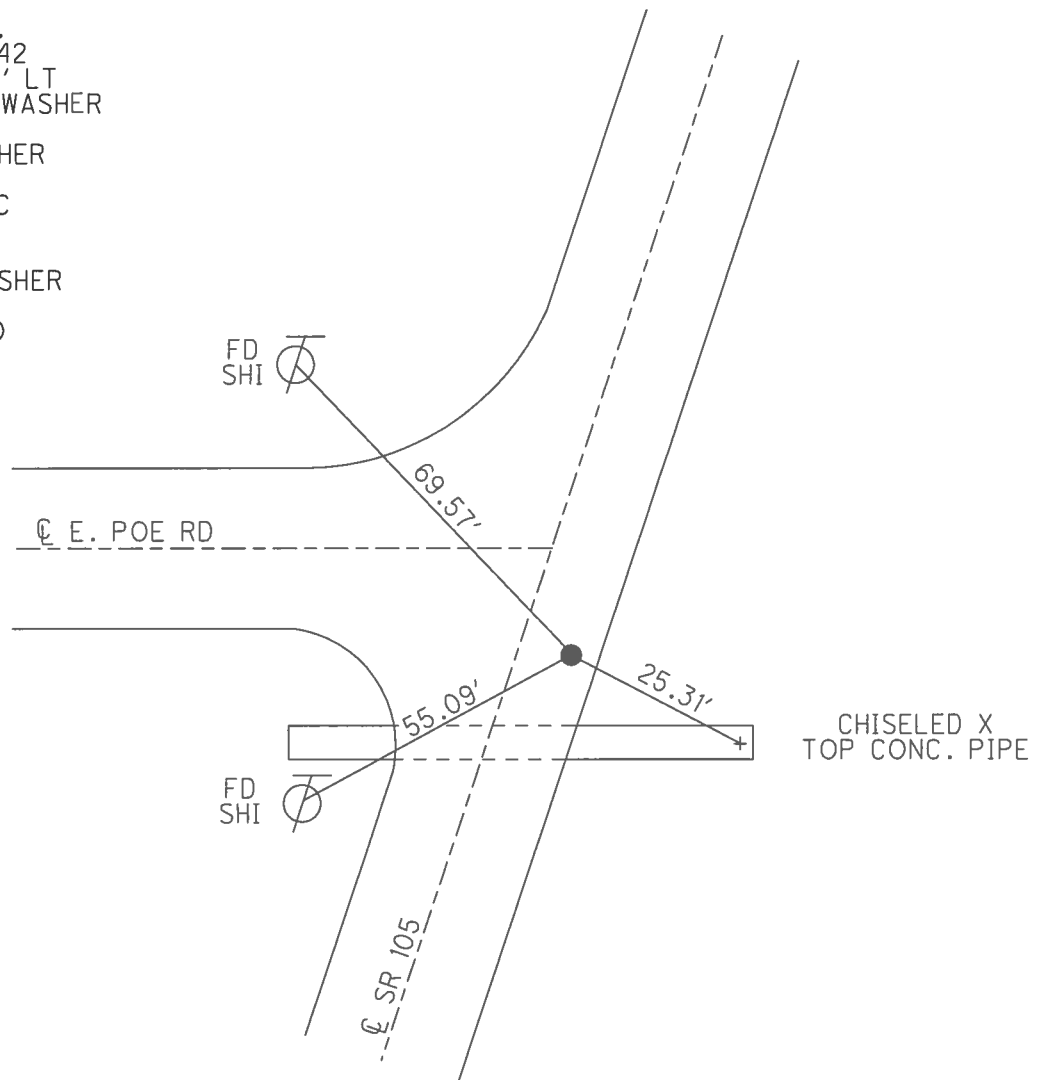

O.D.O.T. DISTRICT 2 SURVEY OFFICE (USE ONLY)

PERSONNEL		REFERENCE NO.	<u>13</u>	SHEET	<u>1</u>	OF	<u>7</u>
NOTES	CODER	DATE	<u>7/25/12</u>	ROUTE	<u>SR 105</u>		
H.C.	RHOADES	WEATHER	<u>CLEAR</u>	COUNTY	<u>WOOD</u>		
R.C.	COUTCHER	TEMP.	<u>80°</u>	TOWNSHIP	<u>WEBSTER</u>		
				SECTION	<u>14</u>		
				T <u>5</u> N R <u>11</u> E			

TYPE MONUMENT MAG/WASHER


ON SURFACE - ~~BELOW~~ ON

~~LEFT~~ - CL PAV'T - RIGHT 6.6'

4.0' TO RT. EDGE PAVEMENT


S.L.M. 155+02.42

GRID: NORTHING: 627797.366 EASTING: 1674518.275

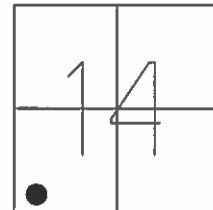

RECORD:
SET PK AND WASHER
6-12-02 DCH
P.I. #11
155+02.42
DELTA= 11° -37' LT


GPS, SV3
SDC, 7-25-12

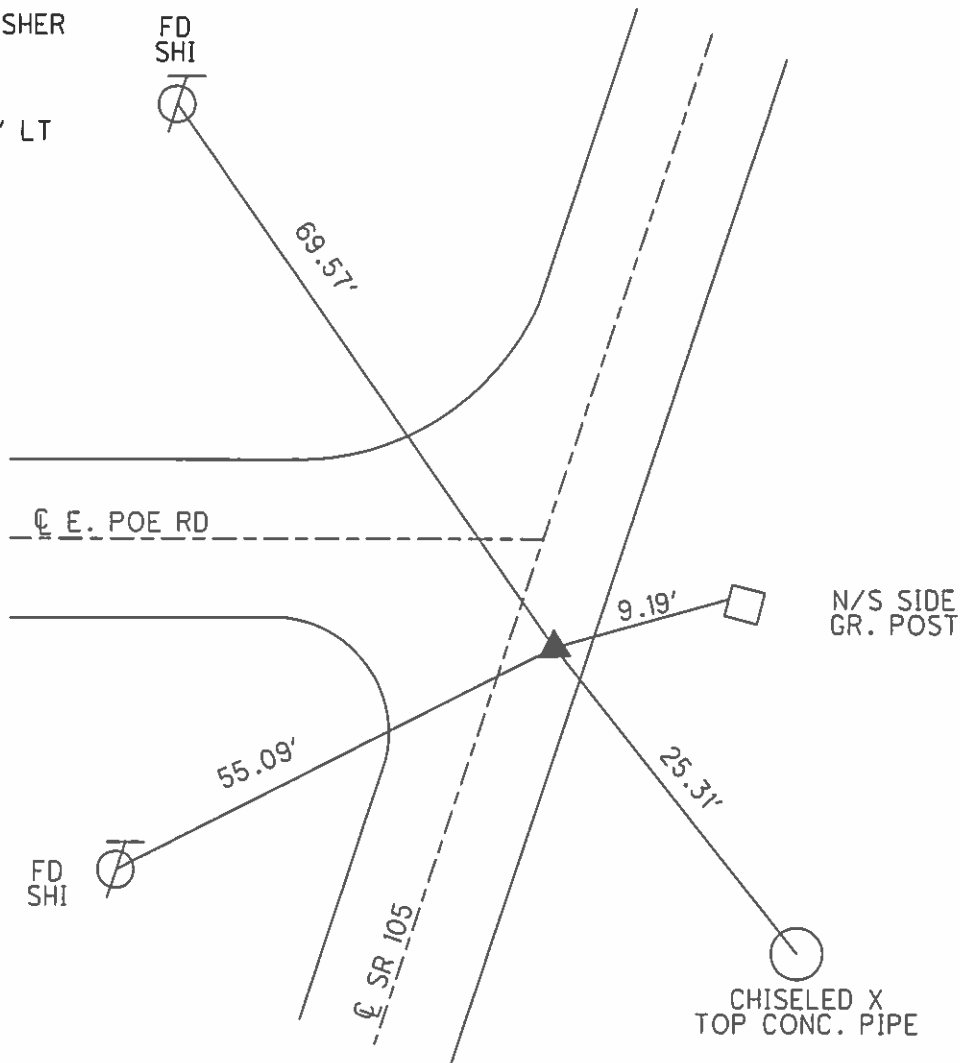


O.D.O.T. DISTRICT 2 SURVEY OFFICE (USE ONLY)

PERSONNEL	REFERENCE NO. <u>13</u>	SHEET <u>1</u> OF <u>7</u>	
NOTES	CODER	DATE <u>7/25/12</u>	ROUTE <u>SR 105</u>
H.C.	RHOADES	WEATHER <u>CLEAR</u>	COUNTY <u>WOOD</u>
R.C.	COUTCHER	TEMP. <u>80°</u>	TOWNSHIP <u>WEBSTER</u>
			SECTION <u>14</u>
			T <u>5</u> N R <u>11</u> E

TYPE MONUMENT MAG/WASHER
 ON SURFACE - ~~BELOW~~ ON
~~LEFT~~ - CL PAV'T - RIGHT 6.6'
4.0' TO RT. EDGE PAVEMENT
 S.L.M. 155+02.42
 GRID: NORTHING: 627797.366 EASTING: 1674518.275

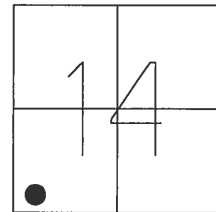

RECORD:
 SET PK AND WASHER
 6-12-02 DCH
 P.I. #11
 155+02.42
 DELTA= 11° -37' LT
 GPS, SV3
 SDC, 7-25-12

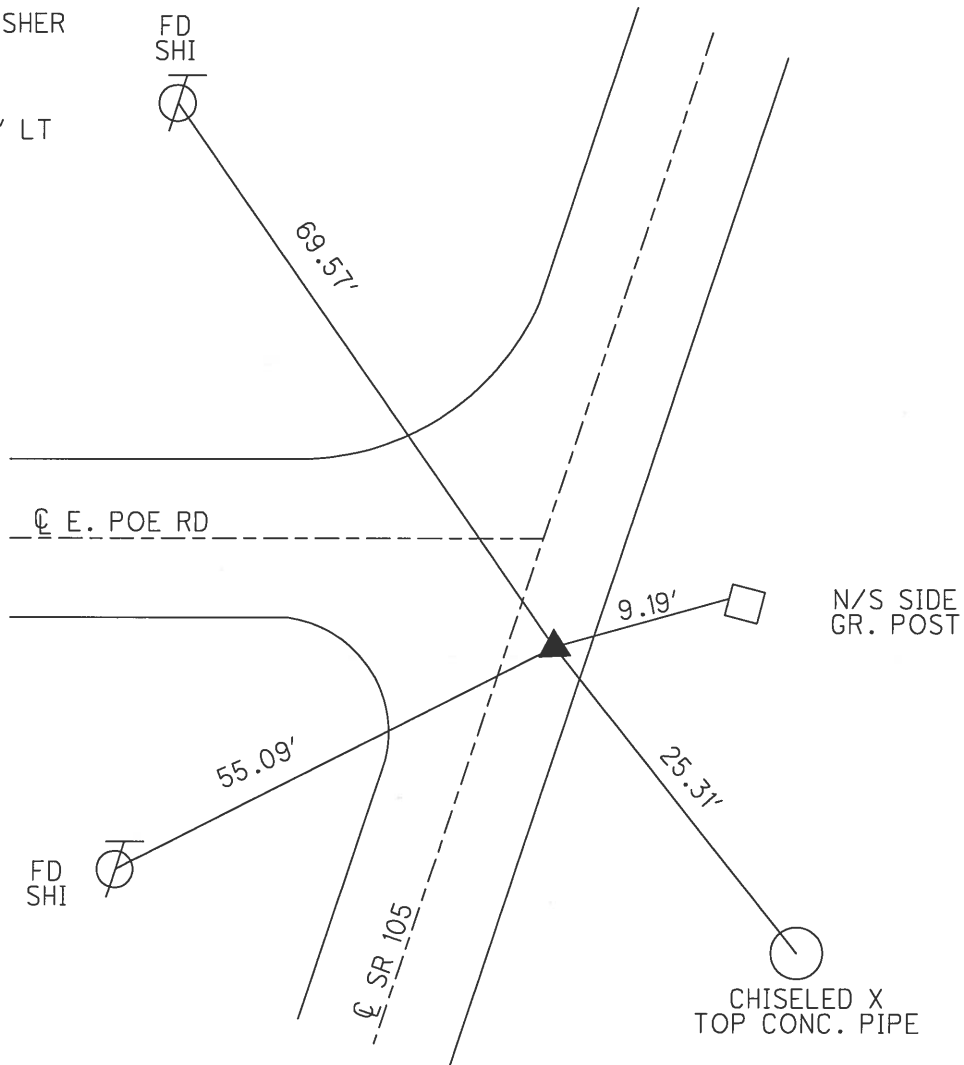

O.D.O.T. DISTRICT 2 SURVEY OFFICE

PERSONNEL

REFERENCE NO. 13

SHEET 19 OF 63

NOTES MOSE

DATE 4-15-02

ROUTE SR 105

H.C. CANTERBURY

WEATHER SUNNY

COUNTY WOOD

R.C. BARNHISEL

TEMP. 70°

TOWNSHIP WEBSTER

SECTION 14

T 5 N R 11 E


TYPE MONUMENT P.K. & WASHER

ON SURFACE - ~~BELOW~~ ON SURFACE

~~LEFT - C PAV'T - RIGHT~~ 6.9' RT.


2.8' TO RT. EDGE PAVEMENT

S.L.M. 154+33

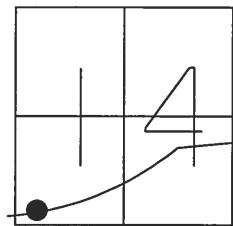

SET PK & WASHER
6-12-02 D.C.H.

RECORD:
P.I. #11
155+02.42
DELTA=11°-37' LT.

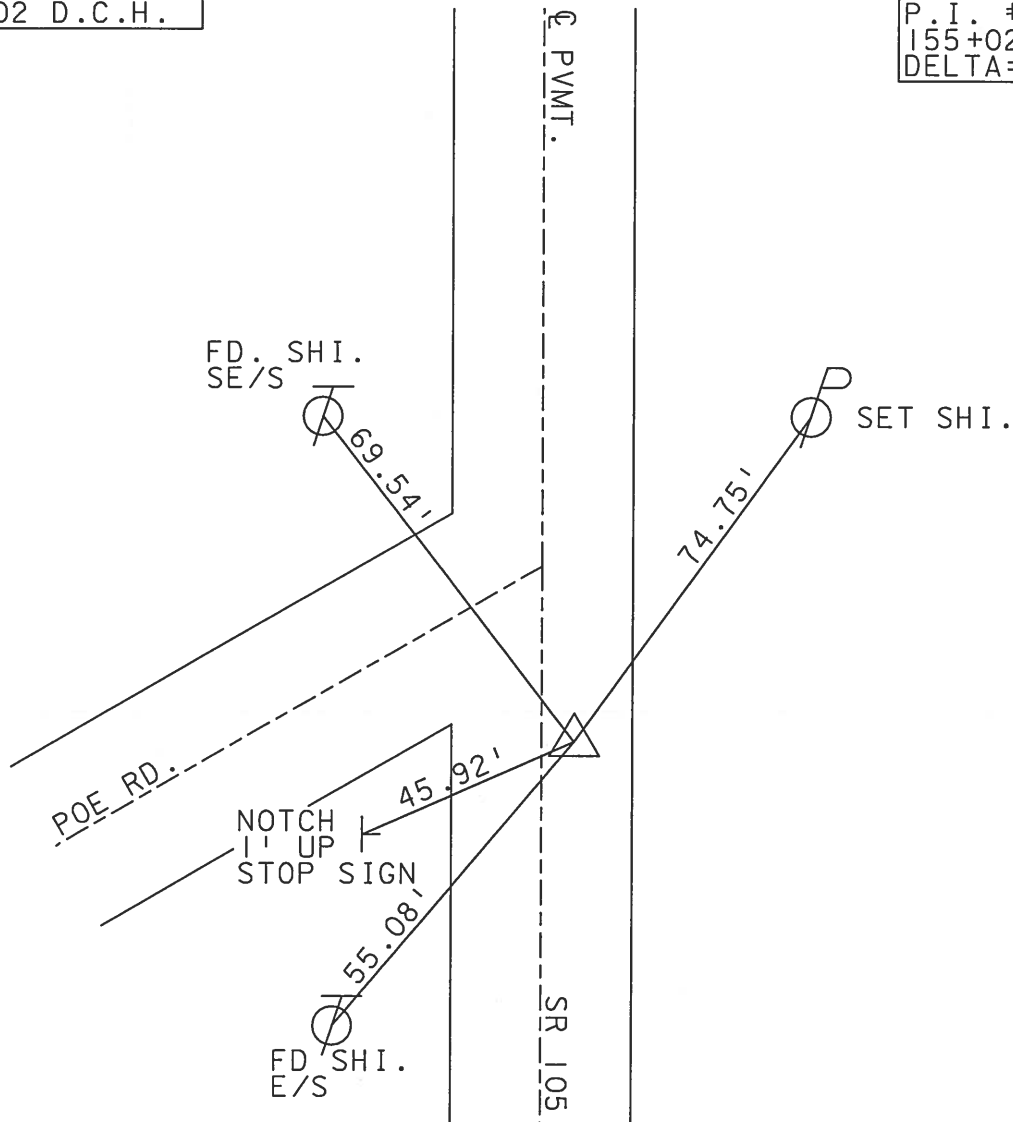

O.D.O.T. DISTRICT 2 SURVEY OFFICE

PERSONNEL

REFERENCE NO. 13

SHEET 18 OF 57

NOTES LONG

H.C. VANDUSEN

R.C. BARNHISEL

DATE 8-19-91

WEATHER cloudy

TEMP. 71°

ROUTE 105

COUNTY WOOD

TOWNSHIP WEBSTER

SECTION 14

T 5 N R 11 E


TYPE MONUMENT PK & WASHER

ON SURFACE - BELOW YES

~~LEFT~~ - C PAV'T. - RIGHT C


J.L. TO RT EDGE PAVEMENT

S.L.M. 154+33

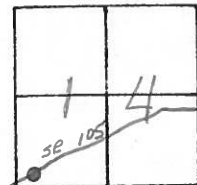

SET PK & WASHER
4-8-92
BVD

RECORD
P.I. #11
155+02.42
Δ=11°-37' LT.

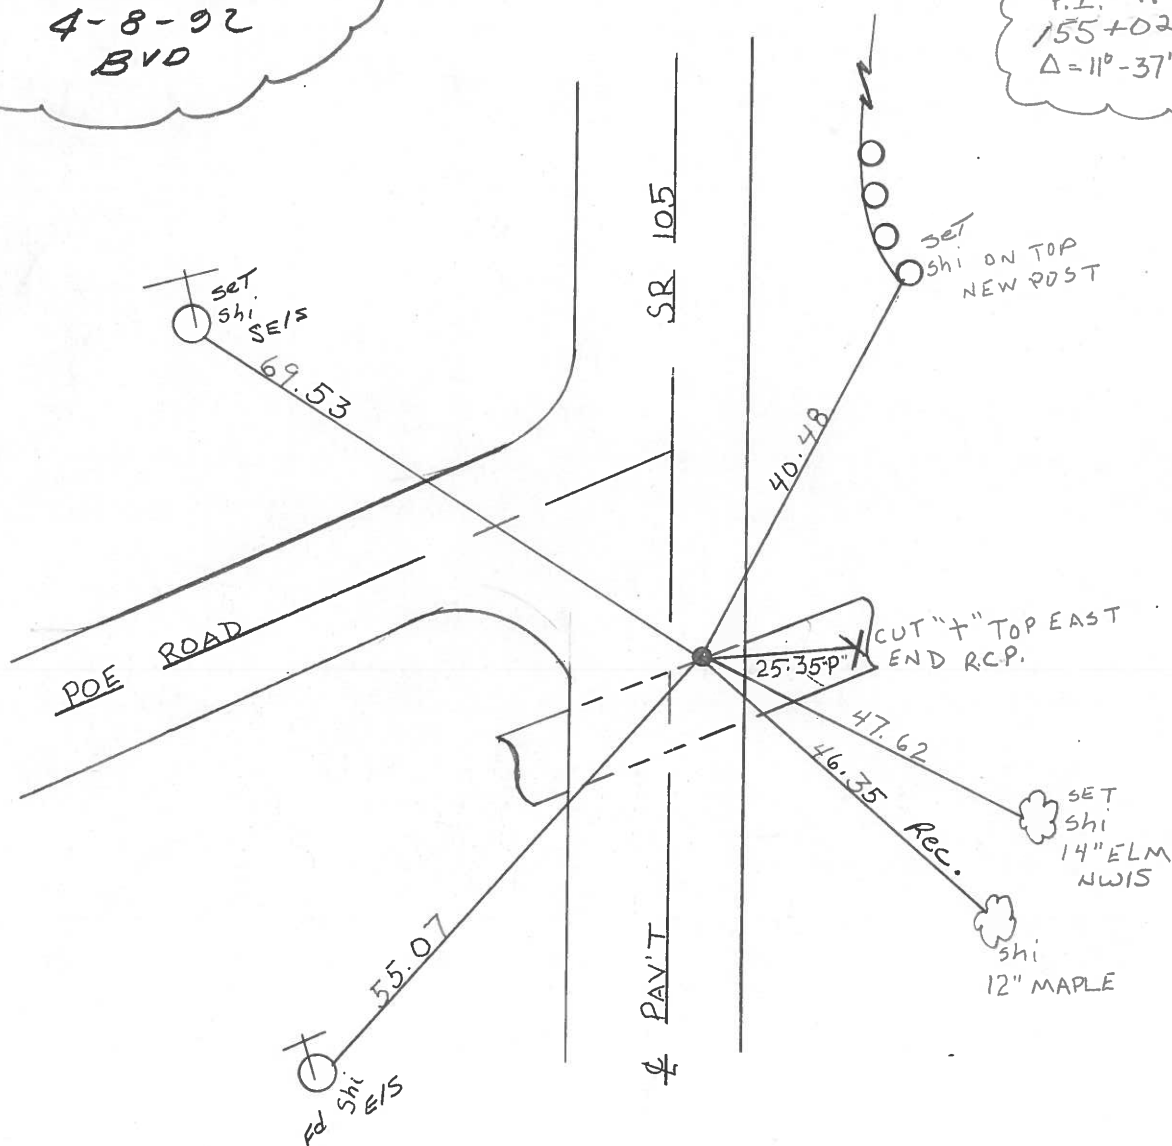

ODOT DISTRICT 2 SURVEY OFFICE

SHEET _____ OF _____

County Wood S.R. 105

Township Webster

Section 14

T N, R E

Personnel Hoffman


Loehrke

Householder

Date 5-24-82

Weather cloudy

Temp. +70°

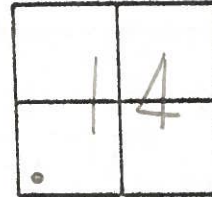


13

P.I. #11

155+02.42

$\Delta = 11^{\circ}-37' Lt$

Set P.K./washer at P.I. AS per
Notes By Stone, 1972

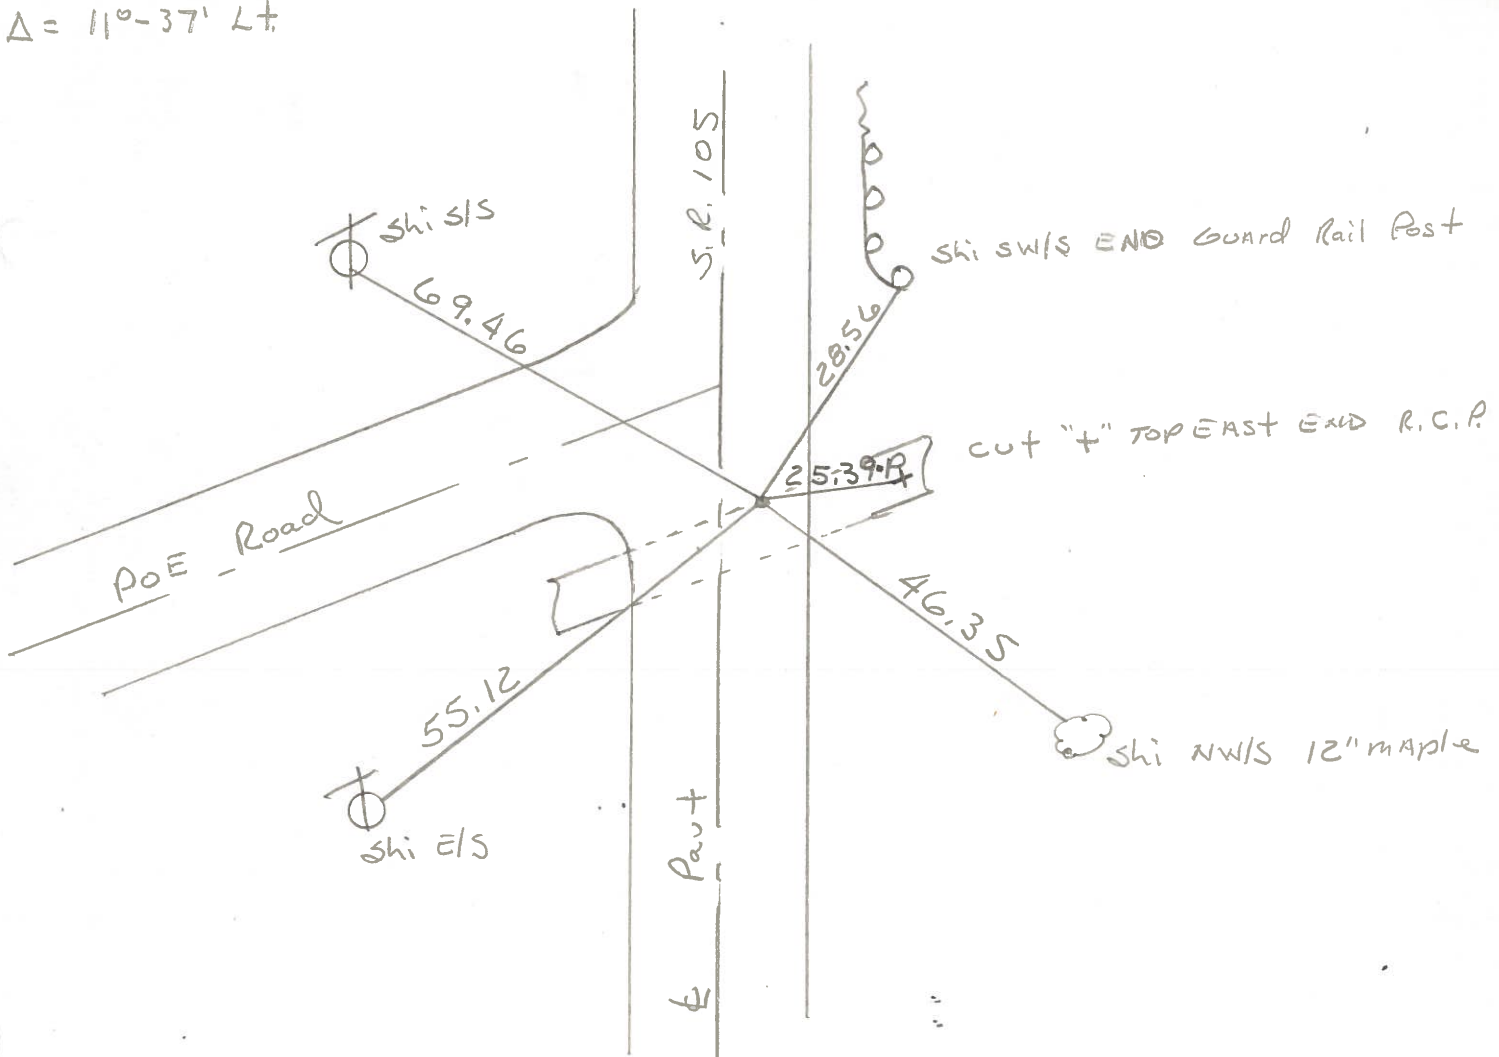

PERSONNEL	TITLE	PERSONNEL	TITLE	COUNTY	DATE
Stone	Notes			Wood	22 Sept. 72
Michalak	FI			S. R. #105	WEATHER Cool
Denno	H.C.			SEC. 14	TEMP. 61°
Curtis	R.C.				

DESCRIPTION References to Control Points JOB NO. _____

LEFT CENTER LINE RIGHT

