

O.D.O.T. DISTRICT 2 SURVEY OFFICE (USE ONLY)

PERSONNEL

REFERENCE NO. 1

SHEET 1 OF 24

NOTES LOEHRKE

DATE 7-14-88

ROUTE SR 199

H.C. BARNHISEL

WEATHER CLOUDY, HUMID

COUNTY WOOD

R.C. REED

TEMP. 85°

TOWNSHIP PERRY

SECTION 36

DWG BY NIESE PID 105306

T 3 N R 12 E

TYPE MONUMENT SM.R.R.SPIKE

ON SURFACE - BELOW ON

OFFSET Q PAVEMENT - LT : RT

8.9' TO RT EDGE PAVEMENT


STATION: 18+48

HORIZ.DATUM: NAD83(2011)


GEOID: 2012A

GRID: NORTHING: 549510.011

EASTING: 1714959.791

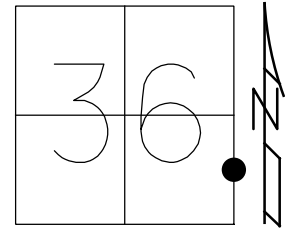

RECORD:
1950 PLAN
 $\Delta = 35^{\circ} 46'$
FD SM.R.R.SPIKE
7/14/88, CL
FD MONBOX
REF1
10/12/11, MC
FD MON BOX
W/ 1" IPIN
REF1
7/21/17, JFO

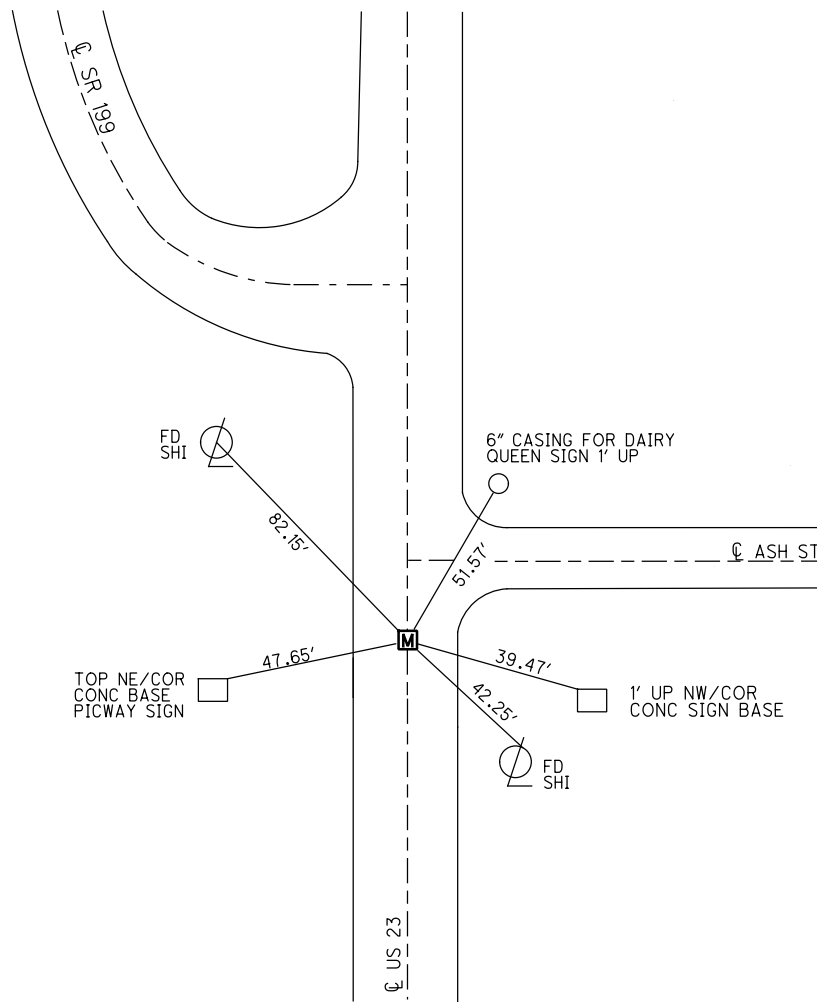


O.D.O.T. DISTRICT 2 SURVEY OFFICE (USE ONLY)


PERSONNEL _____ REFERENCE NO. 1 SHEET 1 OF 24
 NOTES LOEHRKE DATE 7-14-88 ROUTE SR 199
 H.C. BARNHISEL WEATHER CLOUDY, HUMID COUNTY WOOD
 R.C. REED TEMP. 85° TOWNSHIP PERRY
 _____ SECTION 36
 _____ T 3 N R 12 E

TYPE MONUMENT SM.R.R.SPIKE
 ON SURFACE - BELOW ON _____
 LEFT - CL PAV'T - RIGHT - _____
8.9 TO RT CURB ISLAND
 S.L.M. 18+48.00

Grid: Northing: 549510.102 Easting: 1714959.689

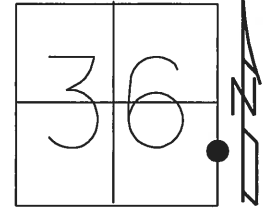

RECORD:
 1950 PLAN
 $\Delta = 35^\circ 46'$
 FD SM.R.R.SPIKE
 7/14/88, CL
 FD MONBOX
 REF1
 10/12/11, MC

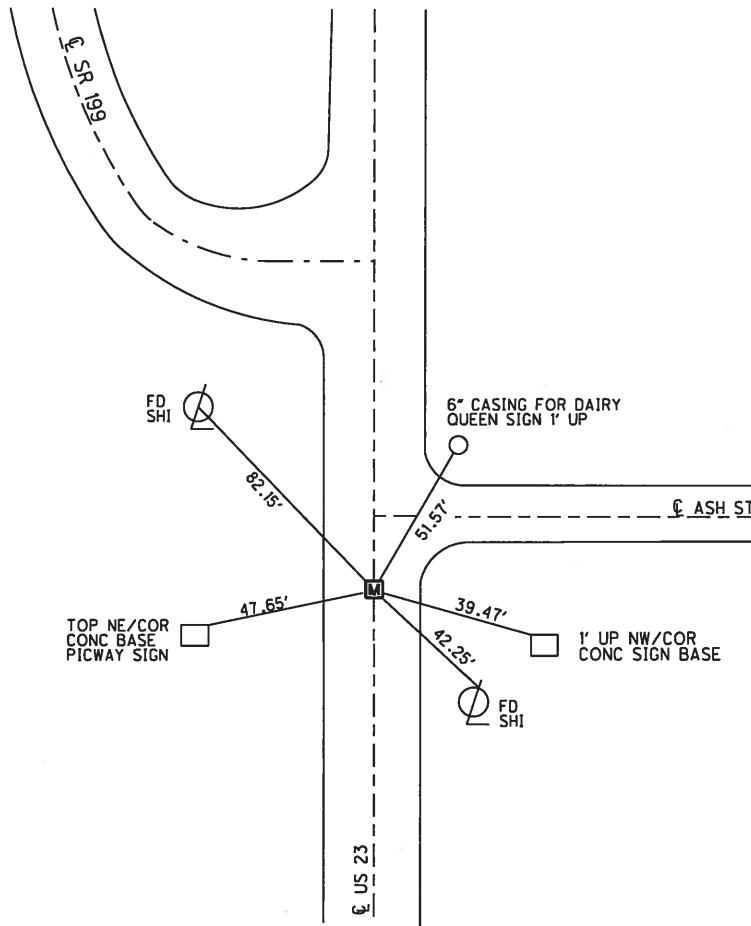

O.D.O.T. DISTRICT 2 SURVEY OFFICE

PERSONNEL

REFERENCE NO. 1

SHEET OF

NOTES LOEHRKE

H.C. BARNHISEL

R.C. PEED

DATE 7-14-88

WEATHER Cloudy Humid

TEMP. 48.5

ROUTE 199

COUNTY WOOD

TOWNSHIP PERRY

SECTION 36

T. 3 N. R. 12 E.



TYPE MONUMENT Small RR Spike

ON SURFACE - BELOW

LEFT - CL PAV'T. - RIGHT

SET TO RA EDGE PAVEMENT Curbs 15' apart

S.L.M. 16447

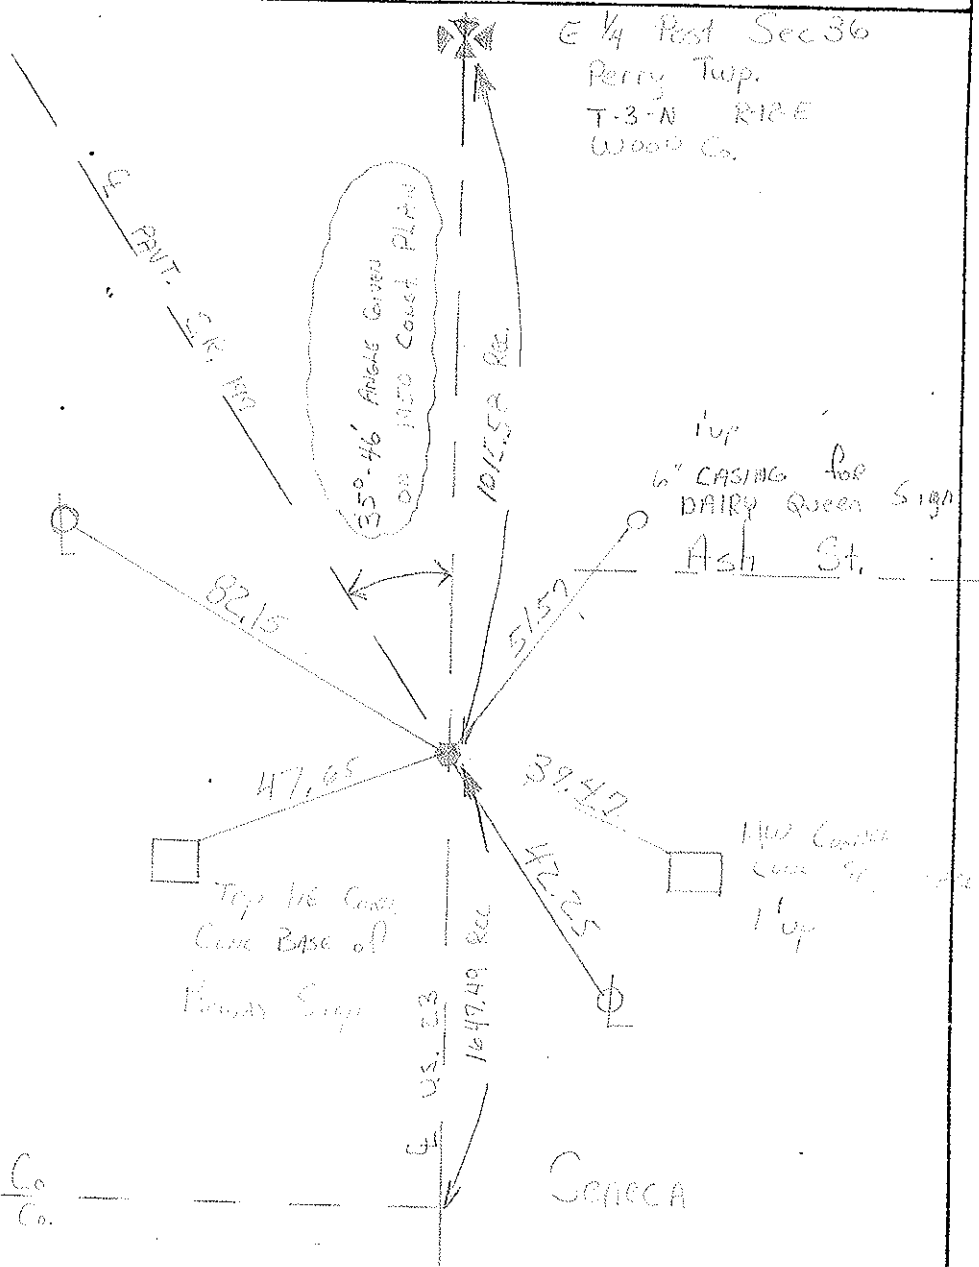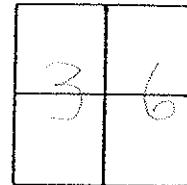


Wood Co.
HANCOCK Co.

Seneca


County WOOD-SENECA S.R. 1998 U.S. 23Date 6-21-79Township PERRYWeather CLOUDYSection 36Temp. +72°

T3N, R12E

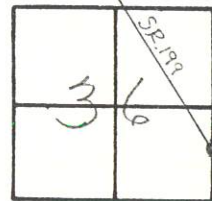Personnel BURNSIDESMITHBOWERSKNAPEMEAD

①

①

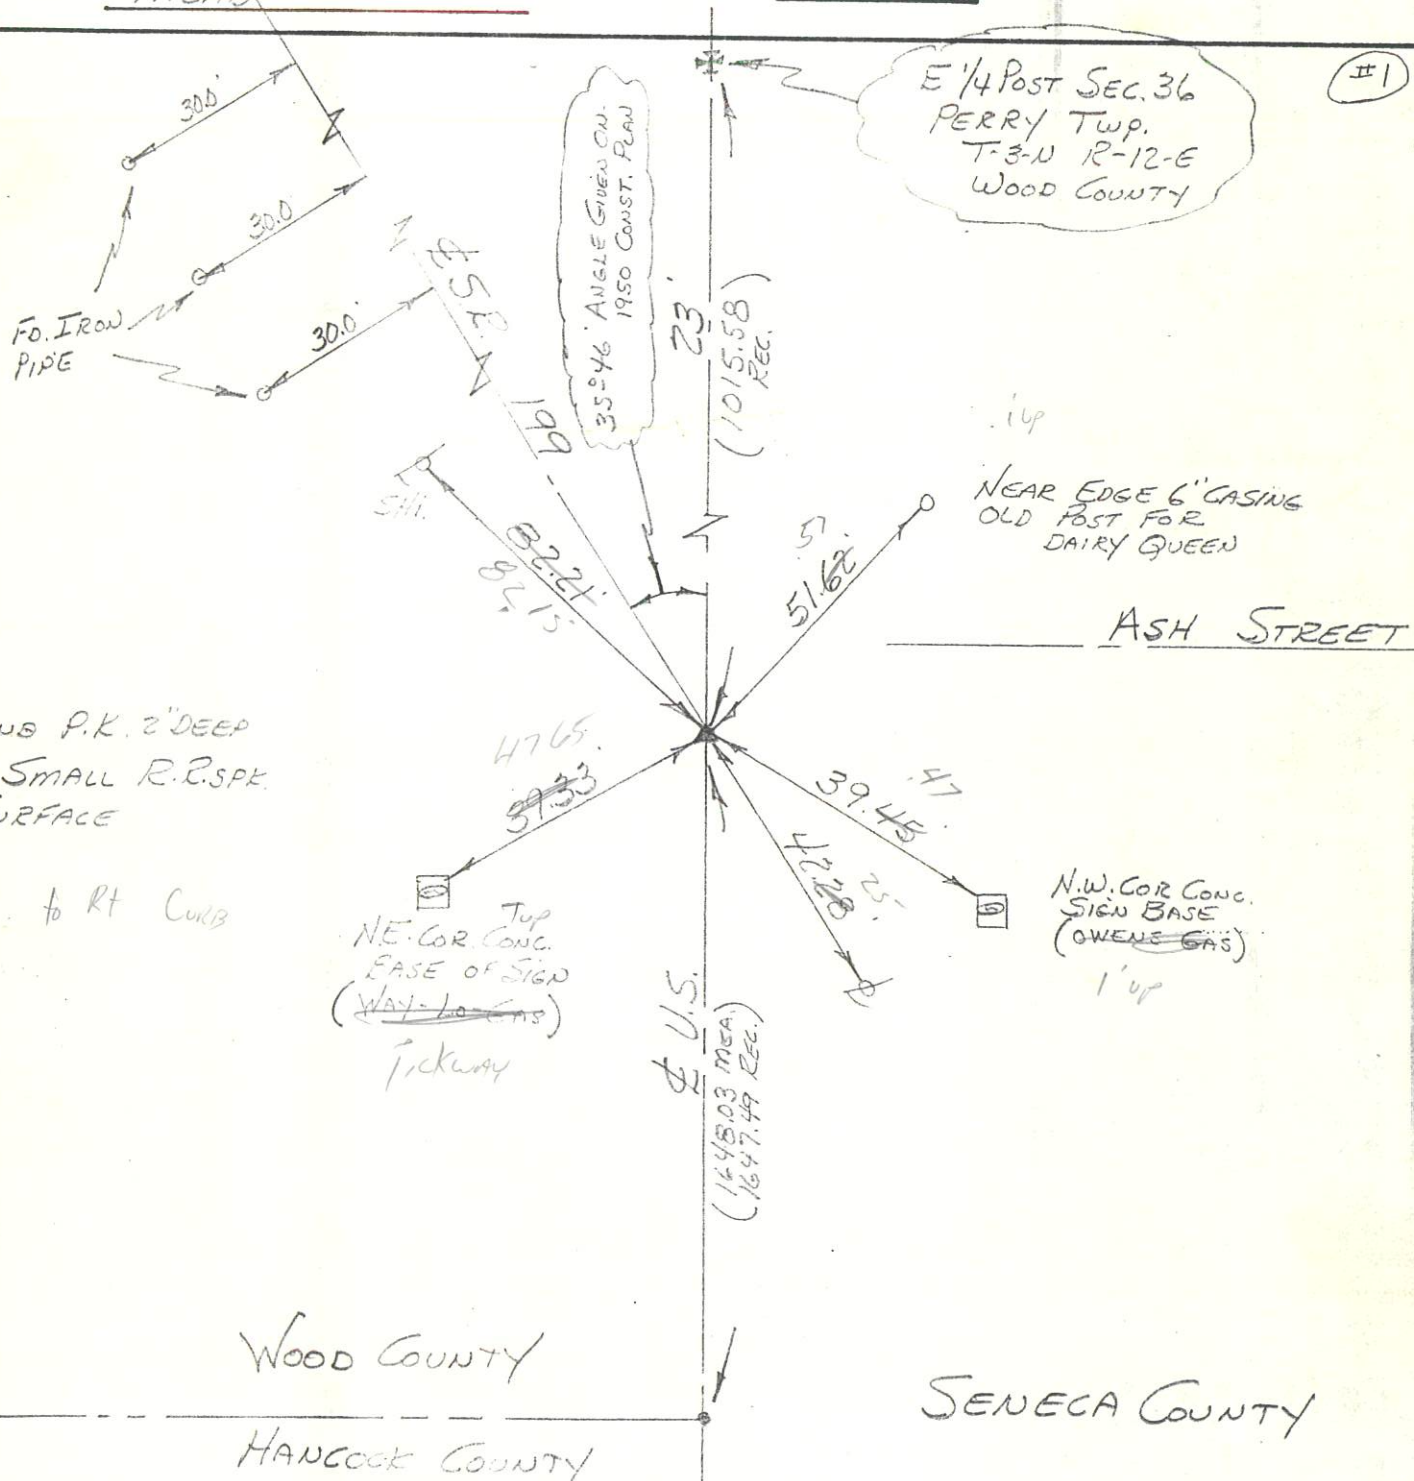

Date 6-21-79

Weather CLOUDY


Temp. +72°

N
A

BOWERS

ΚΥΡΕ

~~MEAD~~

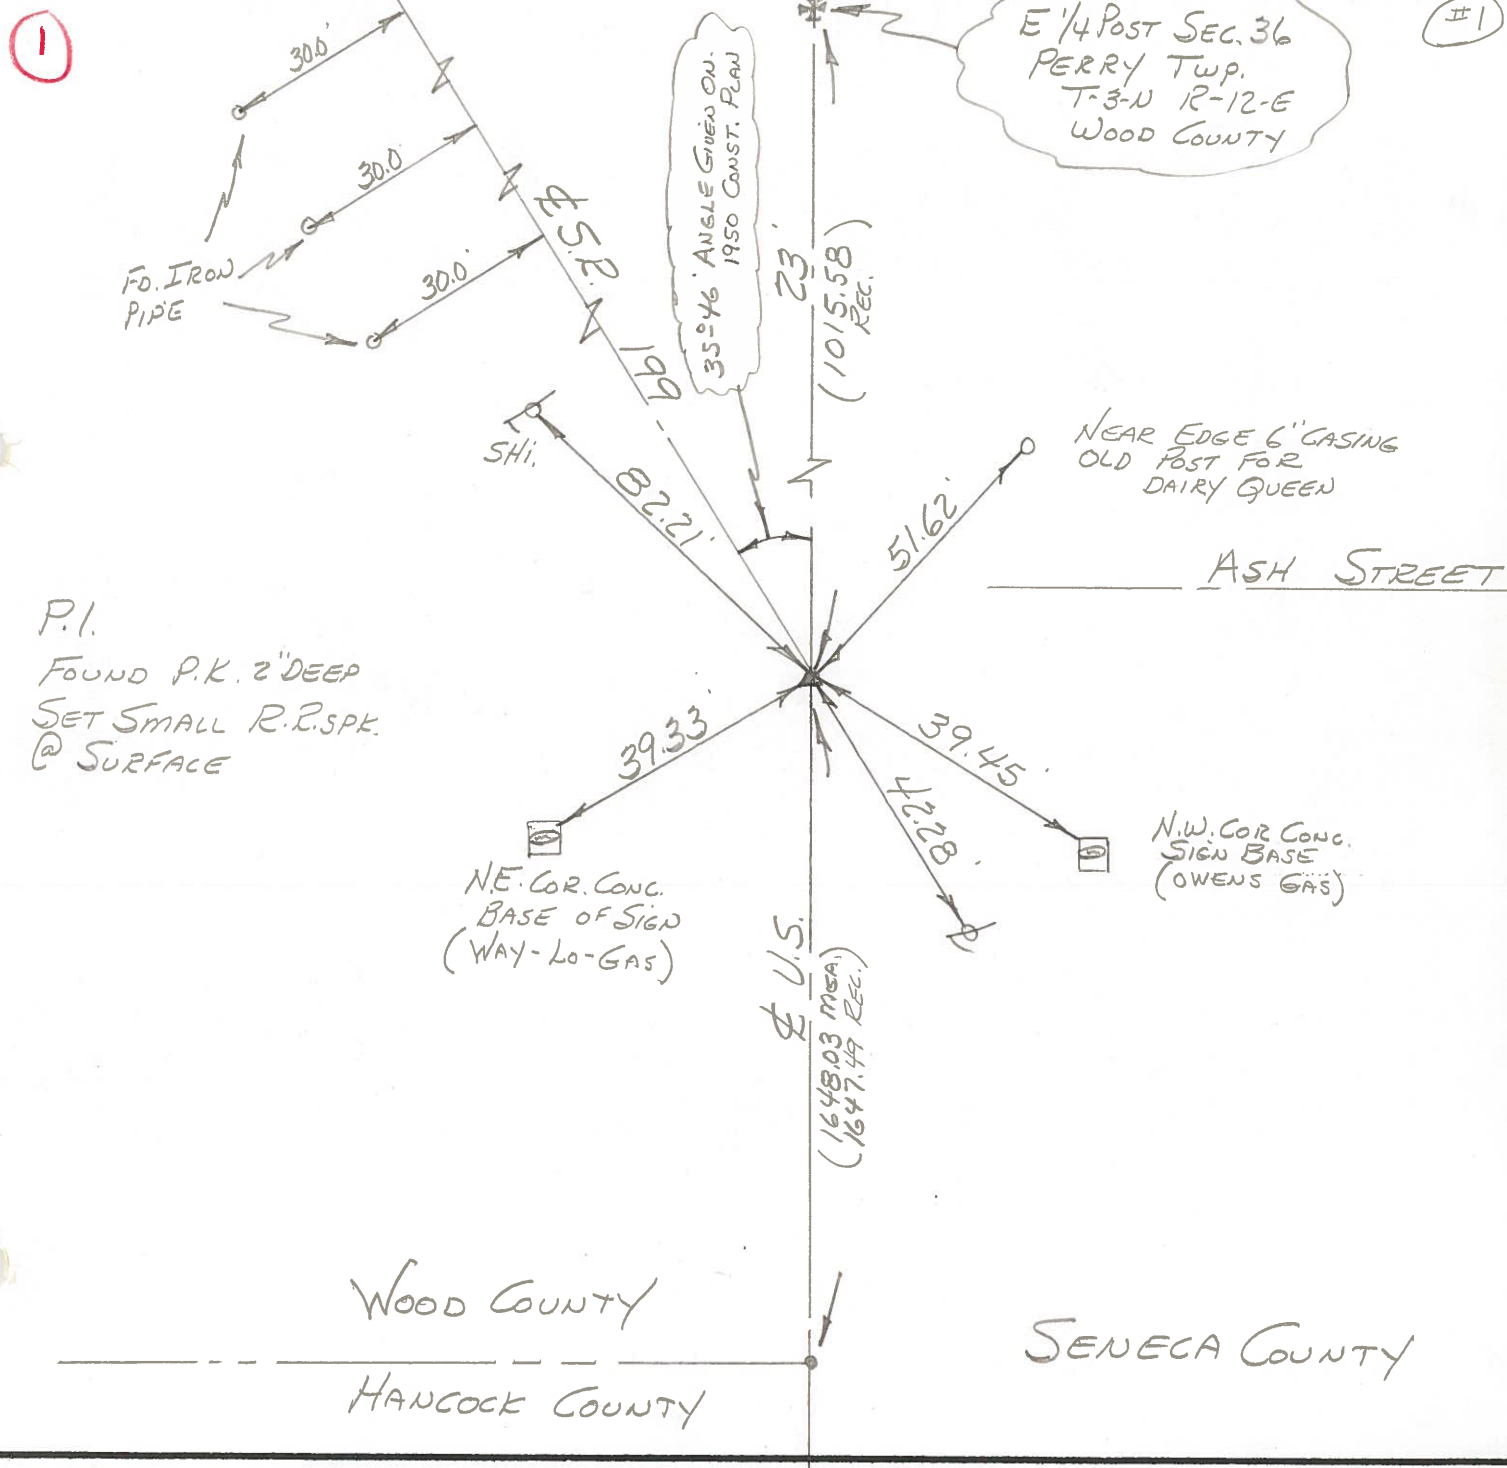

PERSONNEL	TITLE	PERSONNEL	TITLE
BURNSIDE			
SMITH			

COUNTY WOOD-SENECA DATE 12-29-71

S. R. 199 & U.S. 23 WEATHER CLEAR

SEC. FOSTORIA TEMP. +34°

DESCRIPTION _____ LEFT _____ CENTER LINE _____ RIGHT _____ JOB NO. _____

