

O.D.O.T. DISTRICT 2 SURVEY OFFICE (USE ONLY)

PERSONNEL

REFERENCE NO. 5

SHEET 8 OF 24

NOTES RHOADES

DATE 5-6-13

ROUTE SR 199

H.C. CODER

WEATHER CLOUDY

COUNTY WOOD

R.C. ROUSOS

TEMP. 55°

TOWNSHIP PERRY

SECTION 25

T 3 N R 12 E

TYPE MONUMENT P.K.NAIL


ON SURFACE - ~~BELOW~~ ON

LEFT - CL PAV'T - ~~RIGHT~~ 1.4'

7.2' TO LT EDGE PAVEMENT

S.L.M. 110+23.89

Grid: Northing: 557109.615 Easting: 1709817.853

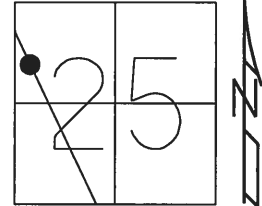

SET
SHI



72.20'

SR 199

30.13' REC

1" IPIN

39.95'

SET
SHI

SET SHI
40" MAPLE

DRIVE #2737

RECORD:
FD P.K.NAIL
6/30/88, CL
SET P.K./WASHER
7/30/90, CL
FD P.K.NAIL
REF5
10/12/11, MC
SET MAG/WASHER
FINREF5
4/29/14, TMR

O.D.O.T. DISTRICT 2 SURVEY OFFICE

PERSONNEL

REFERENCE NO. 5

SHEET 6 OF

NOTES LOEHRKE

H.C. BARNHISEL

R.C. REED

DATE 6-30-88

WEATHER Clear

TEMP. + 65

ROUTE 199

COUNTY WOOD

TOWNSHIP PERRY

SECTION 25

T 3 N R 12 E

TYPE MONUMENT PK NAIL



ON SURFACE - BELOW

LEFT - 6 PAV'T. - RIGHT 1.4'

7.2 TO Lt EDGE PAVEMENT

S.L.M. 108+29

Set P.K. / WASHER
7-30-90
C.L.

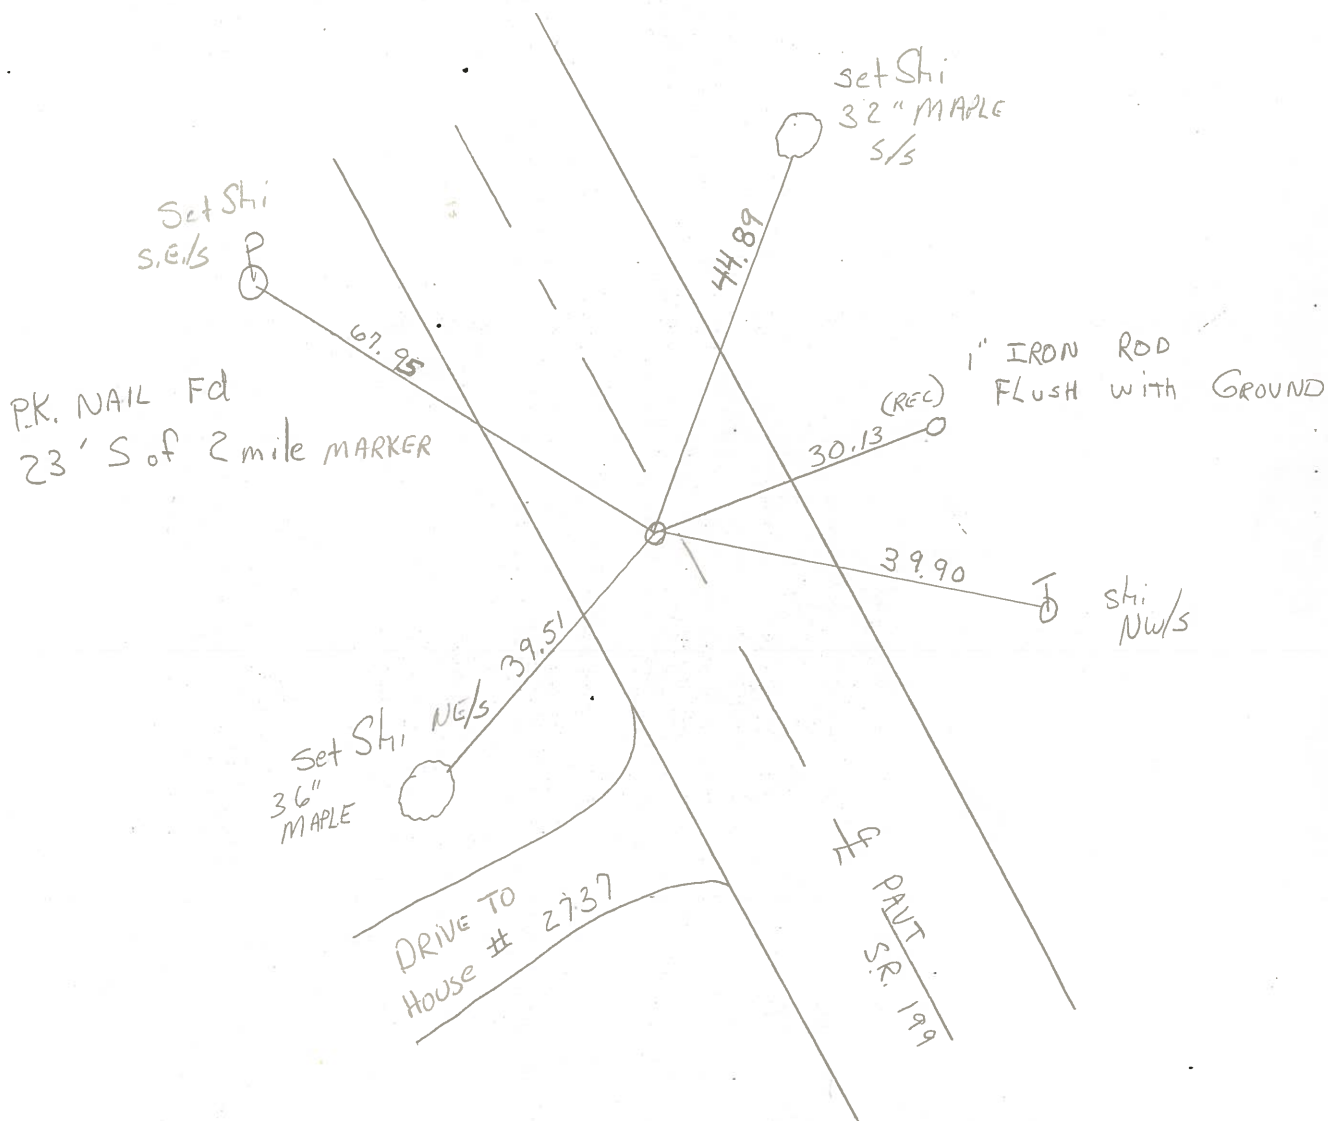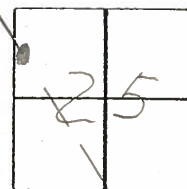

Q.D.O.T. DISTRICT 2 SURVEY OFFICE

SHEET 6 OF

County WOOD S.R. 199

Township PERRY

Section 25

T N, R E

Personnel BURNSIDE

SMITH

BOWERS

Date 1-10-71 (CHKD 5-9-80)

Weather GLEAR

Temp. +45°

23	24
26	25




#5

108+29

1.4 Lt & R AUT

P R MARK @ SURFACE

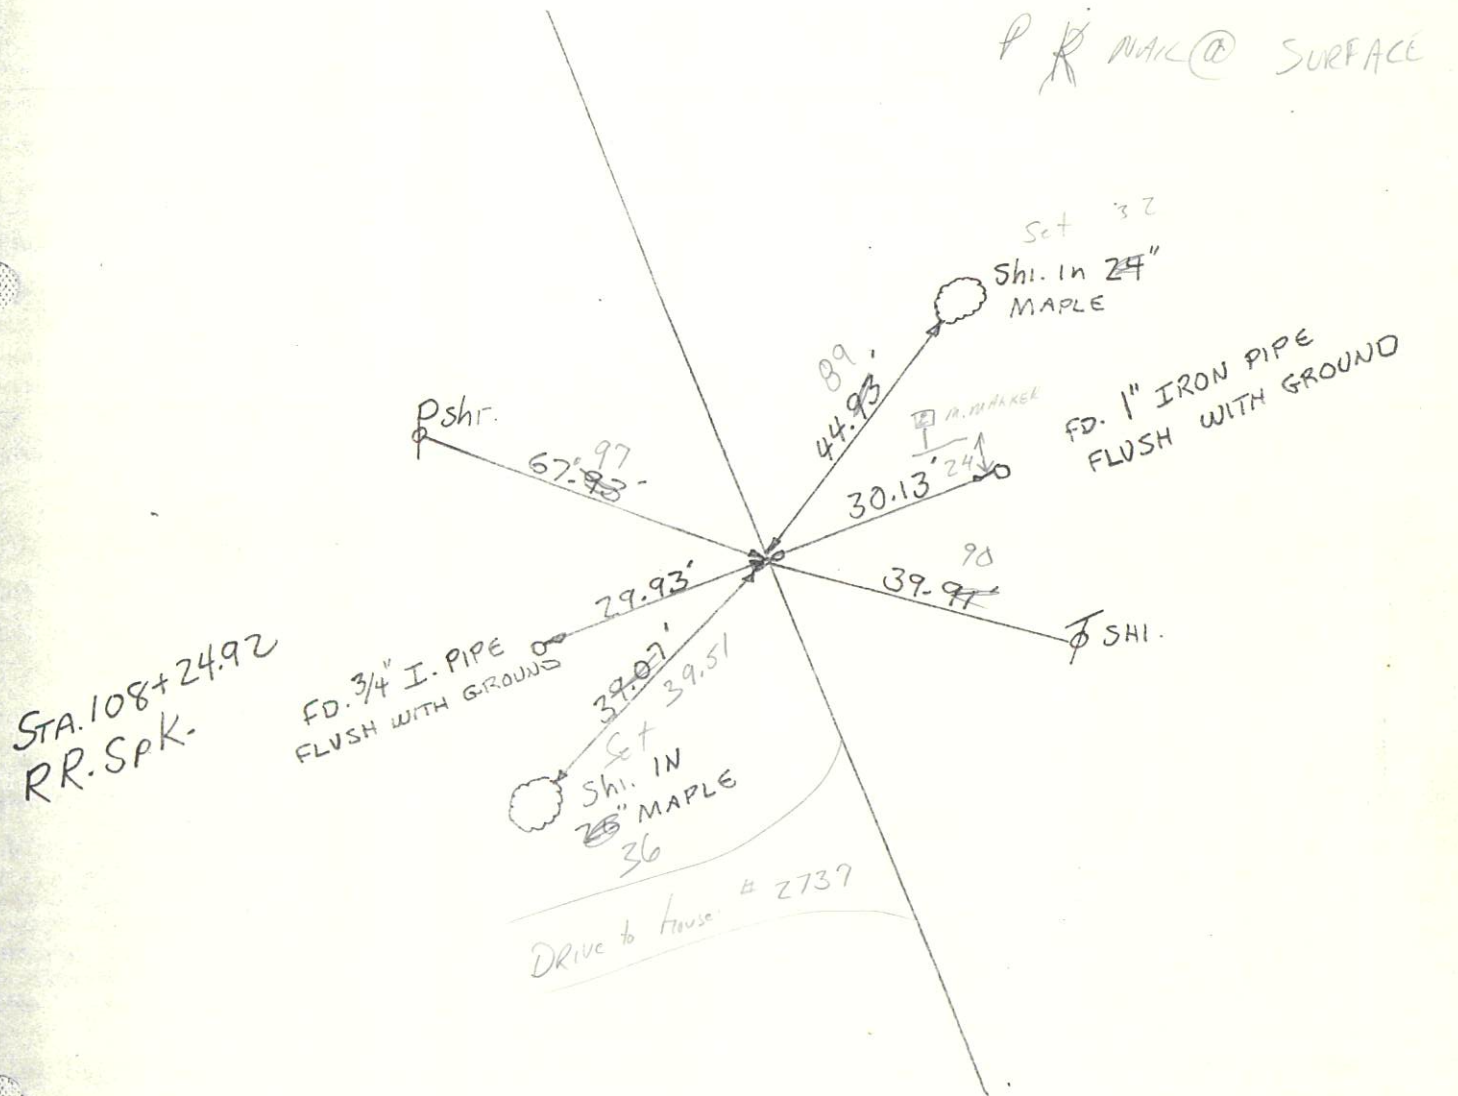

O.D.O.T. DISTRICT 2 SURVEY OFFICE

SHEET 6 OF

County WOOD S.R. 199

Township PERRY

Section 25

T N, R E

Personnel BURNSIDE

SMITH

BOWERS

Date 1-10-71 ^{CHKD} (5-9-80)


Weather GLEAR

Temp. +45°

23	24
26	25



#5

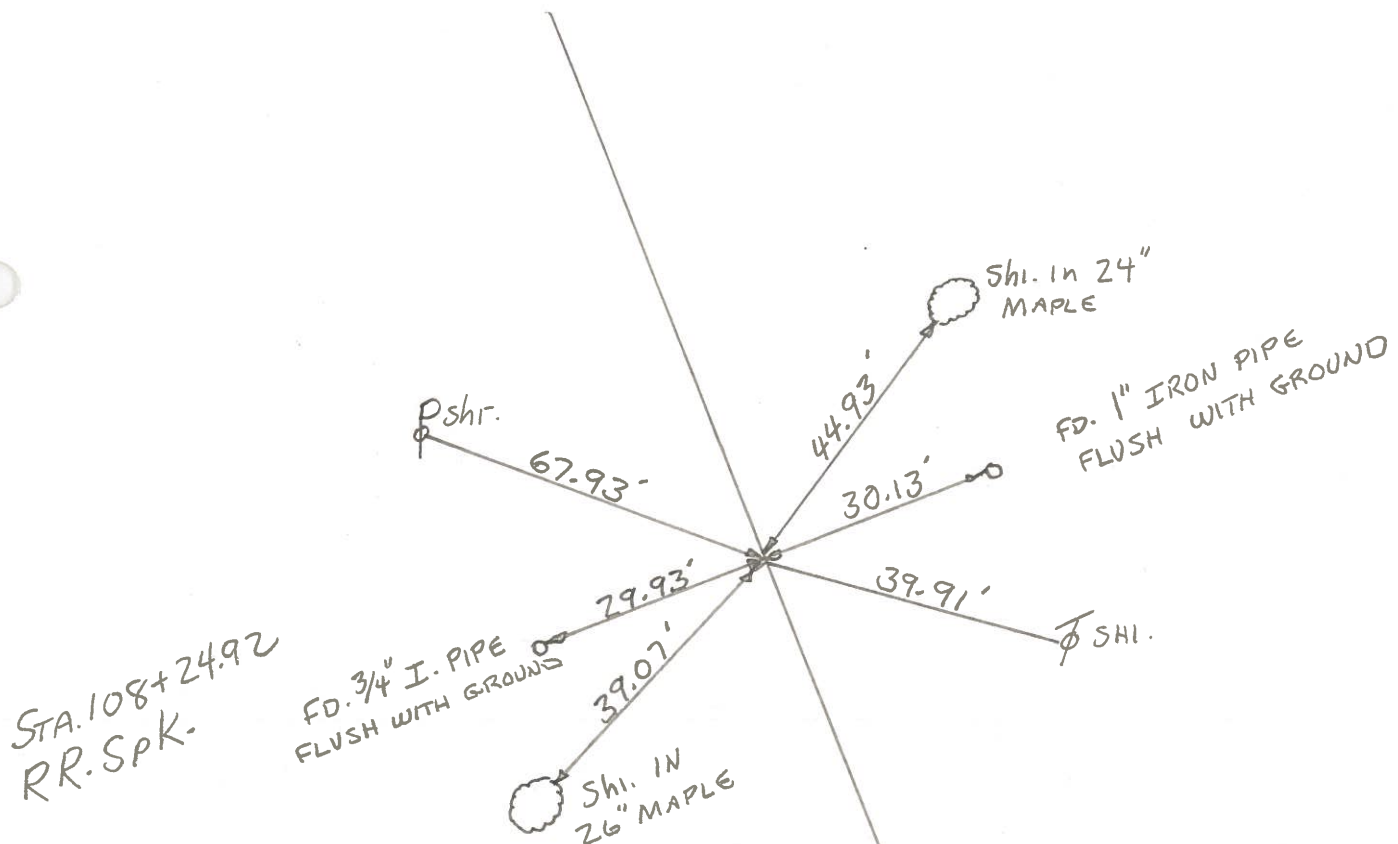

COPIED

SHEET NO. 6

OK-5-9-80

PERSONNEL TITLE PERSONNEL TITLE

COUNTY WOODDATE 1-10-71BURNSIDESMITHBOWERSS. R. 199WEATHER CLEAR

SEC. _____

TEMP. +45°

DESCRIPTION

LEFT

CENTER LINE

RIGHT

JOB NO. _____

