



O.D.O.T. DISTRICT 2 SURVEY OFFICE (USE ONLY)

PERSONNEL	REFERENCE NO.	6	SHEET	9	OF	24
NOTES	RHOADES	DATE	5-6-2013	ROUTE	SR 199	
H.C.	CODER	WEATHER	CLOUDY	COUNTY	WOOD	
R.C.	ROUSOS	TEMP.	55°	TOWNSHIP	PERRY	
				SECTION	25	
				T	3	N
				R	12	E

TYPE MONUMENT 1" IPIN
~~ON SURFACE~~ - BELOW 4"
 LEFT - ℄ PAV'T - ~~RIGHT~~ 17.1'
5.4' TO LT EDGE PAVEMENT
 S.L.M. 131+91.37
 Grid: Northing: 558922.157 Easting: 1708629.379

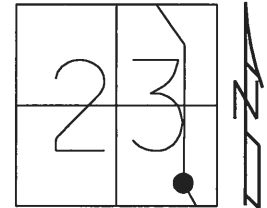

RECORD: P.I.
 STA 129+92.66
 $\Delta = 20^\circ 49'$ RT
 MEAS. BY J. CRONIN
 P.I. STA 113+37
 $\Delta = 20^\circ 55'$ RT
 INFO FROM SURVEY FIELD
 BOOK #R-72 IN
 WOOD CO. COURT
 HOUSE DATED 1920
 FD IPIPE
 2" DOWN
 6/30/88, CL
 FD 1" IPIN
 REF6
 10/12/11, MC
 4" DOWN
 FINREF6
 4/29/14, TMR

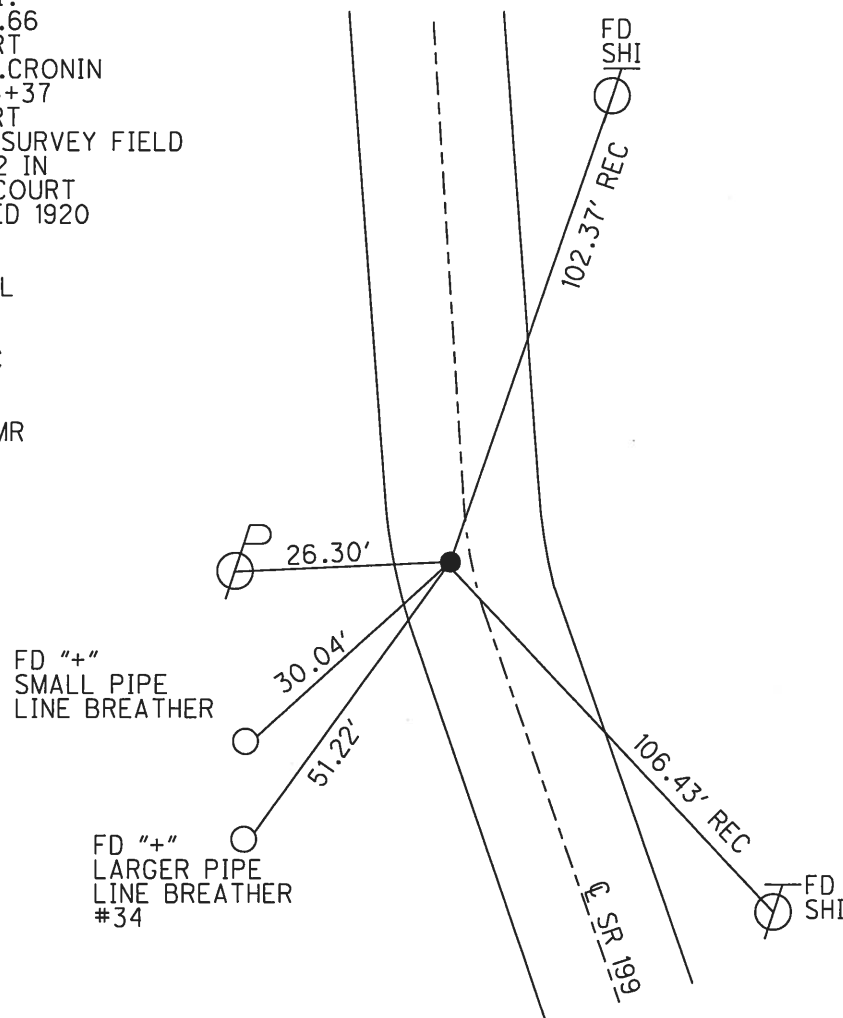

O.D.O.T. DISTRICT 2 SURVEY OFFICE

PERSONNEL

REFERENCE NO. 6

SHEET OF

NOTES LOEHRKE

H.C. BARNHISEL

R.C. REED

DATE 6-30-88

WEATHER Clear

TEMP. +65

ROUTE 199

COUNTY WOOD

TOWNSHIP PERRY

SECTION 23

T 3 N R 12 E


TYPE MONUMENT IRON PIPE OK 7-30-90 C.L.

ON SURFACE - BELOW 2"

LEFT-~~E~~ PAV'T. - RIGHT 1.9 Lt of Lt BERM


1.9 TO Lt EDGE PAVEMENT

S.L.M. 129+94

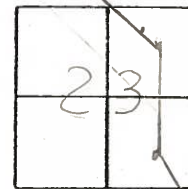

Note: P.I. Sta. 129+92.66
 $\Delta = 20^{\circ} 49' R$
 meas. by J. CRONIN

Note P.I. Sta 113+37
 $\Delta = 20^{\circ} 55' R$
 INFORMATION FROM SURVEY FIELD
 Book # R-72, IN WOOD Co. COURT
 House DATED 1920

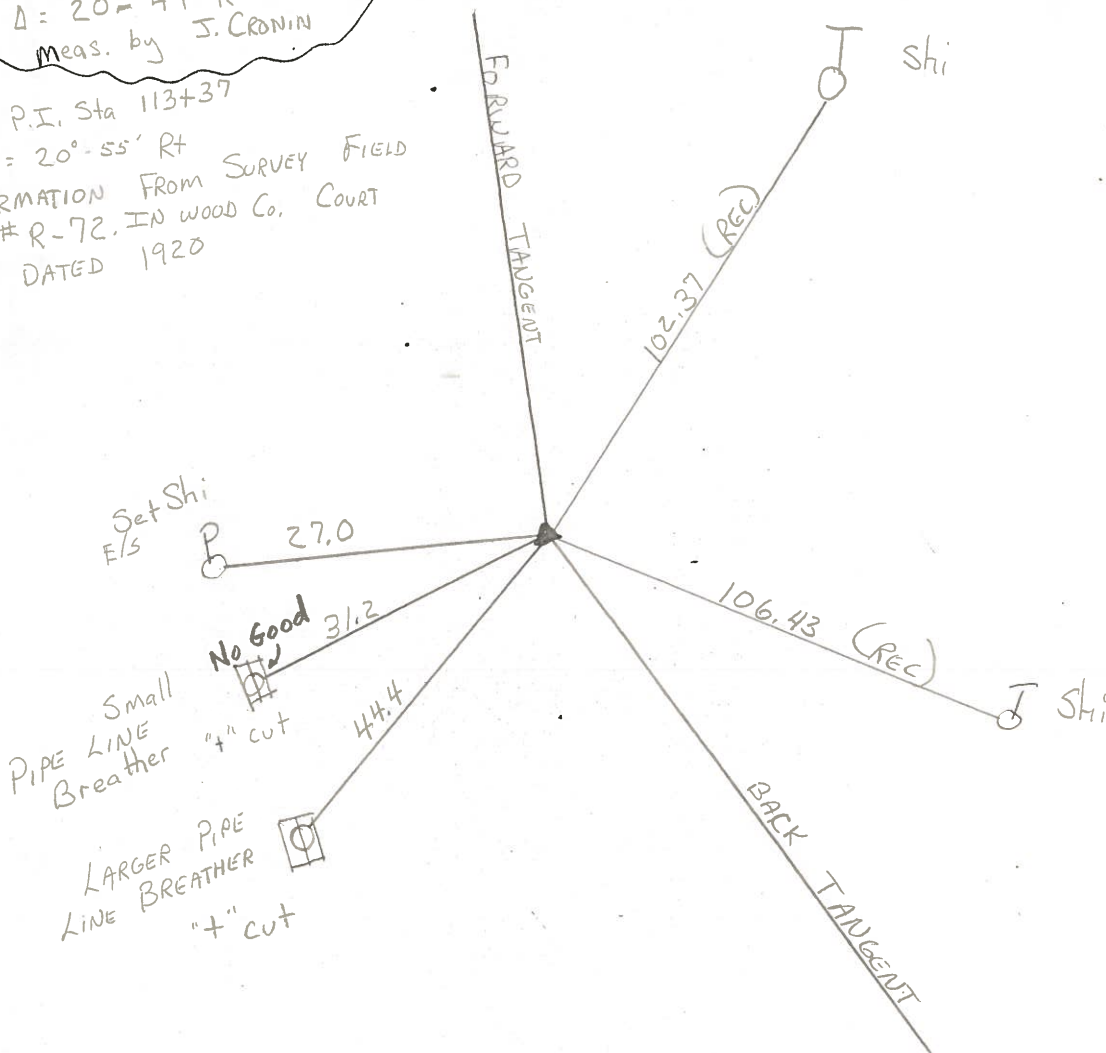

County WOOD S.R. 199

Township PERRY

Section _____

T N, R E

Personnel BURNSIDE

SMITH

BOWERS

Date 1-10-72 (CHKD 5-9-80)

Weather CLEAR

Temp. + 45°

15	14
22	23



#6

Fd PIPE
In Very Poor COND.


1.9 L of L+E BERM
2" Below

P.I. STA. 129+92.66
IRON PIPE IN BERM
2.5' W. OF W. EDGE
PAVEMENT
 $\Delta = 20^{\circ}-49'$ RT. { MEAS. BY J. CROWIN

NOTE:
P.I. STA. 113+37
 $\Delta = 20^{\circ}-55'$ RT.
INFORMATION FROM
SURVEY FIELD BOOK # R-72
IN WOOD COUNTY COURT
HOUSE DATED - 1920

NEAR EDGE
PIPE LINE PIPE
BREATHING PIPE

FACE 6" CASING
CORNER FENCE
POST 1' ABOVE
GROUND

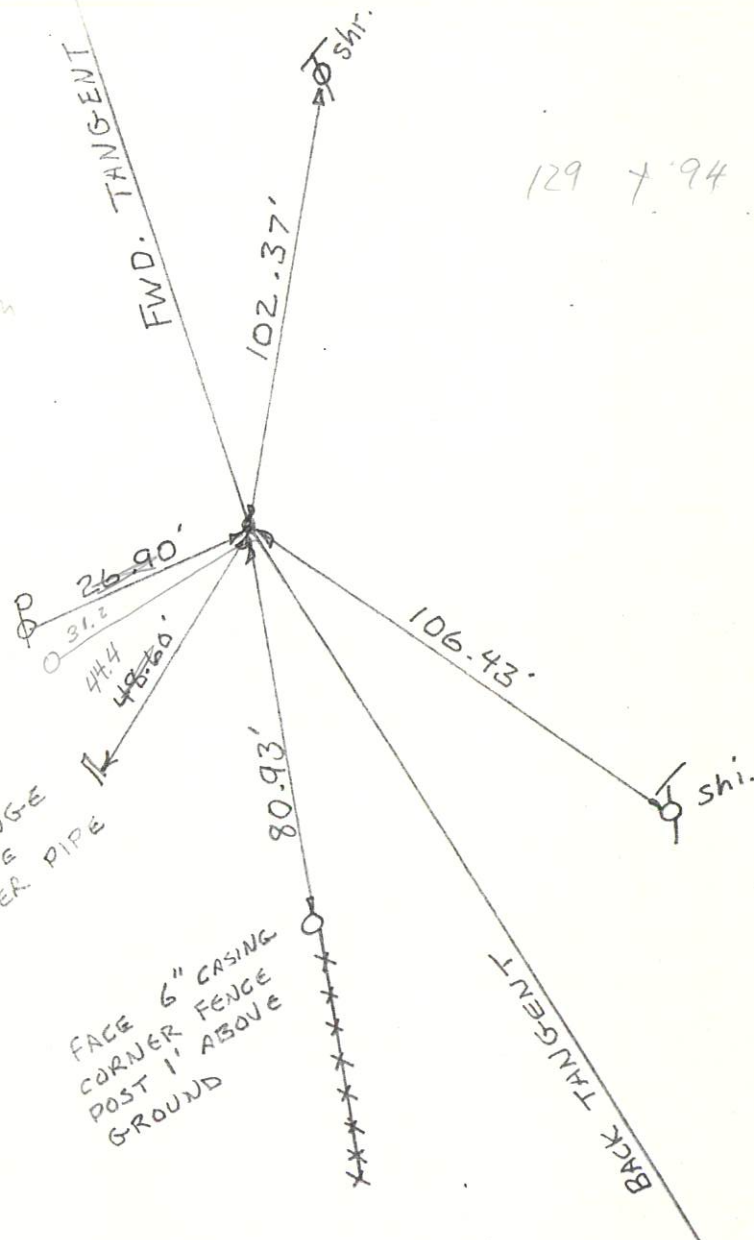

O.D.O.T. DISTRICT 2 SURVEY OFFICE

SHEET 7 OF

County WOOD S.R. 199

Township PERRY

Section _____

T N, R E

Personnel BURNSIDE

SMITH

BOWERS

Date 1-10-72 (CHKD 5-9-80)

Weather CLEAR

Temp. + 45°

15	14
22	23




#6

P.I. STA. 129+92.66
IRON PIPE IN BERM
2.5' W. OF W. EDGE
PAVEMENT
 $\Delta = 20^{\circ}-49'$ RT. { MEAS. BY
J. CROVIN

NEAR EDGE
PIPE LINE
BREATHING PIPE

FACE 6" CASING
CORNER FENCE
POST 1' ABOVE
GROUND

NOTE:
P.I. STA. 113+37
 $A = 20^{\circ}-55'$ RT.
INFORMATION FROM
SURVEY FIELD BOOK # R-72
IN WOOD COUNTY COURT
HOUSE DATED - 1920

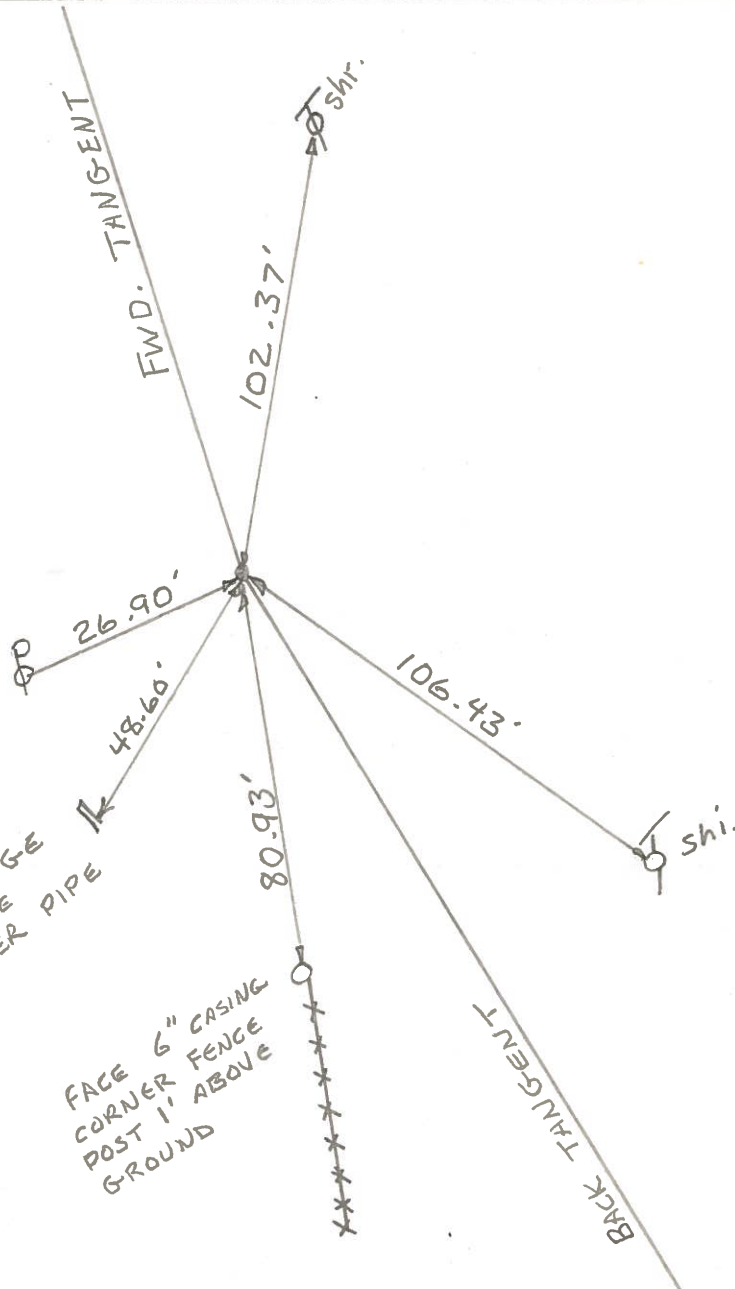

COPIED

SHEET NO. 7

OK-5-9-80

DATE 1-10-72

PERSONNEL TITLE PERSONNEL TITLE

BUENSIDE

COUNTY Wood

SMITH

S. R. 199WEATHER CLEAR

BOWERS

SEC. _____

TEMP. +45°DESCRIPTION 1ST CURVE SOUTH OF BRANDERBERRY ROAD

JOB NO. _____

LEFT

CENTER LINE

RIGHT

P.I. STA. 129+92.66
 IRON PIPE IN BERM
 2.5' W. of W. EDGE
 PAVEMENT
 $\Delta = 20^{\circ} 49' \text{ RT.}$ { MEAS. BY J. CRONIN

NEAR EDGE
 PIPE LINE
 BREATHER PIPE

NOTE:
 P.I. STA. 113+37
 $\Delta = 20^{\circ} 55' \text{ RT}$

INFORMATION FROM
 SURVEY FIELD BOOK #R-72
 IN WOOD COUNTY COURT
 HOUSE DATED - 1920

FACE 6' CASE-
 ING COR. FENCE
 POST 1' ABOVE
 GROUND

FWD. TANGENT

102.37'

SHI.

SHI. 26.90'

48.60'

80.93'

106.43'

BK. TANGENT

