
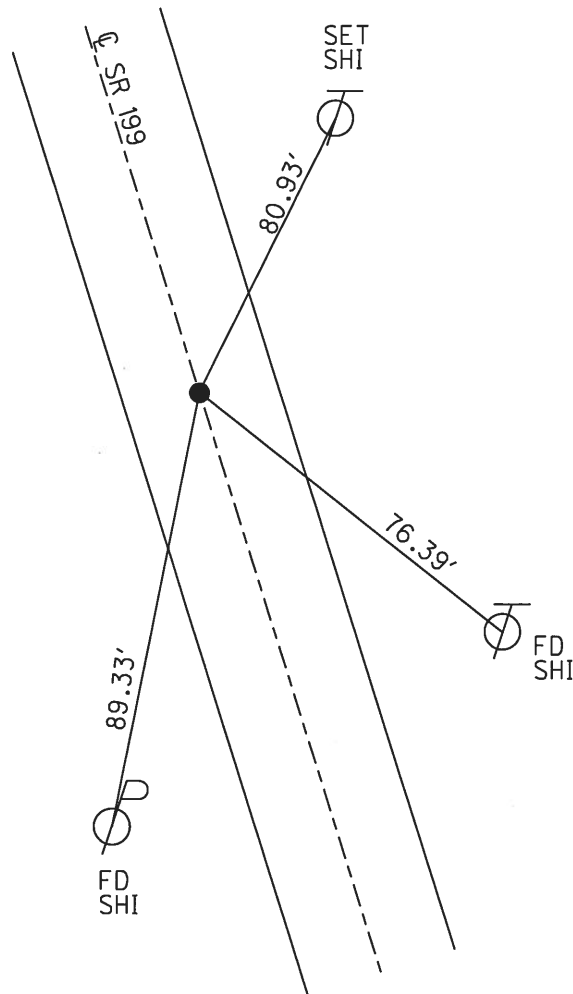


O.D.O.T. DISTRICT 2 SURVEY OFFICE (USE ONLY)

PERSONNEL _____ REFERENCE NO. 9 SHEET 13 OF 24
 NOTES RHOADES DATE 5-6-13 ROUTE SR 199
 H.C. CODER WEATHER FAIR COUNTY WOOD
 R.C. ROUSOS TEMP. 65° TOWNSHIP PERRY
 _____ SECTION 23
 _____ T 3 N R 12 E

TYPE MONUMENT P.K./WASHER
 ON SURFACE - ~~BELOW~~ ON
~~LEFT~~ - Q PAV'T - RIGHT 0.4
11 TO RT EDGE PAVEMENT
 S.L.M. 179+75.97
 Grid: Northing: 563354.421 Easting: 1707054.538

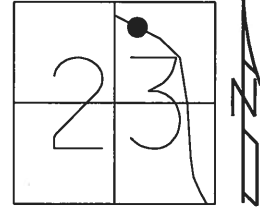

RECORD:
 FD P.K.NAIL
 7/11/88, CL
 SET P.K./WASHER
 7/30/90, CL
 FD P.K./WASHER
 REF9
 10/13/11, MC
 SET MAG/WASHER
 FINREF9
 4/29/14, TMR

O.D.O.T. DISTRICT 2 SURVEY OFFICE

PERSONNEL

REFERENCE NO. 9

SHEET OF

NOTES LOGHRKE

H.C. BARNHISEL

R.C. Reed

DATE 7-11-88

WEATHER Cloudy

TEMP. 80

ROUTE 199

COUNTY WOOD

TOWNSHIP Perry

SECTION 23

T 3 N R 12 E

TYPE MONUMENT P.K. NAIL

ON SURFACE - BELOW

~~LEFT~~ - C PAV'T. - RIGHT 0.4


IL TO RT EDGE PAVEMENT

S.L.M. 177+82


Set P.K. / WASHER

7-30-90

C.L.

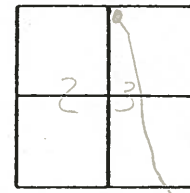

REC.
P.O.T.

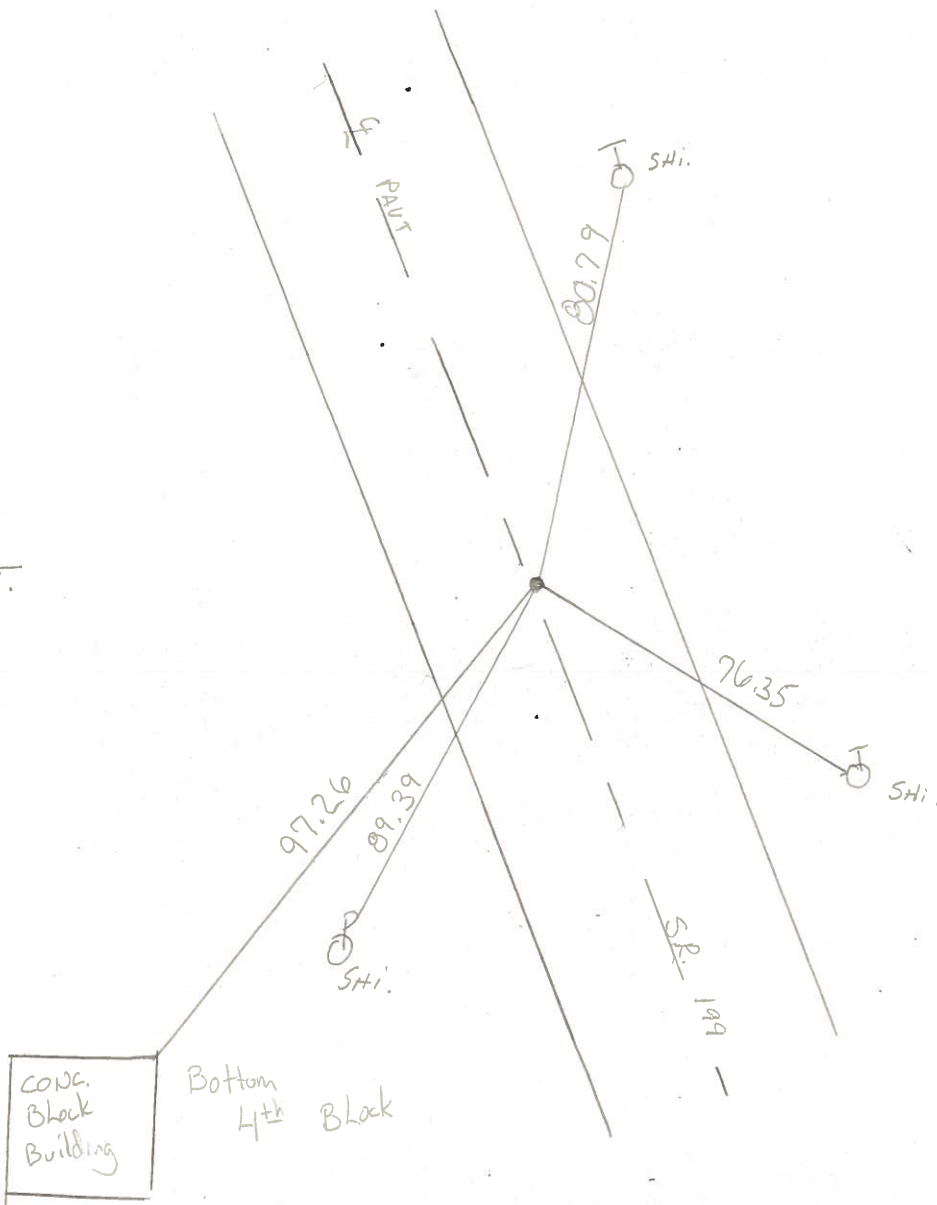

O.D.O.T. DISTRICT 2 SURVEY OFFICE

SHEET 10

OF

County WOOD S.R. 199

Township PERRY

Section 23

T N, R E

Personnel BURNSIDE

SMITH

BOWERS

MEAD

Date 3-28-72 - (^{CRD.} 5-9-80)

Weather CLEAR

Temp. +40°

15	14
22	23




#9

PK NAIL ON RT & PAUT + 82

NOTE: P.O.T. IS 4000'±
SOUTH OF EAGLEVILLE
ROAD OR 2400'±
NORTH OF BRANDEBERRY
ROAD

P.O.T.
SET P.C.

Gr. Conc. Bldg.
J.L. MURPHY
RES.

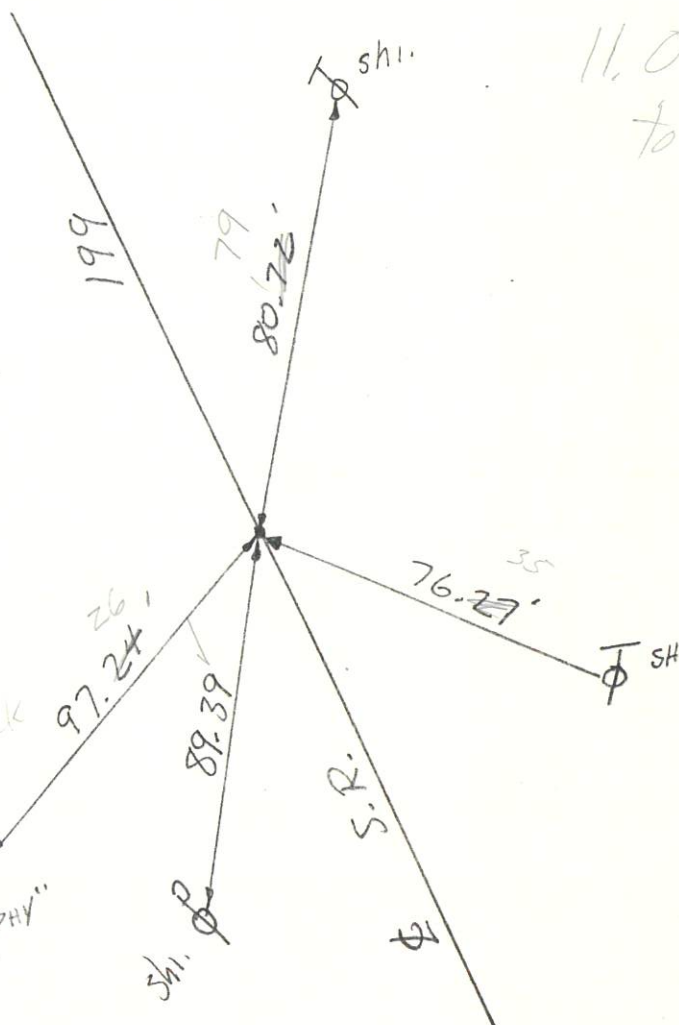

ODOT DISTRICT 2 SURVEY OFFICE

SHEET 10

OF

County WOOD S.R. 199

Township PERRY

Section 23

T N, R E

Personnel BURNSIDE

SMITH

BOWERS

MEAD

Date 3-28-72 - (^{CRD.}5-9-80)

Weather CLEAR

Temp. +40°

15	14
22	23




#9

NOTE: P.O.T. IS 4000'±
SOUTH OF EAGLEVILLE
ROAD OR 2400'±
NORTH OF BRANDEBERRY
ROAD

P.O.T.
SET P.C.

Cor. Conc. Bldg.
J.L. MURPHY
RES.

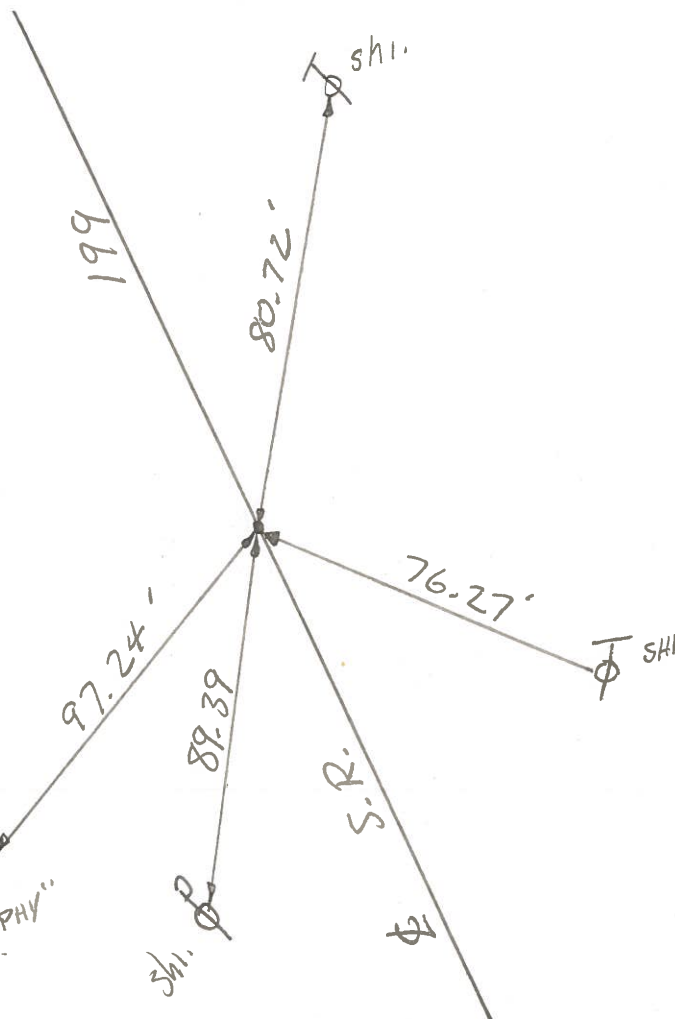

COPIED

SHEET NO. 10
OK-5-9-80
DATE 3-28-72

PERSONNEL	TITLE	PERSONNEL	TITLE
BURNSIDE			
SMITH			
BOWERS			

COUNTY WoodDATE 3-28-72S. R. 199WEATHER CLEAR

SEC. _____

TEMP. +40°DESCRIPTION P.O.T. Top of Hill @ J.L. MURPHY RES.

JOB NO. _____

LEFT

CENTER LINE

RIGHT

NOTE: P.O.T. IS 4000'±
SOUTH OF EAGLEVILLE
ROAD OR 2400'±
NORTH OF BRANDEBERY
ROAD

P.O.T.
SET. P.K.

COR. CONC.
BLK. 111
BLDG.
(J.L. MURPHY)
RES.

97.24'

89.39'

199

80.77'
80.72'

76.27'

SHI.

SHI.

S.R.

±

