

O.D.O.T. DISTRICT 2 SURVEY OFFICE (USE ONLY)

PERSONNEL

REFERENCE NO.

10

SHEET

14

OF

24

NOTES ROUSOS

DATE

5-6-13

ROUTE SR 199

H.C. HOMAN

WEATHER

FAIR

COUNTY WOOD

R.C. GABLE

TEMP.

65°

TOWNSHIP PERRY

SECTION 14

T 3 N R 12 E

TYPE MONUMENT P.K. NAIL



ON SURFACE - ~~BELOW~~ ON

LEFT - Q PAV'T - ~~RIGHT~~ 0.4'

11.2 TO LT EDGE PAVEMENT

S.L.M. 194+06.07

Grid: Northing: 564505.605 Easting: 1706206.070

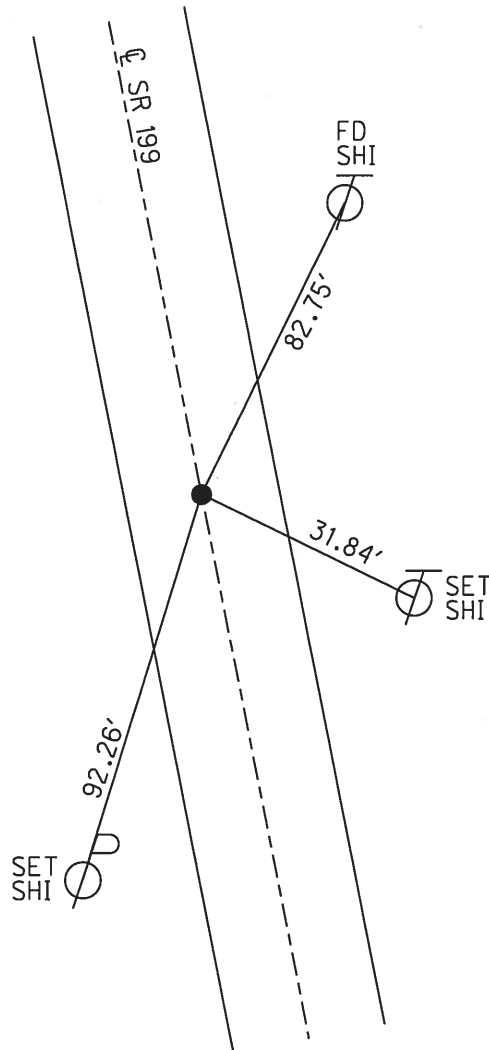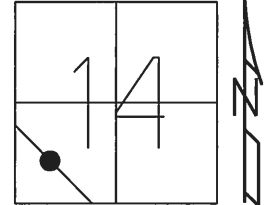

RECORD:
FD P.K.NAIL
7/11/88, CL
SET P.K./WASHER
7/30/90, CL
FD P.K./WASHER
REF10
10/13/11, MC
SET MAG/WASHER
FINREF10
4/29/14, TMR

O.D.O.T. DISTRICT 2 SURVEY OFFICE

PERSONNEL

REFERENCE NO. 10

SHEET OF

NOTES LOEHKE

H.C. BARNHISEL

R.C. REED

DATE 7-11-88

WEATHER Pt Cloudy

TEMP. +80

ROUTE SR 199

COUNTY L1000

TOWNSHIP Perry

SECTION 14

T. 3 N. R. 12 E.

TYPE MONUMENT P.K. NAIL



ON SURFACE - BELOW Yes

LEFT - & PAV'T. - RIGHT Yes

11.2 TO Lt EDGE PAVEMENT

S.L.M. 192 +14

Set P.K. NAIL
E WASHER
7-30-90
C.L.

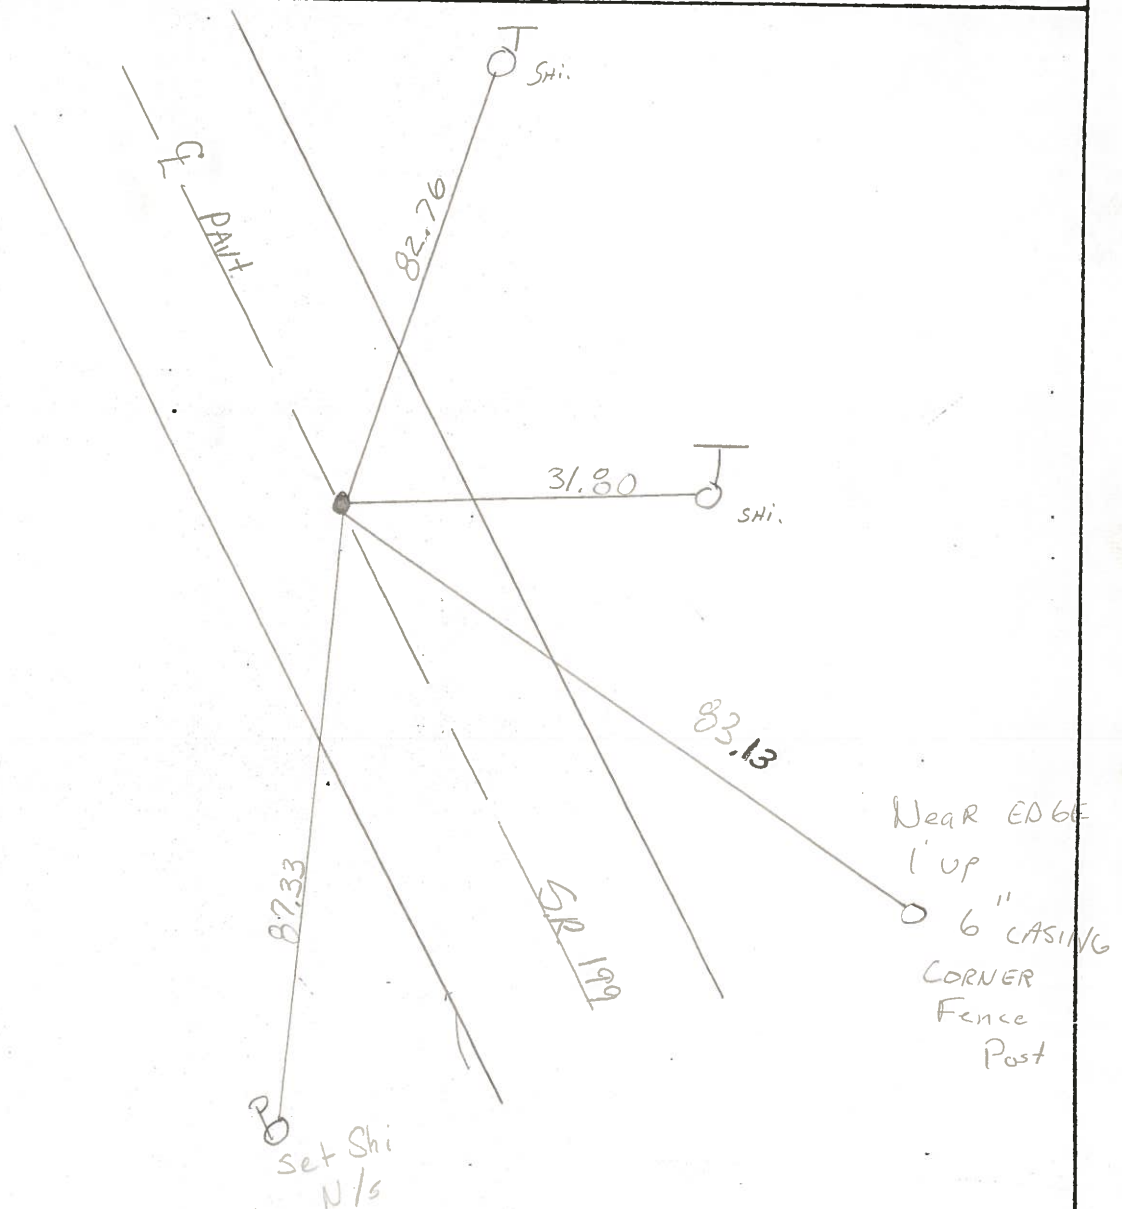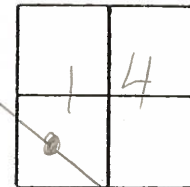

SHEET 11 OF

Date 3-28-72

CHKD.
5-9-80

Weather. CLEAR

Temp. +40°


T_N, R_E

Personnel BURNSIDE

SMITH

BOWERS


$M \in AD$

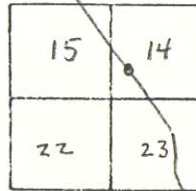

#10

+ 14

ON G

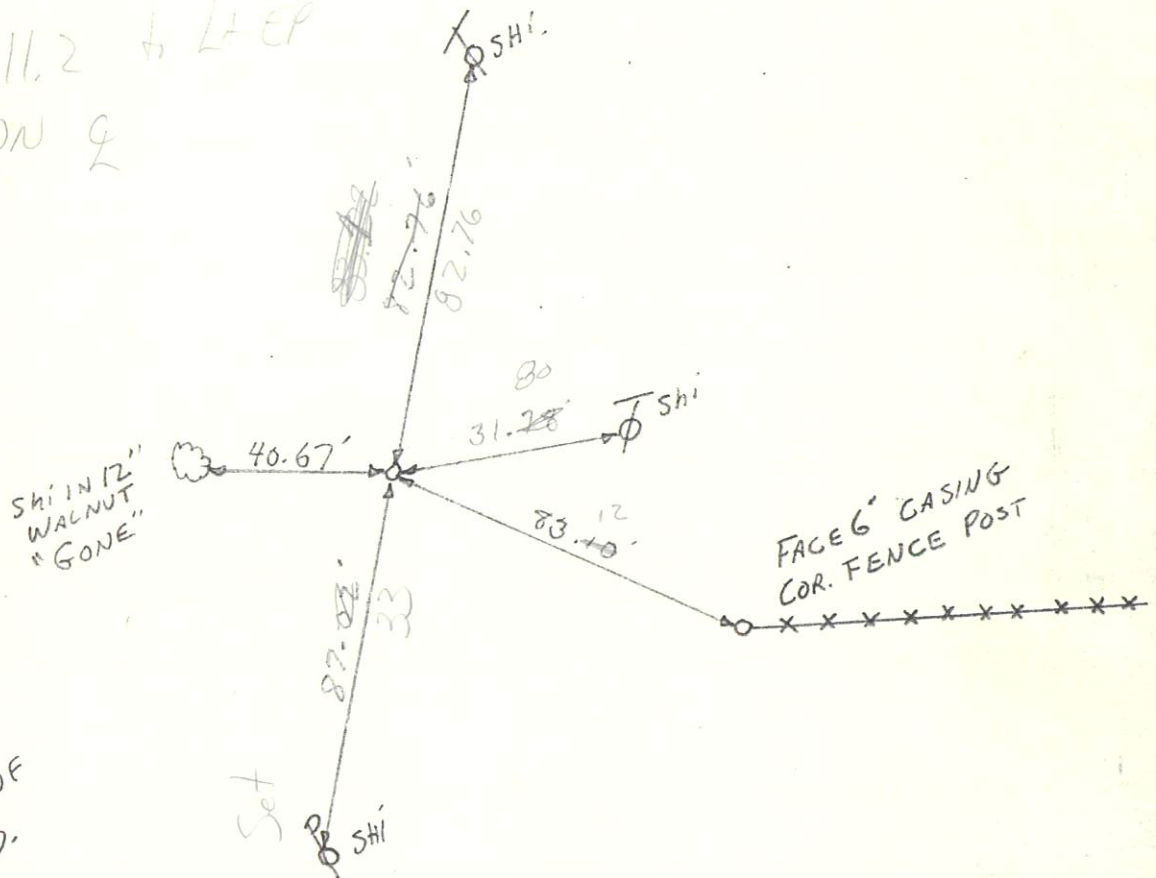

P.I. STA 175+53.5
 $\Delta = 6^{\circ} - 02' \text{ LT.}$
 SET P.K.
 SOUTH

P.I.
 $\Delta = 0^{\circ} - 02$
SET. P.K.
2nd P.I. SOUTH OF
EAGLEVILLE RD.

89 13
 90 14
 75 53
 14 89

O.D.O.T. DISTRICT 2 SURVEY OFFICE

SHEET 11 OF 11

County WOOD S.R. 199

Township PERRY

Section 14

T N, R E

Personnel BURNSIDE

SMITH

BOWERS

MEAD

Date 3-28-72 ^{CHKD.} 5-9-80

Weather CLEAR


Temp. +40°

15	14
22	23



#10

P.I. STA 175+53.5
 $\Delta = 6^{\circ} - 02' \text{ LT.}$
 SET P.K.
 2nd P.I. SOUTH OF
 EAGLEVILLE RD.

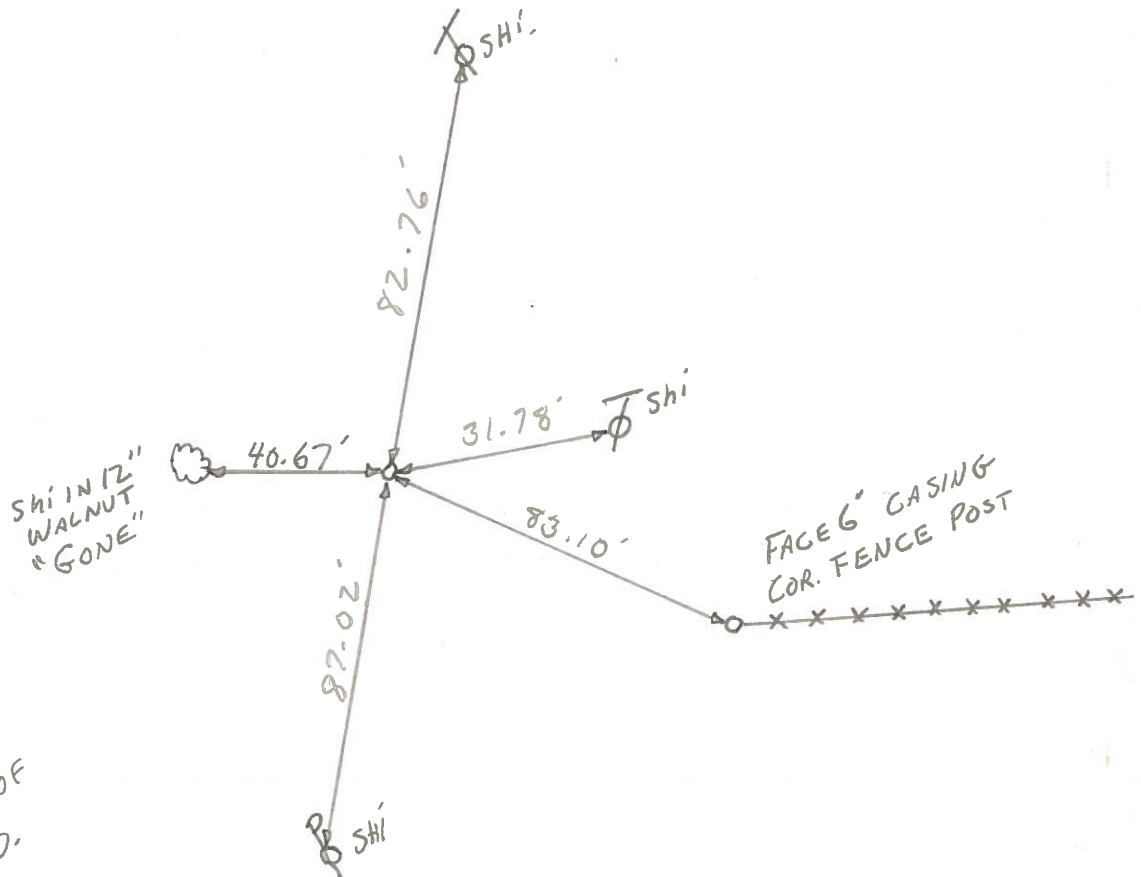

COPIED

SHEET NO. 11

OK-5-9-80

DATE 3-28-72

PERSONNEL TITLE PERSONNEL TITLE

BURNSIDE

COUNTY WOOD

SMITH

S. R. 199WEATHER CLEAR

BOWERS

SEC. _____

TEMP. +40°DESCRIPTION 2ND P.I. SOUTH OF EAGLEVILLE RD.

JOB NO. _____

LEFT

CENTER LINE

RIGHT

10
 P.I. STA. 175+53.5
 $\Delta = 0^\circ 02' \text{ LT.}$
 SET. P.K.

SHI. IN 12"
 WALNUT
 GONE

80.67

87.02
~~87.02~~

82.76

31.78

83.10

FACE 6" CASEING
 COR. FENCE POST

