

O.D.O.T. DISTRICT 2 SURVEY OFFICE (USE ONLY)

PERSONNEL

REFERENCE NO.

11

SHEET

16

OF 24

NOTES

ROUSOS

DATE

5-6-13

ROUTE

SR 199

H.C.

HOMAN

WEATHER

CLOUDY

COUNTY

WOOD

R.C.

GABLE

TEMP.

65°

TOWNSHIP

PERRY

SECTION

14

T 3 N R 12 E

TYPE MONUMENT

P.K./WASHER

ON SURFACE - ~~BELOW~~

ON

LEFT - CL PAV'T - ~~RIGHT~~

0.5'

10.6 TO LT EDGE PAVEMENT

S.L.M.


208+94.11

Grid: Northing:

565703.211

Easting:

1705322.954

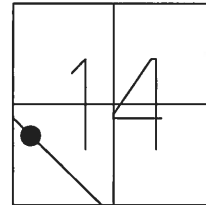

NEAR EDGE IRON
HITCHING POST



96.34' REC

FD
SHI



30.55'

CL SR 199

SET
SHI

84.20'

52.91'

SET
SHI

RECORD:

FD P.K.NAIL

7/11/88, CL

SET P.K./WASHER

7/30/90, CL

FD P.K./WASHER

REF11

10/13/11, MC

SET MAG/WASHER

FINREF11

4/29/14, TMR

O.D.O.T. DISTRICT 2 SURVEY OFFICE

PERSONNEL

REFERENCE NO. 11

SHEET OF

NOTES LOGARKE

H.C. BARNHISEL

R.C. Reed

DATE 7-11-88

WEATHER pt Cloudy

TEMP. 78.0

ROUTE SR 199

COUNTY WOOD

TOWNSHIP Perry

SECTION 14

T 3 N R 12 E

TYPE MONUMENT P.K. NAIL


ON SURFACE - BELOW

LEFT - CL PAV'T. - RIGHT 0.5'

10.6 TO Lt EDGE PAVEMENT

S.L.M. 207 + 03

Set P.K. / WASHER
7-30-90
C.L.

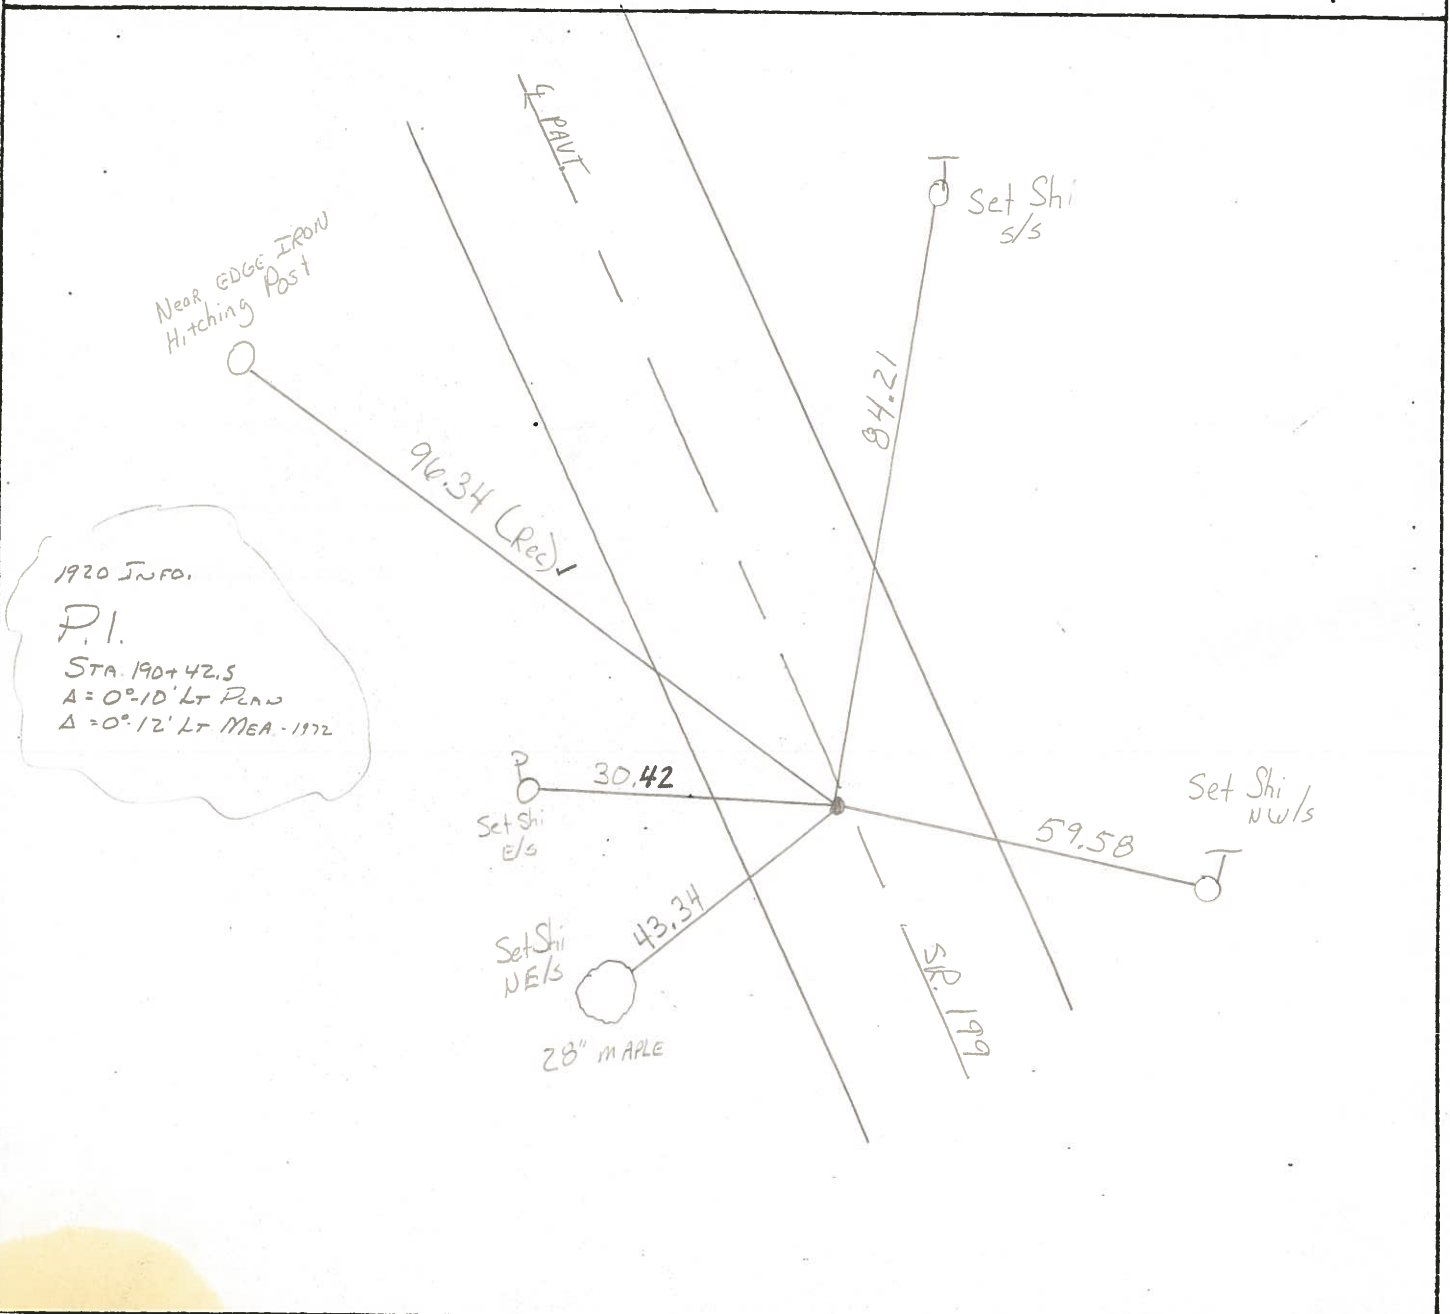

ODOT. DISTRICT 2 SURVEY OFFICE

SHEET 12 OF

County _____ S.R. _____

Township PERRY

Section 14

T_N, R_E

Personnel BURNSIDE

SMITH


BOWERS

MEAD

Date 3-28-72 (CHKD 5-9-80)


Weather _____

Temp. _____

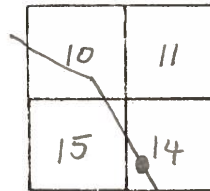

#11

P.I. STA. 190+42.5
 $\Delta = 0^\circ 10' \text{ LT. (PLAN)}$
 $\Delta = 0^\circ 12' \text{ LT. (MEA.)}$
 SET. P.K.
 1st P.I. South of
 EAGLEVILLE ROAD.

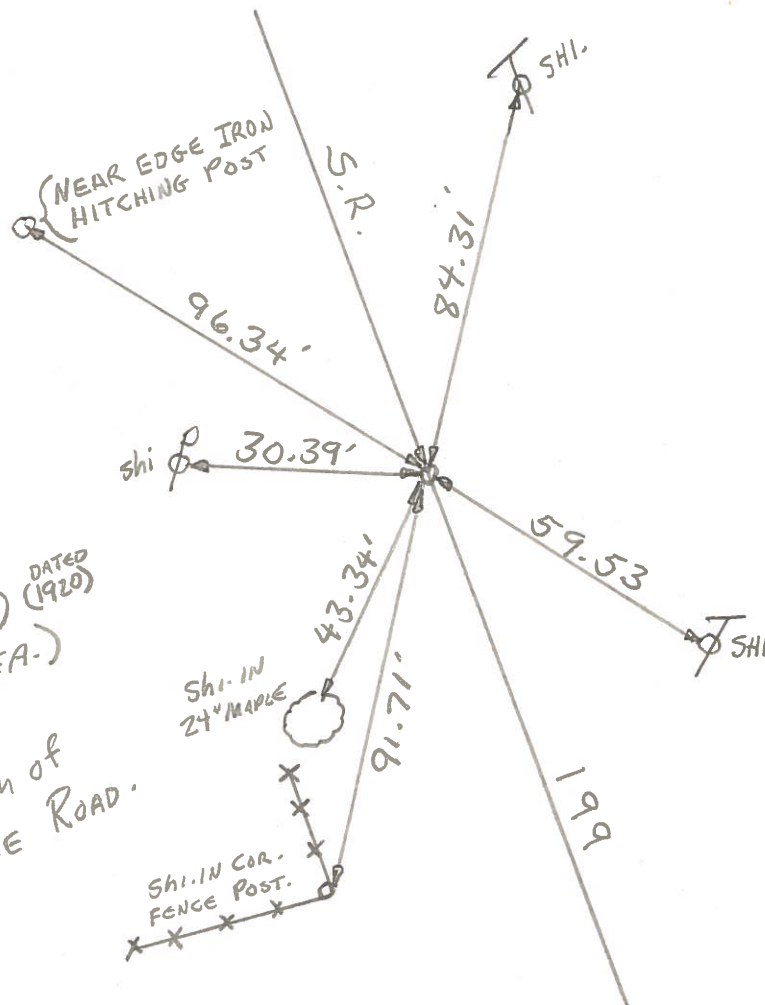

O.D.O.T. DISTRICT 2 SURVEY OFFICE

SHEET 12 OF

County _____ S. R. _____

Township _____ PERRY _____

Section _____ 14 _____

T. N, R. E

Personnel _____ BURNSIDE _____

_____ SMITH _____


_____ BOWERS _____

_____ MEAD _____

Date 3-28-72 (5-9-80) ^{CHKD}

Weather _____

Temp. _____

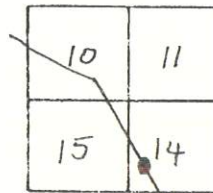


0.5 Lt 4

207 + 03

#11

10.6 to Lt 67

P.I. STA. 190+42.5
 $\Delta = 0^\circ - 10' \text{ LT. (PLAN)}$
 $\Delta = 0^\circ 12' \text{ LT. (MEA.)}$
 SET. P.K.
 1st P.I. South of
 EAGLEVILLE ROAD.

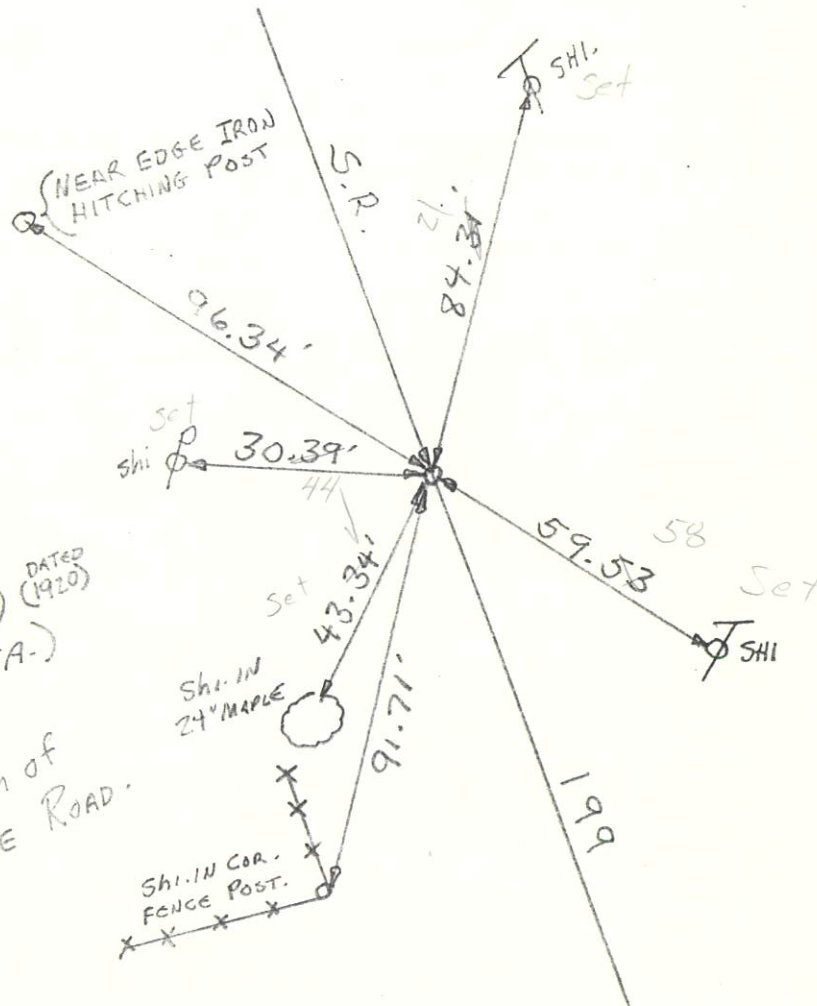

COPIED

SHEET NO. 12

PERSONNEL TITLE PERSONNEL TITLE

BURNSIDE

SMITH

BOWERS

COUNTY WoodDATE OK-5-9-80
3-28-72S. R. 199WEATHER CLEAR

SEC. _____

TEMP. 40°DESCRIPTION 1ST P.I. SOUTH OF EAGLEVILLE ROAD

JOB NO. _____

LEFT

CENTER LINE

RIGHT

P.I. STA. 190+42.5
 $\Delta = 0^\circ - 10' \text{ LT. (PLAN) (DATED 1920)}$
 $\Delta = 0^\circ - 12' \text{ LT. (MEAN)}$
 SET. P.K.

