
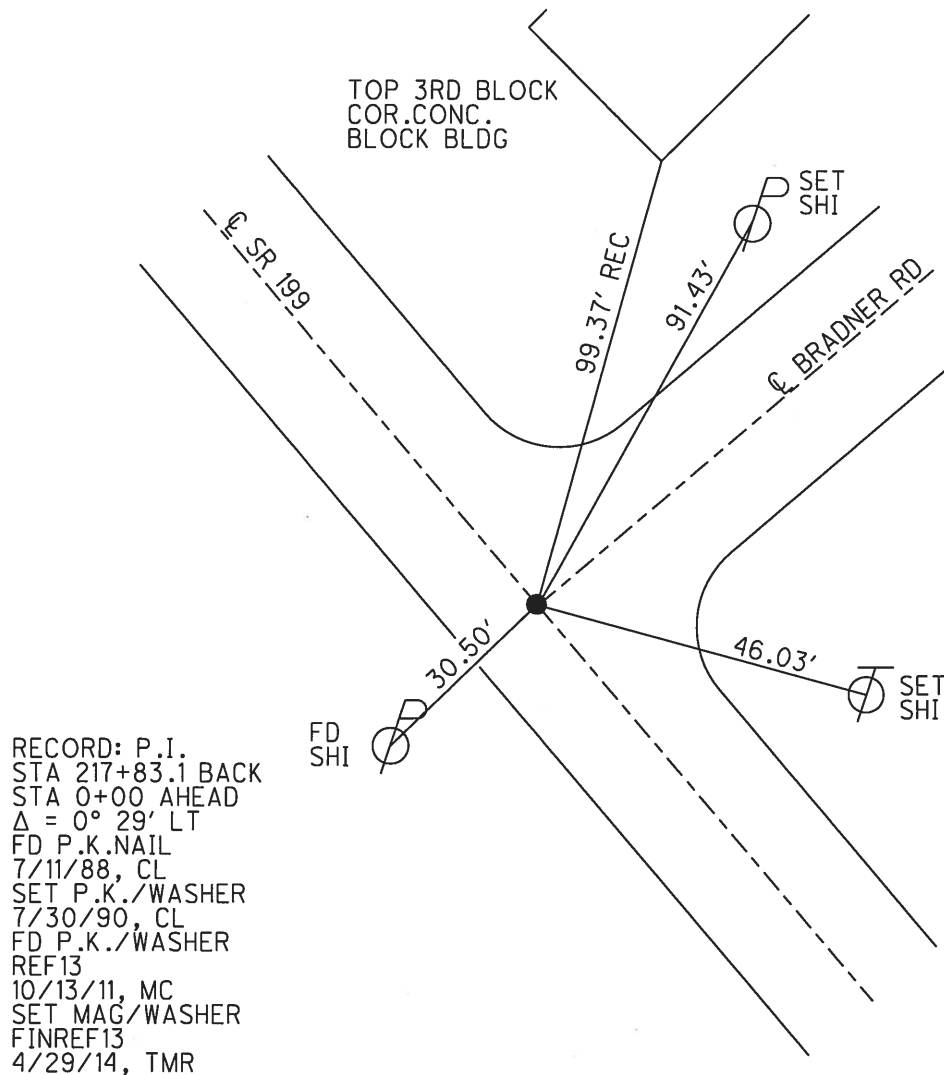


O.D.O.T. DISTRICT 2 SURVEY OFFICE (USE ONLY)

PERSONNEL _____ REFERENCE NO. 13 SHEET 19 OF 24
NOTES ROUSOS DATE 5-6-13 ROUTE SR 199
H.C. CODER WEATHER CLOUDY COUNTY WOOD
R.C. GABLE TEMP. 65° TOWNSHIP PERRY
SECTION 15
T 3 N R 12 E

TYPE MONUMENT P.K./WASHER
ON SURFACE - ~~BELOW~~ ON
LEFT - CL PAV'T - RIGHT ON
10.7' TO LT EDGE PAVEMENT
S.L.M. 236+33.53

Grid: Northing: 567913.777 Easting: 1703704.871

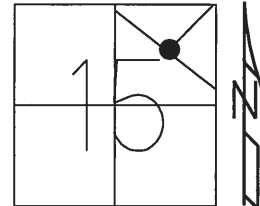

O.D.O.T. DISTRICT 2 SURVEY OFFICE

PERSONNEL

REFERENCE NO. 13

SHEET OF

NOTES LOHRKE

H.C. BARNHISEL

R.C. Reed

DATE 7-11-88

WEATHER Cloudy

TEMP. +80

ROUTE SR 199

COUNTY Wood

TOWNSHIP Perry

SECTION 15

T 3 N R 12 E

TYPE MONUMENT P.R. NAIL

ON SURFACE - BELOW Yes

LEFT- & PAV'T. - RIGHT Both ROAD



TO EDGE PAVEMENT

S.L.M. 234 + 44

Set P.K. / WASHER

7-30-90

C.L.

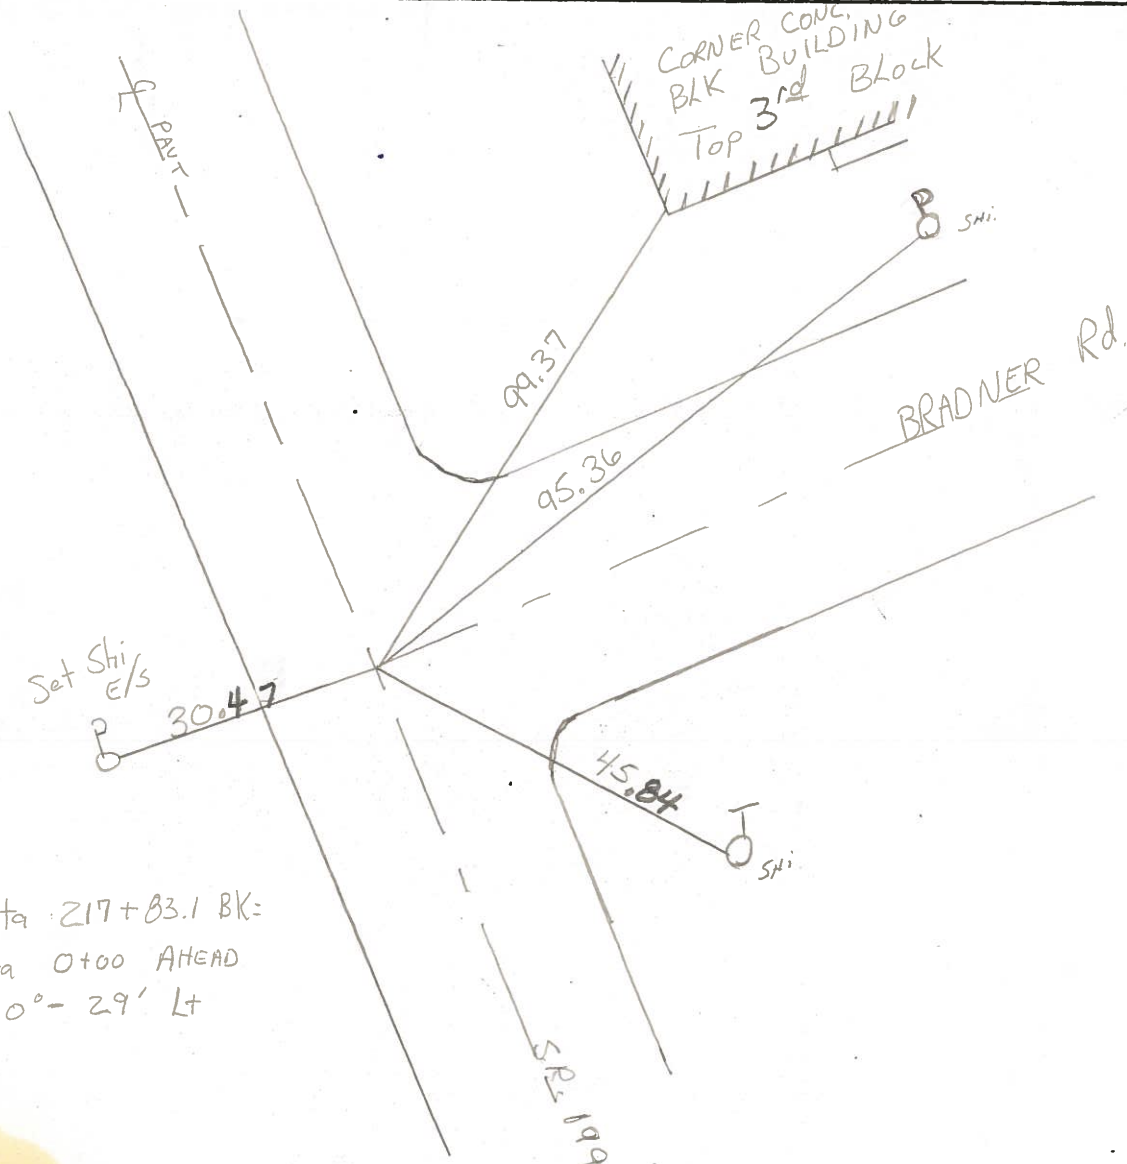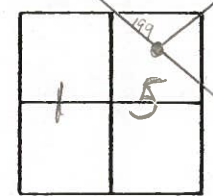

P.I. Sta 217+03.1 BK:

P.I. Sta 0+00 AHEAD

$\Delta = 0^\circ - 29' \text{ Lt}$

ODOT DISTRICT 2 SURVEY OFFICE

SHEET 14 OF

County WOOD S.R. 199

Township PERRY

Section 15

T N, R E

Personnel BURNSIDE

SMITH

BOWER

MEAD

Date 11-15-71 ^{CHKD} 5-9-80


Weather

Temp.

9	10
16	15



#14

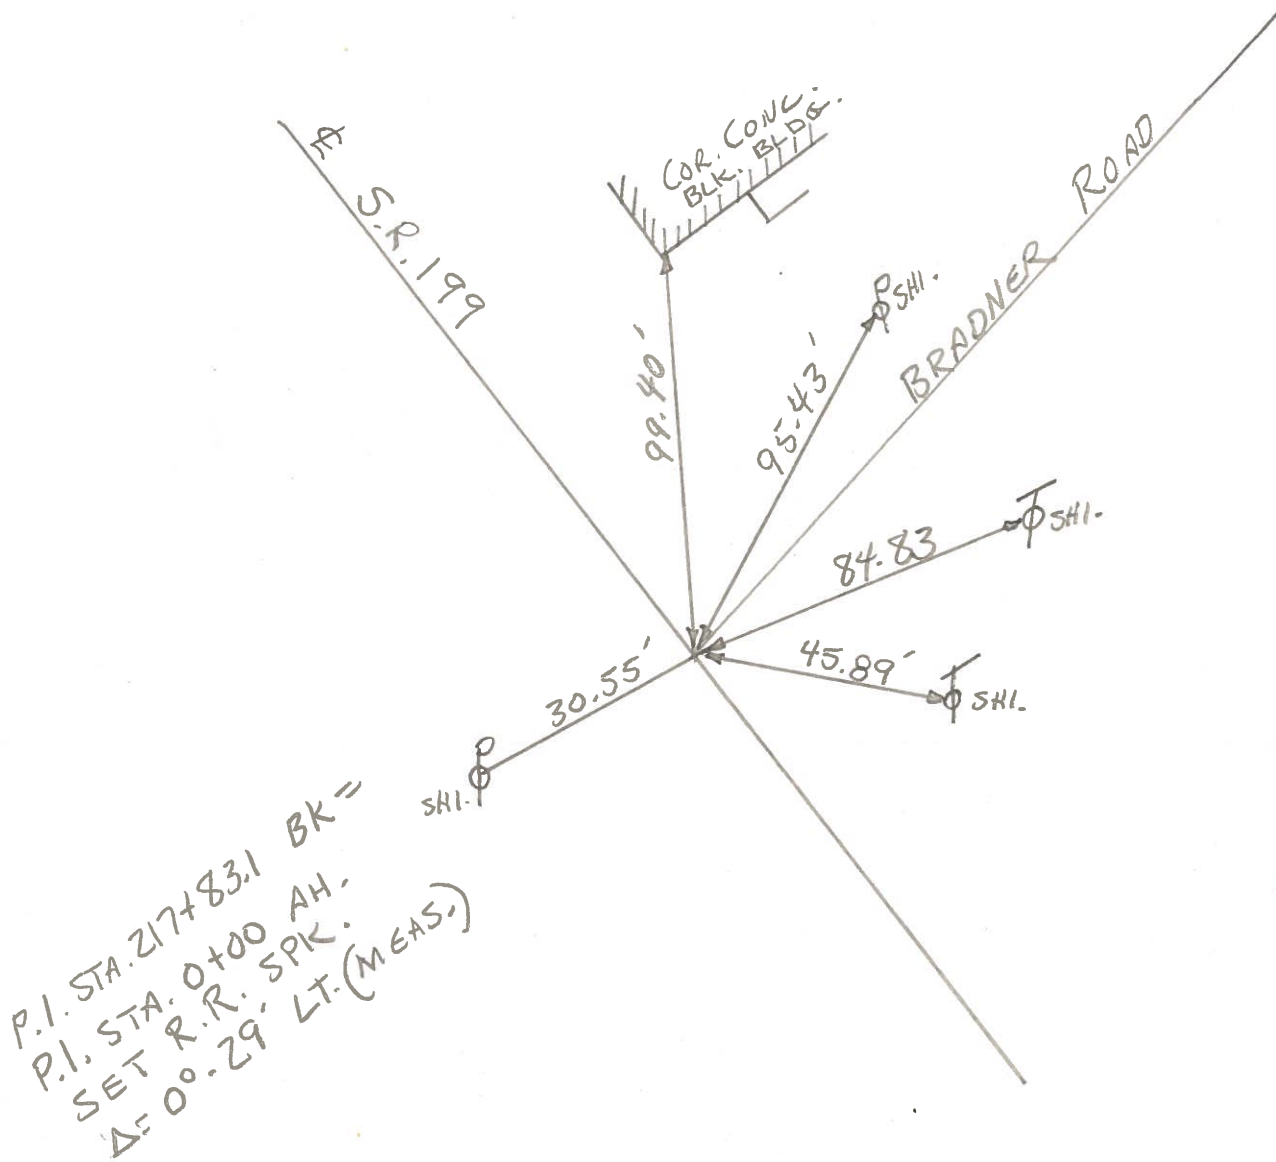

ODOT. DISTRICT 2 SURVEY OFFICE

SHEET 14 OF

County WOOD S.R. 199

Township PERRY

Section 15

T N, R E

Personnel BURNSIDE

SMITH

BOWER

MEAD

Date 11-15-71 ^{CHKD} 5-9-80

Weather _____


Temp. _____

9	10
16	15



#14

234+44

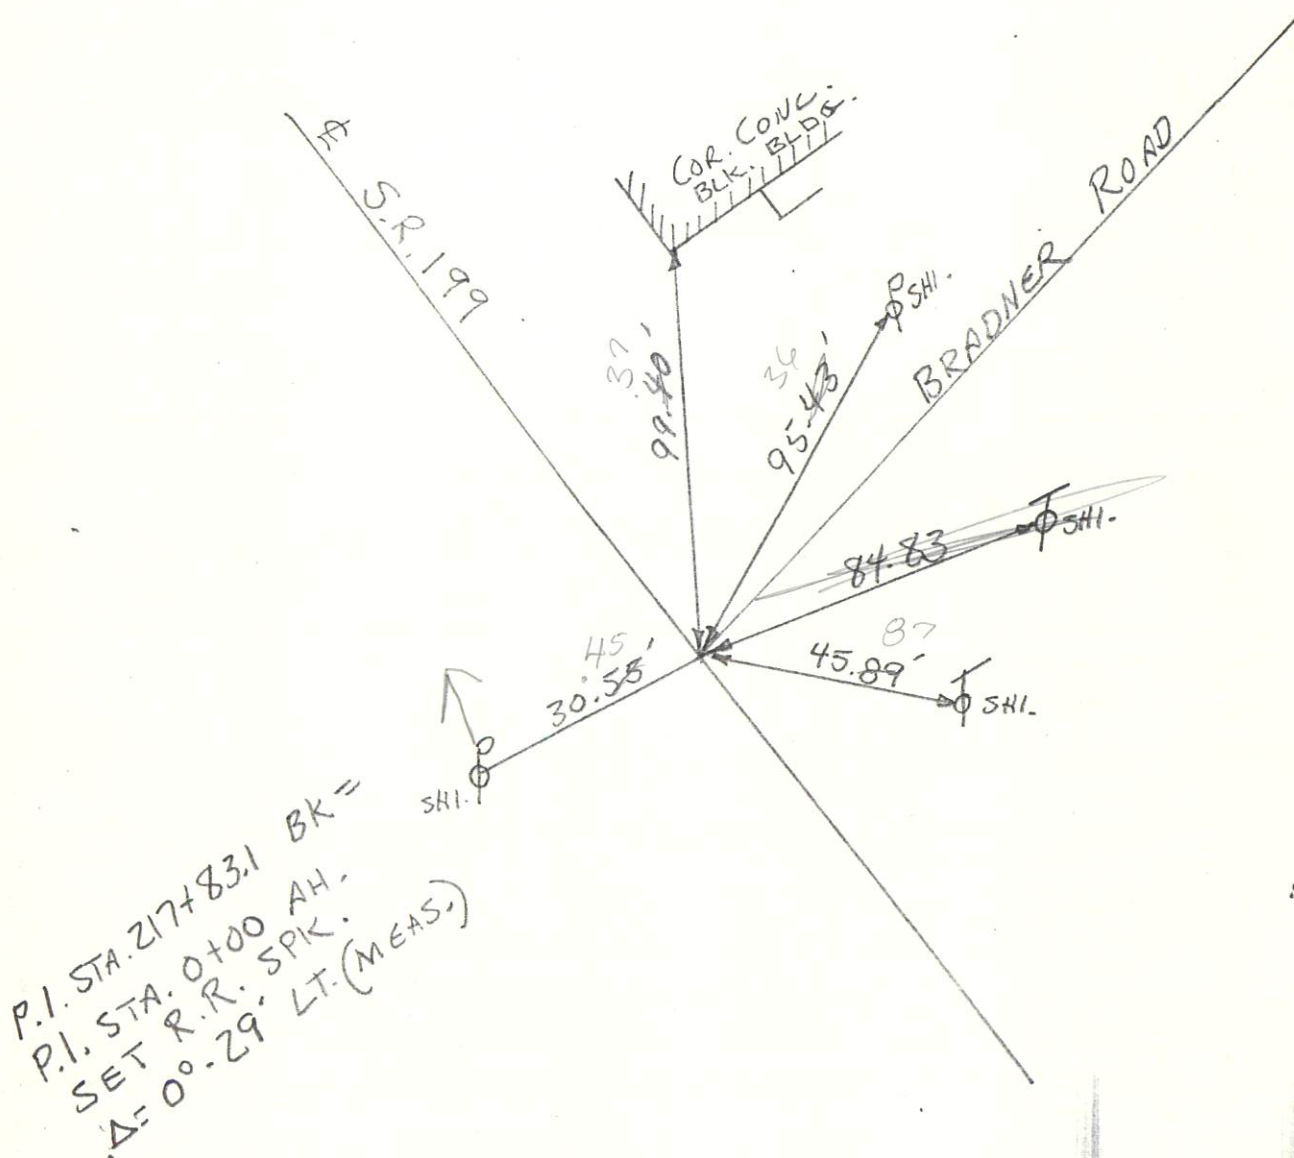

1000000

COPIED

SHEET NO. 14
OK-5-9-80
~~11-15-71~~

PERSONNEL	TITLE	PERSONNEL	TITLE	COUNTY	DATE	WEATHER	TEMP.
BURNSIDE				Wood		CLEAR	+60°
SMITH				S. R. 199			
HOLCOMBE				SEC.			

DESCRIPTION LEFT CENTER LINE RIGHT JOB NO.

