
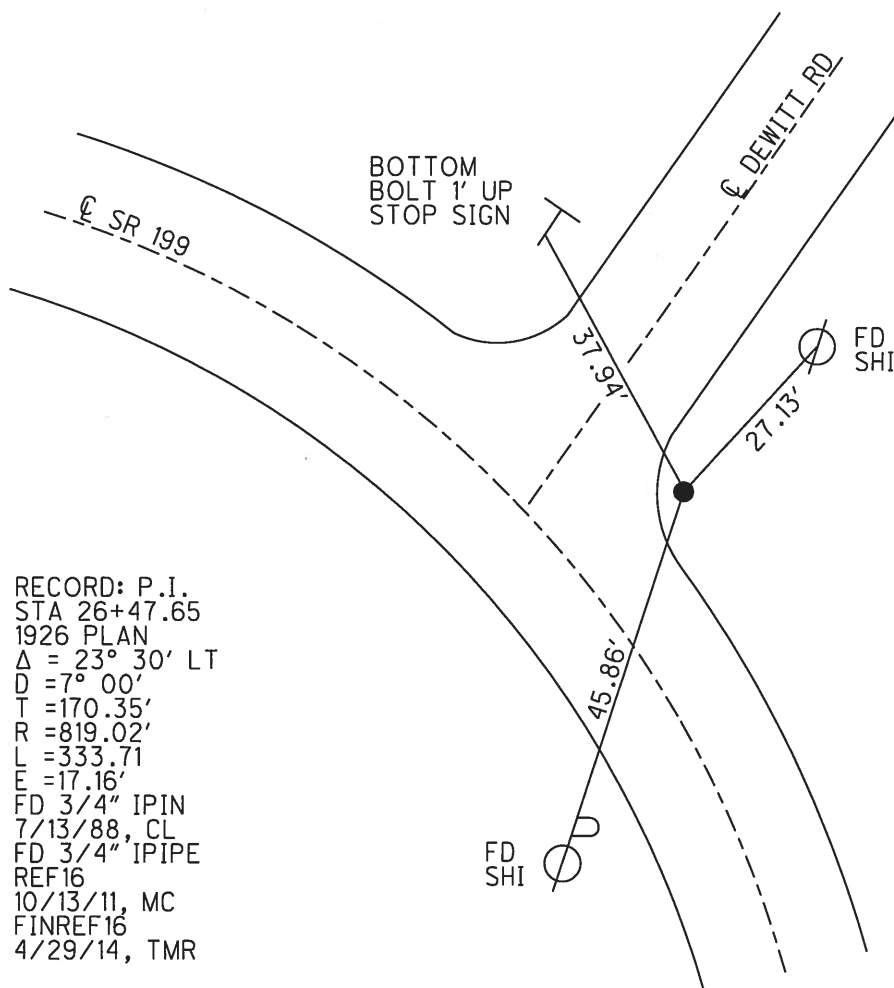


O.D.O.T. DISTRICT 2 SURVEY OFFICE (USE ONLY)

PERSONNEL	REFERENCE NO. <u>16</u>	SHEET <u>21</u> OF <u>24</u>
NOTES <u>ROUSOS</u>	DATE <u>5-6-13</u>	ROUTE <u>SR 199</u>
H.C. <u>HOMAN</u>	WEATHER <u>CLOUDY</u>	COUNTY <u>WOOD</u>
R.C. <u>GABLE</u>	TEMP. <u>72°</u>	TOWNSHIP <u>PERRY</u>
		SECTION <u>10</u>
		T <u>3</u> N R <u>12</u> E

TYPE MONUMENT 3/4" IPIPE
 ON SURFACE - ~~BELOW~~ ON
~~LEFT~~ - CL PAV'T - RIGHT 20.8'
6.5' RT TO RT EDGE PAVEMENT
 S.L.M. 262+80.16
 Grid: Northing: 570035.583 Easting: 1702123.124

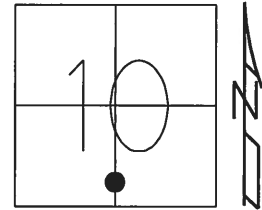

O.D.O.T. DISTRICT 2 SURVEY OFFICE

PERSONNEL

REFERENCE NO. 16

SHEET _____ OF _____

NOTES

LOCHRYE

H.C.

BARNHISEL

DATE 7-13-88

ROUTE 199

R.C.

Reed

WEATHER Pt Chavon Humid

COUNTY WOOD

TEMP. + 90

TOWNSHIP PerrySECTION 10

T _ _ R _ _

TYPE MONUMENT 3/4 IRON ROD



ON SURFACE - BELOW _____

~~LEFT~~ - & PAN'T. - RIGHT 19.2

8.7 TO R₁ EDGE PAVEMENT, R₁ OF R₁ EDGE

S.L.M. 260+85

O.K.
7-30-90
C.L.

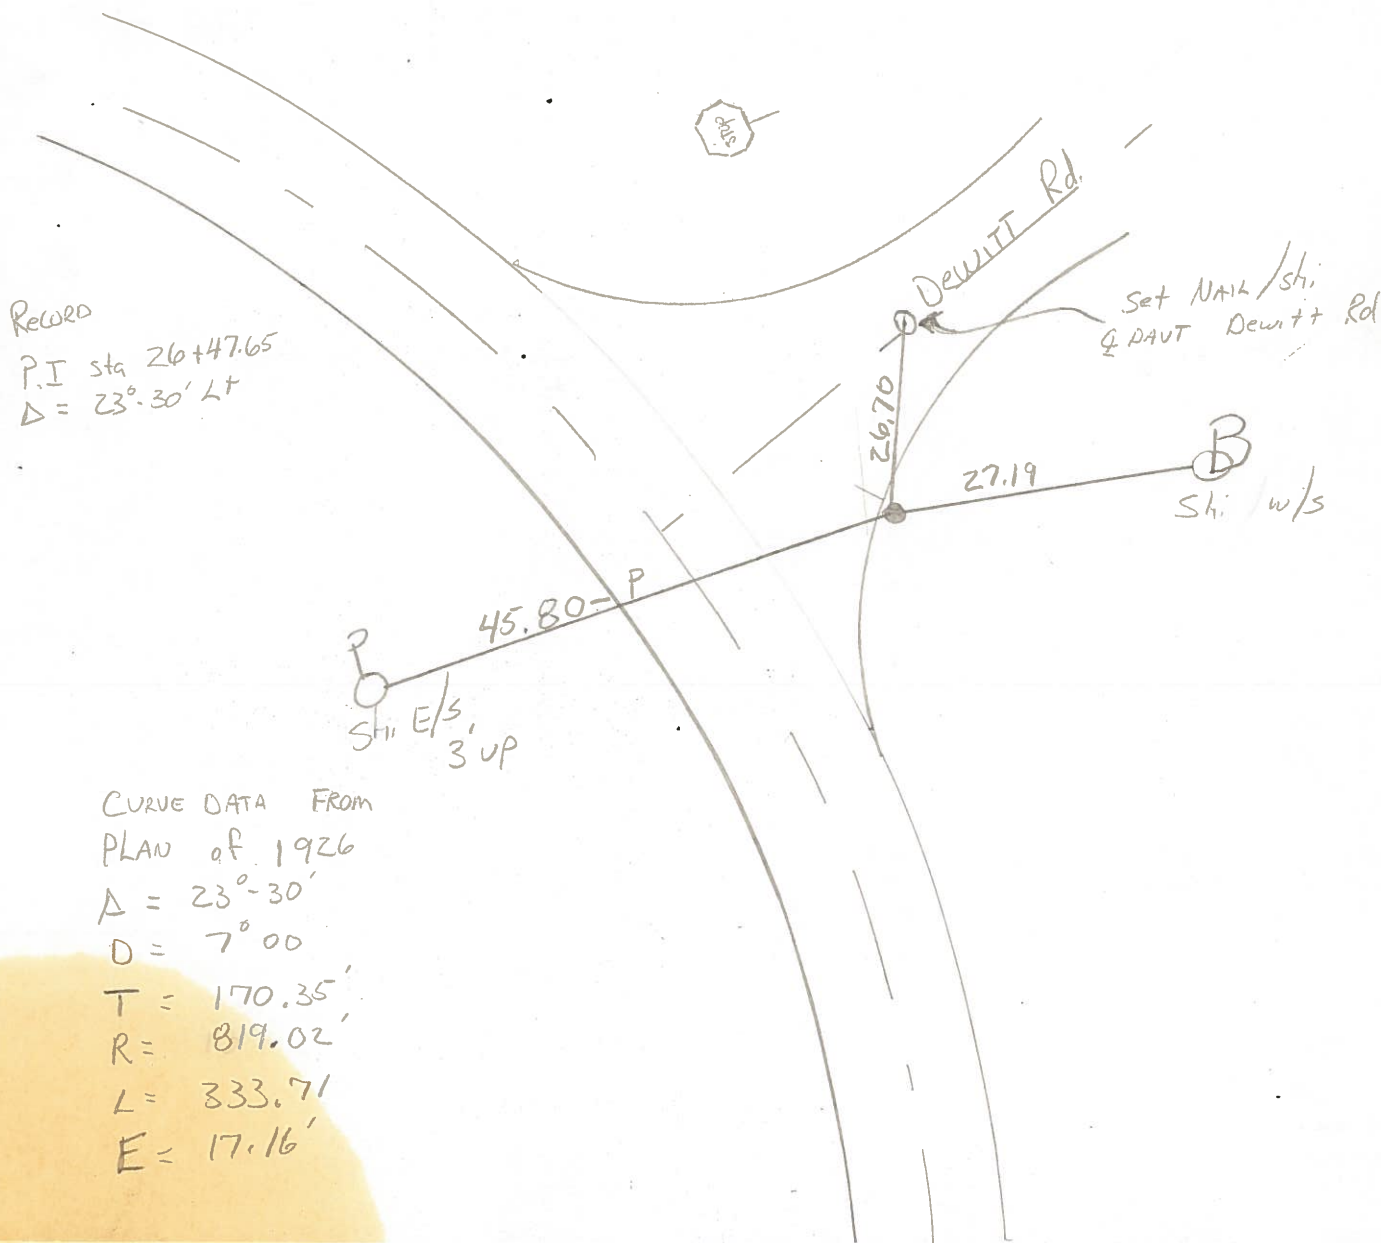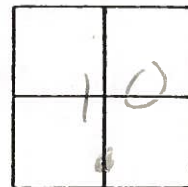

County WOOD S.R. 199

Township PERRY

Section 10

T N, R E

Personnel BURNSIDE

SMITH

BOWERS

MEAD

Date 11-15-71 (5-9-80)^{CKD}

Weather _____

Temp. _____

4	3
9	10



#16

S.R. 199
(FWD. TANGENT)

DEWITT RD.
(UNIMPROVED)

shr in
26" ASH

125.47'
(P.)

45.70'

P
Shi.

P.I. STA. 26+47.65
A = 23°-30'-LT. (REC. & meas.)
SET 3/4" IRON ROD
7.2' E. OF E. EDGE PAVT.
13

(Bk. TANGENT)
S.R. 199

CURVE DATA FROM
PLAN OF 1926
A = 23°-30'
D = 7°-00'
T = 170.35'
R = 819.02'
L = 335.71'
E = 17.16'

County WOOD S.R. 199Township PERRYSection 10T N, R EPersonnel BURNSIDESMITHBOWERSMEADDate 11-15-71 ^{CKD} (5-9-80)

Weather _____

Temp. _____

4	3
9	10



#16

S.R. 199
(FWD. TANGENT)DEWITT RD.
(UNIMPROVED)sh. in
26" ASH125.47'
(P.)

27.25' sh.

45.70'

sh.

(BK. TANGENT)
S.R. 199P.I. STA. 26+47.65
 $\Delta = 23^{\circ}-30'$ (REC. & meas.)
SET $\frac{3}{4}$ " IRON ROD
7.2' E. of E. EDGE PAVT.CURVE DATA FROM
PLAN OF 1926
 $\Delta = 23^{\circ}-30'$
 $D = 7^{\circ}-00'$
 $T = 170.35'$
 $R = 819.02'$
 $L = 335.71'$
 $E = 17.16'$

COPIED

SHEET NO. 16
OK-5-9-80

DATE 11-15-71

PERSONNEL

TITLE

PERSONNEL

TITLE

COUNTY Wood

S. R. 199

WEATHER CLEAR

SEC. 1ST CURVE N. of BRADNER RD. TEMP. +66°

DESCRIPTION

LEFT

CENTER LINE

RIGHT

JOB NO.

