


O.D.O.T. DISTRICT 2 SURVEY OFFICE (USE ONLY)

PERSONNEL	REFERENCE NO. <u>19</u>	SHEET <u>1</u> OF <u>45</u>
NOTES	DATE <u>04-25-16</u>	ROUTE <u>SR 199</u>
H.C. <u>LEU</u>	WEATHER <u>PARTLY CLDY</u>	COUNTY <u>WOOD</u>
R.C. <u>HOMAN</u>	TEMP. <u>80°F</u>	TOWNSHIP <u>PERRY</u>
		SECTION <u>4</u>
		T <u>3</u> N R <u>12</u> E

TYPE MONUMENT SM.R.R.SPIKE
 ON SURFACE - ~~BELOW~~ ON
 LEFT - Q PAV'T - ~~RIGHT~~ 1'
11.7' TORT EDGE PAVEMENT
 S.L.M. 329+18

Grid: Northing: 574453.3092 Easting: 1697086.727

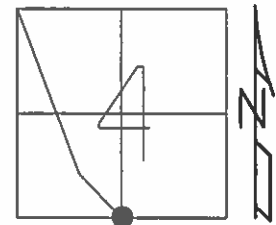


RECORD:

PI STA 94+33
 $\Delta=0^{\circ}13'RT$ (REC)
 $0^{\circ}16'RT$ (MEA.)
 FD ADJ BRASS MON
 4.5" BELOW
 SET RR ON TOP

SET SM. RR. SPK
 8-25-87, MDB

FD SM RR SPK
 GPS, REF19
 04-25-16



SET MAG/WASHER
 GPS, NEWREF19
 09-26-16

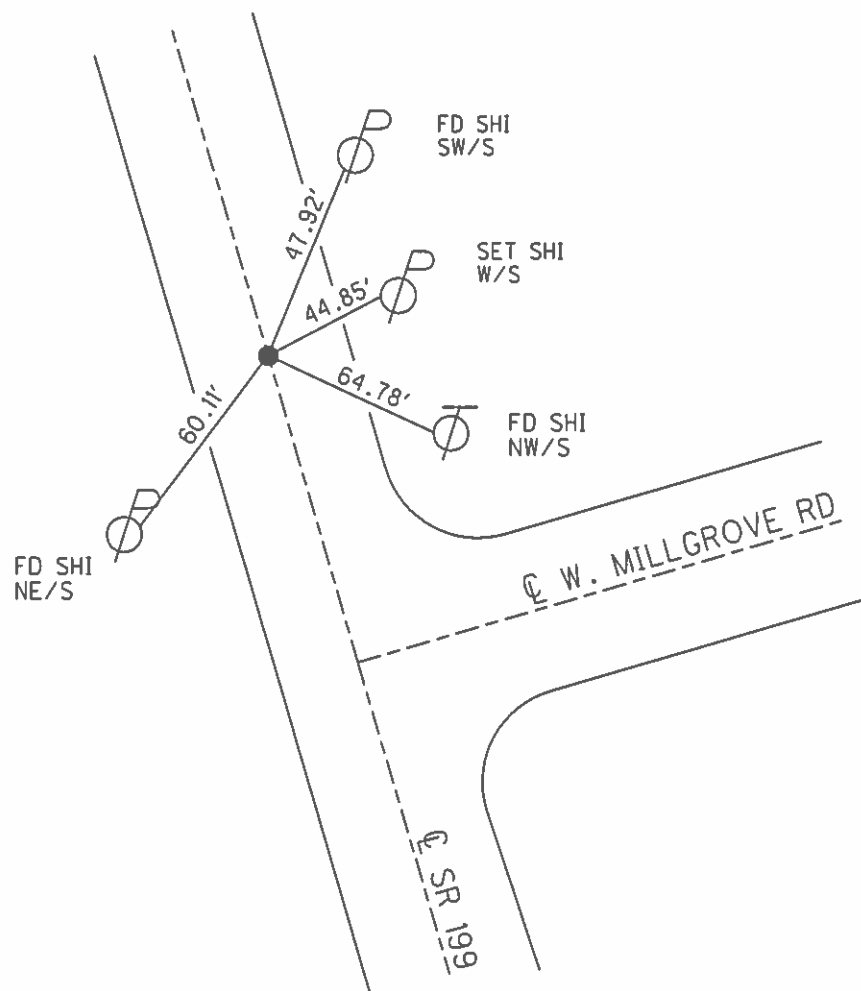

O.D.O.T. DISTRICT 2 SURVEY OFFICE (USE ONLY)

PERSONNEL	REFERENCE NO. <u>19</u>	SHEET <u>24</u> OF <u>24</u>
NOTES <u>RHOADES</u>	DATE <u>5-6-13</u>	ROUTE <u>SR 199</u>
H.C. <u>CODER</u>	WEATHER <u>CLOUDY</u>	COUNTY <u>WOOD</u>
R.C. <u>TROUSOS</u>	TEMP. <u>65°</u>	TOWNSHIP <u>PERRY</u>
		SECTION <u>4</u>
		T <u>3</u> N R <u>12</u> E

TYPE MONUMENT SM RR SPIKE
 ON SURFACE - ~~BELOW~~ ON
 LEFT - ~~C PAV'T~~ - RIGHT 0.8'
11.7 TO RT EDGE PAVEMENT
 S.L.M. 330+61.43
 Grid: Northing: 574453.397 Easting: 1697086.615

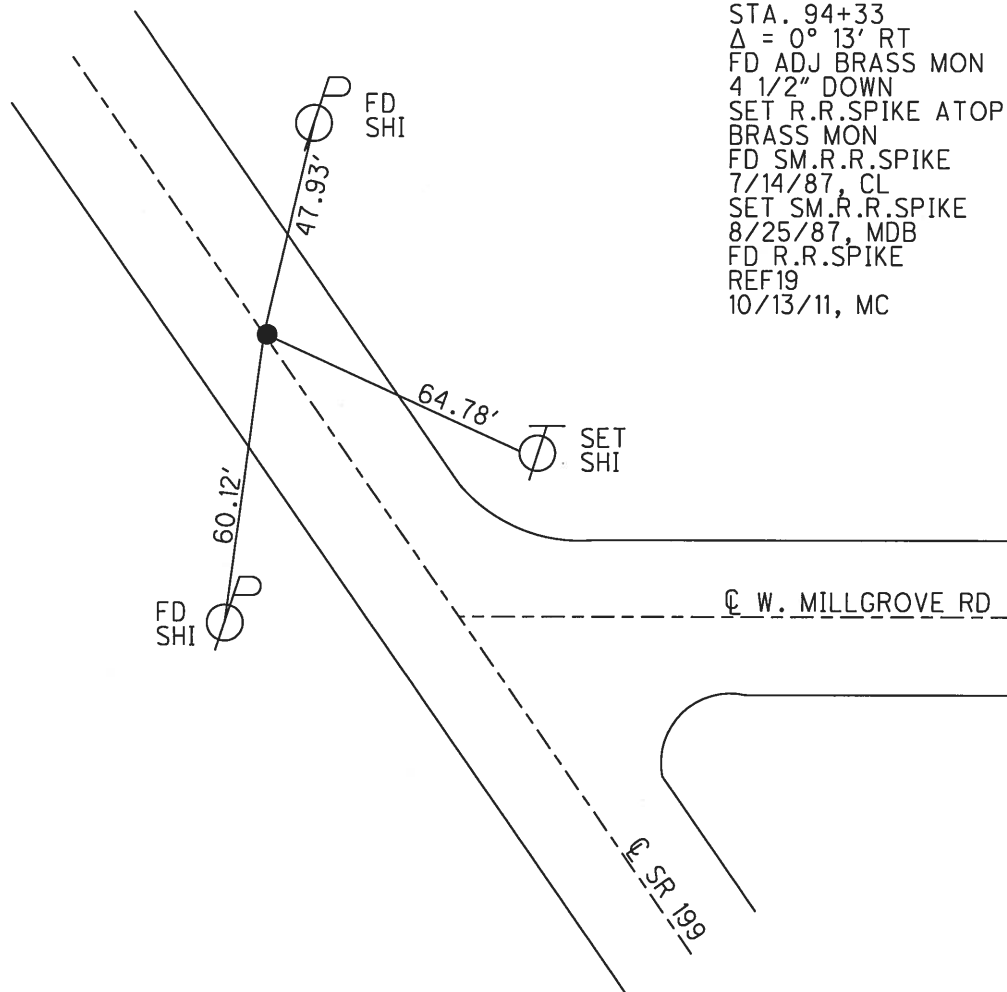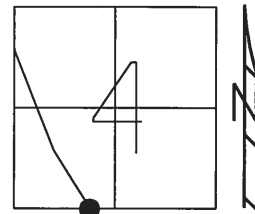

RECORD: P.I.
 STA. 94+33
 $\Delta = 0^\circ 13' \text{ RT}$
 FD ADJ BRASS MON
 4 1/2" DOWN
 SET R.R.SPIKE ATOP
 BRASS MON
 FD SM.R.R.SPIKE
 7/14/87, CL
 SET SM.R.R.SPIKE
 8/25/87, MDB
 FD R.R.SPIKE
 REF19
 10/13/11, MC

O.D.O.T. DISTRICT 2 SURVEY OFFICE

PERSONNEL



REFERENCE NO. 19 SHEET OF

NOTES BARNHILL
H.C. Loehrke
R.C. Hoffman

DATE 7-14-87
WEATHER cloudy
TEMP. + 70°

ROUTE 199
COUNTY WOOD
TOWNSHIP Perry
SECTION 4
T. 3 N. R. 12 E.

TYPE MONUMENT Sm RR Spk
ON SURFACE - BELOW yes
LEFT- & PAW'T. - RIGHT yes
11.7 TO Rt EDGE PAVEMENT
S.L.M. 329 + 18

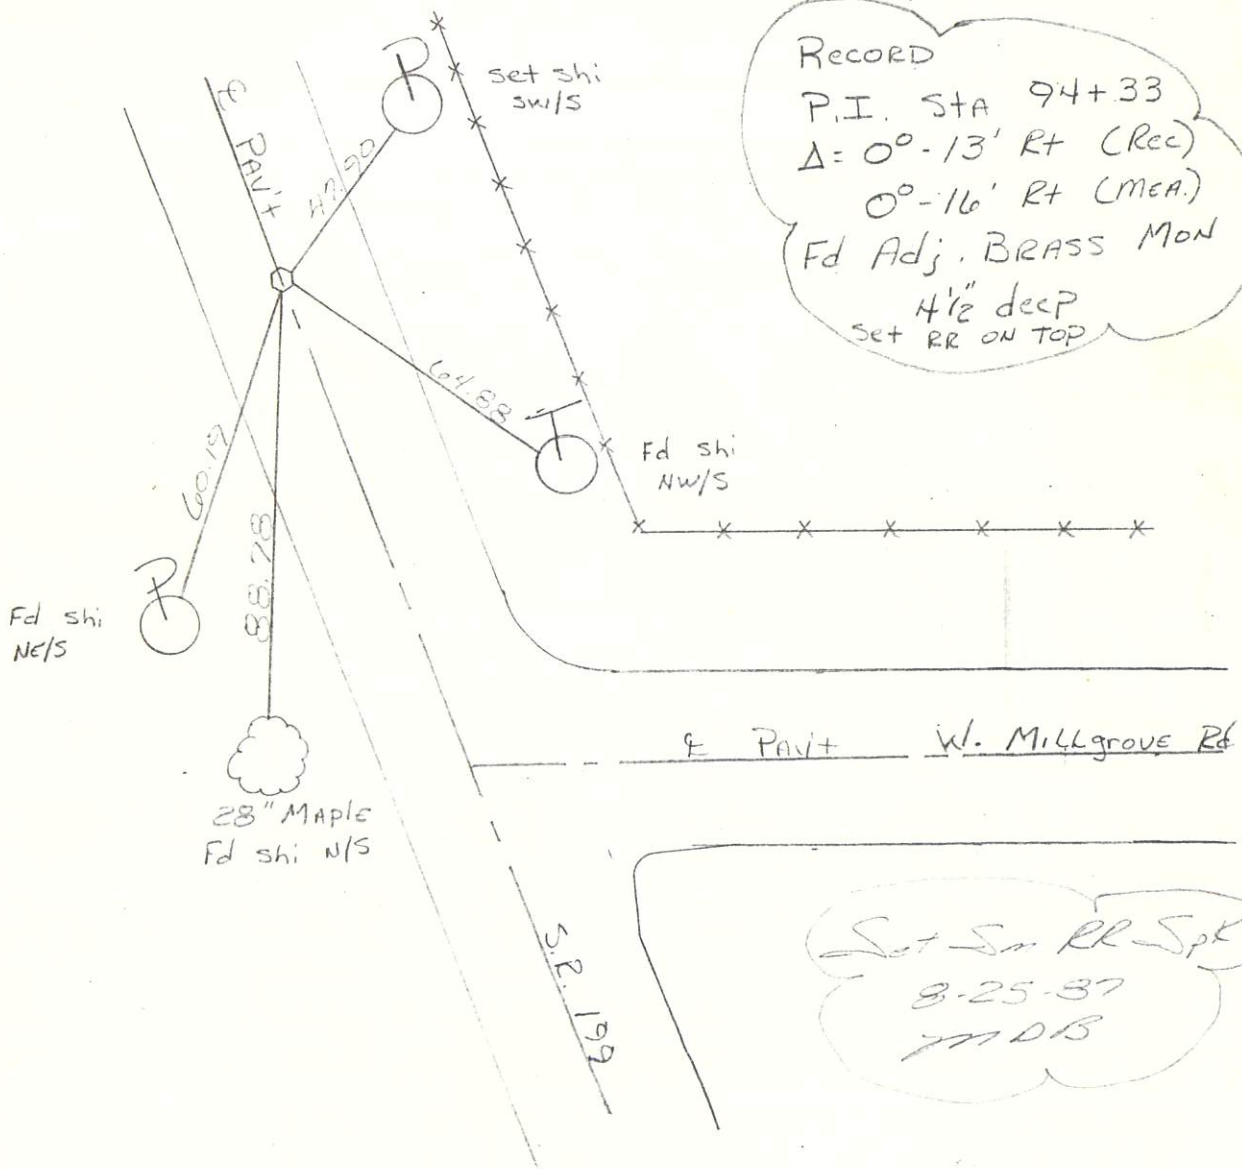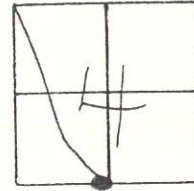

RECORD

P.I. STA 94+33
 $\Delta = 0^{\circ}-13' \text{ Rt (Rec)}$
 $0^{\circ}-16' \text{ Rt (Mea.)}$
Fd Adj. BRASS MON
4 1/2" deep
set RR ON TOP

Set Sm RR Spk
8-25-87
MDB

O.D.O.T. DISTRICT 2 SURVEY OFFICE

PERSONNEL

REFERENCE NO. 19

SHEET OF

NOTES BARNHISEL

H.C. Loehrke

R.C. HOFFMAN

DATE 7-14-87

WEATHER Cloudy

TEMP. + 70°

ROUTE 199

COUNTY WOOD

TOWNSHIP Perry

SECTION 4

T 3 N R 12 E



TYPE MONUMENT Sm RR Spk

ON SURFACE - BELOW yes

LEFT - C PAV'T. - RIGHT yes

11.7 TO R+ EDGE PAVEMENT

S.L.M. 329 +18

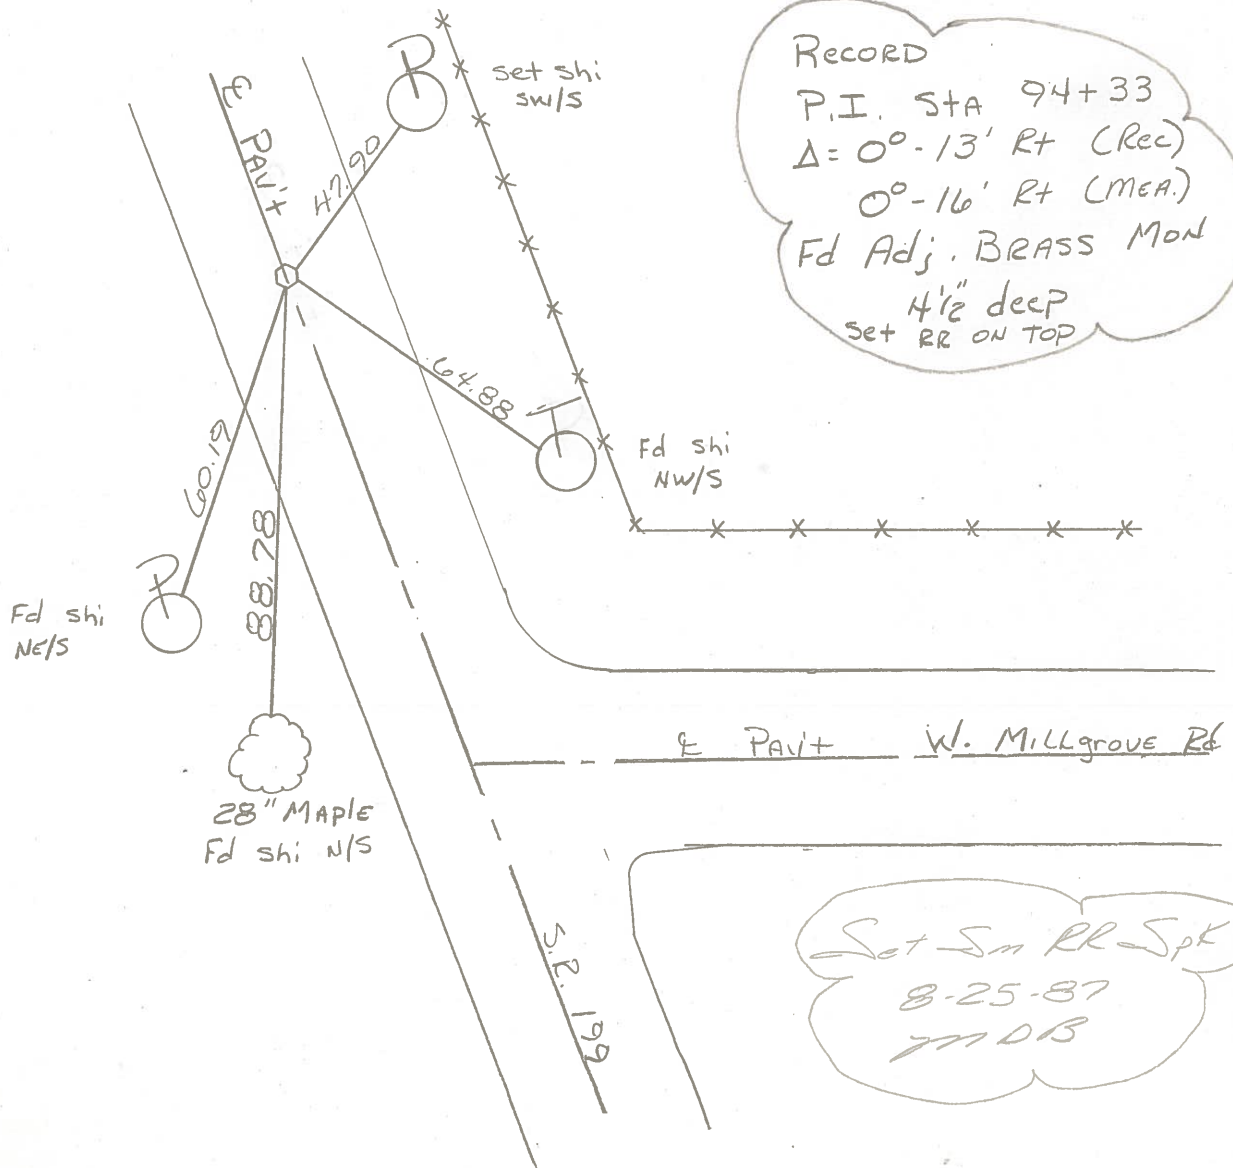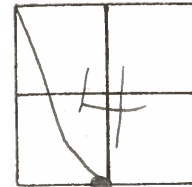

RECORD
 P.I. STA 94+33
 $\Delta = 0^{\circ}-13' \text{ Rt (Rec)}$
 $0^{\circ}-16' \text{ Rt (MEAS)}$
 Fd Adj. BRASS MON
 4 1/2" deep
 Set RR ON TOP

Set Sm RR Spk
 8-25-87
 MDB

O.D.O.T. DISTRICT 2 SURVEY OFFICE

SHEET 19 OF

County WOOD S.R. 199

Township PERRY

Section 4

T N, R E

Personnel BURNSIDE

SMITH

BOWERS

MEAD

Date 11-22-7 (O.K. 5-9-80)


Weather CLEAR R.B.

Temp. +25°

32	33
5	4



#19

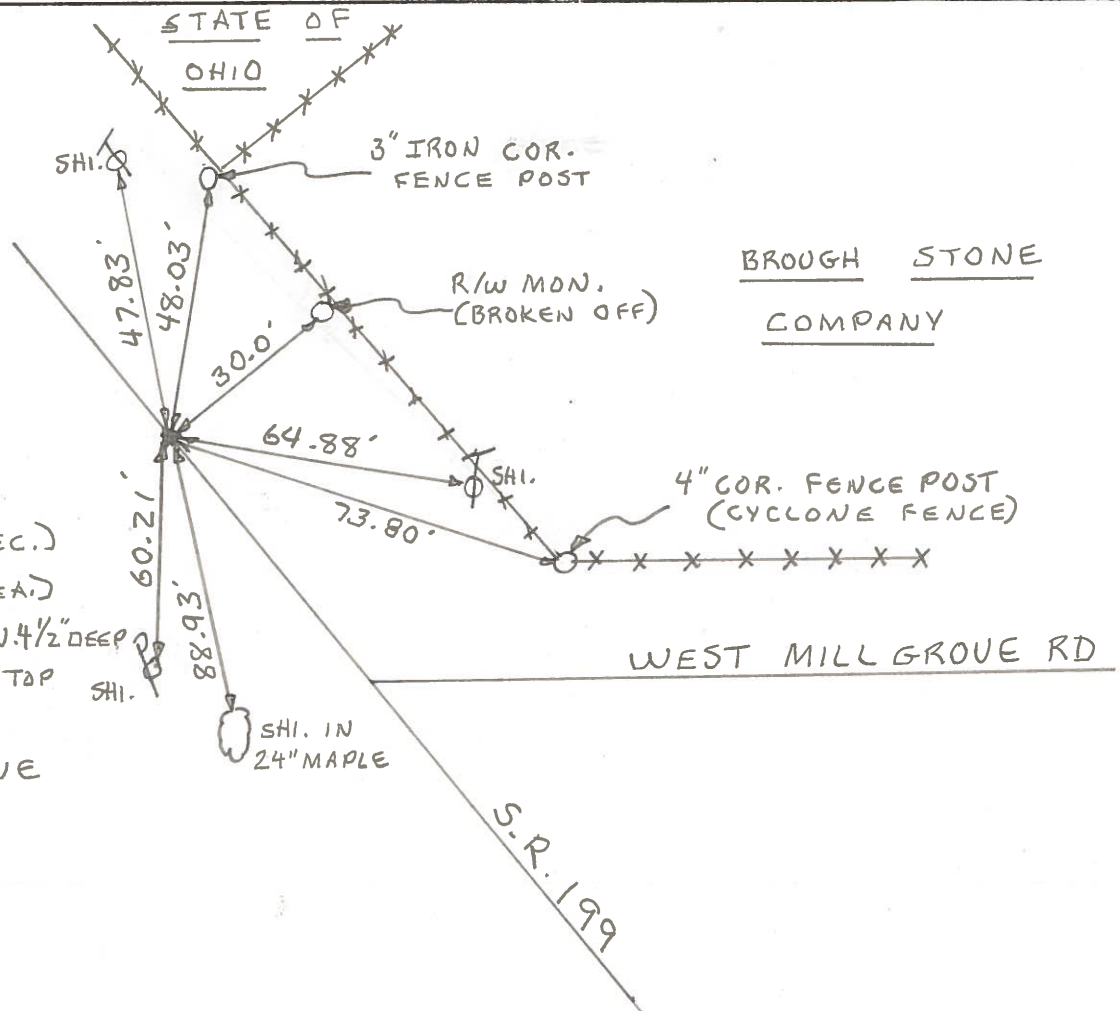

P.I. STA. 94+33

A = 0°-13' RT. (REC.)

0°-16' RT. (MEAD)

FD. ADJ. BRASS MON. 4 1/2" DEEP

SET R.R. SPIKE ON TOP

EAST CORP LINE

WEST MILGROVE

WEST MILL GROVE RD

S.R. 199

COPIED

SHEET NO. 19

PERSONNEL	TITLE	PERSONNEL	TITLE
BURNSIDE			
SMITH			
POWERS			

COUNTY Wood DATE 11-22-71

S. R. 199 WEATHER CLEAR

SEC. _____ TEMP. +25°

DESCRIPTION E. CORP. LINE WEST MILLGROVE JOB NO. _____

LEFT

CENTER LINE

RIGHT

OK-5-22-78
R.B.

P.I. STA. 94+33

 $\Delta = 0^\circ - 13' \text{ RT (REC.)}$ $0^\circ - 16' \text{ RT (MEA.)}$

FD. ADJ. BRASS MON 4 1/2" DEEP

SET R.R. SPT ON TOP

EAST CORP. LINE

WEST MILLGROVE

