

O.D.O.T. DISTRICT 2 SURVEY OFFICE (USE ONLY)

PERSONNEL

REFERENCE NO. 30

SHEET OF

NOTES ASTON

DATE 7/18/24

ROUTE SR 199

H.C. NIESE

WEATHER SUNNY

COUNTY WOOD

R.C. PRESTON-COLVIN

TEMP. 77°

TOWNSHIP MONTGOMERY

DWG BY BARRIERE

PID 113719

SECTION 20

T 4 N R 12 E

TYPE MONUMENT MONBOW W/ 1" IPIN

ON SURFACE - BELOW ON

OFFSET $\varnothing$ PAVEMENT 0.5' LT LT : RT


 TO EDGE PAVEMENT

STATION: 499+34


HORIZ.DATUM: NAD83(2011)/WOOD LDP GEOID: 18

GRID: NORTHING: 590307.926 EASTING: 1691280.373

LDP: NORTHING: 412663.122 EASTING: 202881.012

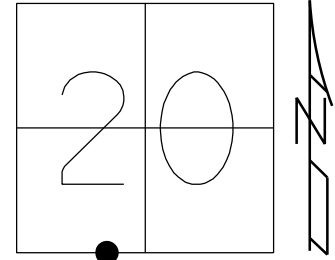

RECORD:
 $\Delta = 01^{\circ}05'$ RT
FD SM.R.R.SPIKE
7/14/87, MDB
SET SM.R.R.SPIKE
8/25/87, MDB
FD SM.R.R.SPIKE
3/16/06, RGN
8/18/09, MC
SET MAG/WASHER
11/10/09, MC
FD MAG SHANK
9/10/21, DSA
FD SHANK
NEWREF30
7/18/24, TDN
FD MONBOW
W/ 1" IPIN
SET PER
PID 113719 PLANS
NEWREF30
10/31/24, TDN

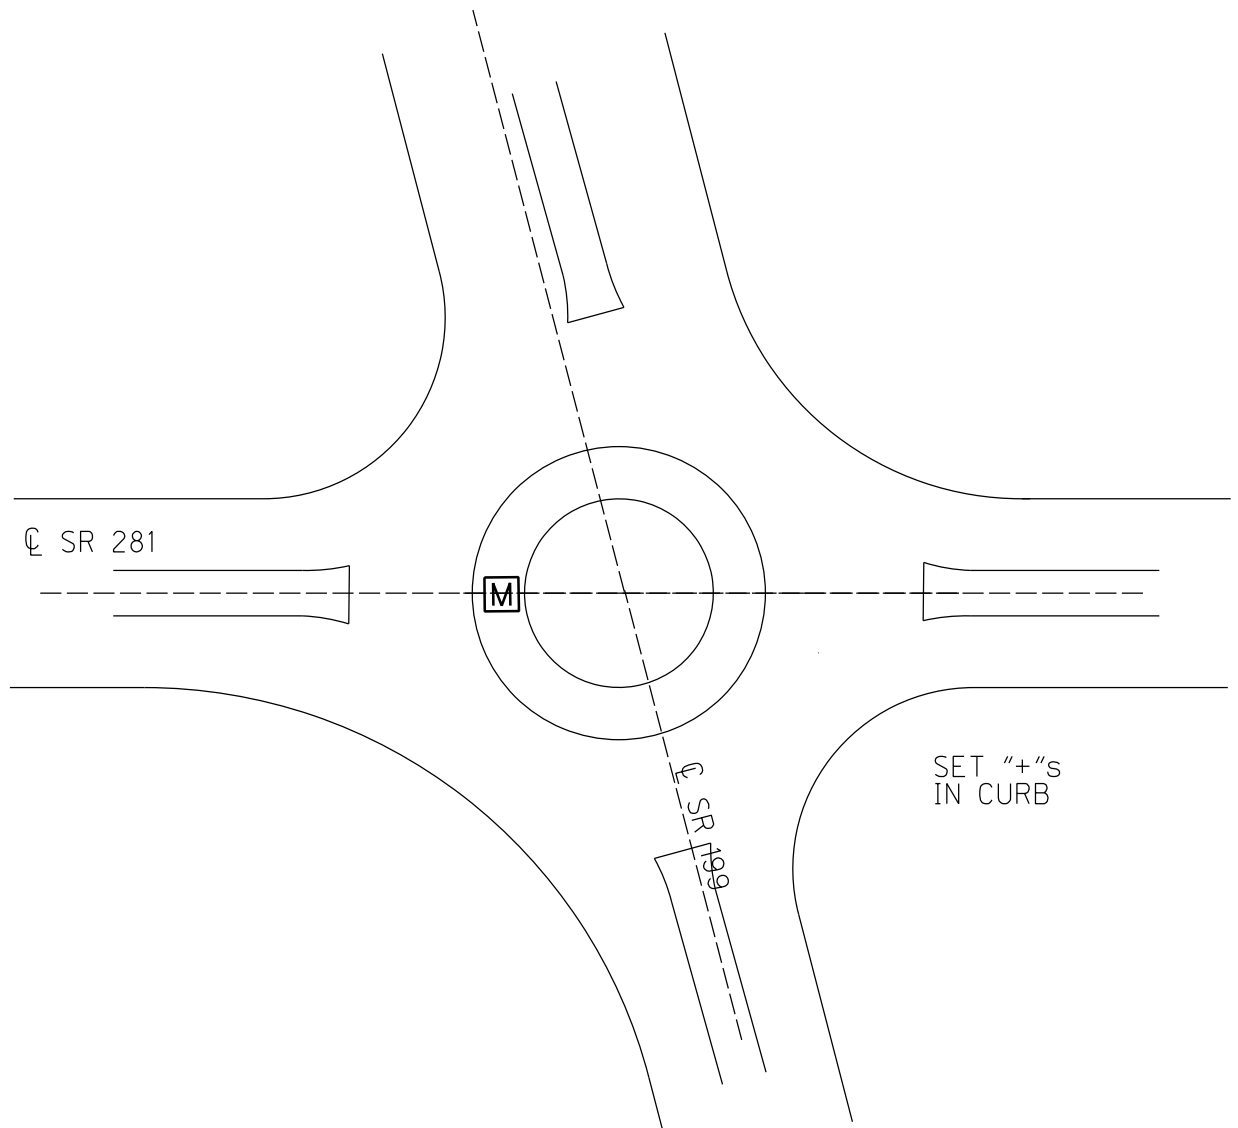

O.D.O.T. DISTRICT 2 SURVEY OFFICE (USE ONLY)

PERSONNEL

REFERENCE NO. 30

SHEET 16 OF 45

NOTES HUSS
H.C. CANTERBURY
R.C. HUSS

DATE 8/18/09
WEATHER SUNNY
TEMP. 86°

ROUTE SR 199
COUNTY WOOD
TOWNSHIP MONTGOMERY
SECTION 20
T 4 N R 12 E

DWG BY RHOADES PID 101286

TYPE MONUMENT SM.R.R.SPIKE

ON SURFACE - ~~BELOW~~ ON

OFFSET Q PAVEMENT 0.5' LT : ~~RT~~
- TO - EDGE PAVEMENT


STATION: 499+34

HORZ.DATUM: NAD83(2011)

GEOID: 2012A


GRID: NORTHING: 590308.089

EASTING: 1691280.338

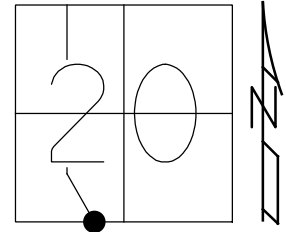

RECORD:

$\Delta = 01^{\circ}05'$ RT
FD SM.R.R.SPIKE
7/14/87, MDB
SET SM.R.R.SPIKE
8/25/87, MDB
FD SM.R.R.SPIKE
3/16/06, RGN
8/18/09, MC
SET MAG/WASHER
11/10/09, MC
FD MAG SHANK
9/10/21, DSA

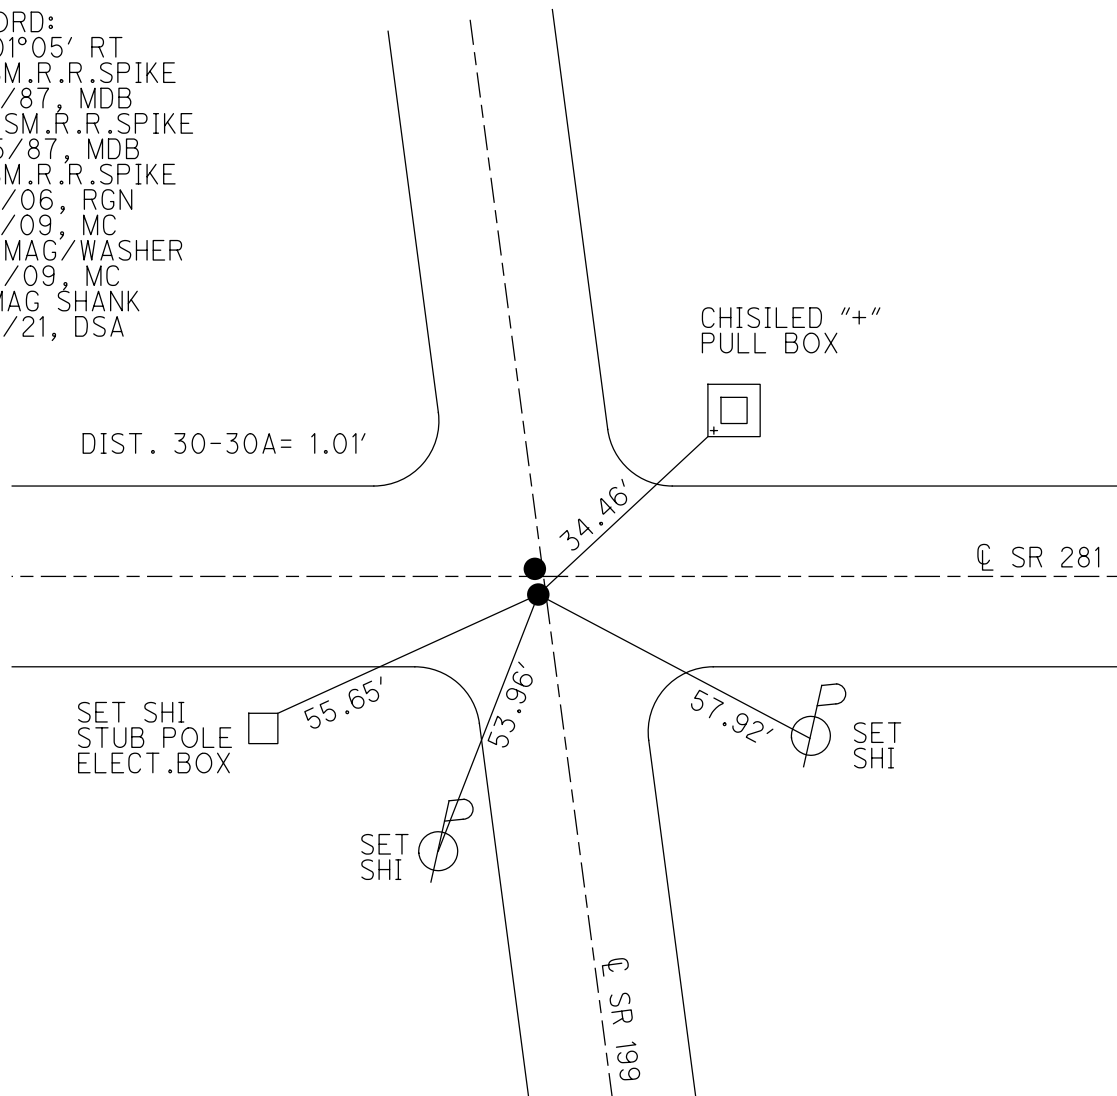

O.D.O.T. DISTRICT 2 SURVEY OFFICE (USE ONLY)

PERSONNEL

REFERENCE NO. 30

SHEET 16 OF 45

NOTES HUSS

DATE 08-18-09

ROUTE SR 199

H.C. CANTERBURY

WEATHER SUNNY

COUNTY WOOD

R.C. HUSS

TEMP. 86° F

TOWNSHIP MONTGOMERY

SECTION 20

T 4 N R 12 E

TYPE MONUMENT SM. RRSPK


ON SURFACE - ~~BELOW~~ ON

LEFT - Q PAV'T - ~~RIGHT~~ 0.5', 1' S. OF Q SR 281

- TO - EDGE PAVEMENT

S.L.M. 499+34

Grid: Northing: 590308.089 Easting: 1691280.338

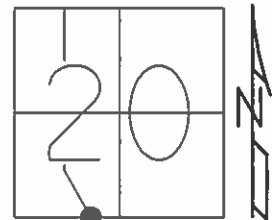

RECORD

$\Delta = 01^{\circ}-05'$ RT. (MEAS.)
FD. PK
SET RRSPK


RECORD

07-14-87 MDB
FD. SM. RRSPK

08-25-87 MDB
SET SM. RRSPK

03-16-06 RGN
FD. SM. RRSPK

11-10-09 MC
RESET MAG/W

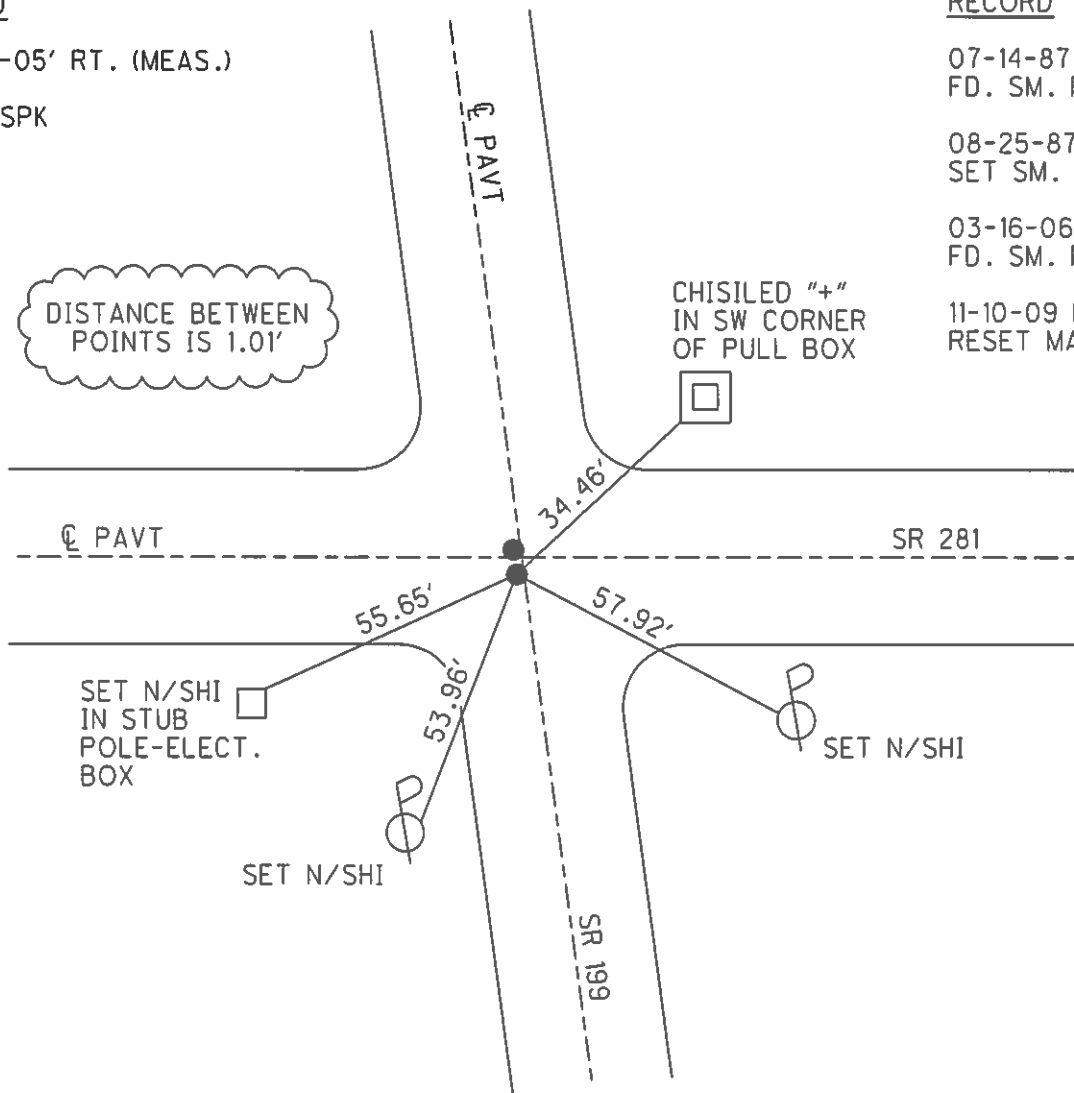

O.D.O.T. DISTRICT 2 SURVEY OFFICE (USE ONLY)

PERSONNEL

REFERENCE NO. 30A

SHEET 14 OF 42

NOTES HUSS

DATE 08-18-09

ROUTE SR 199

H.C. CANTERBURY

WEATHER SUNNY

COUNTY WOOD

R.C.	HUSS
------	------

TEMP. 86° F

TOWNSHIP MONTGOMERY

SECTION 20

T 4 N R 12 F

TYPE MONUMENT PK NAIL


ON SURFACE - ~~BELOW~~ ON

LEFT - C PAV'T - ~~RIGHT~~ 0.3', ON C SR 281

____ TO ____ EDGE PAVEMENT


S.L.M. 499+35

Grid: Northing: 590309.092 Easting: 1691280.411

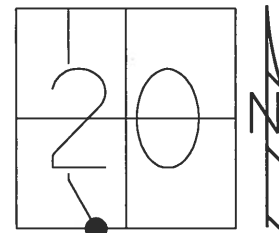

RECORD

11-10-09 MC
RESET MAG/W

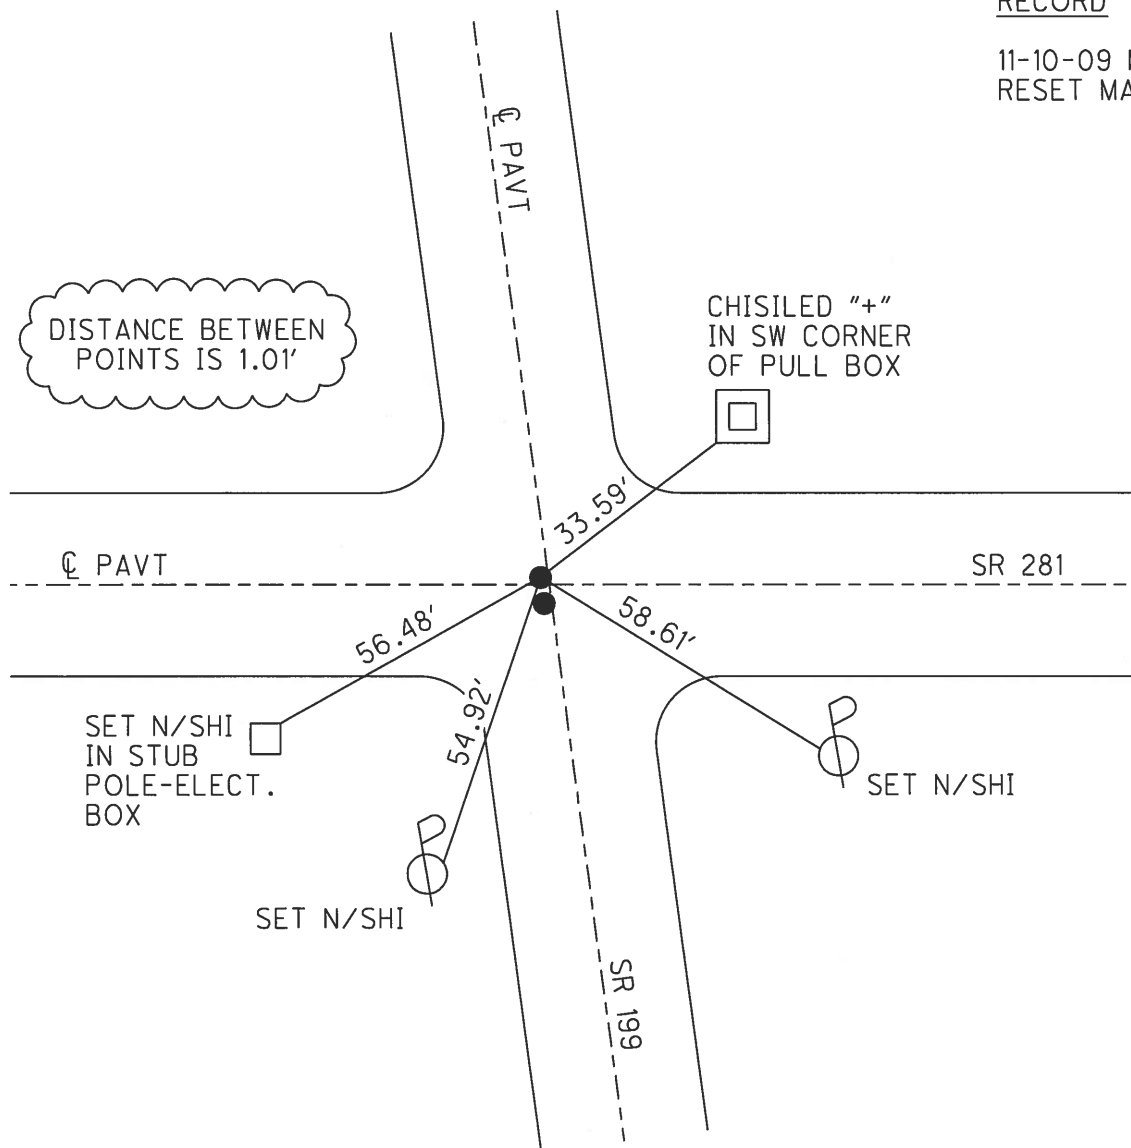

O.D.O.T. DISTRICT 2 SURVEY OFFICE

PERSONNEL

REFERENCE NO. 30

SHEET OF

NOTES BARNHISEL

H.C. Loehrke

R.C. HOFFMAN

DATE 7-14-87

WEATHER Sunny

TEMP. +75°

ROUTE 199

COUNTY WOOD

TOWNSHIP Montgomery

SECTION 20

T4 N R 12 E


TYPE MONUMENT Sm RR Spk

ON SURFACE - BELOW YES

LEFT - ℄ PAV'T. - RIGHT 1.5 (1.0 SOF & SR 281)

- TO - EDGE PAVEMENT

S.L.M. 499+34 (199 SLM) 1029+41 (281 SLM)

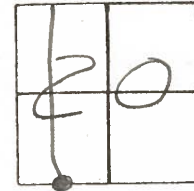

Record

Fd PK - O.K.

Set R.R. Spk

$\Delta = 1^{\circ} 05' R +$ (meas)

Set Shi
E. Post of Sign

Btw Hall

Set Sm RR Spk
8-25-87
77AB


Set Shi
20" Walnut
sw/s

Fd Shi
sw/s

S.R. 281

CONC MON
Bent + DAMAGED
USED CTR Rod
(Cut NOTCH IN
Bent OVER Rod.)

Fd Shi
NE/S

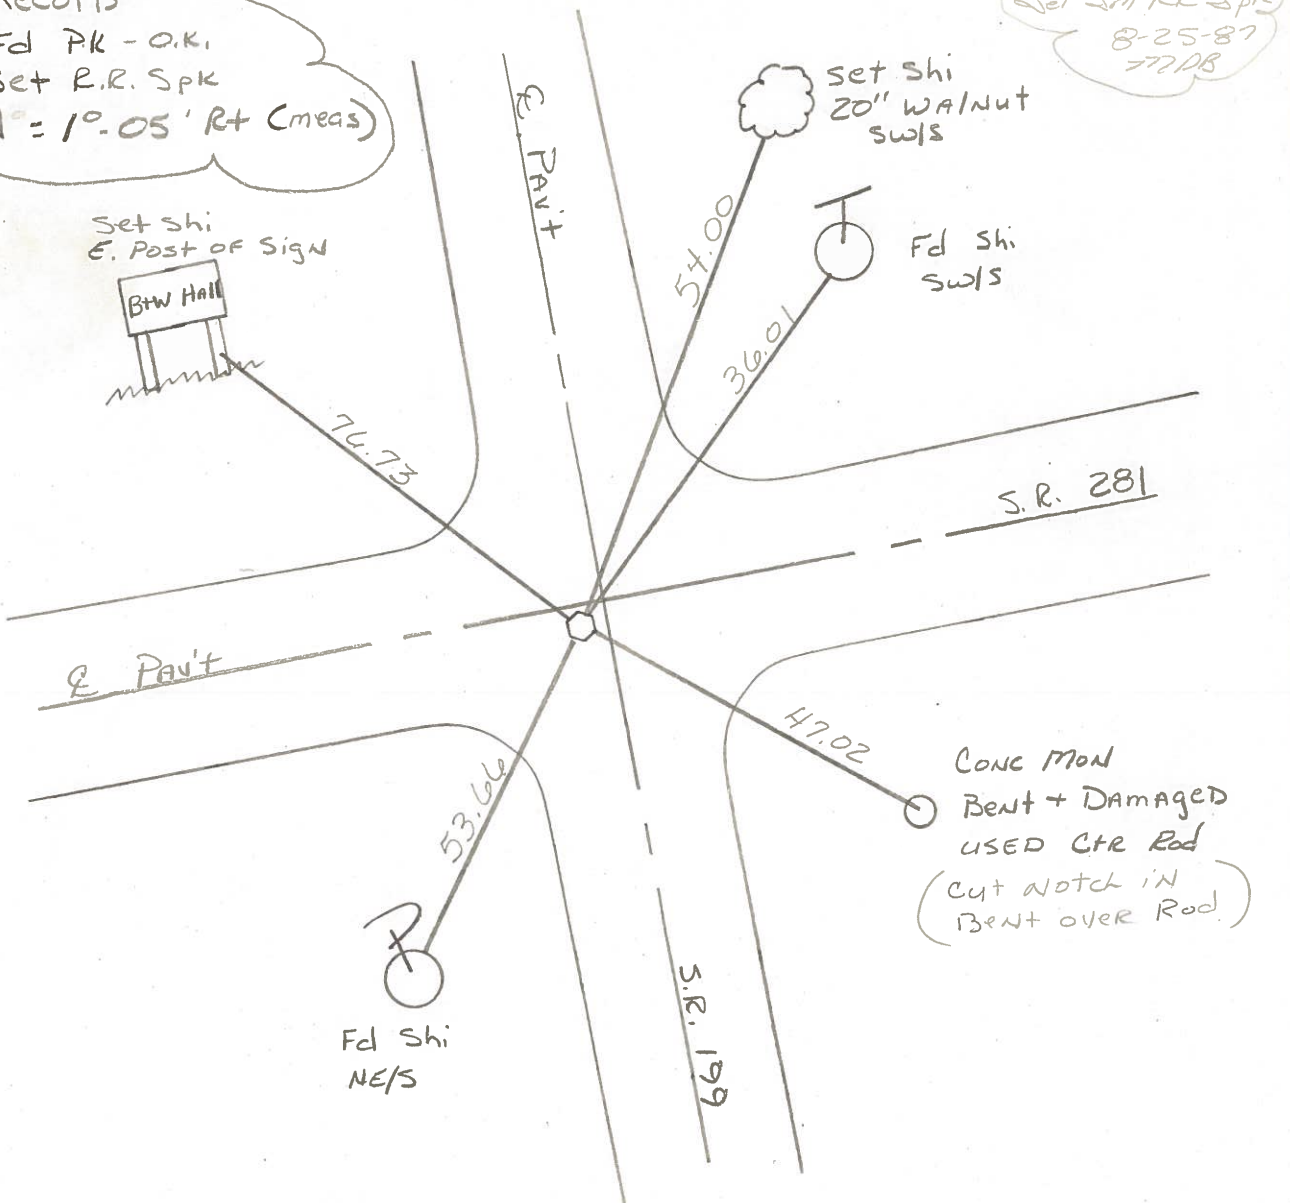

County WOOD S.R. 199

Township MONTGOMERY

Section 20

T4N, R12E

Personnel BURNSIDE

SMITH

BOWERS

Date 11-18-71 (5-22-78) ^{CHKD}


Weather CLOUDY

Temp. +65°

17	16
20	21



#30

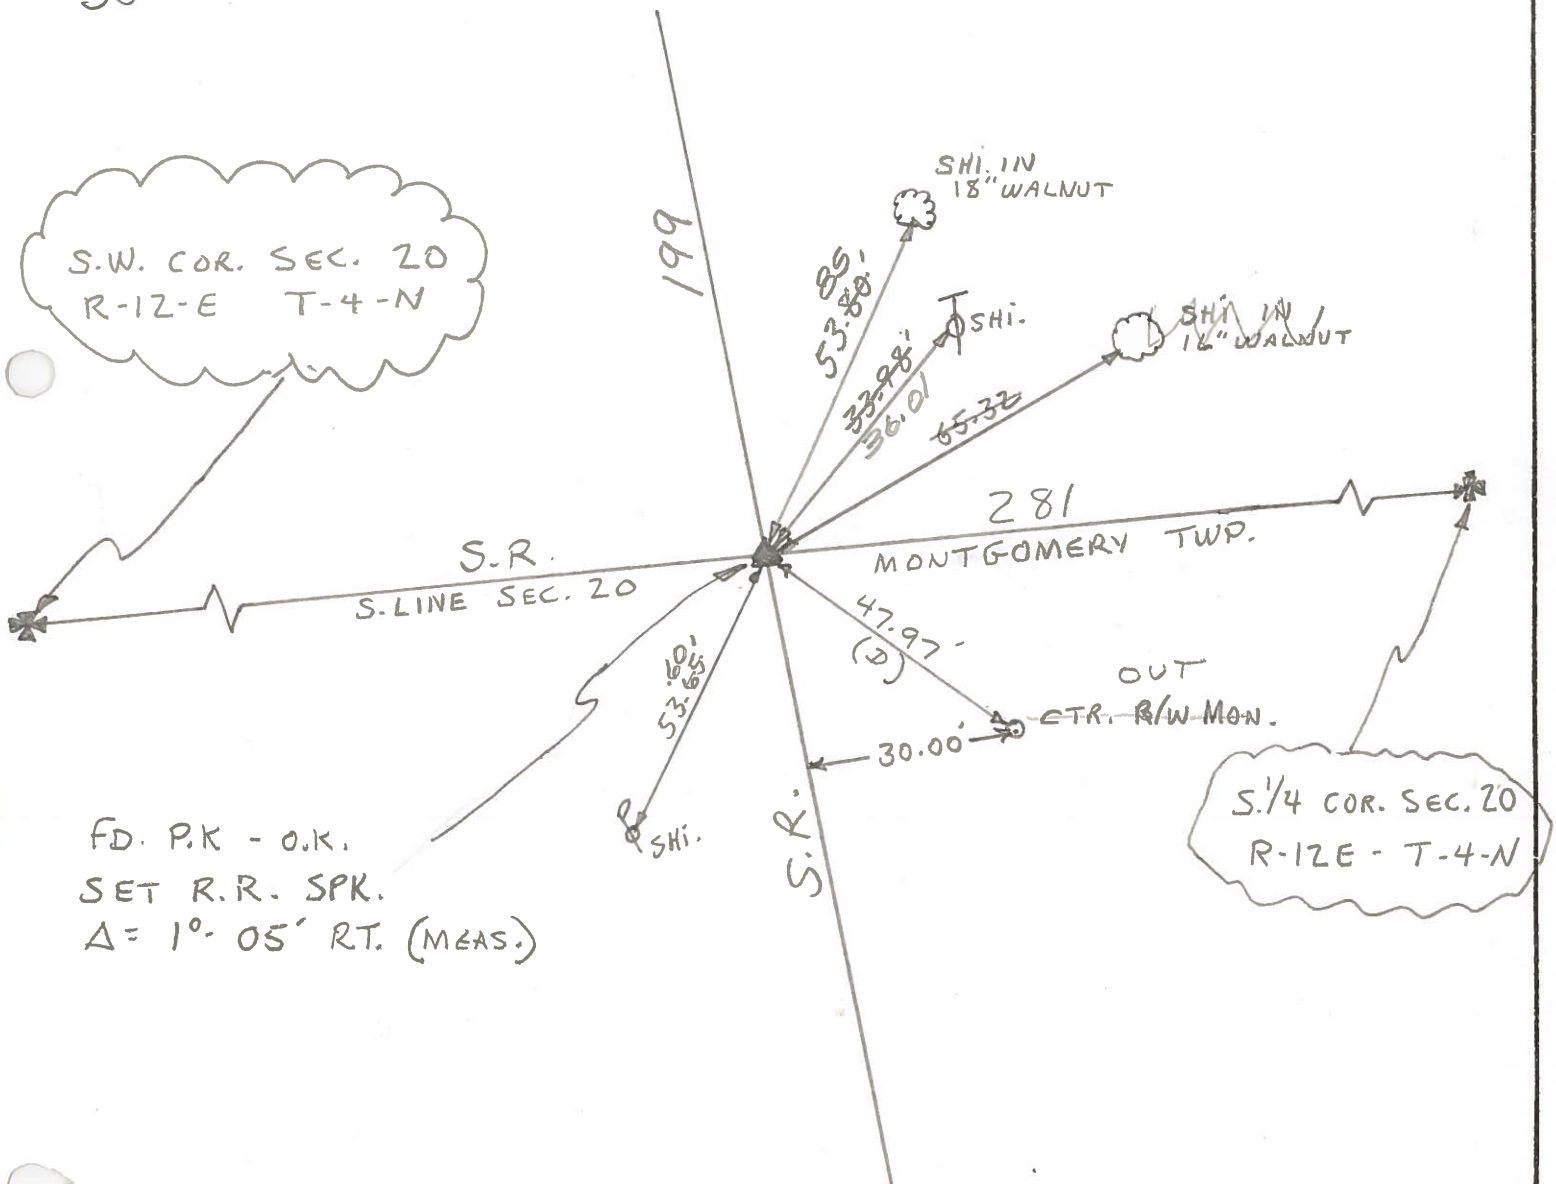

FD. P.K. - O.K.
SET R.R. SPK.
 $\Delta = 1^{\circ} 05' \text{ RT. (MEAS.)}$

COPIED

SHEET NO. 30

PERSONNEL TITLE PERSONNEL TITLE

BURNSIDE

COUNTY WOOD

DATE 11-18-71

SMITH

S. R. 199 & 281

WEATHER CLOUDY

BOWERS

SEC. 5. LINE SEC. 20

TEMP. +65°

DESCRIPTION

LEFT

CENTER LINE

RIGHT

JOB NO.

OK - 5.22-78
R.B.

30

S.W. COR. SEC. 20
R-12-E T-4-N
MONTGOMERY
Twp.

FD. P.K. - OK -
SET R.R. SPK.
 $\Delta = 1^{\circ}05'$ ET. (MEAS.)

S. R.
S. LINE SEC. 20

199

53.80'
35.98'
65.32'

SHI. IN
18" WALNUT

SHI.

SHI. IN
16" WALNUT

281
MONTGOMERY TWP
T-4-N R-12-E

47.97'
(D)

30.00' CTR. R/W MON.

53.65'
SHI.

S. R.

S. 1/4 COR. SEC. 20
R-12-E T-4-N
MONTGOMERY
Twp.