

O.D.O.T. DISTRICT 2 SURVEY OFFICE (USE ONLY)

PERSONNEL

REFERENCE NO. 30A

SHEET OF

NOTES ASTON

DATE 7/18/24

ROUTE SR 199

H.C. NIESE

WEATHER SUNNY

COUNTY WOOD

R.C. PRESTON-COLVIN

TEMP. 77°

TOWNSHIP MONTGOMERY

DWG BY BARRIERE

PID 113719

SECTION 20

T 4 N R 12 E

TYPE MONUMENT MONBOW W/ 1" IPIN

ON SURFACE - BELOW ON

OFFSET $\varnothing$ PAVEMENT 0.5' LT LT : RT


 TO EDGE PAVEMENT

STATION: 499+34

HORZ. DATUM: NAD83(2011)/WOOD LDP GEOID: 18


GRID: NORTHING: 590309.087 EASTING: 1691280.426

LDP: NORTHING: 412664.283 EASTING: 202881.050

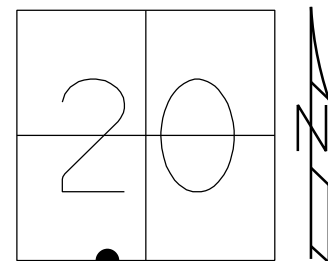

RECORD:
FD P.K.NAIL
8/18/09, MC
SET MAG/WASHER
11/10/09, MC
FD MAG/WASHER
9/10/21, DSA
FD SHANK
NEWREF 30A
7/18/24, TDN
POINT NOT RE-ESTABLISHED
AFTER PID 113719
10/31/24, TDN

****NO POINT PRESENT****

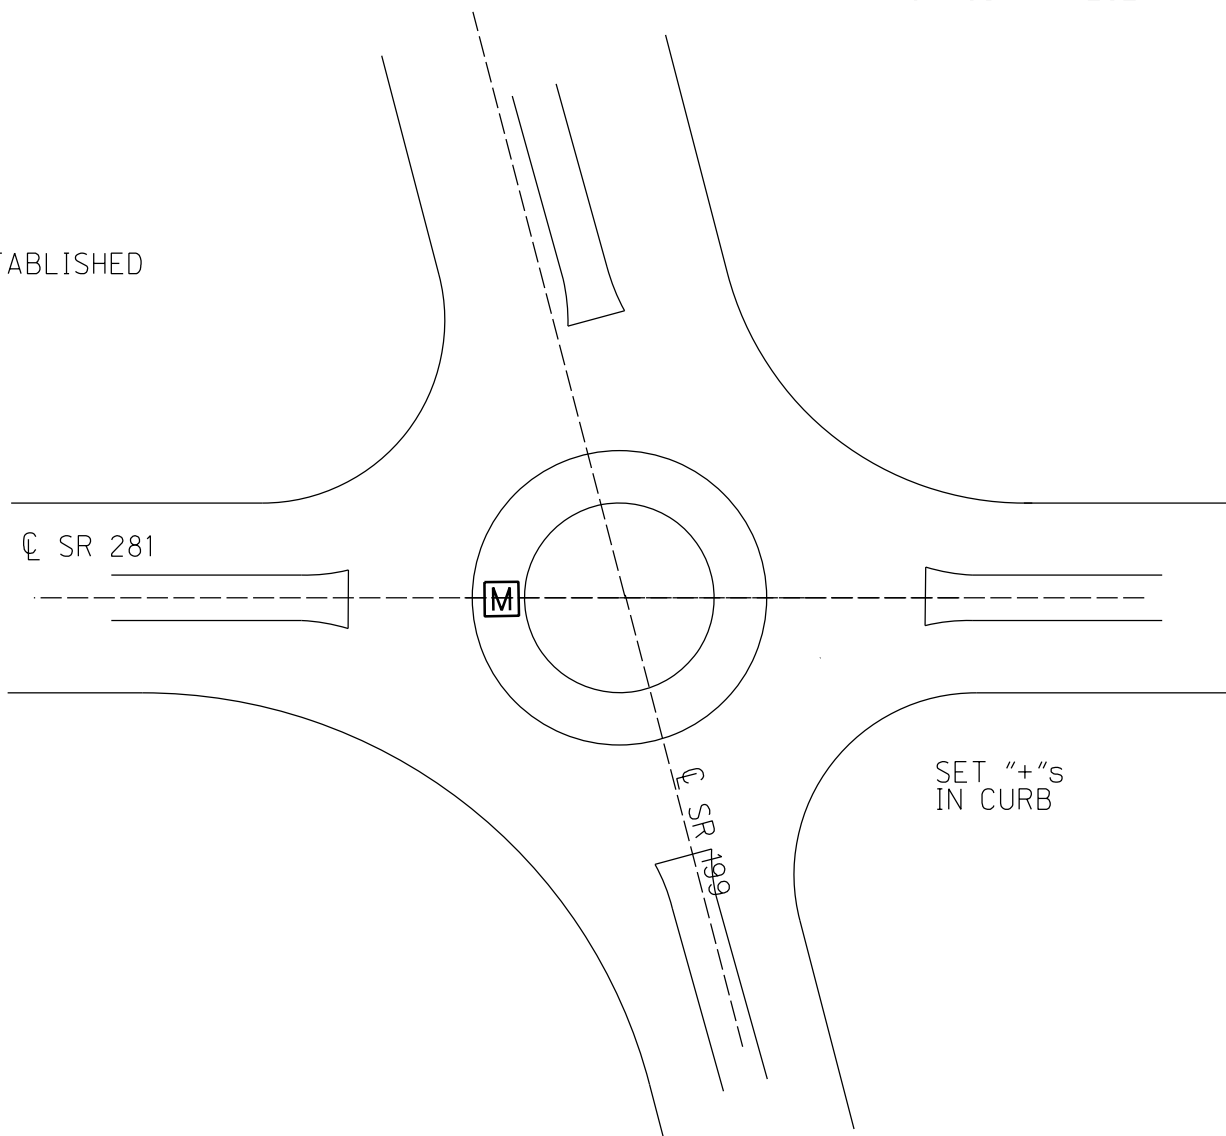

O.D.O.T. DISTRICT 2 SURVEY OFFICE (USE ONLY)

PERSONNEL

REFERENCE NO. 30 A

SHEET 17 OF 45

NOTES_HUSS

DATE 8/18/09ROUTE SR 199

H.C. CANTERBURY

WEATHER CLOUDY

COUNTY WOOD

R.C. HUSS

TEMP. 86°

TOWNSHIP MONTGOMERYDWG BY RHOADES

PID 101286

T_4_N R_12_E

TYPE MONUMENT P.K.NAIL

ON SURFACE - ~~BELOW~~ ON

OFFSET @ PAVEMENT 0.3' LT : RT


_____TO_____EDGE PAVEMENT

STATION: 499+35


HORZ.DATUM: NAD83(2011)

GEOID: 2012A

GRID: NORTHING: 590309.092

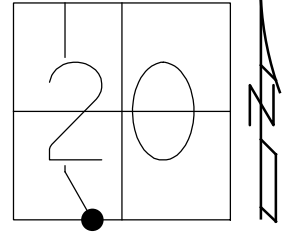EASTING: 1691280.411

RECORD:
FD P.K.NAIL
8/18/09, MC
SET MAG/WASHER
11/10/09, MC
FD MAG/WASHER
9/10/21, DSA

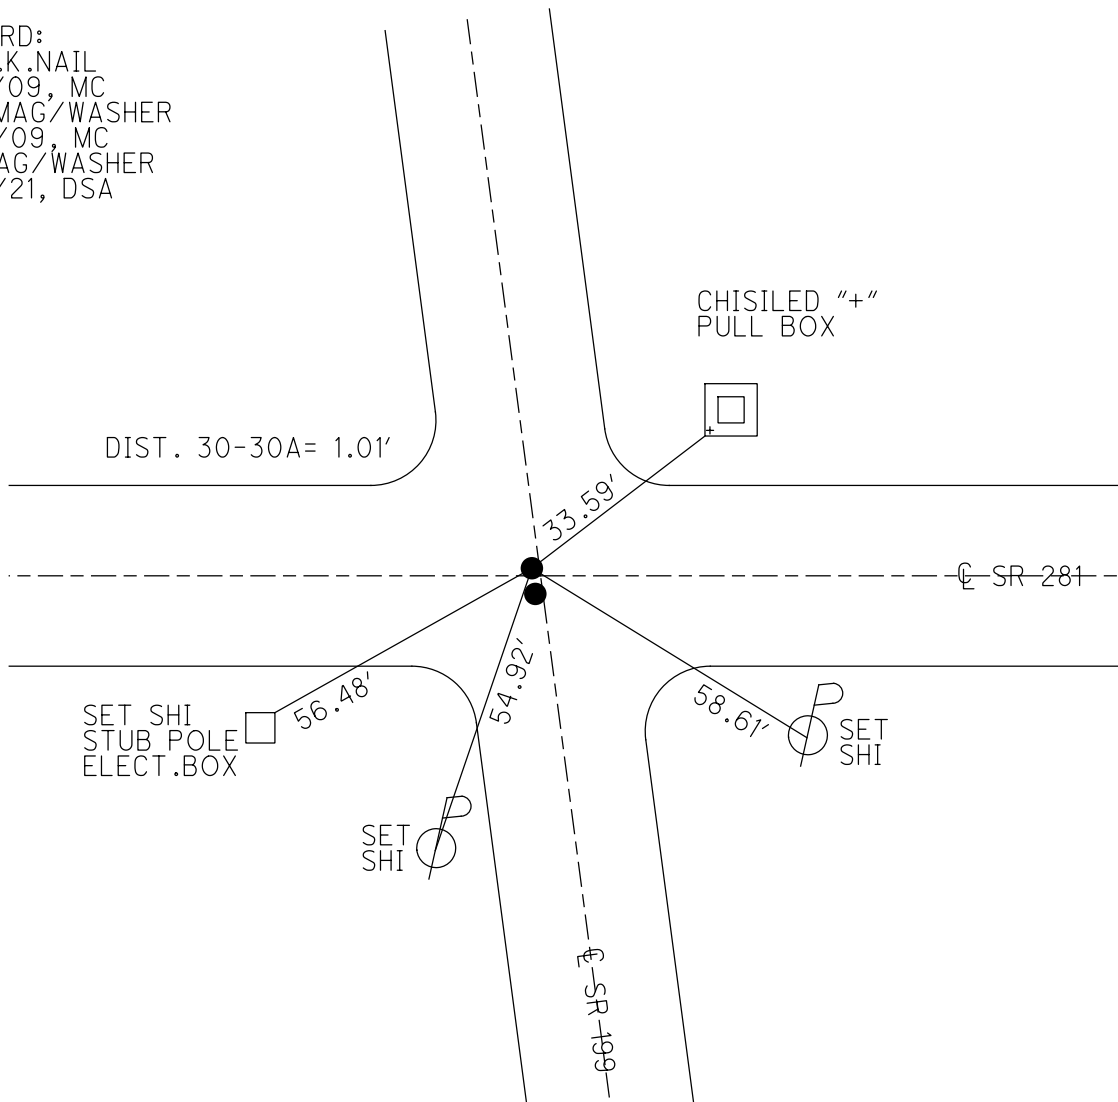

O.D.O.T. DISTRICT 2 SURVEY OFFICE (USE ONLY)

PERSONNEL

REFERENCE NO. 30A

SHEET 17 OF 45

NOTES HUSS

DATE 08-18-09

ROUTE SR 199

H.C. CANTERBURY

WEATHER SUNNY

COUNTY WOOD

R.C. HUSS

TEMP. 86° F

TOWNSHIP MONTGOMERY

SECTION 20

T 4 N R 12 E

TYPE MONUMENT PK NAIL


ON SURFACE - ~~BELOW~~ ON

LEFT - Q PAV'T - ~~RIGHT~~ 0.3', ON Q SR 281

- TO - EDGE PAVEMENT

S.L.M. 499+35

Grid: Northing: 590309.092 Easting: 1691280.411

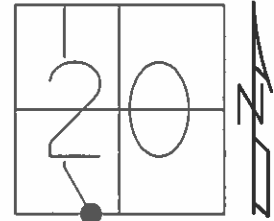

RECORD

11-10-09 MC
RESET MAG/W

