

O.D.O.T. DISTRICT 2 SURVEY OFFICE (USE ONLY)

PERSONNEL

REFERENCE NO. 1

SHEET 4 OF 26

NOTES ASTON
H.C. NIESE
R.C. PRESTON-COLVIN

DATE 5/21/24
WEATHER SUNNY
TEMP. 75°

ROUTE SR 235
COUNTY WOOD
TOWNSHIP JACKSON
SECTION 35

DWG BY BARRIERE PID 101290

T 3 N R 9 E

TYPE MONUMENT LG RR SPIKE

ON SURFACE - BELOW 6" DOWN

OFFSET $\angle$ PAVEMENT 1.8' LT ~~LT~~ : RT

TO EDGE PAVEMENT

STATION: 0+00

HORIZ.DATUM: WOOD LDP


GEOID: 2018

GRID: NORTHING:


EASTING:

LDP: NORTHING: 549689.883

EASTING: 1613801.891

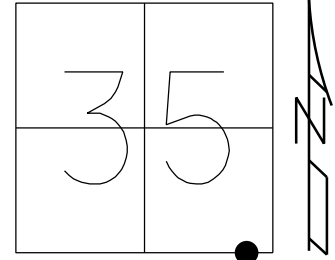

RECORD:
SET P.K./WASHER
10-27-93, MB
FD LG.R.R.SPIKE
3 1/2" DOWN
REF1
6-18-18, JLL
DNF
4-27-21, JFO
FD LG RSPK
6" DOWN
REF1
2/3/23, TDN
8/14/23, TDN
FD LG RSPK
6" DOWN
5/21/24, TDN

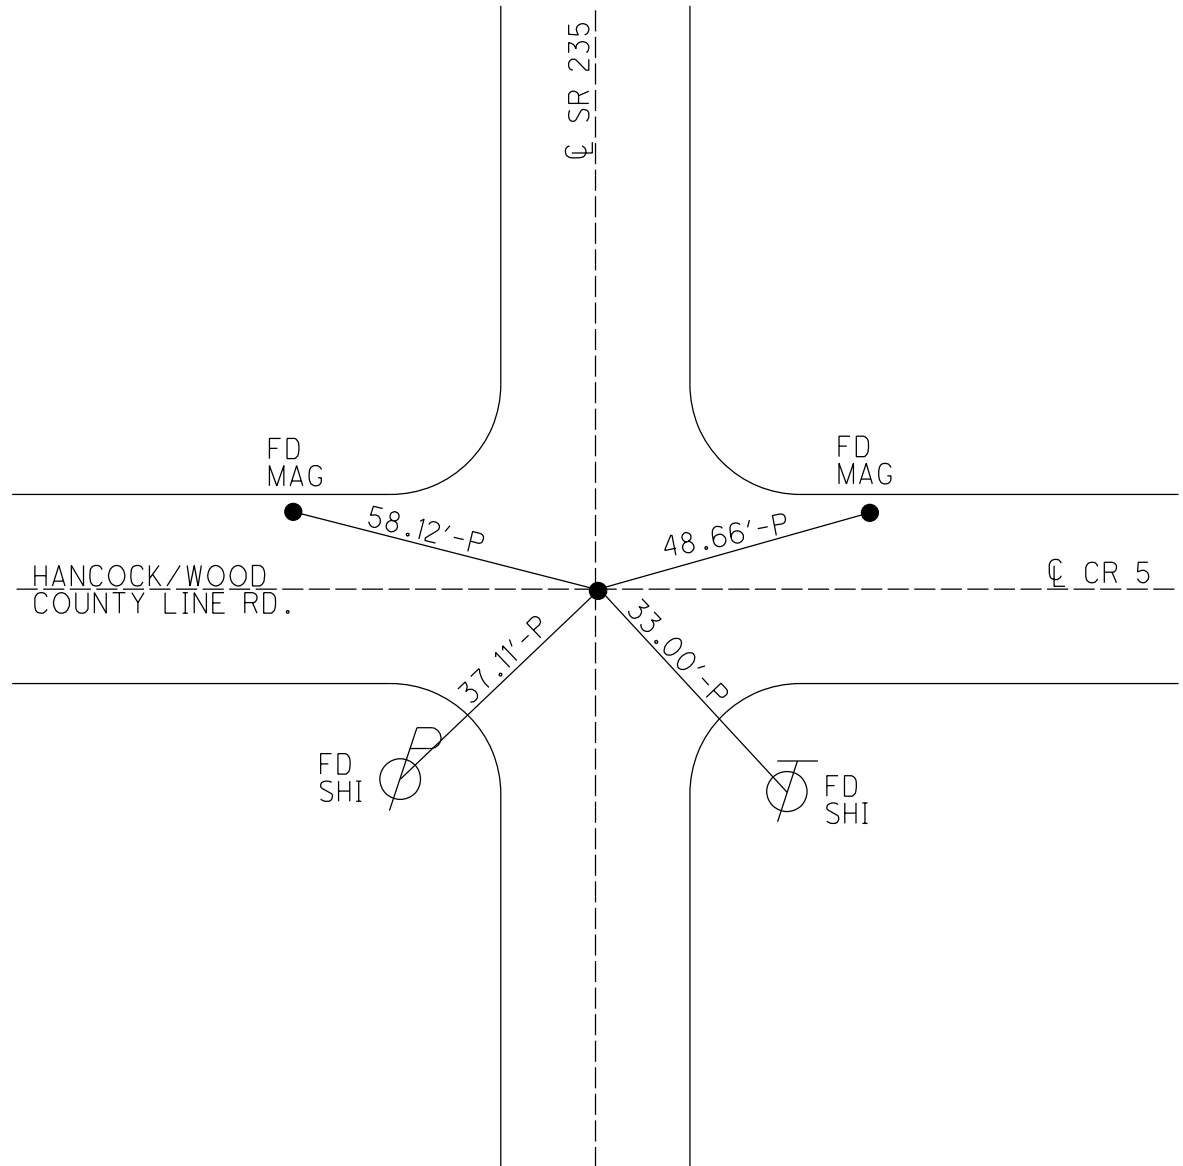

O.D.O.T. DISTRICT 2 SURVEY OFFICE (USE ONLY)

PERSONNEL

REFERENCE NO. 1

SHEET 1 OF 8

NOTES AUBLE

DATE 2-10-23

ROUTE SR 235

H.C. NIESE

WEATHER WINDY

COUNTY WOOD

R.C. MILLER

TEMP. 38°

TOWNSHIP JACKSON

SECTION 35

DWG BY RHOADES PID 101290

T 3 N R 9 E

TYPE MONUMENT LG.R.R.SPIKE

~~ON SURFACE~~ - BELOW 6"

OFFSET Q PAVEMENT ON LT : RT

- TO - EDGE PAVEMENT


STATION: 0+00

HORZ.DATUM: NAD83 2011


GEOID: NAVD88 2018

GRID: NORTHING: 549689.883

EASTING: 1613801.891

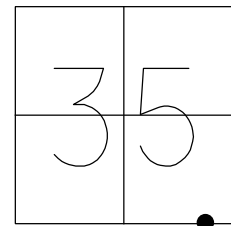

RECORD:
SET P.K./WASHER
10-27-93, MB
FD LG.R.R.SPIKE
3 1/2" DOWN
REF1
6-18-18, JLL
DNF
4-27-21, JFO
FD LG RSPK
6" DOWN
REF1
2/3/23, TDN
8/14/23, TDN

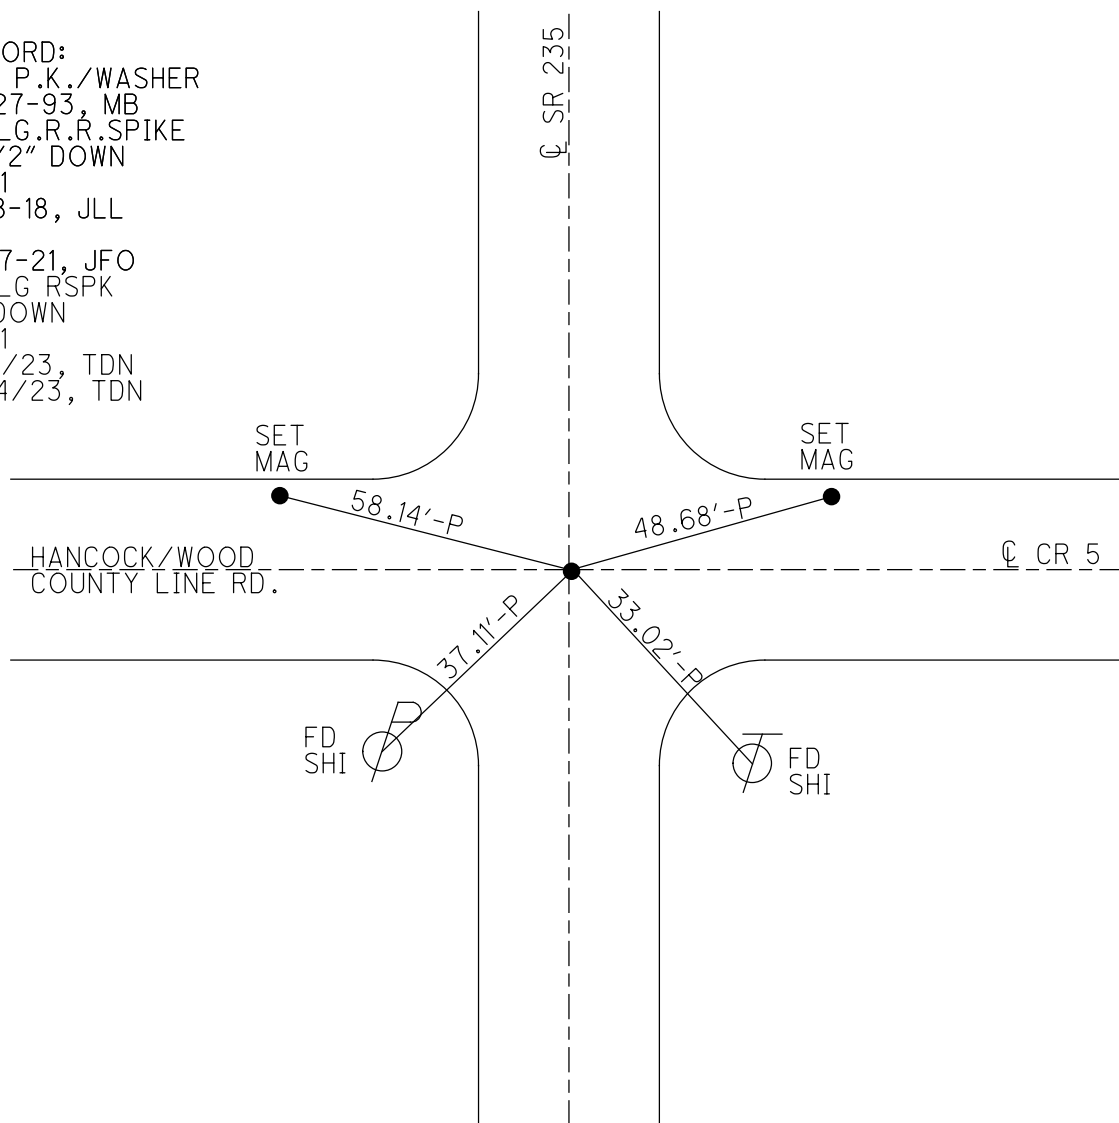

O.D.O.T. DISTRICT 2 SURVEY OFFICE (USE ONLY)

PERSONNEL

REFERENCE NO. 1

SHEET 1 OF 8

NOTES HAGEMEYER

DATE 6/8/18

ROUTE SR 235

H.C. LEU

WEATHER CLOUDY

COUNTY WOOD

R.C. HAGEMEYER

TEMP. 72°

TOWNSHIP JACKSON

SECTION 35

DWG BY RHOADES PID PAVETRAIN

T 3 N R 9 E

TYPE MONUMENT LG.R.R.SPIKE

~~ON SURFACE~~ - BELOW 3 1/2"

OFFSET Q PAVEMENT ON LT : RT

- TO - EDGE PAVEMENT


STATION: 0+00

HORIZ.DATUM: NAD83 2011


GEOID: NAVD88 2018

GRID: NORTHING: 549689.859

EASTING: 1613801.870

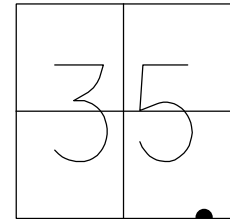

RECORD:
SET P.K./WASHER
10-27-93, MB
FD LG.R.R.SPIKE
3 1/2" DOWN
REF1
6-18-18, JLL
DNF
4-27-21, JFO

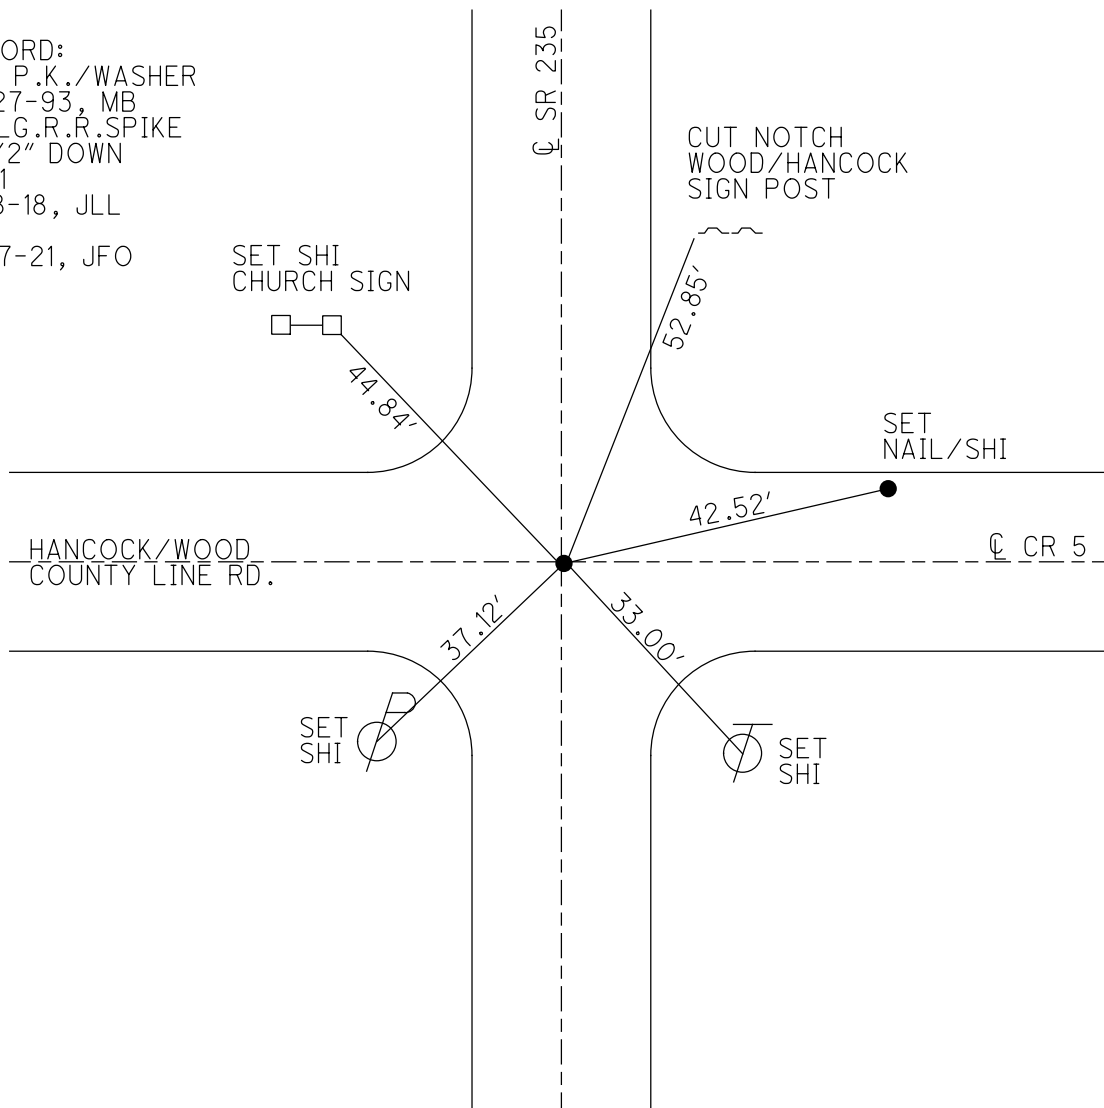

O.D.O.T. DISTRICT 2 SURVEY OFFICE (USE ONLY)

PERSONNEL _____ REFERENCE NO. 1 SHEET 1 OF 8

NOTES _____ DATE 5-6-04 ROUTE SR 235

H.C. CANTERBURY WEATHER SUNNY COUNTY WOOD

R.C. ARMS TEMP. 65°F TOWNSHIP JACKSON

SECTION 35

T 3 N R 9 E


TYPE MONUMENT _____ RR. SPIKE _____

~~ON SURFACE~~ - BELOW 2"

LEFT - ℄ PAV'T - RIGHT ON


- TO - EDGE PAVEMENT

S.L.M. 0+00

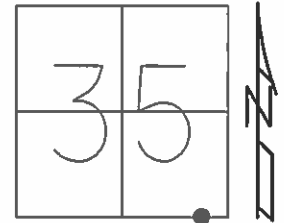

Grid: Northing: 549689.974 Easting: 1613801.886

RECORD:
SET PK/WASHER
10-27-93 M.B.

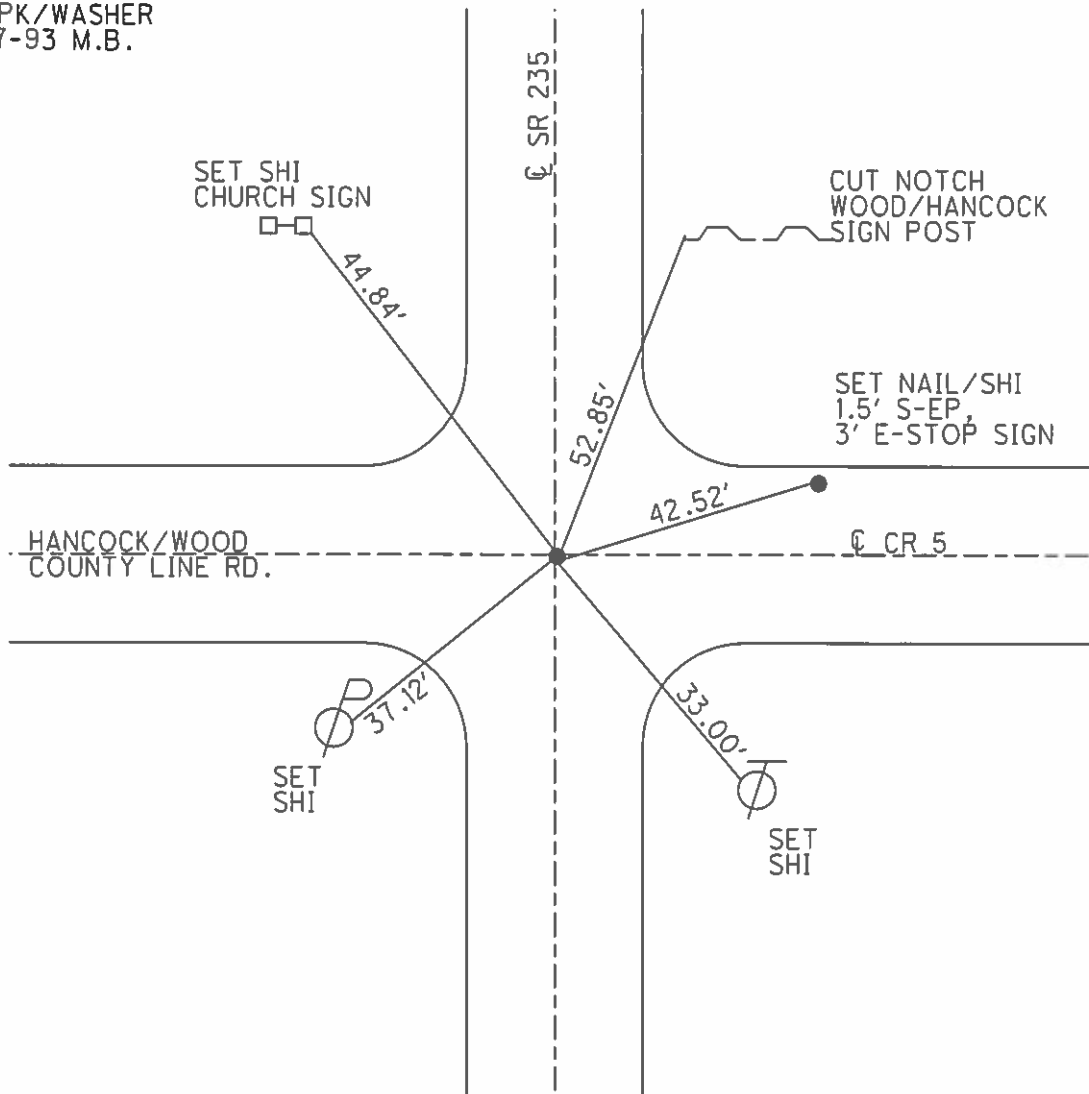

O.D.O.T. DISTRICT 2 SURVEY OFFICE

PERSONNEL

REFERENCE NO. 1

SHEET 1 OF 5

NOTES NUHFER

DATE 5-6-04

ROUTE S.R. 235

H.C. CANTERBURY

WEATHER SUNNY

COUNTY WOOD

R.C. ARMS

TEMP. +65°

TOWNSHIP JACKSON

SECTION 35

T 3 N R 9 E


TYPE MONUMENT FD.RR SPK

ON SURFACE 2" BELOW

~~LEFT~~ - Q PAV'T YES

TO EDGE PAVEMENT

S.L.M. 0+00

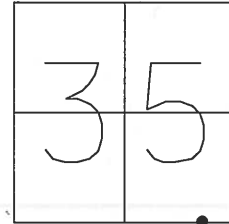

SET NAIL/SHI
CHURCH SIGN

RESET P.K. & WASHER
10-27-93
M.B.

CUT NOTCH
WOOD/HANCOCK
SIGN POST


SET NAIL/SHI
1.5' S-EP,
3' E-STOP SIGN

HANCOCK/WOOD
COUNTY LINE RD.

Q PAVEMENT

SET NAIL/SHI
N/E

SET NAIL/SHI
N/W

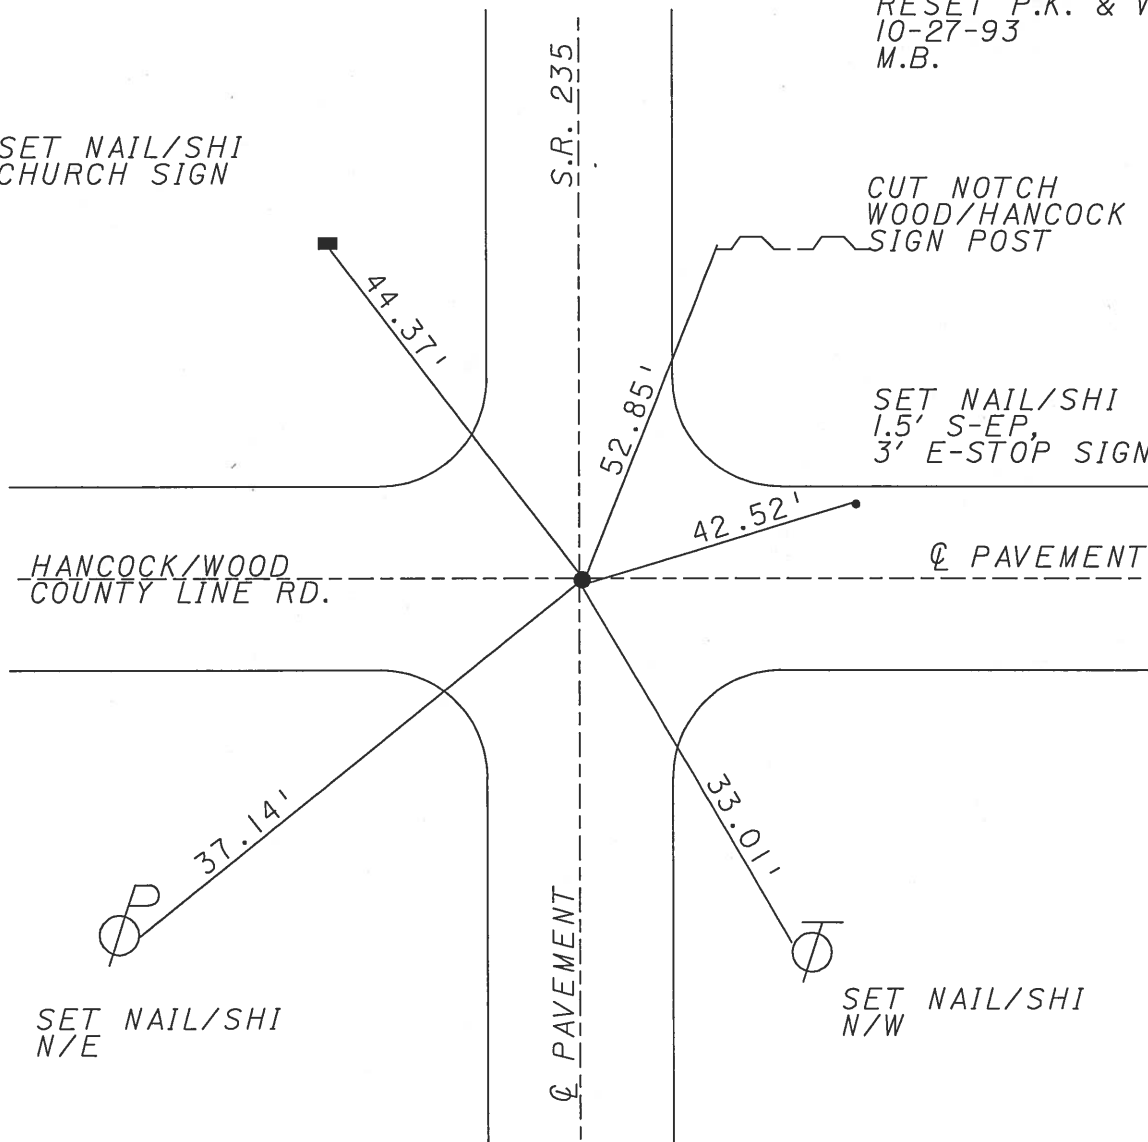

SHEET NO. 1
OK 11-29-83
DATE 12-8-75

PERSONNEL	TITLE	PERSONNEL	TITLE
BURNSIDE			
SMITH			
BOWERS			
MEAD			

COUNTY Wood

S. R. 235


WEATHER Cloudy

SEC. 35

TEMP. +36°

DESCRIPTION # CONTROL TIES HANCOCK-WOOD CO. LINE NORTH

JOB NO.

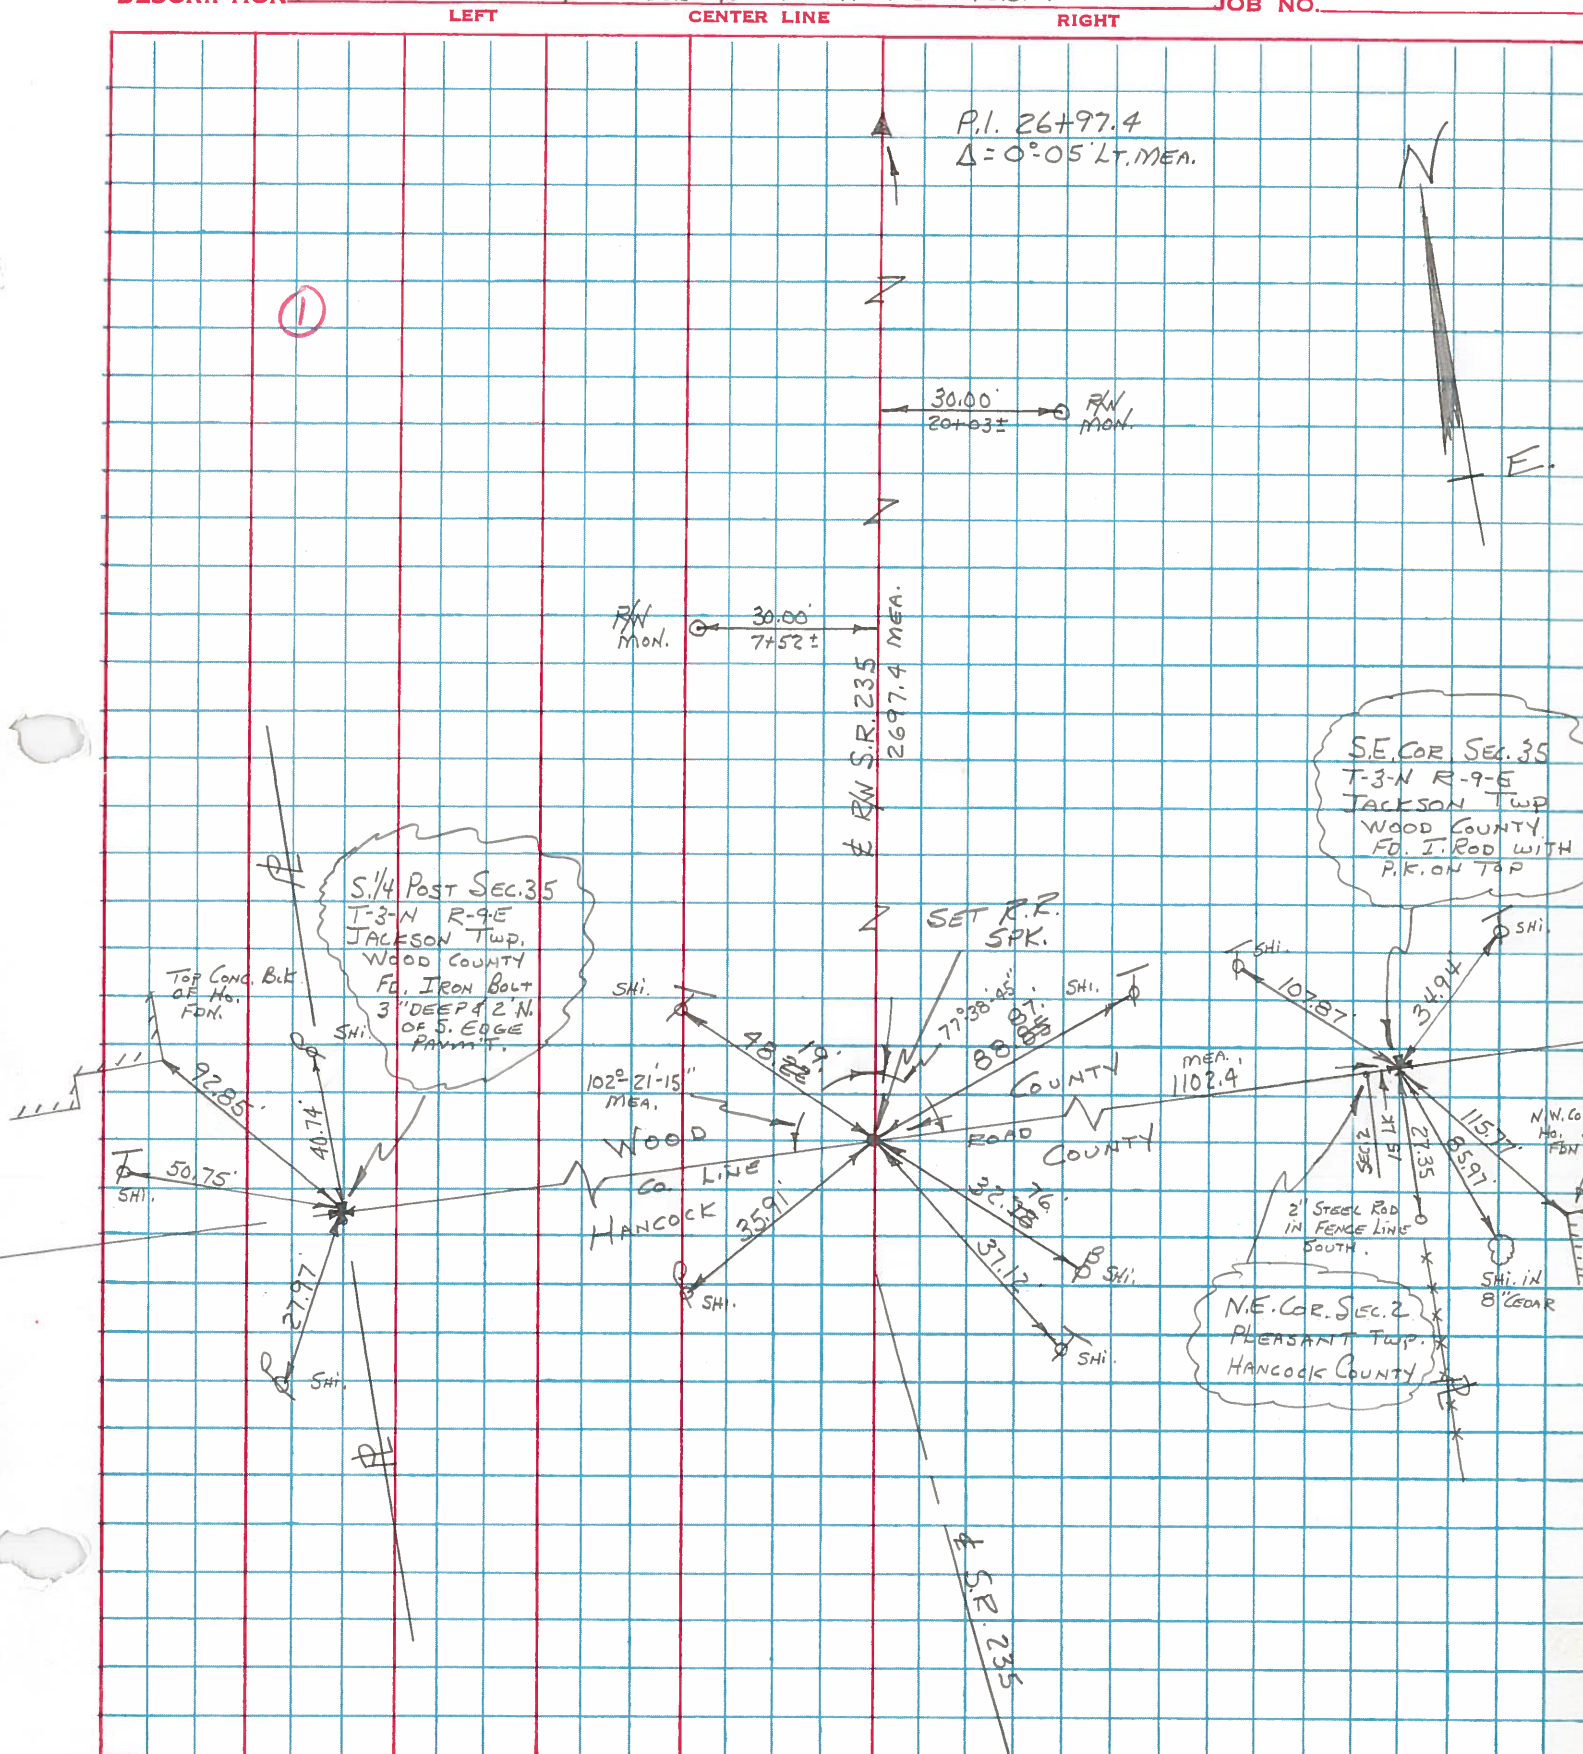

PERSONNEL	TITLE	PERSONNEL	TITLE
BURNSIDE			
SMITH			
BOWERS			

COUNTY WOOD DATE 4-28-72

S. R. 235 WEATHER CLEAR

SEC. 35 TEMP. +60°

DESCRIPTION HANCOCK-WOOD Co. LINE N. TO S.R. 18 JOB NO. _____

