

O.D.O.T. DISTRICT 2 SURVEY OFFICE (USE ONLY)

PERSONNEL

REFERENCE NO. 2

SHEET 4 OF 26

NOTES NIESE

DATE 10/25/24

ROUTE SR 235

H.C. NIESE

WEATHER CLOUDY

COUNTY WOOD

R.C. PRESTON-COLVIN

TEMP. 53°

TOWNSHIP JACKSON

DWG BY BARRIERE

PID 101290

SECTION 35

T 3 N R 9 E

TYPE MONUMENT MAG NAIL/WASHER

ON SURFACE - BELOW ON

OFFSET $\varnothing$ PAVEMENT LT : RT


 TO EDGE PAVEMENT

STATION: 26+96.8

HORZ.DATUM: NAD83(2011)/WOOD LDP GEOID: 2018


GRID: NORTHING: 373658.809 EASTING: 126512.778

LDP: NORTHING: 552317.132 EASTING: 1614410.791

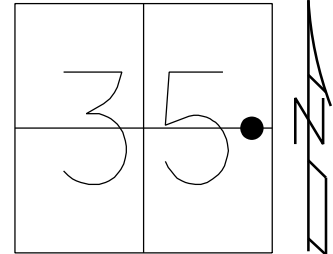

RECORD:

$\Delta = 0^\circ 05' \text{ LT}$
 SET P.K./WASHER
 10-27-93, MB
 SET MAG/WASHER
 08-03-04, MC
 FD MAG/WASHER
 REF2
 6-08-18, JLL
 FD MAG NAIL
 REF2
 4-27-21
 9-16-21, JFO
 1/11/23, JMR
 2/1/23, JAM
 5/23/23, TDN
 8/14/23, TDN
 SET MAG/WASHER
 10/25/24, TDN

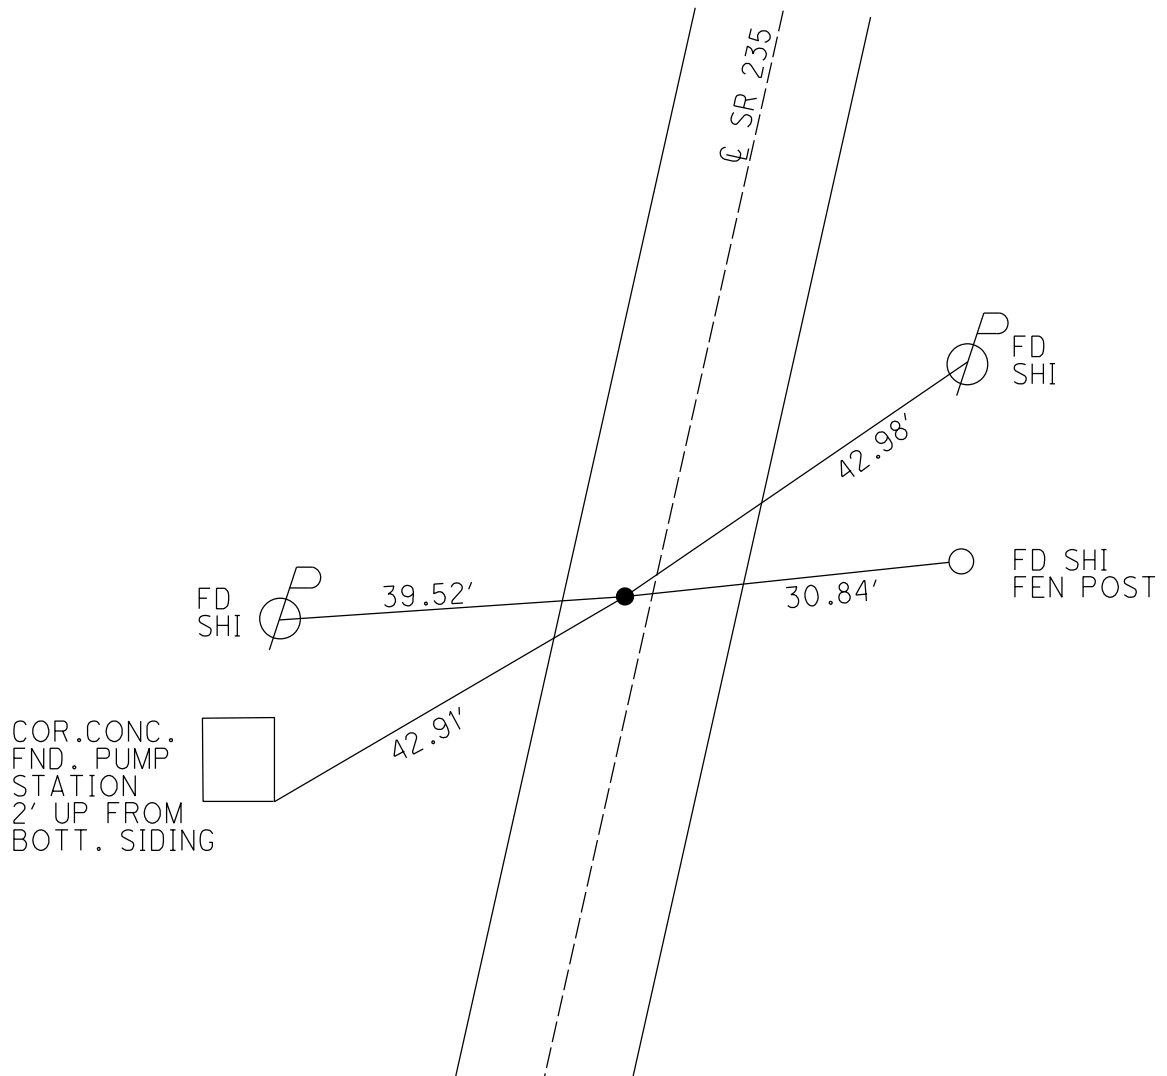

O.D.O.T. DISTRICT 2 SURVEY OFFICE (USE ONLY)

PERSONNEL

REFERENCE NO. 2

SHEET 2 OF 8

NOTES AUBLE

DATE 5-23-23

ROUTE SR 235

H.C. NIESE

WEATHER CLEAR

COUNTY WOOD

R.C. AUBLE

TEMP. 69°

TOWNSHIP JACKSON

SECTION 35

DWG BY AUBLE

PID PAVETRAIN

T 3 N R 9 E

TYPE MONUMENT MAG NAIL

ON SURFACE - ~~BELOW~~ ON

OFFSET CL PAVEMENT 3.7' LT : ~~RT~~
5.9' TO LT EDGE PAVEMENT


STATION: 26+96.80

HORZ.DATUM: NAD83(2011)

GEOID: NAVD88 2018

GRID: NORTHING: 552317.132


EASTING: 1614410.791

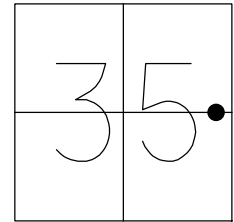

RECORD:

$\Delta = 0^{\circ} 05' \text{ LT}$
SET P.K./WASHER
10-27-93, MB
SET MAG/WASHER
08-03-04, MC
FD MAG/WASHER
REF2
6-08-18, JLL
FD MAG NAIL
REF2
4-27-21
9-16-21, JFO
1/11/23, JMR
2/1/23, JAM
5/23/23, TDN
8/14/23, TDN

COR.CONC.
FND. PUMP
STATION

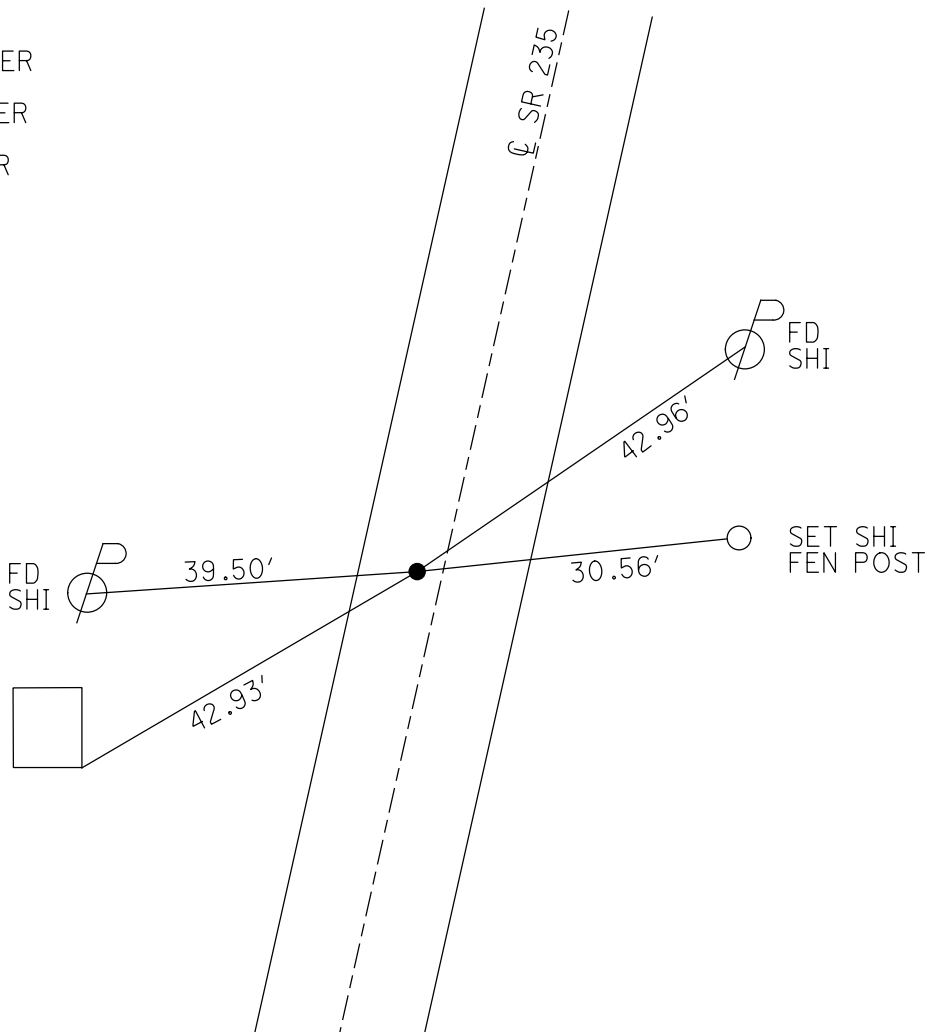

O.D.O.T. DISTRICT 2 SURVEY OFFICE (USE ONLY)

PERSONNEL

REFERENCE NO. 2

SHEET 2 OF 8

NOTES RHOADES DATE 4-27-21

H.C. O'DONNELL WEATHER WINDY

R.C. RHOADES TEMP. 64° F

ROUTE SR 235

COUNTY WOOD

TOWNSHIP JACKSON

SECTION 35

DWG BY AUBLE PID PAVETRAIN

T 3 N R 9 E

TYPE MONUMENT MAG NAIL

ON SURFACE - ~~BELOW~~ ON

OFFSET Q PAVEMENT 3.7' LT : ~~RT~~

5.9' TO LT EDGE PAVEMENT


STATION: 26+96.80

HORZ.DATUM: NAD83(2011)

GEOID: NAVD88 2018

GRID: NORTHING: 552317.130

EASTING: 1614410.799

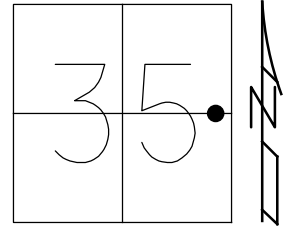

RECORD:

$\Delta = 0^\circ 05' \text{ LT}$
SET P.K./WASHER
10-27-93, MB
SET MAG/WASHER
08-03-04, MC
FD MAG/WASHER
REF2
6-08-18, JLL
FD MAG NAIL
REF2
4-27-21
9-16-21, JFO
1/11/23, JMR

COR.CONC.
FND. PUMP
STATION



39.51'

42.95'

Q SR 235

42.97'



FD
SHI

30.17'

FD SHI
TOP WOOD
FEN POST

O.D.O.T. DISTRICT 2 SURVEY OFFICE (USE ONLY)

PERSONNEL

REFERENCE NO. 2

SHEET 2 OF 8

NOTES RHOADES

DATE 4-27-21

ROUTE SR 235

H.C. O'DONNELL

WEATHER WINDY

COUNTY WOOD

R.C. RHOADES

TEMP. 64° F

TOWNSHIP JACKSON

SECTION 35

DWG BY AUBLE

PID PAVETRAIN

T 3 N R 9 E

TYPE MONUMENT MAG NAIL

ON SURFACE - ~~BELOW~~ ON

OFFSET CL PAVEMENT 3.7' LT : ~~RT~~

5.9' TO LT EDGE PAVEMENT


STATION: 26+96.80

HORZ.DATUM: NAD83(2011)

GEOID: NAVD88 2018

GRID: NORTHING: 552317.130

EASTING: 1614410.799

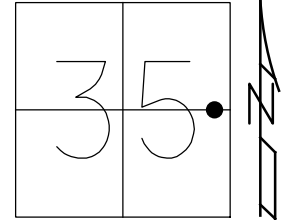

RECORD:

$\Delta = 0^\circ 05' \text{ LT}$
SET P.K./WASHER
10-27-93, MB
SET MAG/WASHER
08-03-04, MC
FD MAG/WASHER
REF2
6-08-18, JLL
FD MAG NAIL
REF2
4-27-21
9-16-21, JFO

COR.CONC.
FND. PUMP
STATION



39.51'


42.97'



30.17'

FD SHI
TOP WOOD
FEN POST

42.95'

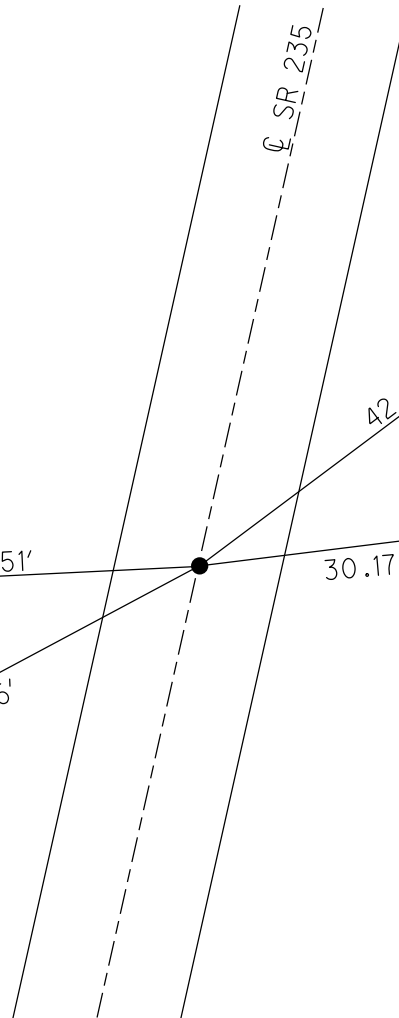

O.D.O.T. DISTRICT 2 SURVEY OFFICE (USE ONLY)

PERSONNEL _____ REFERENCE NO. 2 SHEET 2 OF 8

NOTES _____ DATE 05-06-04 ROUTE SR 235

H.C. CANERBURY WEATHER SUNNY COUNTY WOOD

R.C. ARMS TEMP. 65°F TOWNSHIP JACKSON

SECTION 35

T 3 N R 9 E


TYPE MONUMENT MAG/WASHER

ON SURFACE - ~~BELOW~~ ON _____

LEFT - ℄ PAV'T - ~~RIGHT~~ 3.7'

5.9' TO LT EDGE PAVEMENT

S.L.M. 26+96.80

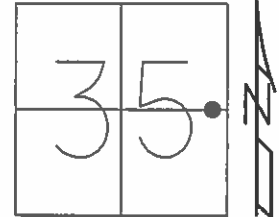


Grid: Northing: 552317.145 Easting: 1614410.753

RECORD:
Δ=0°05'LT

SET PK/WASHER
10-27-93, MB

SET MAG/WASHER
08-03-04, MC

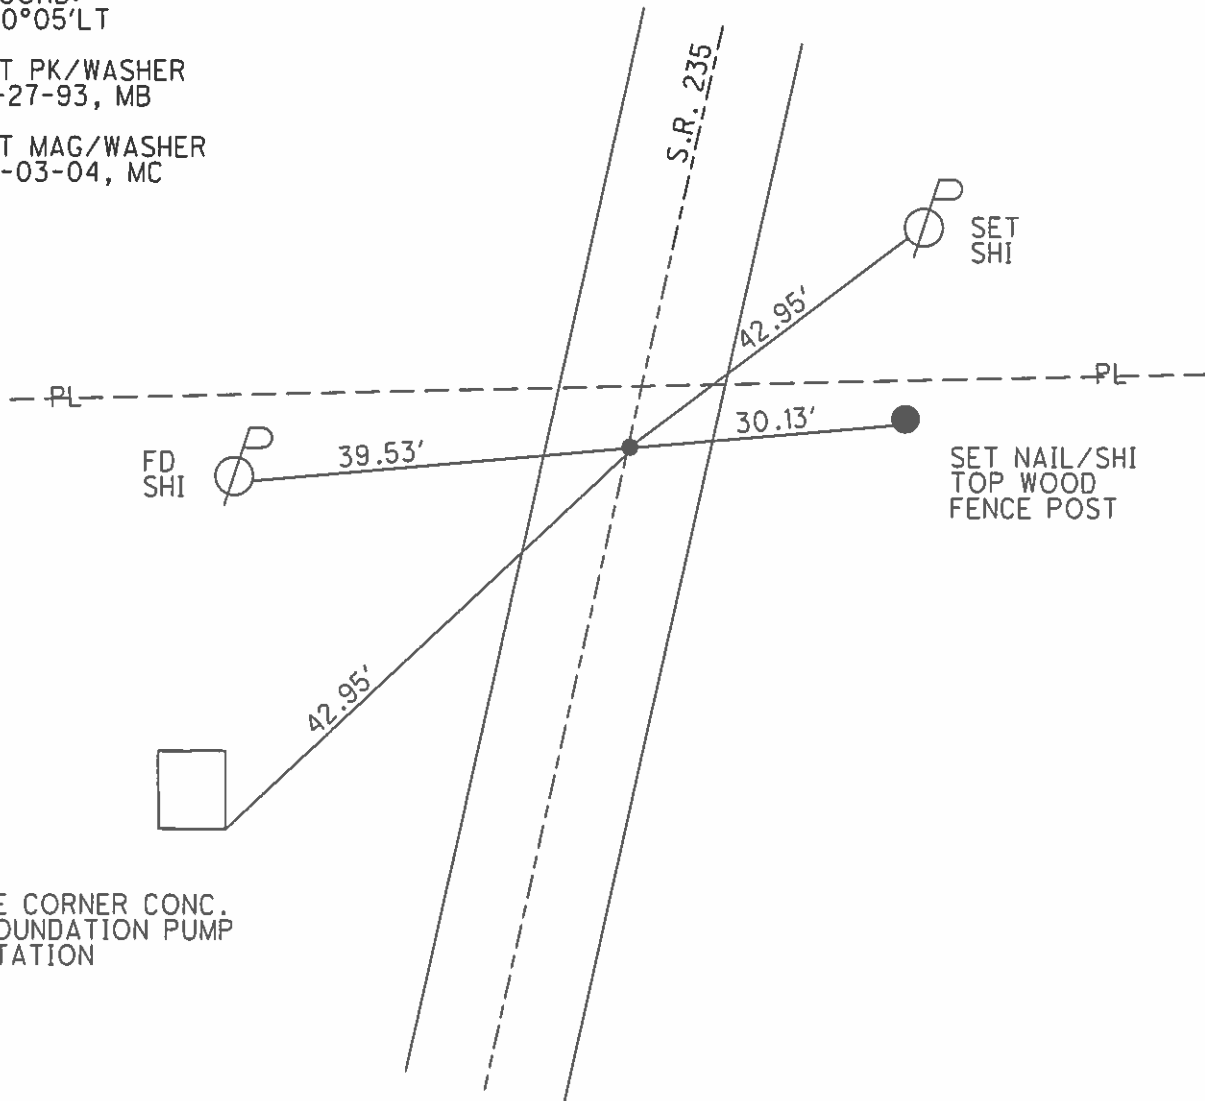

SE CORNER CONC.
FOUNDATION PUMP
STATION

O.D.O.T. DISTRICT 2 SURVEY OFFICE

PERSONNEL

REFERENCE NO. 2

SHEET 2 OF 5

NOTES NUHFER

DATE 05-06-04

ROUTE S.R. 235

H.C. CANTERBURY

WEATHER SUN

COUNTY WOOD

R.C. ARMS

TEMP. +65°

TOWNSHIP JACKSON

SECTION 35

T 3 N R 9 E


TYPE MONUMENT P.K. + WASHER

ON SURFACE YES

LEFT - Q PAV'T 3.7'

5.9' TO LT. EDGE PAVEMENT


S.L.M. 27+01

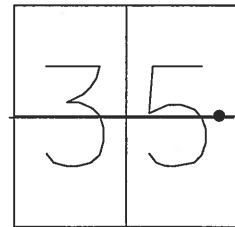

RECORD:
DELTA = 0°-05' LT.

RESET MAG & WASHER
08-03-04 M.C.

RESET P.K. & WASHER
10-27-93
M.B.

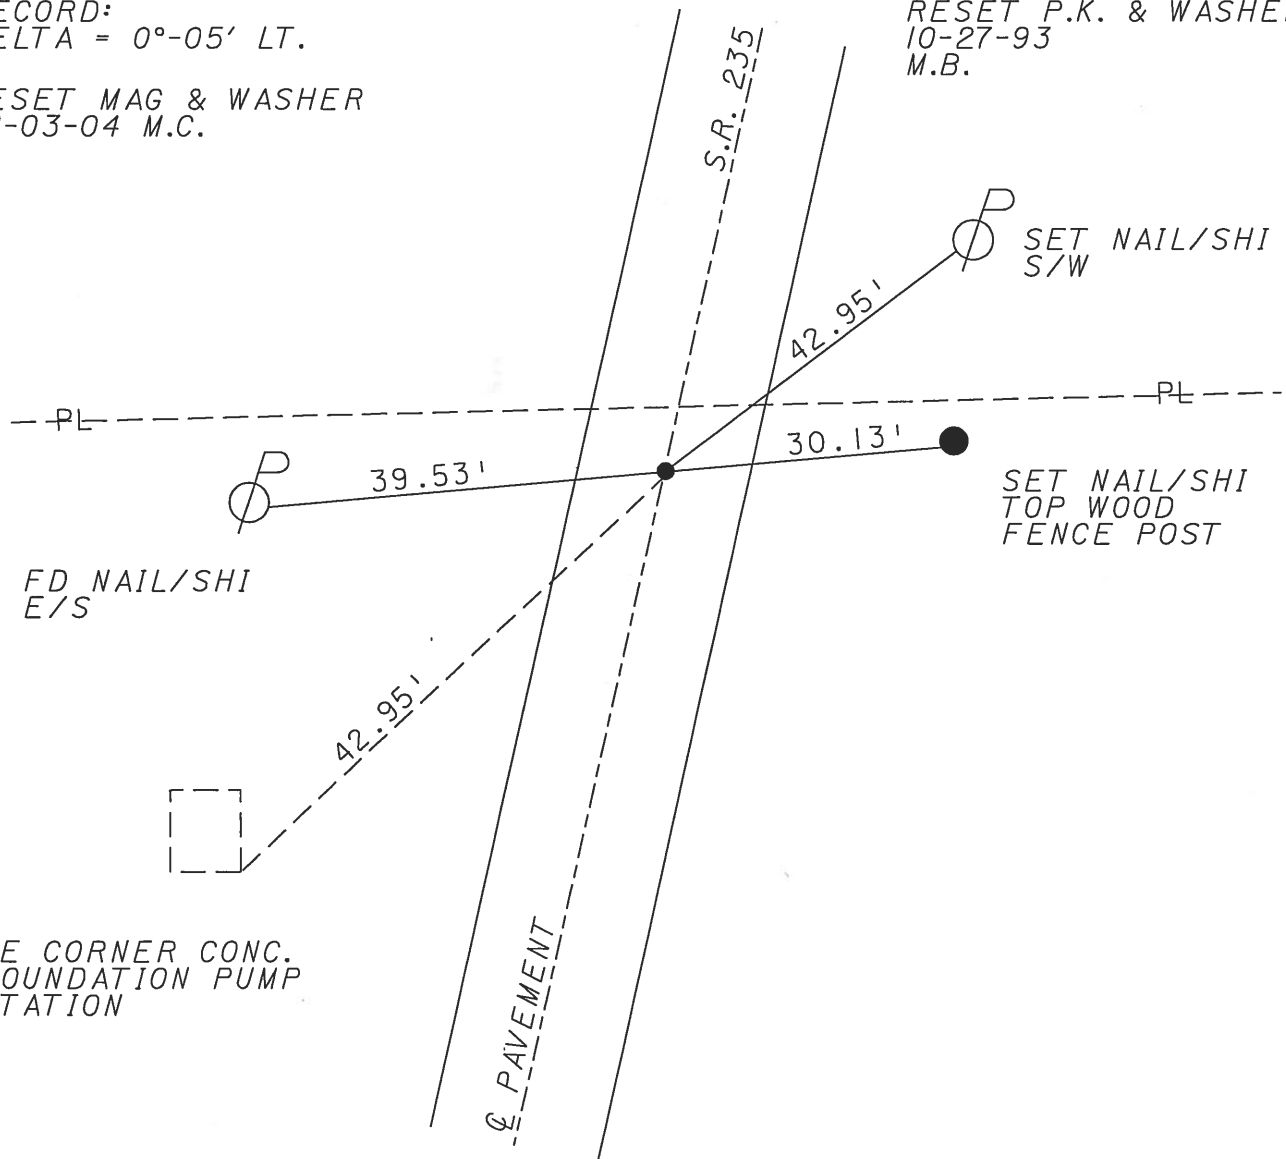

O.D.O.T. DISTRICT 2 SURVEY OFFICE

PERSONNEL

REFERENCE NO. 2

SHEET 1 OF 3

NOTES OTTO

H.C. KUSZ

R.C. BARNHISEL

DATE 7-21-93

WEATHER Cloudy

TEMP. +72°

ROUTE SR 235

COUNTY WOOD

TOWNSHIP Jackson

SECTION 35

T 3 N R 9 E


TYPE MONUMENT PK & WASHER

ON SURFACE - BELOW YES

LEFT- & PAV'T. - RIGHT 3.4

6.4 TO LT EDGE PAVEMENT


S.L.M. 27 + 01

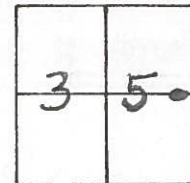

RECORD:



$\Delta = 0^{\circ} - 05' \text{ LT}$

RESET PK & WASHER
10-27-93
M13

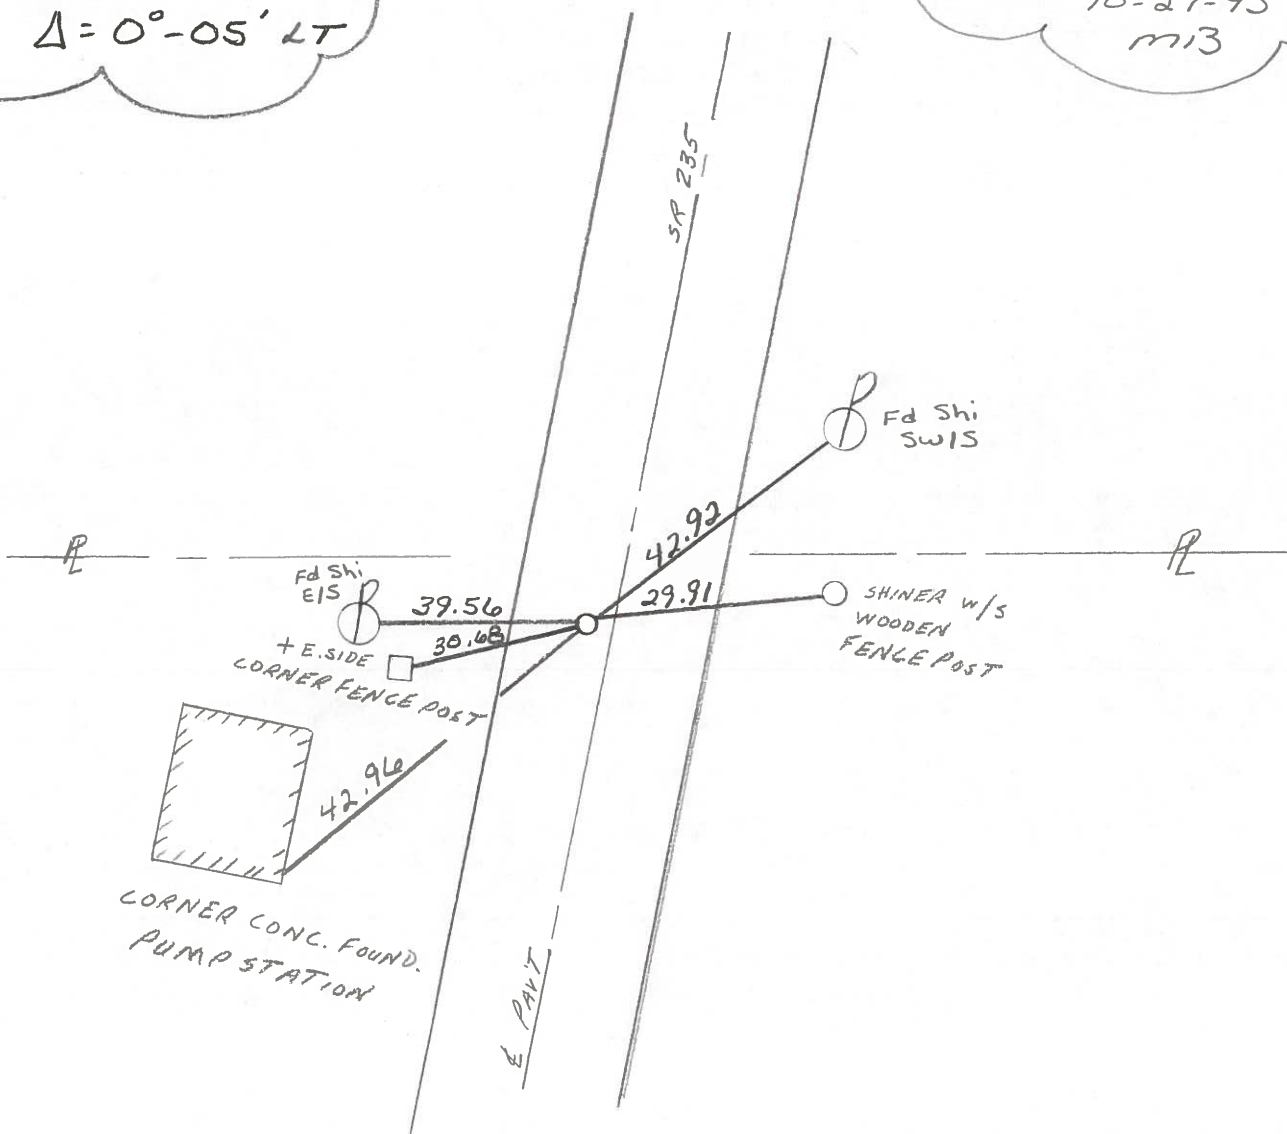

County WOOD S.R. 235Township JACKSONSection

T3N, R9E

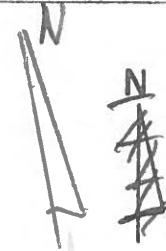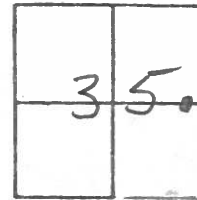Personnel BARNDHISEL HCHOUSEHOLDER R.C.LOEHRKE Date 11-28-83Weather RAINTemp. +40°

Fd: RR SPIKE @ SURFACE

SLM 26+95

3.7 LF of & PAVT SR235

#2

 $\Delta = 0^{\circ}05' LT$

PT 'A' Fd PK NAIL 1" BELOW SURFACE

SLM 39+60±


No Ties Available

ORIGIN UNKNOWN

SET PK + WASHER

7-25-85

C.L.

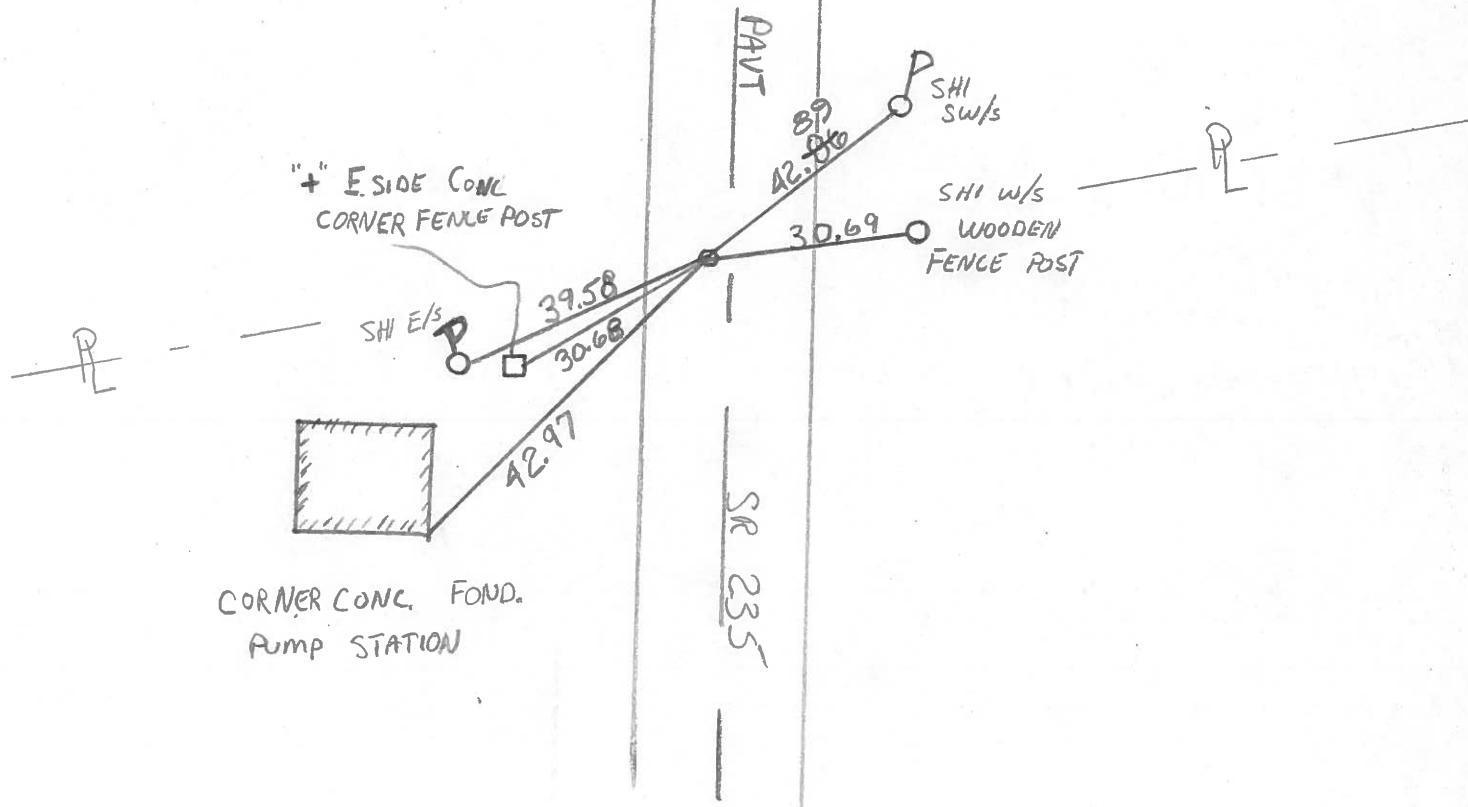

SHEET NO. 2
OK 11-28-83
DATE 12-8-75

PERSONNEL	TITLE	PERSONNEL	TITLE
BURNSIDE			
SMITH			
POWERS			
MEAD			


COUNTY WOODS. R. 235WEATHER CLOUDYSEC. 35 JACKSON TWP.TEMP. +36°DESCRIPTION ± CONTROL TIES

JOB NO. _____

LEFT

CENTER LINE

RIGHT

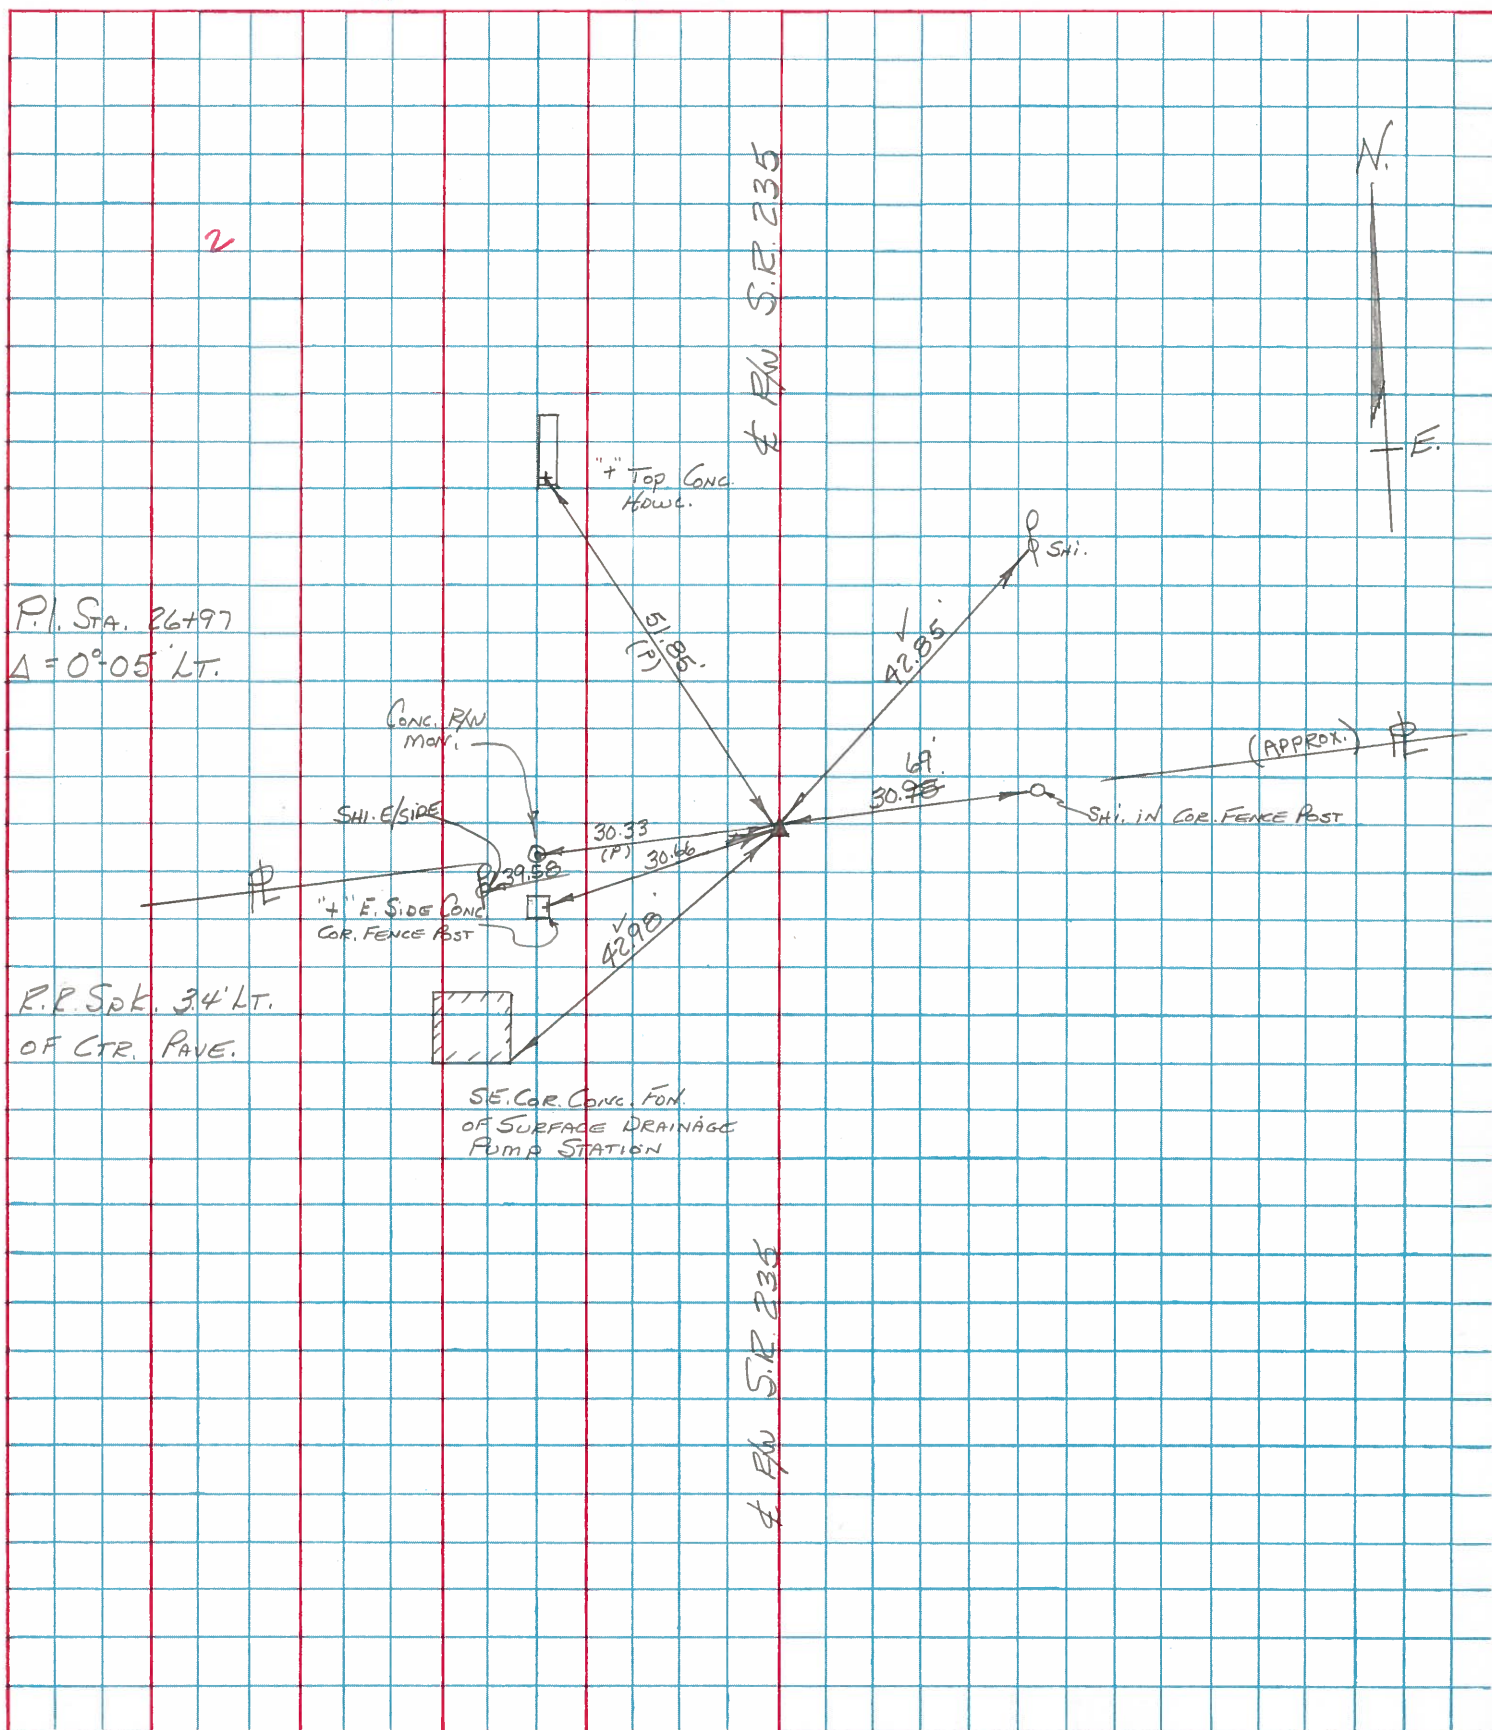

PERSONNEL TITLE PERSONNEL TITLE

BURNSIDE

COUNTY WoodDATE 4-28-72

SMITH

S. R. 235WEATHER CLEAR

BOWERS

SEC. 35TEMP. +60°DESCRIPTION CONTROL POINTS

JOB NO.

LEFT

CENTER LINE

RIGHT

#2
P.I. STA 26+92.5

SET P.K. 3.4' LT. of & AVE.

 $\Delta = 0^\circ 04' \text{ REC.}$ $\Delta = 0^\circ 05' 30'' \text{ MEAS.}$ CONC. R/W
MONUMENT
(GOOD)"+" TOP CONC
HOWL.51.85'
(P)30.33'
(P)

30.68'

"+" CUT ON EAST
SIDE CONC. COR.
FENCE FBST42.85'
P SHI.

30.95'

30.06'
(D)R/W MON.
LEANING

APPROX.

