

O.D.O.T. DISTRICT 2 SURVEY OFFICE (USE ONLY)

PERSONNEL

REFERENCE NO. 2 A

SHEET 4 OF 26

NOTES NIESE

DATE 10/25/24

ROUTE SR 235

H.C. NIESE

WEATHER CLOUDY

COUNTY WOOD

R.C. PRESTON-COLVIN

TEMP. 53°

TOWNSHIP JACKSON

DWG BY BARRIERE

PID 101290

SECTION 35

T 3 N R 9 E

TYPE MONUMENT MAG NAIL/WASHER

ON SURFACE - BELOW ON

OFFSET ϕ PAVEMENT 2.3' LT LT : RT


7.6' TO LT EDGE PAVEMENT

STATION: 49+67.08


HORIZ.DATUM: NAD83(2011)/WOOD LDP GEOID: 2018

GRID: NORTHING: 375878.824 EASTING: 126992.619

LDP: NORTHING: 554530.440 EASTING: 1614919.811

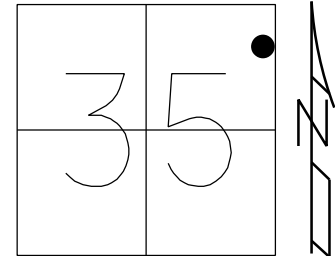

RECORD:
SET P.K./WASHER
10-27-93, MB
SET MAG/WASHER
8-3-04 M.C.
FD MAG/WASHER
REFA2
6-8-18, JLL
FD MAG/WASHER
REFA2
4-27-21
9-16-21, JFO
1/11/23, JMR
2/1/23, JAM
5/23/23, DSA
8/14/23, TDN
SET MAG/WASHER
10/24/25, TDN

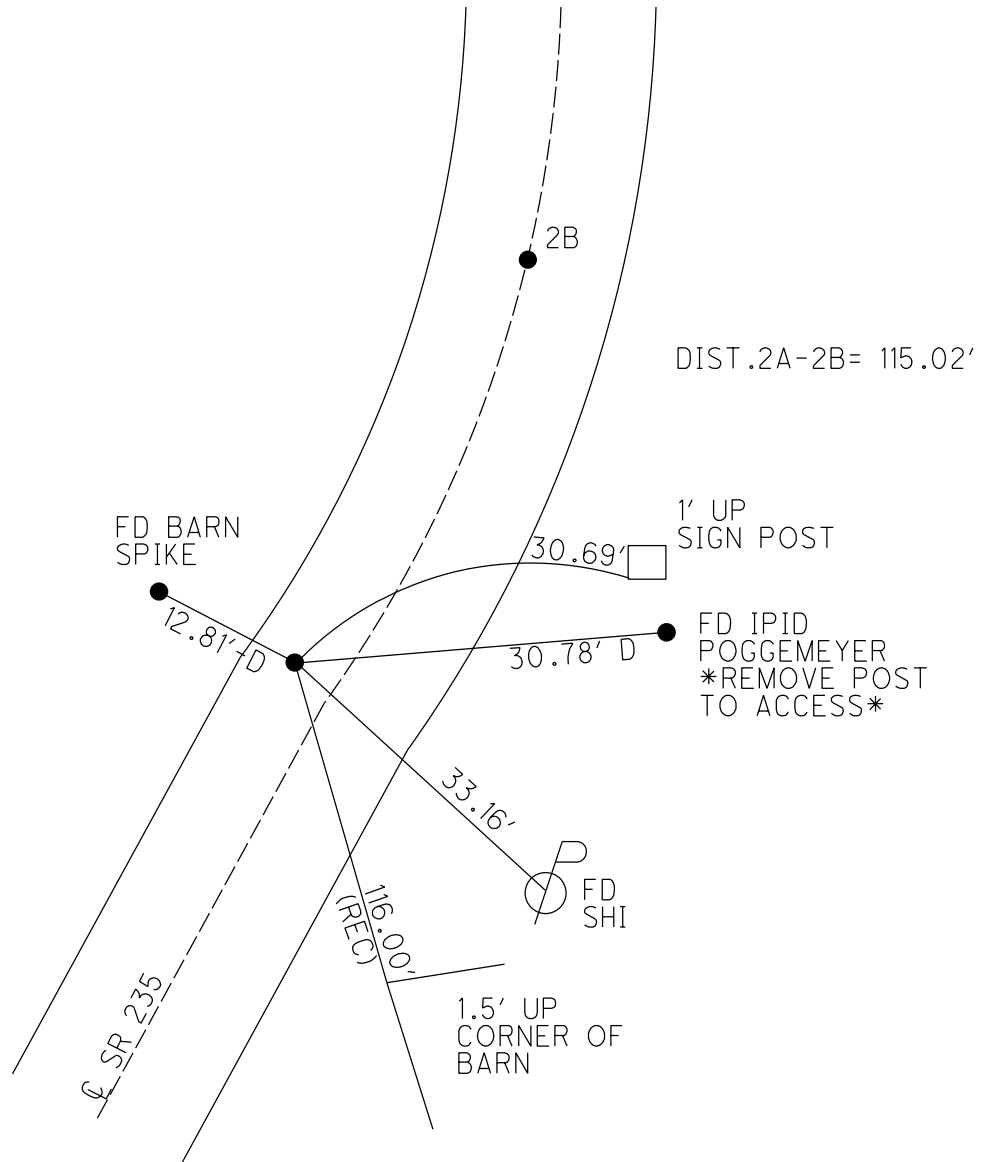

O.D.O.T. DISTRICT 2 SURVEY OFFICE (USE ONLY)

PERSONNEL

REFERENCE NO. 2 A

SHEET 3 OF 8

NOTES AUBLE

DATE 5-23-23

ROUTE SR 235

H.C. NIESE

WEATHER CLEAR

COUNTY WOOD

R.C. AUBLE

TEMP. 69° F

TOWNSHIP JACKSON

SECTION 35

DWG BY AUBLE

PID PAVETRAIN

T 3 N R 9 E

TYPE MONUMENT MAG/WASHER

ON SURFACE - ~~BELOW~~ ON

OFFSET Q PAVEMENT 2.3' LT : ~~RT~~

7.6' TO LT EDGE PAVEMENT


STATION: 49+67.08

HORZ.DATUM: NAD83(2011)


GEOID: NAVD88 2018

GRID: NORTHING: 554530.446

EASTING: 1614919.811

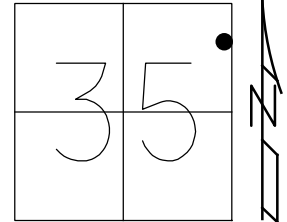

RECORD:
SET P.K./WASHER
10-27-93, MB
SET MAG/WASHER
8-3-04 M.C.
FD MAG/WASHER
REFA2
6-8-18, JLL
FD MAG/WASHER
REFA2
4-27-21
9-16-21, JFO
1/11/23, JMR
2/1/23, JAM
5/23/23, DSA
8/14/23, TDN

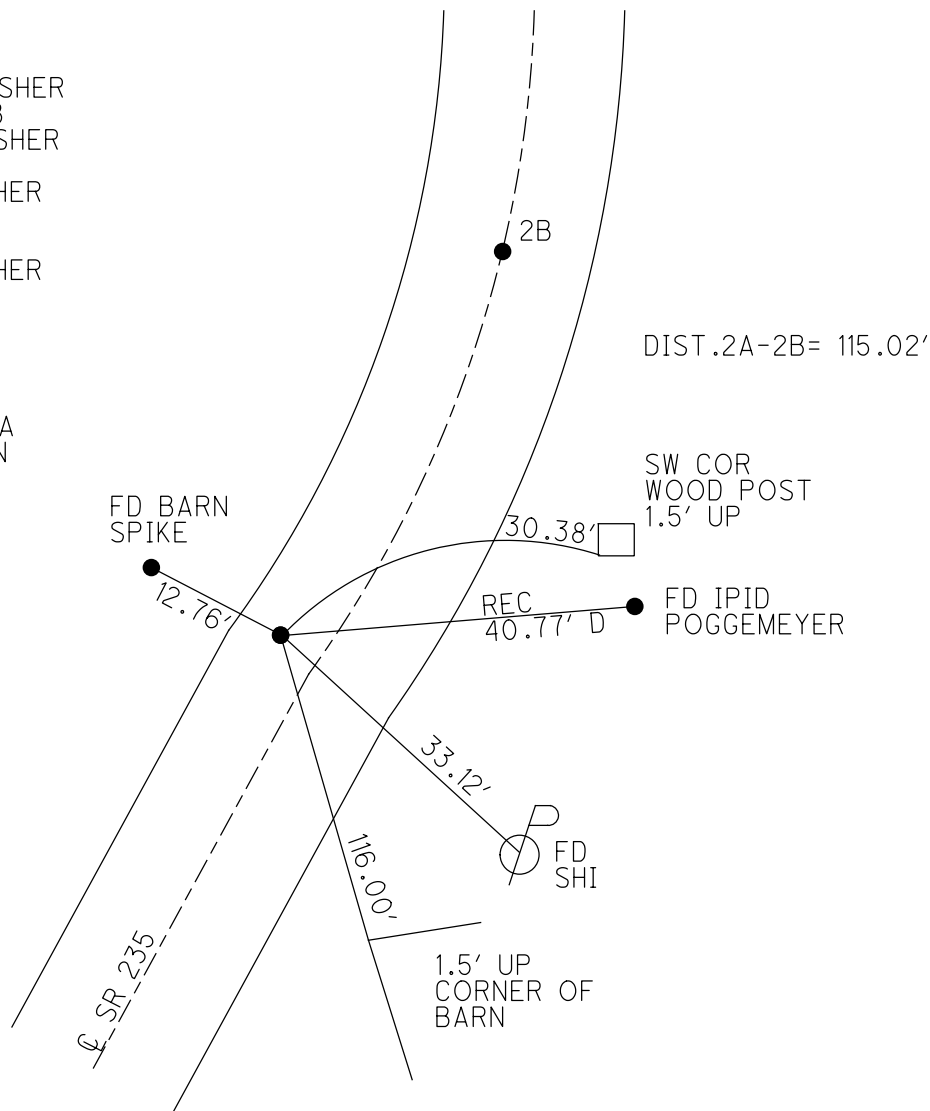

O.D.O.T. DISTRICT 2 SURVEY OFFICE (USE ONLY)

PERSONNEL

REFERENCE NO. 2 A

SHEET 3 OF 8

NOTES RHOADES

DATE 4-27-21

ROUTE SR 235

H.C. O'DONNELL

WEATHER WINDY

COUNTY WOOD

R.C. RHOADES

TEMP. 64° F

TOWNSHIP JACKSON

SECTION 35

DWG BY AUBLE

PID PAVETRAIN

T 3 N R 9 E

TYPE MONUMENT MAG/WASHER

~~ON SURFACE~~ - BELOW ON

OFFSET Q PAVEMENT 2.3' LT : ~~RT~~

7.6' TO LT EDGE PAVEMENT


STATION: 49+67.08

HORIZ.DATUM: NAD83(2011)


GEOID: NAVD88 2018

GRID: NORTHING: 554530.401

EASTING: 1614919.807

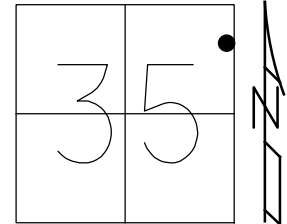

RECORD:
SET P.K./WASHER
10-27-93, MB
SET MAG/WASHER
8-3-04 M.C.
FD MAG/WASHER
REFA2
6-8-18, JLL
FD MAG/WASHER
REFA2
4-27-21
9-16-21, JFO
1/11/23, JMR

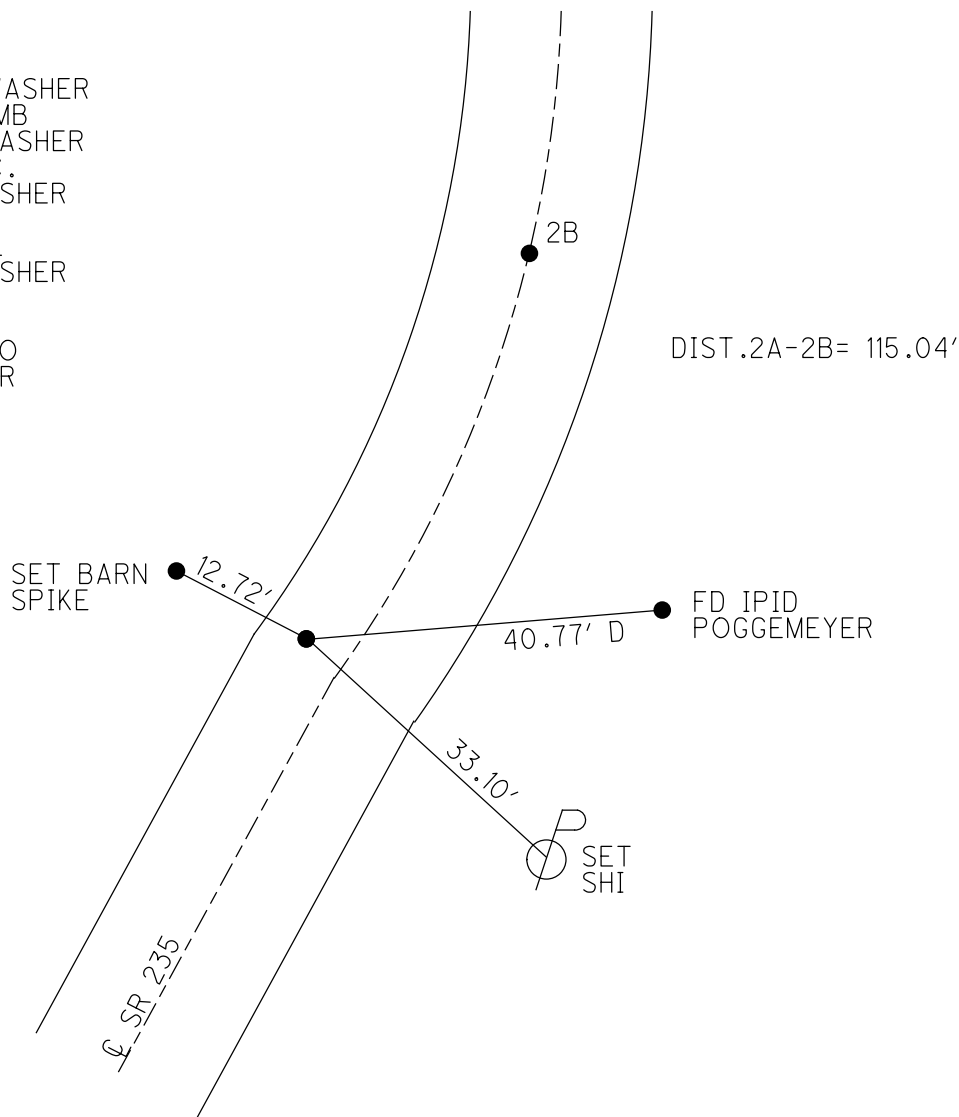

O.D.O.T. DISTRICT 2 SURVEY OFFICE (USE ONLY)

PERSONNEL

REFERENCE NO. 2 A

SHEET 3 OF 8

NOTES RHOADES

DATE 4-27-21

ROUTE SR 235

H.C. O'DONNELL

WEATHER WINDY

COUNTY WOOD

R.C. RHOADES

TEMP. 64° F

TOWNSHIP JACKSON

SECTION 35

DWG BY AUBLE

PID PAVETRAIN

T 3 N R 9 E

TYPE MONUMENT MAG/WASHER

~~ON SURFACE~~ - BELOW ON

OFFSET Q PAVEMENT 2.3' LT : ~~RT~~

7.6' TO LT EDGE PAVEMENT


STATION: 49+67.08

HORZ.DATUM: NAD83(2011)


GEOID: NAVD88 2018

GRID: NORTHING: 554530.401

EASTING: 1614919.807

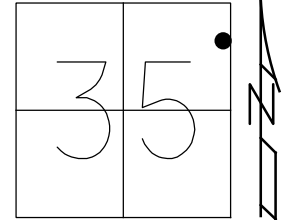


RECORD:
SET P.K./WASHER
10-27-93, MB
SET MAG/WASHER
8-3-04 M.C.
FD MAG/WASHER
REFA2
6-8-18, JLL
FD MAG/WASHER
REFA2
4-27-21
9-16-21, JFO

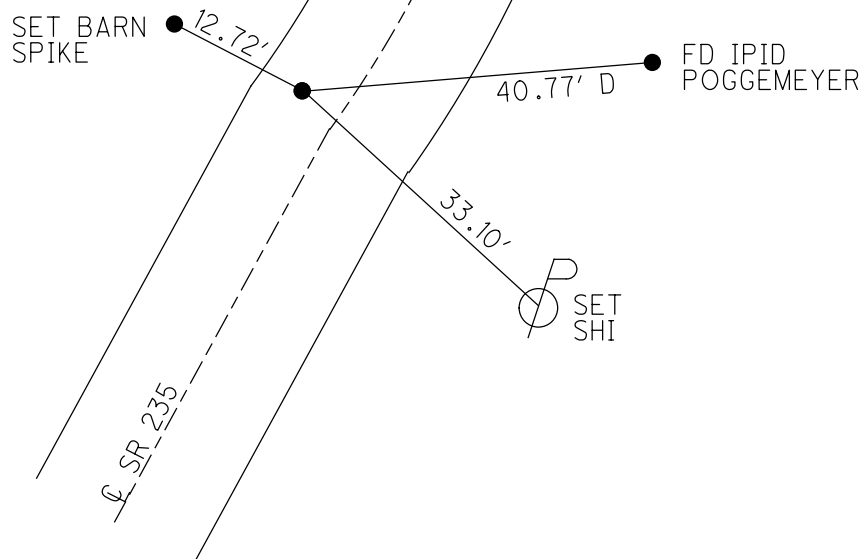

O.D.O.T. DISTRICT 2 SURVEY OFFICE (USE ONLY)

PERSONNEL	REFERENCE NO. <u>2 A</u>	SHEET <u>3</u> OF <u>8</u>	
NOTES <u>NUHFER</u>	DATE <u>05-06-04</u>	ROUTE <u>SR 235</u>	
H.C. <u>CANERBURY</u>	WEATHER <u>SUNNY</u>	COUNTY <u>WOOD</u>	
R.C. <u>ARMS</u>	TEMP. <u>65°F</u>	TOWNSHIP <u>JACKSON</u>	
		SECTION <u>35</u>	
		T <u>3</u> N R <u>9</u> E	

TYPE MONUMENT MAG/WASHER
 ON SURFACE - ~~BELOW~~ ON
 LEFT - Q PAV'T - ~~RIGHT~~ 2.3'
7.6' TO LT EDGE PAVEMENT
 S.L.M. 49+67.08

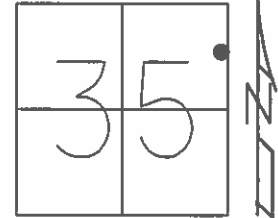


Grid: Northing: 554530.423 Easting: 1614919.879

RESET P.K. & WASHER
 10-27-93
 MB

RESET MAG & WASHER
 08-03-04 M.C.

DIST. 2A-2B= 115.01'

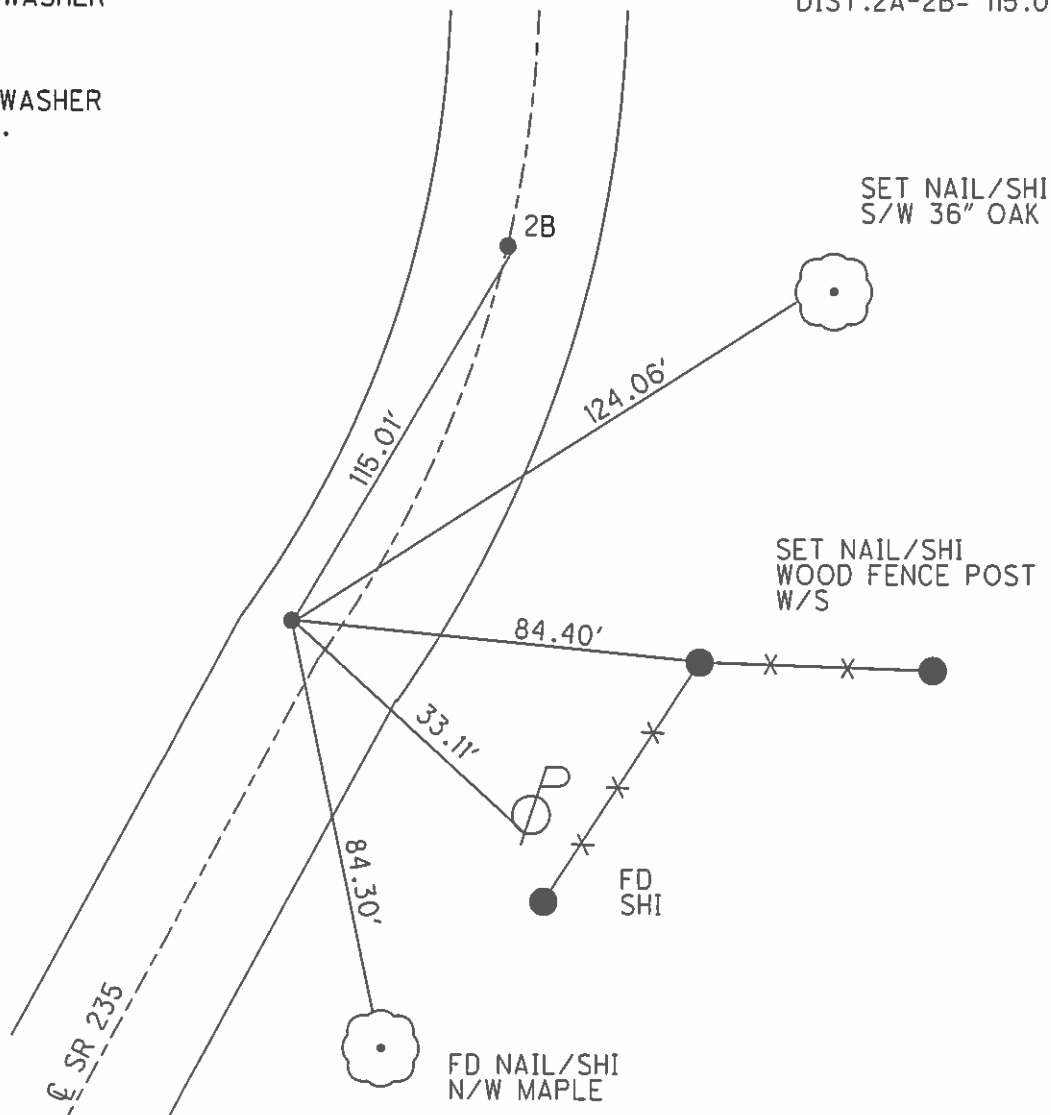

O.D.O.T. DISTRICT 2 SURVEY OFFICE

PERSONNEL

REFERENCE NO. 2-A

SHEET 3 OF 5

NOTES NUHFER

DATE 05-06-04

ROUTE S.R. 235

H.C. CANTERBURY

WEATHER SUN

COUNTY WOOD

R.C. ARMS

TEMP. +65°

TOWNSHIP JACKSON

SECTION 35

T 3 N R 9 E


TYPE MONUMENT P.K. + WASHER

ON SURFACE YES

LEFT - Q PAV'T 2.3'


7.6' TO LT. EDGE PAVEMENT

S.L.M. 49+78

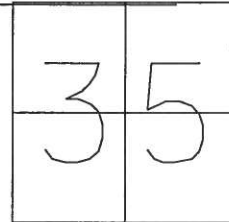

RESET P.K. & WASHER
10-27-93
MB

RESET MAG & WASHER
08-03-04 M.C.

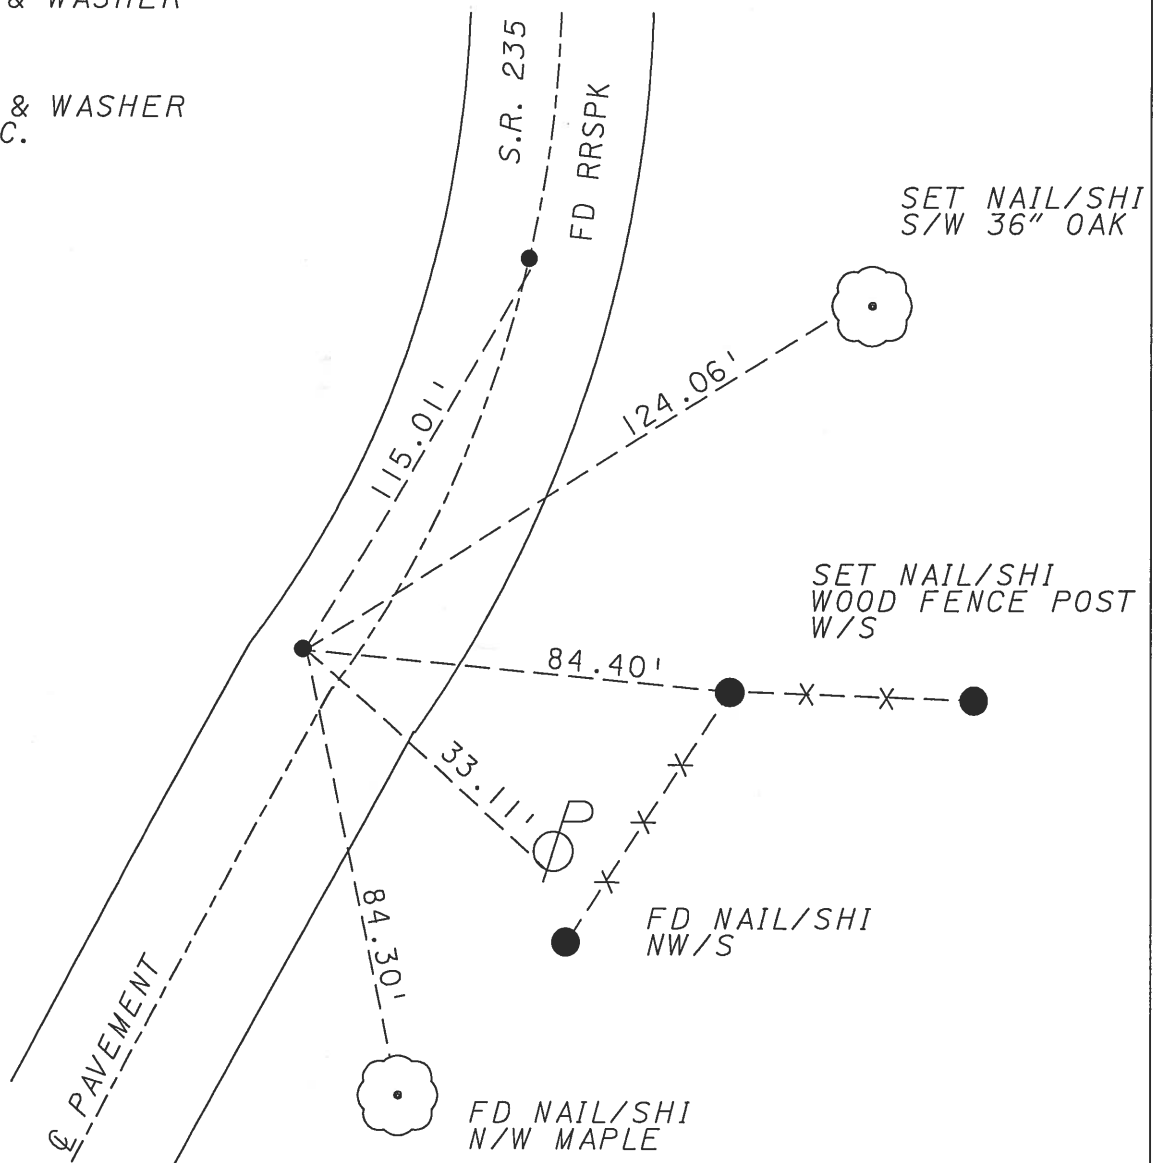

O.D.O.T. DISTRICT 2 SURVEY OFFICE

PERSONNEL

REFERENCE NO. 2-A

SHEET 2 OF 3

NOTES OTTO

H.C. Kusz

R.C. BARNHISEL

DATE 7-21-93

WEATHER cloudy

TEMP. +72°

ROUTE SR 235

COUNTY WOOD

TOWNSHIP JACKSON

SECTION 35

T3 N R 9 E


TYPE MONUMENT P.K. & WASHER

ON SURFACE - ~~BELOW~~ yes


LEFT-CL PAW'T. - ~~RIGHT~~ 2.3

8.4 TO LT EDGE PAVEMENT

S.L.M. 49+78

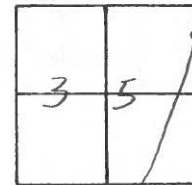

Reset PK & WASHER
10-27-93
MB

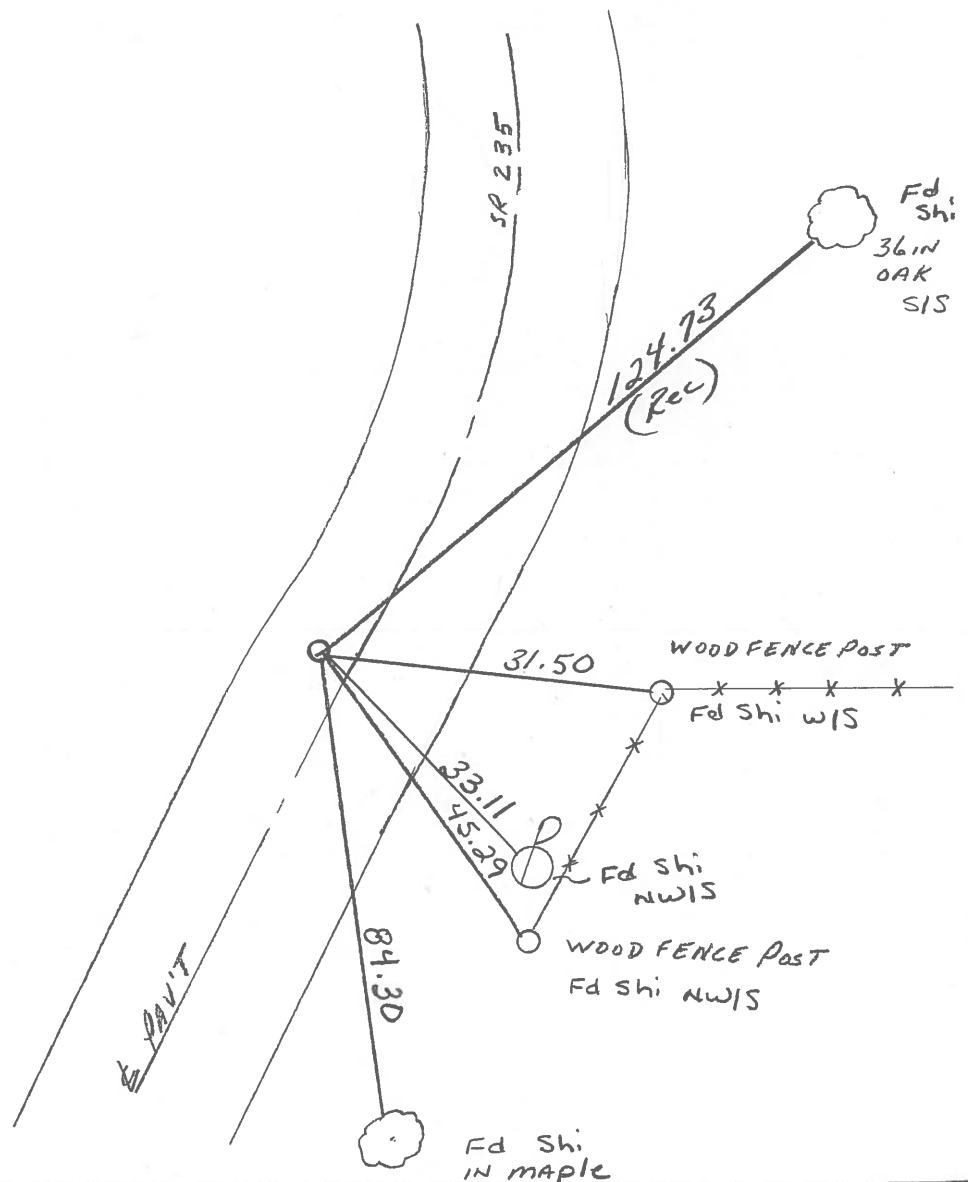

O.D.O.T. DISTRICT 2 SURVEY OFFICE

PERSONNEL

REFERENCE NO. 2A

SHEET OF

NOTES LOEHRKE

H.C. BARNHISEL

R.C. HOFFMAN

DATE 7-2-85

WEATHER CLOUDY

TEMP. +72

ROUTE 235

COUNTY WOOD

TOWNSHIP JACKSON

SECTION

T 3 N R 9 E



TYPE MONUMENT R.R. SPIKE Set P.K. / WASHER
7-25-85 CH

~~ON SURFACE~~ - BELOW

LEFT - C PAV'T. - RIGHT Left 2.5

7.1 TO Lf EDGE PAVEMENT

S.L.M. 49+64

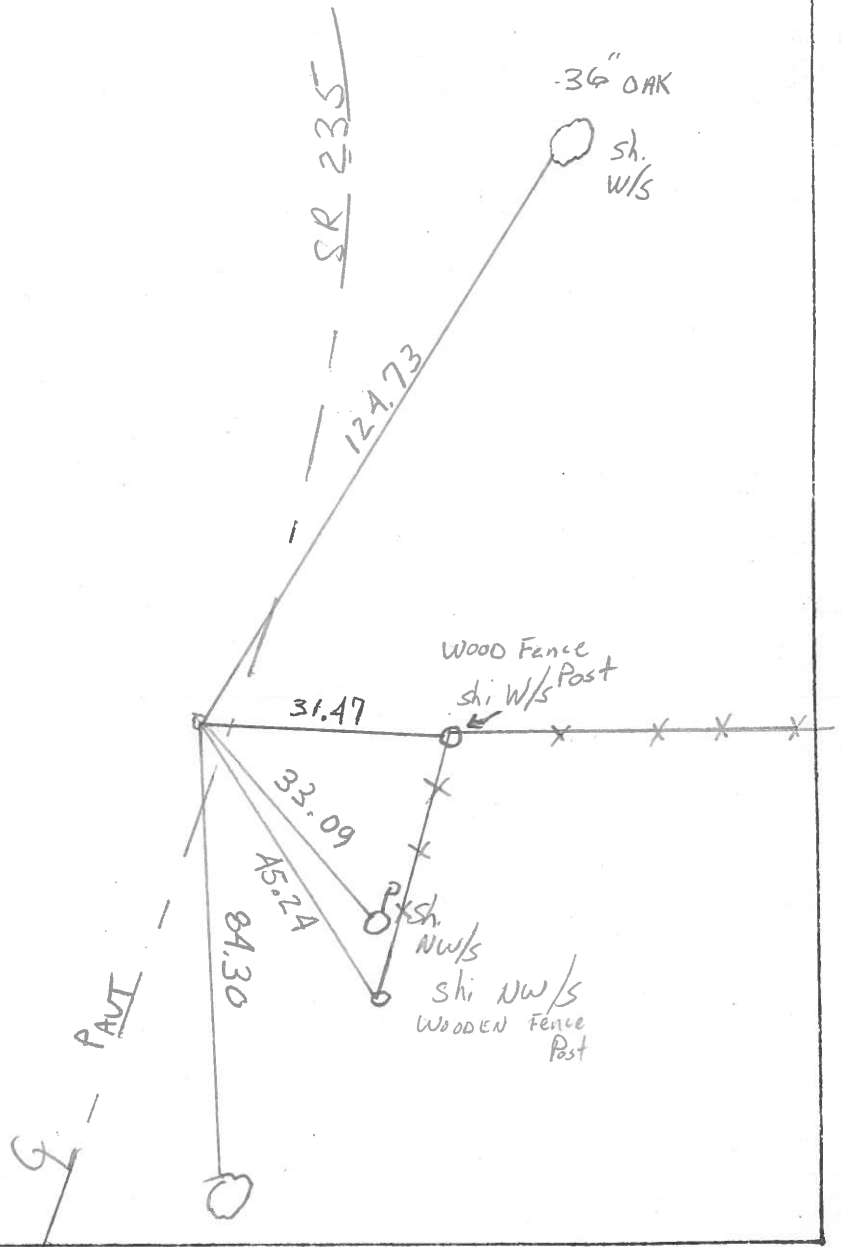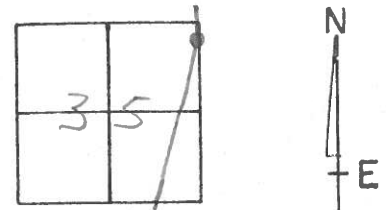

PERSONNEL TITLE PERSONNEL TITLE

BURNSIDE

COUNTY Wood

SMITH

S. R. 235

WEATHER Cloudy

BOWERS

SEC. 35 JACKSON Twp.

TEMP. +36°

MEAD

DESCRIPTION & CONTROL TIES

JOB NO.

LEFT

CENTER LINE

RIGHT

