

O.D.O.T. DISTRICT 2 SURVEY OFFICE (USE ONLY)

PERSONNEL

REFERENCE NO. 2 B

SHEET 4 OF 26

NOTES NIESE

DATE 10/25/24

ROUTE SR 235

H.C. NIESE

WEATHER CLOUDY

COUNTY WOOD

R.C. PRESTON-COLVIN

TEMP. 53°

TOWNSHIP JACKSON

DWG BY BARRIERE

PID 101290

SECTION 35

T 3 N R 9 E

TYPE MONUMENT MAG NAIL/WASHER

ON SURFACE - BELOW ON

OFFSET Q PAVEMENT ON LT : RT


8.8' TO RT EDGE PAVEMENT

STATION: 50+82.98


HORIZ.DATUM: NAD83(2011)/WOOD LDP GEOID: 2018

GRID: NORTHING: 375991.222 EASTING: 127017.072

LDP: NORTHING: 554642.496 EASTING: 1614945.741

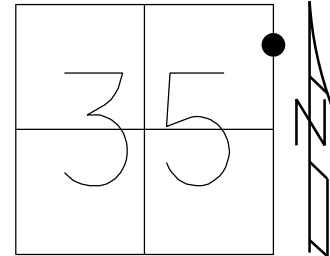

RECORD: P.I.
 $\Delta = 6^\circ 43''$ LT
 SET P.K./WASHER
 10-27-93, MB
 SET PK/WASHER
 8-3-04, M.C.
 FD MAG/WASHER
 REFB2
 6-8-21, JLL
 FD MAG/WASHER
 REFB2
 4-27-21
 9-16-21, JFO
 1/11/23, JMR
 2/1/23, JAM
 5/23/23, TDN
 8/14/23, TDN
 SET MAG/WASHER
 NEWREF2B
 10/25/24, TDN

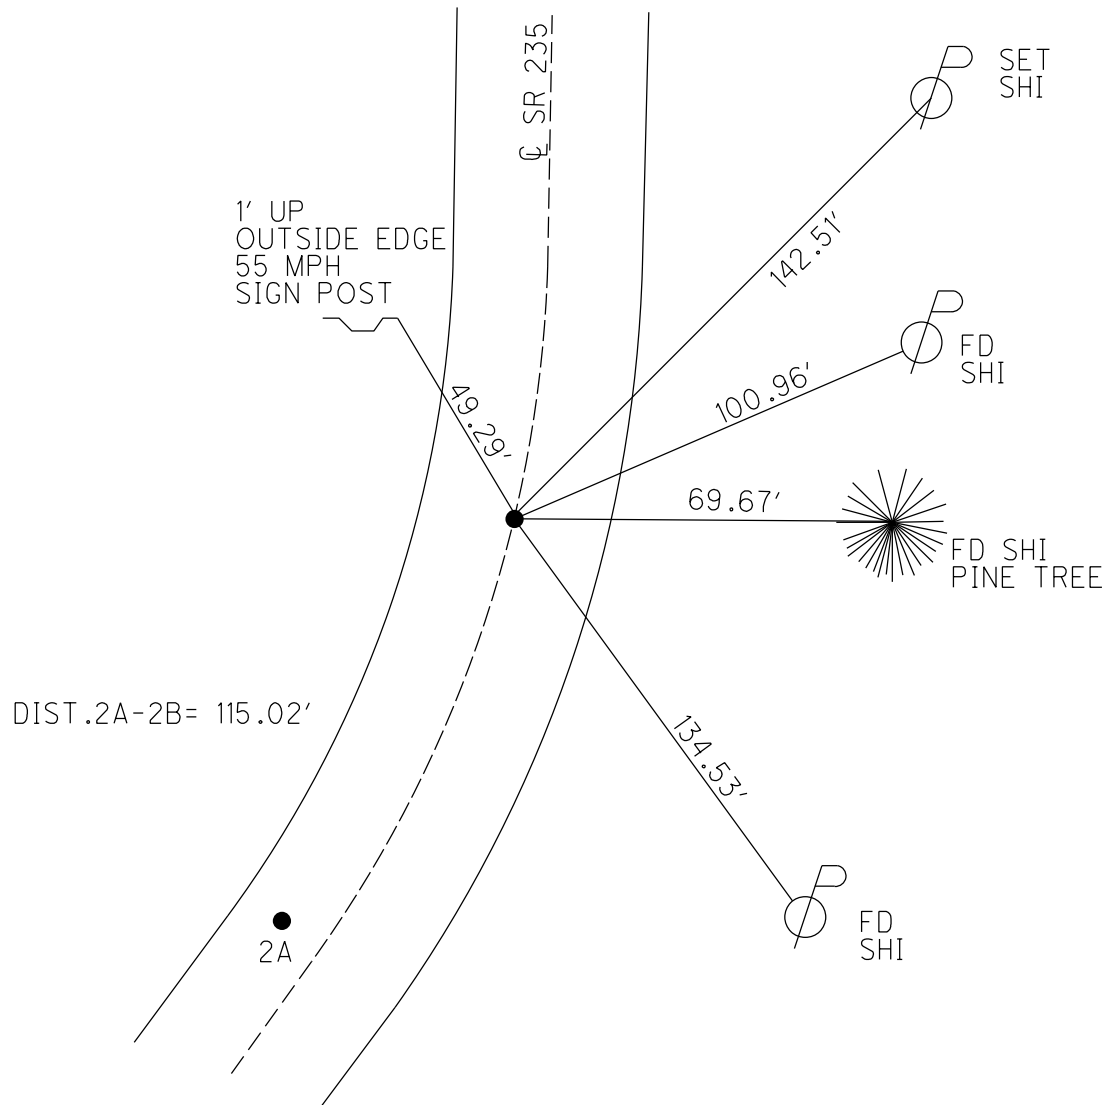

O.D.O.T. DISTRICT 2 SURVEY OFFICE (USE ONLY)

PERSONNEL

REFERENCE NO. 2 B

SHEET 4 OF 8

NOTES AUBLE

DATE 5-23-23

ROUTE SR 235

H.C. NIESE

WEATHER CLEAR

COUNTY WOOD

R.C. AUBLE

TEMP. 69° F

TOWNSHIP JACKSON

SECTION 35

DWG BY AUBLE

PID PAVETRAIN

T 3 N R 9 E

TYPE MONUMENT MAG/WASHER

ON SURFACE - ~~BELOW~~ ON

OFFSET Q PAVEMENT ON LT : RT

8.8' TO RT EDGE PAVEMENT


STATION: 50+82.98

HORZ.DATUM: NAD83(2011)


GEOID: NAVD88 2018

GRID: NORTHING: 554642.488

EASTING: 1614945.700

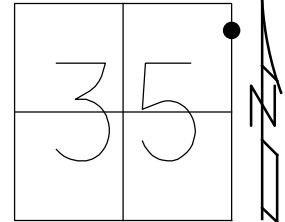

RECORD: P.I.
 $\Delta = 6^\circ 43''$ LT
SET P.K./WASHER
10-27-93, MB
SET PK/WASHER
8-3-04, M.C.
FD MAG/WASHER
REFB2
6-8-21, JLL
FD MAG/WASHER
REFB2
4-27-21
9-16-21, JFO
1/11/23, JMR
2/1/23, JAM
5/23/23, TDN
8/14/23, TDN

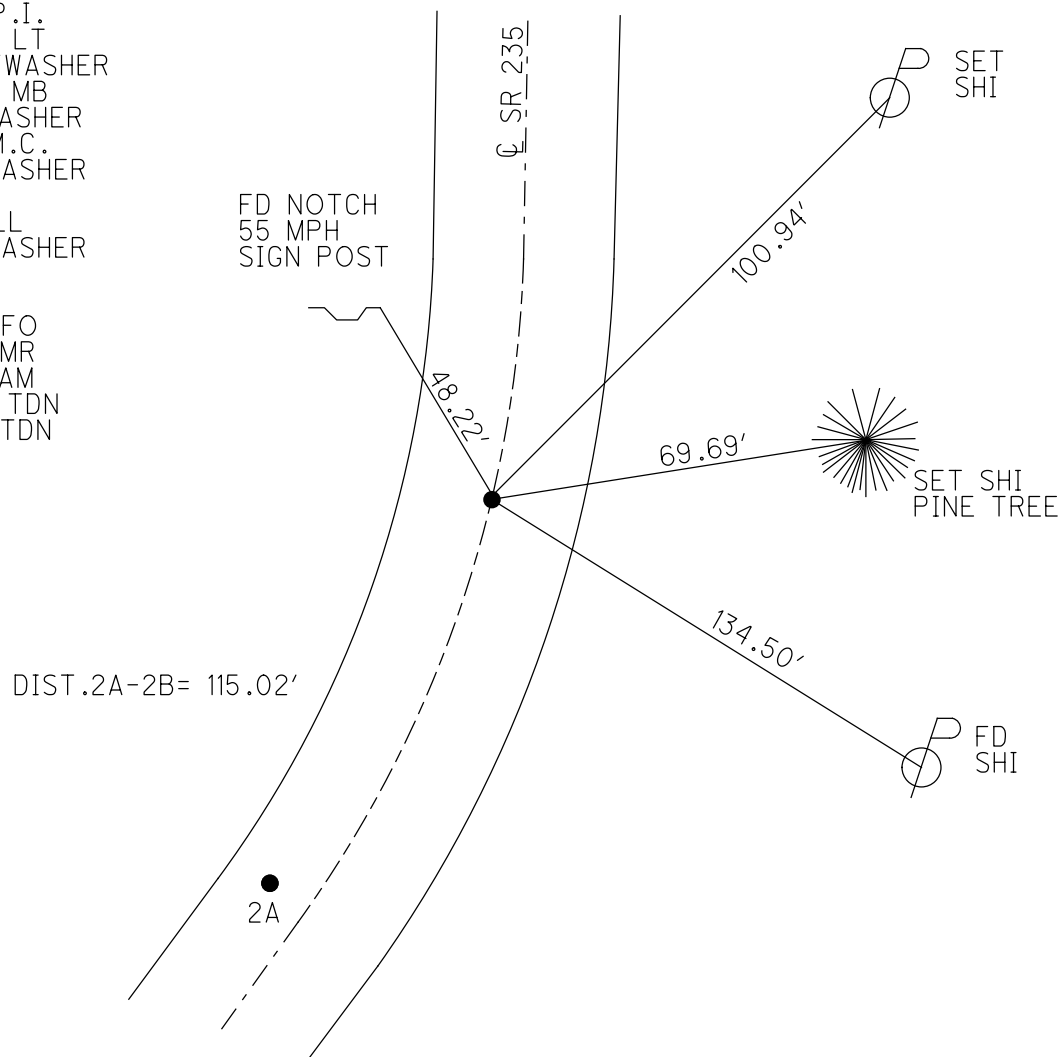

O.D.O.T. DISTRICT 2 SURVEY OFFICE (USE ONLY)

PERSONNEL

REFERENCE NO. 2 B

SHEET 4 OF 8

NOTES RHOADES

DATE 4-27-21

ROUTE SR 235

H.C. O'DONNELL

WEATHER WINDY

COUNTY WOOD

R.C. RHOADES

TEMP. 64° F

TOWNSHIP JACKSON

SECTION 35

DWG BY AUBLE

PID PAVETRAIN

T 3 N R 9 E

TYPE MONUMENT MAG/WASHER

ON SURFACE - ~~BELOW~~ ON

OFFSET Q PAVEMENT ON LT : RT

8.8' TO RT EDGE PAVEMENT


STATION: 50+82.98

HORIZ.DATUM: NAD83(2011)


GEOID: NAVD88 2018

GRID: NORTHING: 554642.485

EASTING: 1614945.696

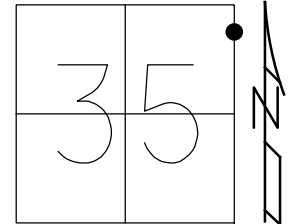

RECORD: P.I.
 $\Delta = 6^\circ 43''$ LT
SET P.K./WASHER
10-27-93, MB
SET PK/WASHER
8-3-04, M.C.
FD MAG/WASHER
REFB2
6-8-21, JLL
FD MAG/WASHER
REFB2
4-27-21
9-16-21, JFO
1/11/23, JMR

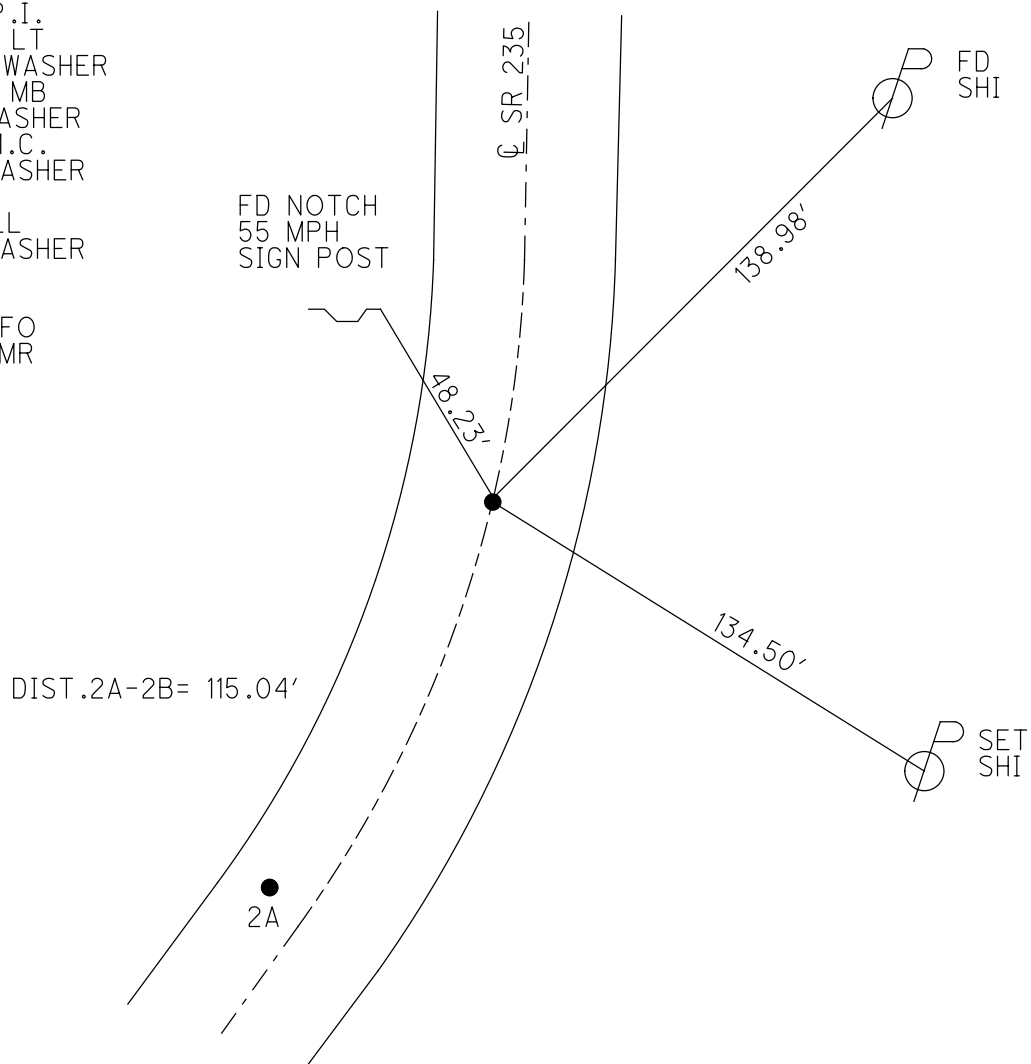

O.D.O.T. DISTRICT 2 SURVEY OFFICE (USE ONLY)

PERSONNEL

REFERENCE NO. 2 B

SHEET 4 OF 8

NOTES RHOADES

DATE 4-27-21

ROUTE SR 235

H.C. O'DONNELL

WEATHER WINDY

COUNTY WOOD

R.C. RHOADES

TEMP. 64° F

TOWNSHIP JACKSON

SECTION 35

DWG BY AUBLE

PID PAVETRAIN

T 3 N R 9 E

TYPE MONUMENT MAG/WASHER

ON SURFACE - ~~BELOW~~ ON

OFFSET Q PAVEMENT ON LT : RT

8.8' TO RT EDGE PAVEMENT


STATION: 50+82.98

HORZ.DATUM: NAD83(2011)


GEOID: NAVD88 2018

GRID: NORTHING: 554642.485

EASTING: 1614945.696

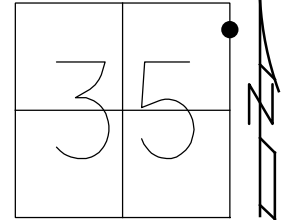

RECORD: P.I.
 $\Delta = 6^\circ 43''$ LT
SET P.K./WASHER
10-27-93, MB
SET PK/WASHER
8-3-04, M.C.
FD MAG/WASHER
REFB2
6-8-21, JLL
FD MAG/WASHER
REFB2
4-27-21
9-16-21, JFO

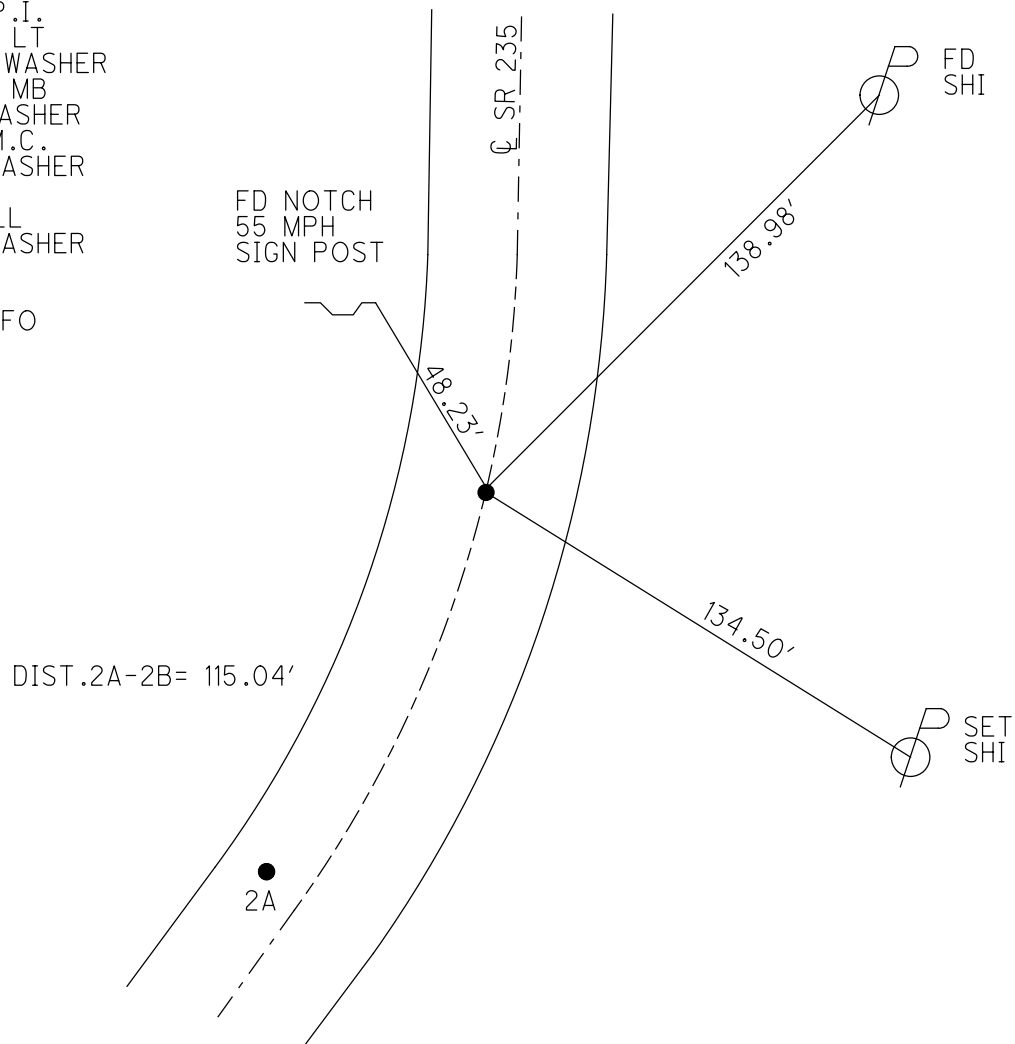


O.D.O.T. DISTRICT 2 SURVEY OFFICE (USE ONLY)

PERSONNEL _____ REFERENCE NO. 2 B SHEET 4 OF 8

NOTES NUHFER DATE 05-06-04 ROUTE SR 235
H.C. CANERBURY WEATHER SUNNY COUNTY WOOD
R.C. ARMS TEMP. 65°F TOWNSHIP JACKSON
SECTION 35
T 3 N R 9 E

TYPE MONUMENT RR SPIKE
ON SURFACE - ~~BELOW~~ 2"
LEFT - Q PAV'T - RIGHT ON
8.8' TO RT EDGE PAVEMENT
S.L.M. 50+93
Grid: Northing: - Easting: -

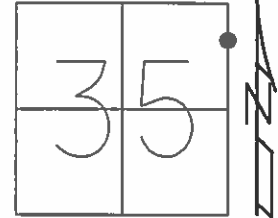


RECORD:
DELTA=6°-43' LT.

DIST. 2A-2B= 115.01'

SET PK/WASHER
10-27-93, MB

SET PK/WASHER
08-03-04, M.C.

CUT NOTCH
55 MPH
SIGN POST

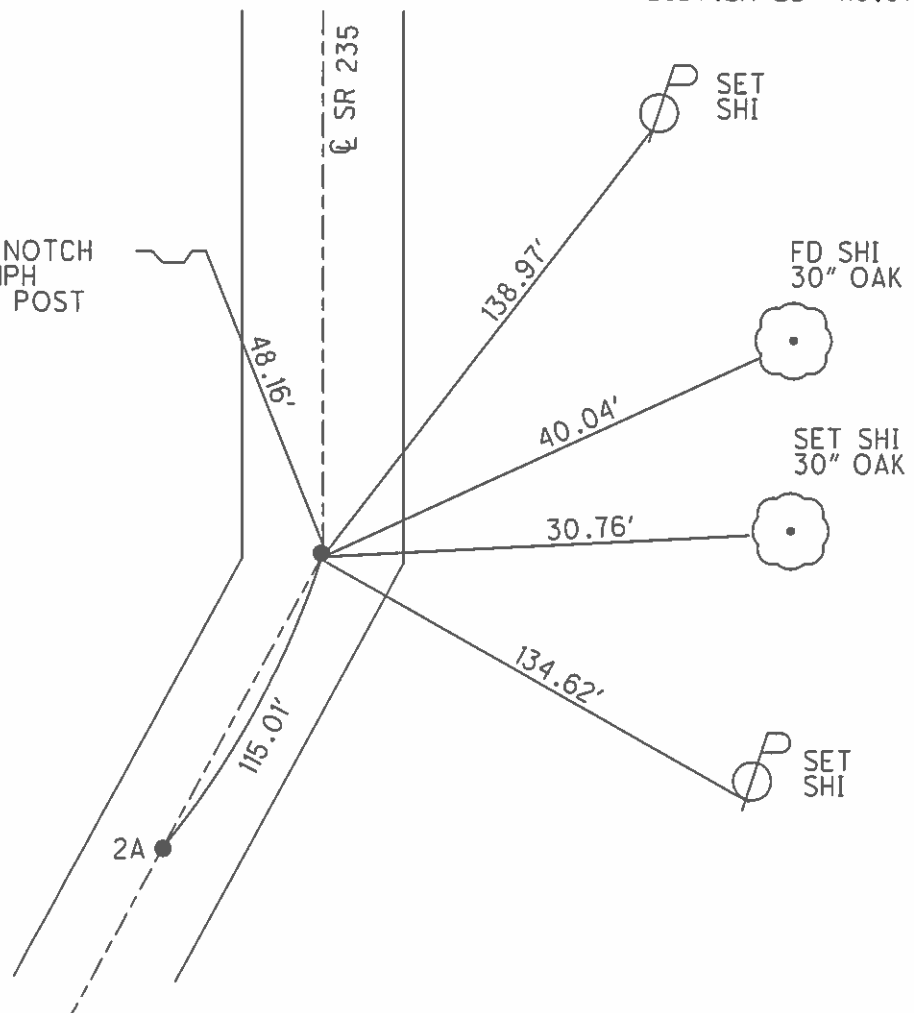

O.D.O.T. DISTRICT 2 SURVEY OFFICE

PERSONNEL

REFERENCE NO. 2-B

SHEET 4 OF 5

NOTES NUHFER

DATE 05-06-04

ROUTE S.R. 235

H.C. CANTERBURY

WEATHER SUN

COUNTY WOOD

R.C. ARMS

TEMP. +65°

TOWNSHIP JACKSON

SECTION 35

T 3 N R 9 E


TYPE MONUMENT RR SPIKE

ON SURFACE 2" DOWN

~~LEFT~~ - Q PAV'T ON

8.8' TO RT. EDGE PAVEMENT

S.L.M. 50+93

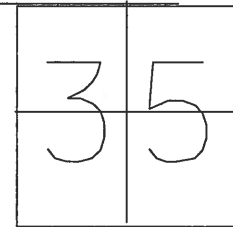


RECORD:
DELTA=6°-43' LT.

RESET P.K. & WASHER
10-27-93
MB

RESET MAG & WASHER
08-03-04 M.C.


CUT NOTCH
55 MPH
SIGN POST

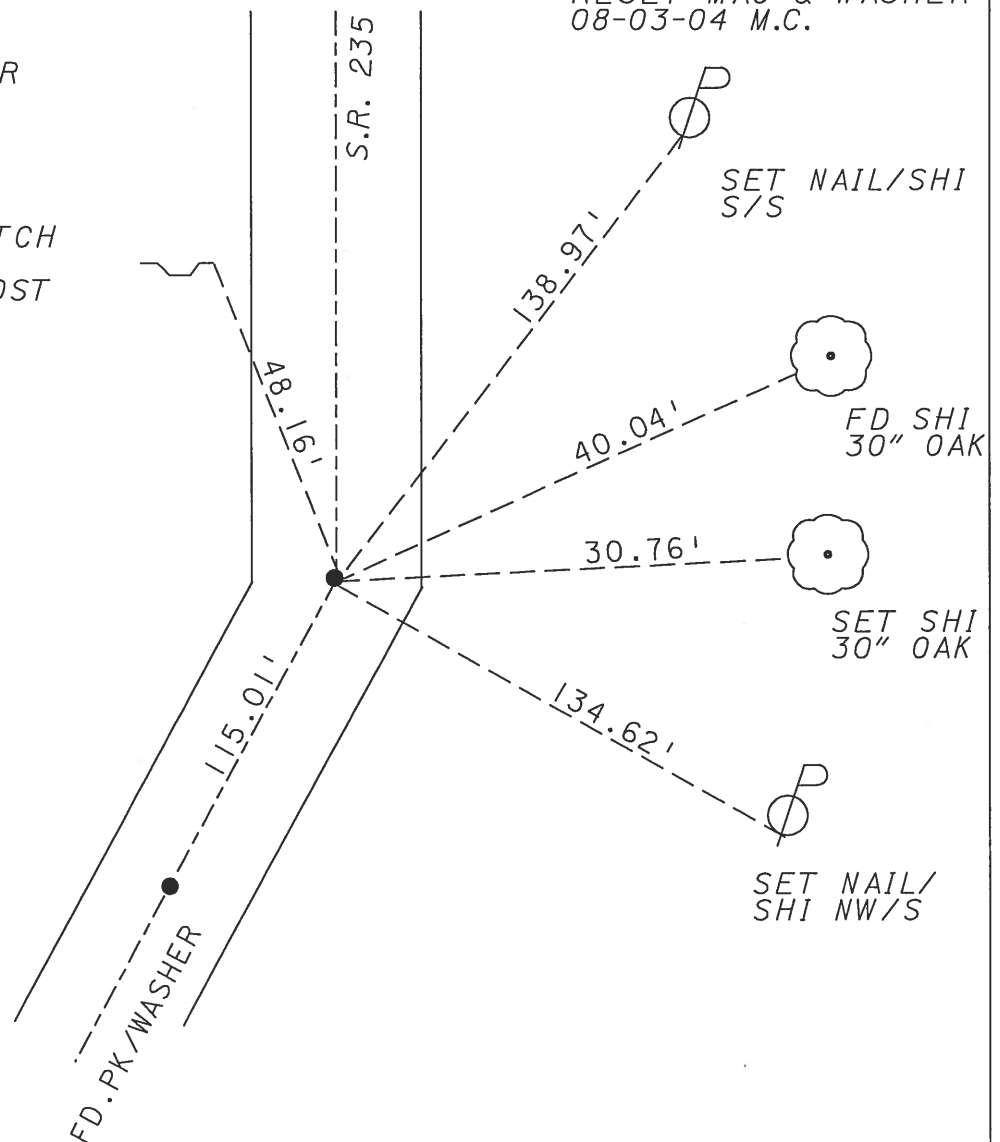

PERSONNEL	TITLE	PERSONNEL	TITLE
BURNSIDE			
SMITH			
BOWERS			

COUNTY Wood DATE 5-1-72
 S. R. 235 WEATHER SHOWERS
 SEC. 35 TEMP. +62°

DESCRIPTION _____ JOB NO. _____

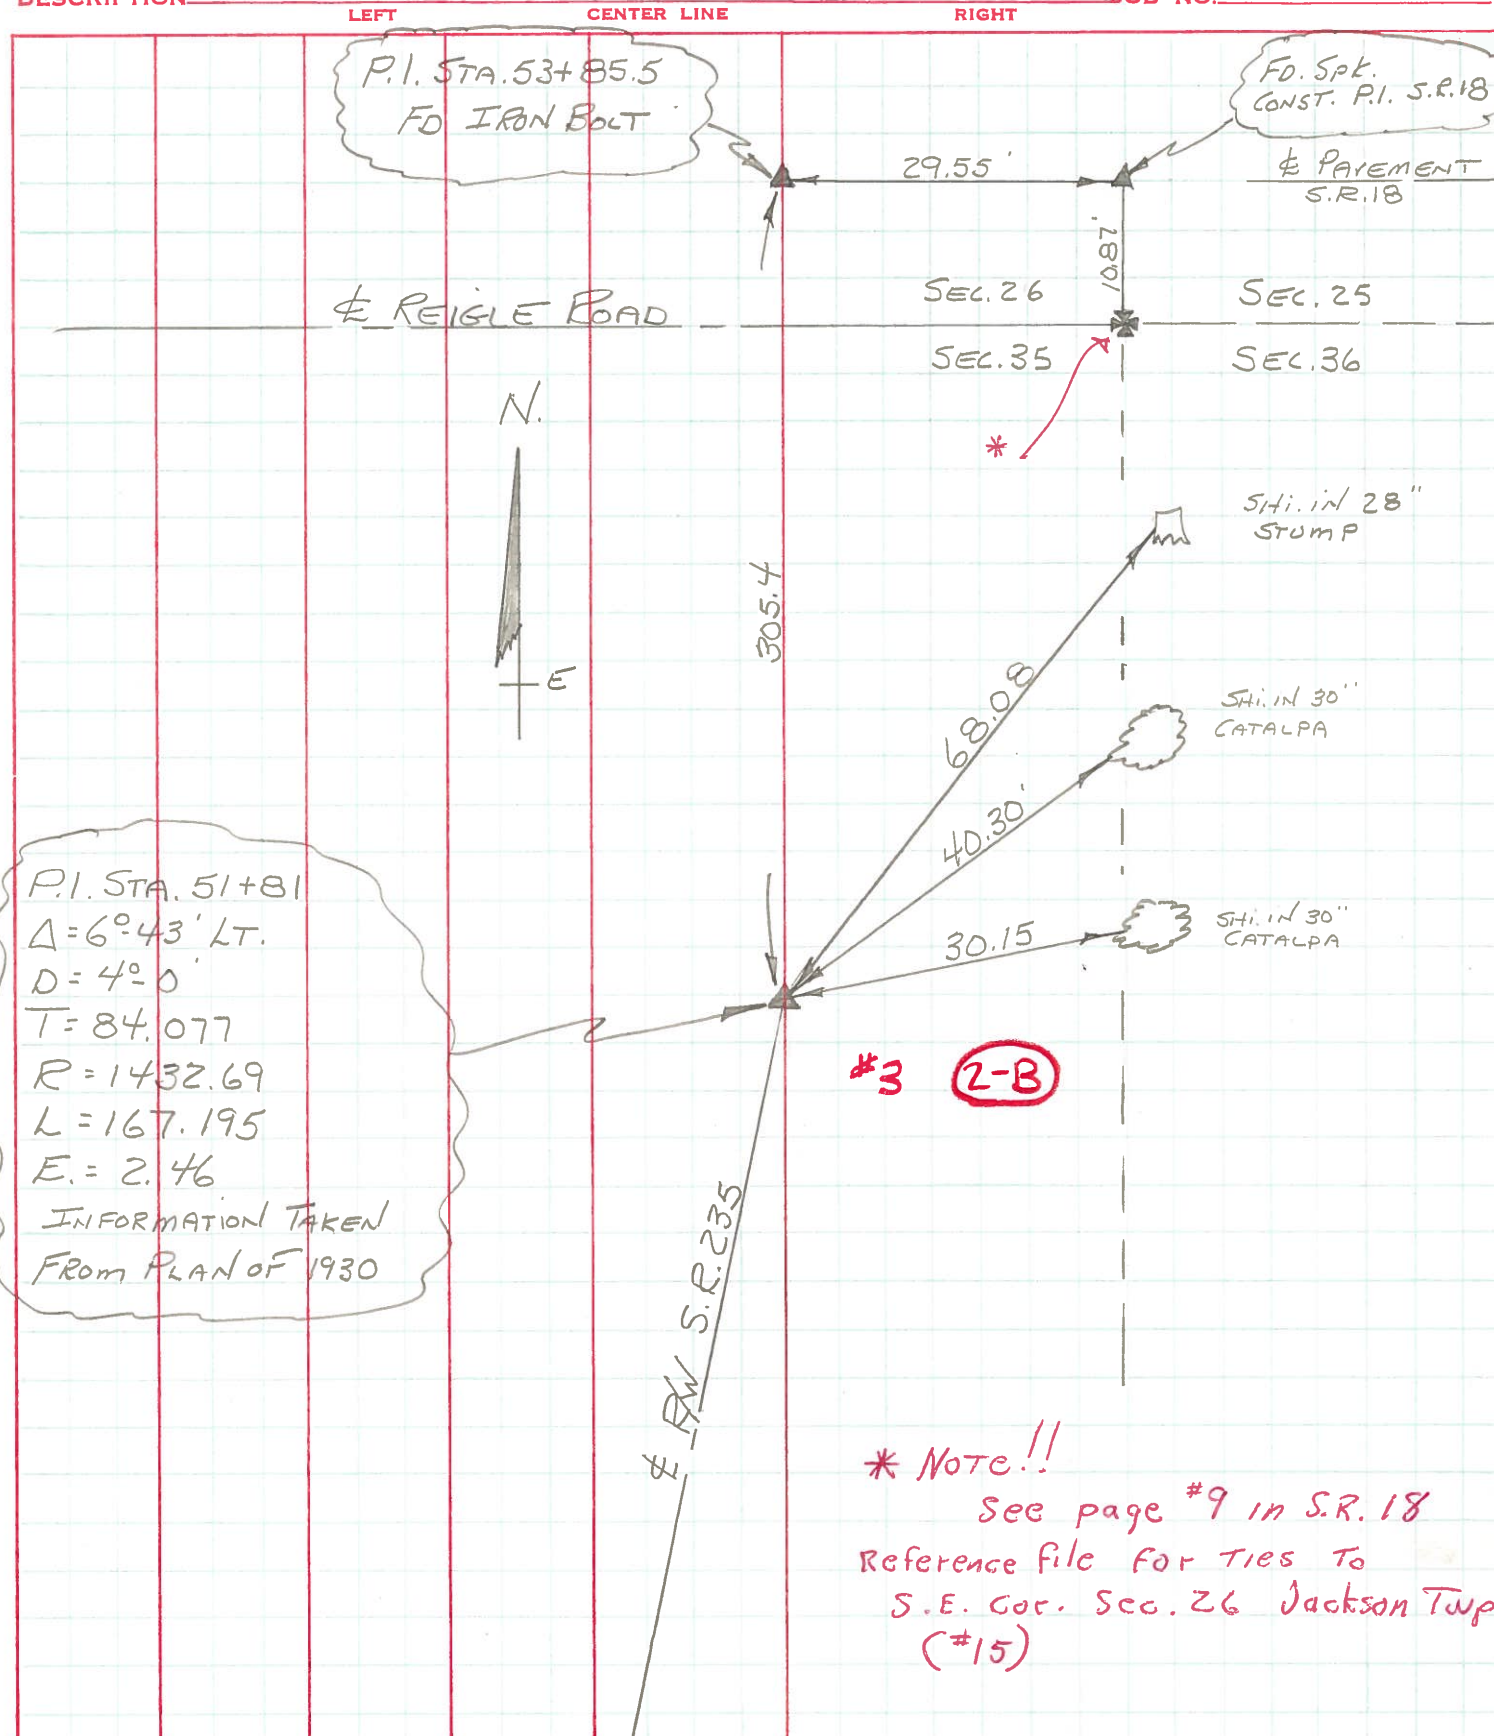

PERSONNEL TITLE PERSONNEL TITLE

BURNSIDE

COUNTY Wood

WEATHER Cloudy

SMITH

S. R. 235

BOWERS

SEC. 35 JACKSON TWP. TEMP. +36°

MEAD

DESCRIPTION

CONTROL TIES

LEFT

CENTER LINE

RIGHT

JOB NO.

