

O.D.O.T. DISTRICT 2 SURVEY OFFICE (USE ONLY)

PERSONNEL

REFERENCE NO. 3

SHEET 4 OF 26

NOTES NIESE

DATE 10/28/24

ROUTE SR 235

H.C. NIESE

WEATHER CALM

COUNTY WOOD

R.C. PRESTON-COLVIN

TEMP. 42°

TOWNSHIP JACKSON

SECTION 35

DWG BY BARRIERE PID 101290

T 3 N R 9 E

TYPE MONUMENT MAG NAIL/WASHER

ON SURFACE - BELOW ON

OFFSET $\odot$ PAVEMENT 2.5' LT LT : RT

TO EDGE PAVEMENT

STATION: 53+76.82

HORIZ.DATUM: NAD83(2011)/WOOD LDP GEOID: 2018


GRID: NORTHING: 376284.344 EASTING: 127044.992

LDP: NORTHING: 554935.199 EASTING: 1614977.520

26	25
35	36



RECORD:
FD P.K./WASHER
FD MAG/WASHER
5/6/04, RGN
SET MAG/WASHER
8-3-04, MC
FD MAG/WASHER
REF3
6/1/18, JLL
4-27-21
9-16-21, JFO
1/11/23, JMR
2/1/23, JAM
8/14/23, TDN
5/21/24, TDN
SET MAG/WASHER
10/28/24, TDN

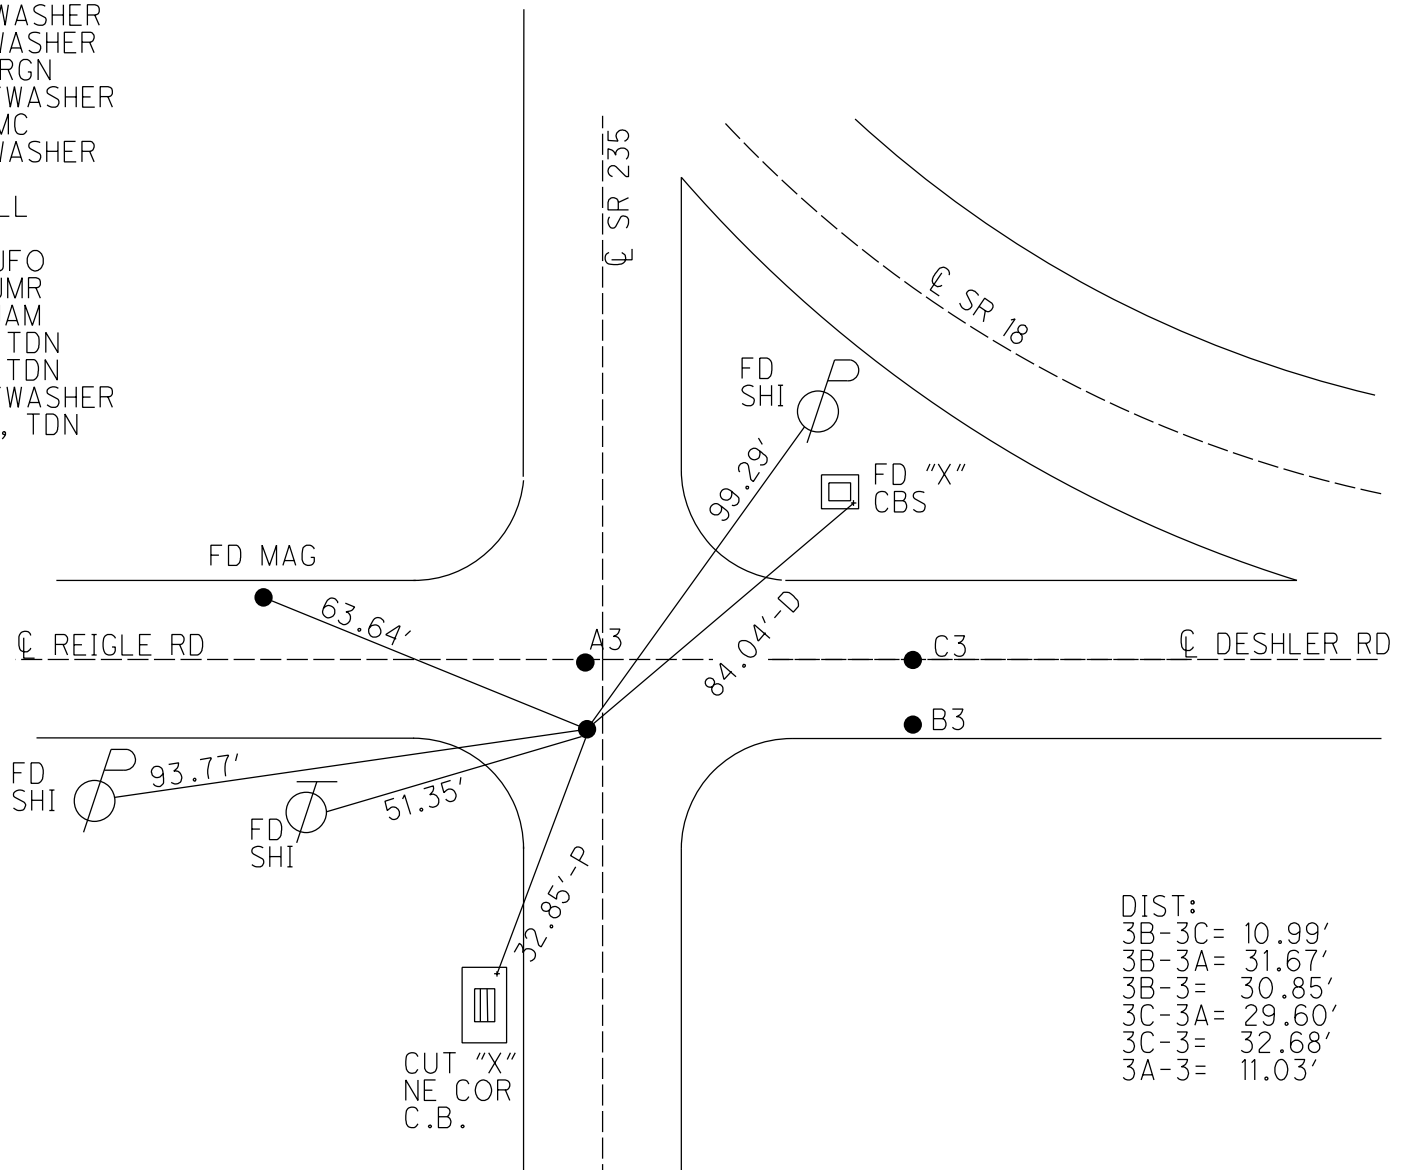

DIST:
3B-3C= 10.99'
3B-3A= 31.67'
3B-3= 30.85'
3C-3A= 29.60'
3C-3= 32.68'
3A-3= 11.03'

O.D.O.T. DISTRICT 2 SURVEY OFFICE (USE ONLY)

PERSONNEL

REFERENCE NO. 3

SHEET 5 OF 8

NOTES AUBLE

DATE 5-23-23

ROUTE SR 235

H.C. NIESE

WEATHER CALM

COUNTY WOOD

R.C. AUBLE

TEMP. 74° F

TOWNSHIP JACKSON

SECTION 25

DWG BY AUBLE

PID PAVETRAIN

T 3 N R 9 E

TYPE MONUMENT MAG/WASHER

ON SURFACE - ~~BELOW~~ ON

OFFSET CL PAVEMENT 2.5' LT : ~~RT~~

- TO - EDGE PAVEMENT


STATION: 53+76.82

HORIZ.DATUM: NAD83(2011)

GEOID: NAVD88 2018


GRID: NORTHING: 554935.199

EASTING: 1614977.520

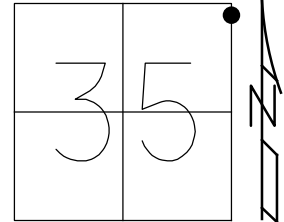

RECORD:

FD P.K./WASHER
FD MAG/WASHER
5/6/04, RGN
SET MAG/WASHER
8-3-04, MC
FD MAG/WASHER
REF3
6/1/18, JLL
4-27-21
9-16-21, JFO
1/11/23, JMR
2/1/23, JAM
8/14/23, TDN

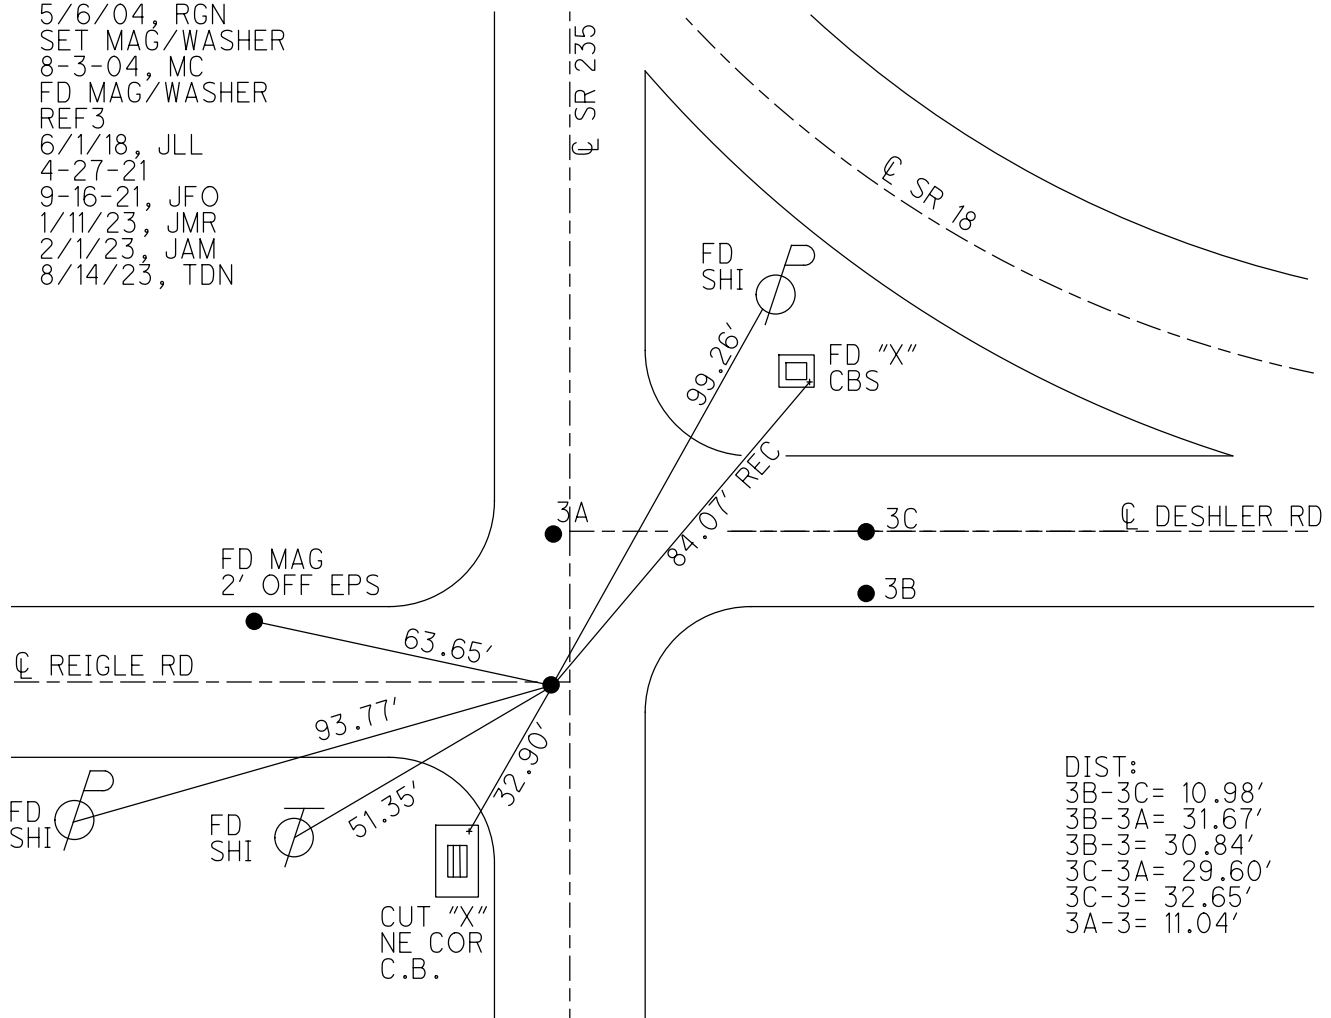

DIST:

3B-3C= 10.98'
3B-3A= 31.67'
3B-3= 30.84'
3C-3A= 29.60'
3C-3= 32.65'
3A-3= 11.04'

O.D.O.T. DISTRICT 2 SURVEY OFFICE (USE ONLY)

PERSONNEL

REFERENCE NO. 3

SHEET 5 OF 8

NOTES RHOADES

DATE 4-27-21

ROUTE SR 235

H.C. O'DONNELL

WEATHER WINDY

COUNTY WOOD

R.C. RHOADES

TEMP. 64° F

TOWNSHIP JACKSON

SECTION 25

DWG BY AUBLE PID PAVETRAIN

T 3 N R 9 E

TYPE MONUMENT MAG/WASHER

ON SURFACE - ~~BELOW~~ ON

OFFSET Q PAVEMENT 2.5' LT : ~~RT~~

- TO - EDGE PAVEMENT


STATION: 53+76.82

HORIZ.DATUM: NAD83(2011)


GEOID: NAVD88 2018

GRID: NORTHING: 554935.177

EASTING: 1614977.489

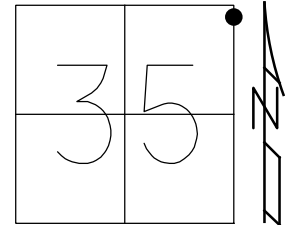

RECORD:
FD P.K./WASHER
FD MAG/WASHER
5/6/04, RGN
SET MAG/WASHER
8-3-04, MC
FD MAG/WASHER
REF3
6/1/18, JLL
4-27-21
9-16-21, JFO
1/11/23, JMR

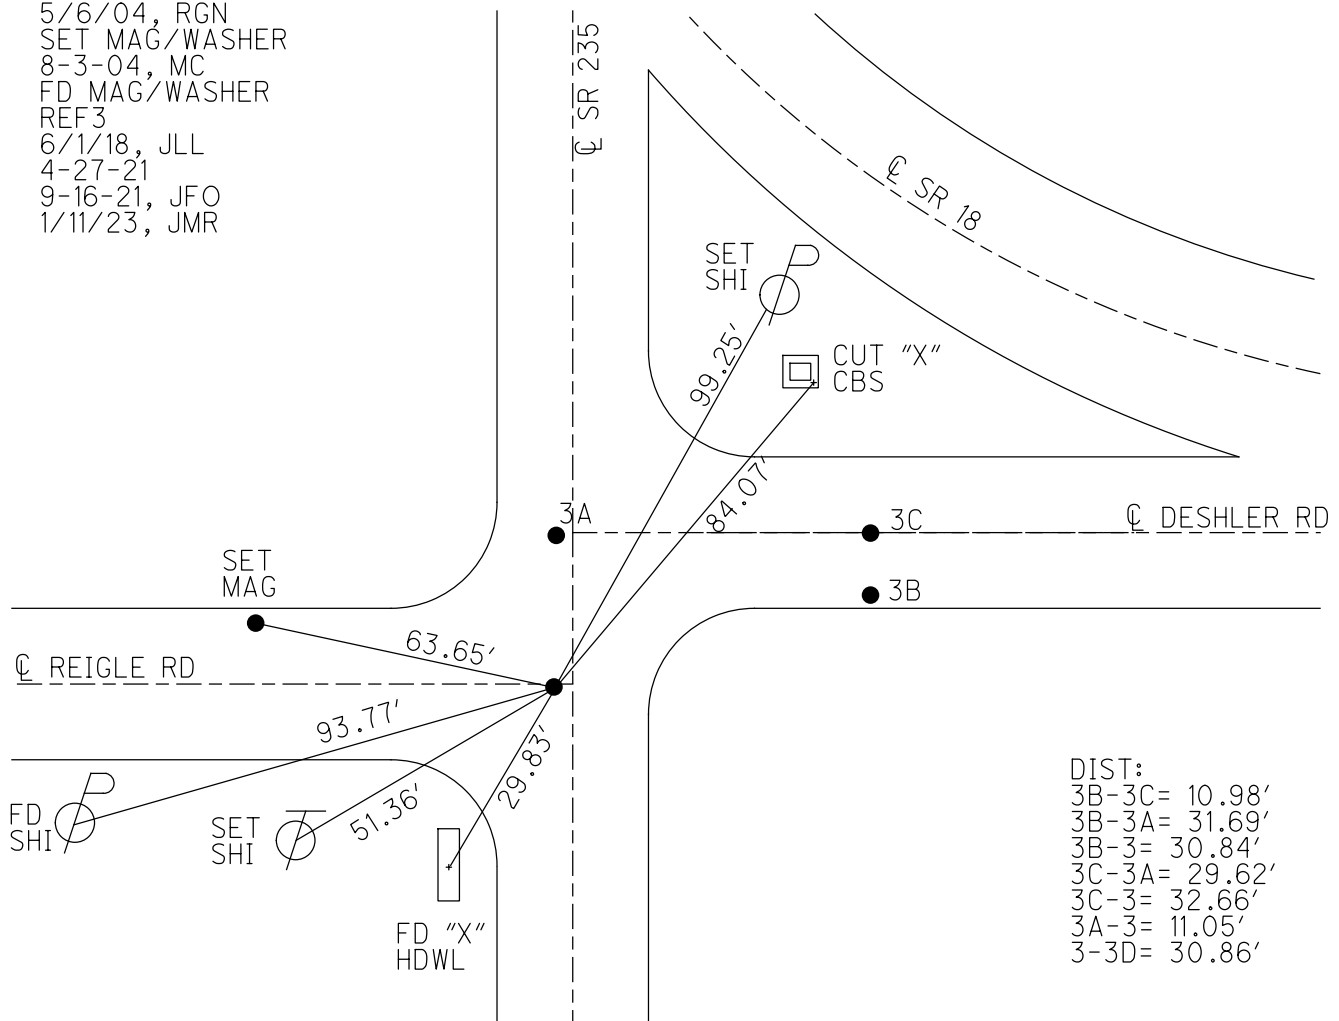

DIST:
3B-3C= 10.98'
3B-3A= 31.69'
3B-3= 30.84'
3C-3A= 29.62'
3C-3= 32.66'
3A-3= 11.05'
3-3D= 30.86'

O.D.O.T. DISTRICT 2 SURVEY OFFICE (USE ONLY)

PERSONNEL

REFERENCE NO. 3

SHEET 5 OF 8

NOTES RHOADES

DATE 4-27-21

ROUTE SR 235

H.C. O'DONNELL

WEATHER WINDY

COUNTY WOOD

R.C. RHOADES

TEMP. 64° F

TOWNSHIP JACKSON

SECTION 25

DWG BY AUBLE PID PAVETRAIN

T 3 N R 9 E

TYPE MONUMENT MAG/WASHER

ON SURFACE - ~~BELOW~~ ON

OFFSET Q PAVEMENT 2.5' LT : ~~RT~~

- TO - EDGE PAVEMENT


STATION: 53+76.82

HORIZ.DATUM: NAD83(2011)


GEOID: NAVD88 2018

GRID: NORTHING: 554935.177

EASTING: 1614977.489

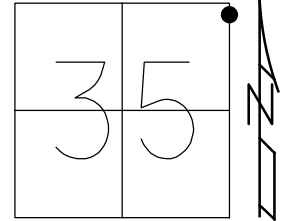

RECORD:
FD P.K./WASHER
FD MAG/WASHER
5/6/04, RGN
SET MAG/WASHER
8-3-04, MC
FD MAG/WASHER
REF3
6/1/18, JLL
4-27-21
9-16-21, JFO

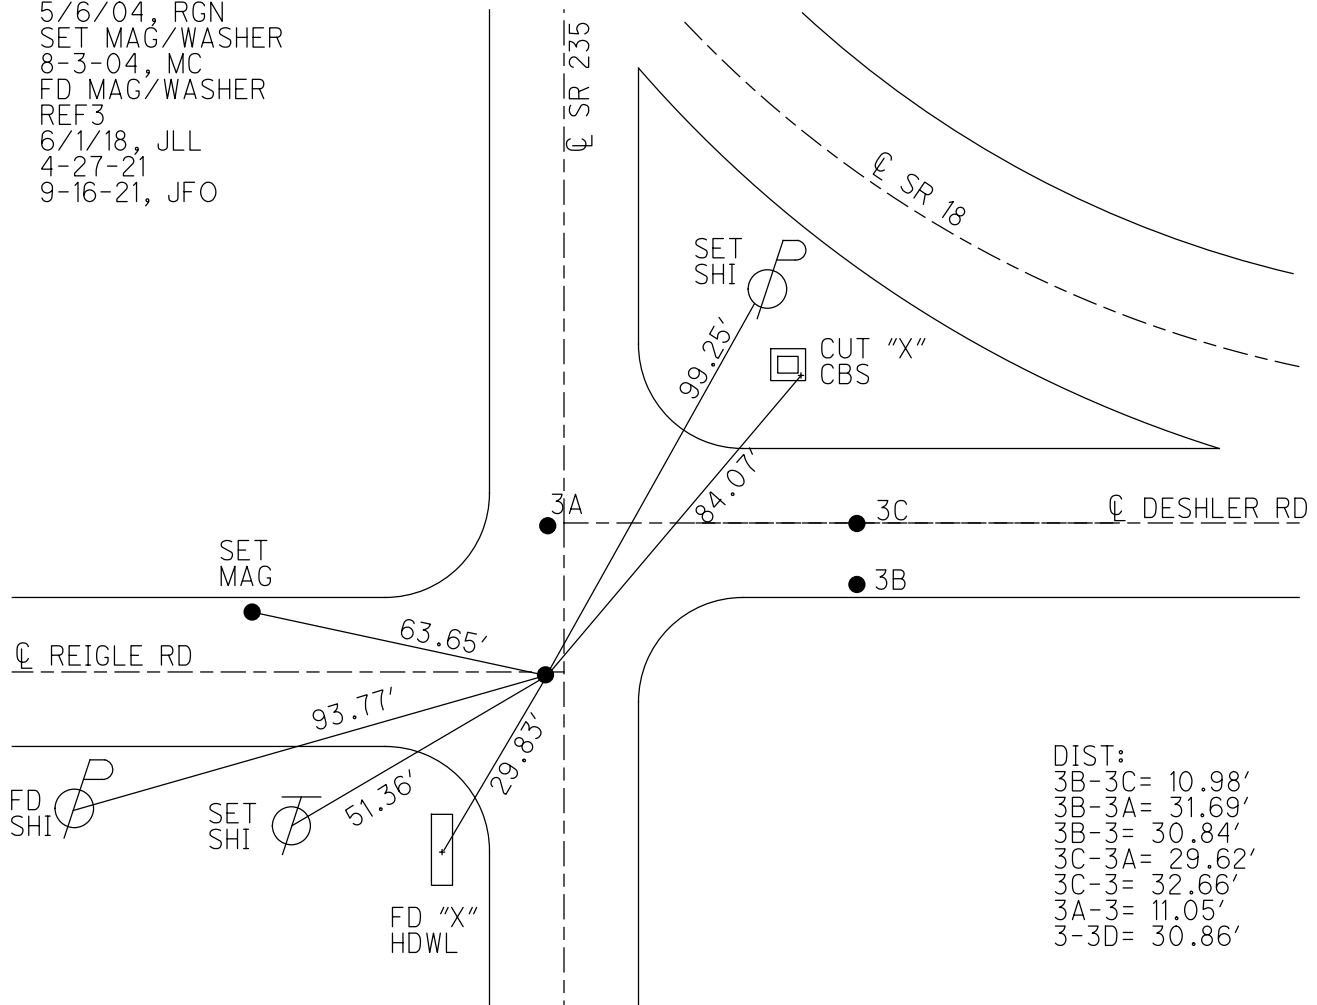


DIST:
3B-3C= 10.98'
3B-3A= 31.69'
3B-3= 30.84'
3C-3A= 29.62'
3C-3= 32.66'
3A-3= 11.05'
3-3D= 30.86'

O.D.O.T. DISTRICT 2 SURVEY OFFICE (USE ONLY)

PERSONNEL _____ REFERENCE NO. 3 SHEET 5 OF 8

NOTES	NUHFER	DATE	5-06-04	ROUTE	SR 235
H.C.	CANERBURY	WEATHER	SUNNY	COUNTY	WOOD
R.C.	ARMS	TEMP.	65°F	TOWNSHIP	JACKSON
				SECTION	25
				T	3 N R 9 E

TYPE MONUMENT MAG/WASHER
 ON SURFACE - ~~BELOW~~ ON
 LEFT - Q PAV'T - ~~RIGHT~~ 2.5'
- TO - EDGE PAVEMENT
 S.L.M. 53+76.82

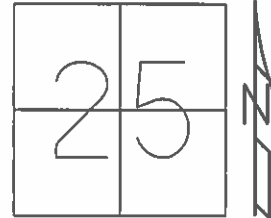


Grid: Northing: 554935.163 Easting: 1614977.299

RECORD:
 PK WASHER @SURFACE
 11.0 S. OF Q EAST
 2.5 LT. OF Q S.R. 235
 ON CL WEST

SET MAG/WASHER
 ALL FOUR POINTS
 08-03-04, MC

REF 3B TO REF 3C = 10.99'
 REF 3B TO REF 3A = 31.68'
 REF 3B TO REF 3 = 30.84'
 REF 3C TO REF 3A = 29.60'
 REF 3C TO REF 3 = 32.65'
 REF 3A TO REF 3 = 11.05'

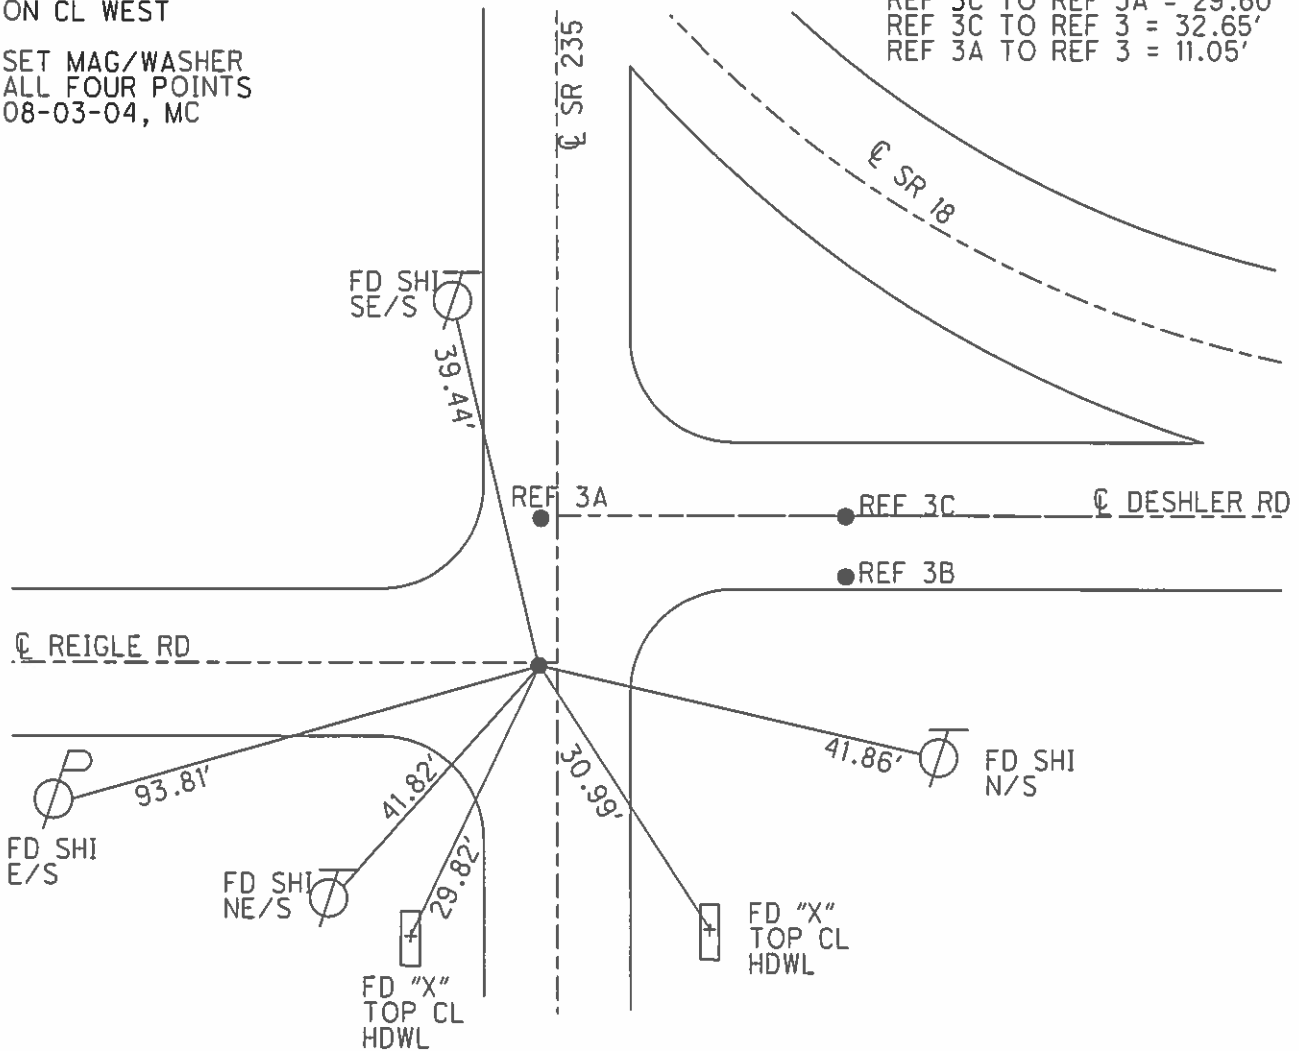

O.D.O.T. DISTRICT 2 SURVEY OFFICE

PERSONNEL

REFERENCE NO. 3

SHEET 5 OF 5

NOTES NUHFER

DATE 5-06-04

ROUTE S.R. 235
S.R. 18

H.C. CANTERBURY

WEATHER SUN

COUNTY WOOD

R.C. ARMS

TEMP. +65°

TOWNSHIP JACKSON

SECTION 26

T 3 N R 9 E

TYPE MONUMENT P.K./WASHER
PT "D" 1/2" IPIN>>

ON SURFACE YES

LEFT-Q PAV'T-RIGHT INFO. BELOW

TO EDGE PAVEMENT

S.L.M. PT "D" 53+90

26	25
35	36



RECORD: PT "A"
OVER STONE


PT "A" 3B
PK SHINER@SURFACE
11.0 S. OF Q EAST
27.5 E. OF Q S.R. 235

PT "B" 3C
PK SHINER@2"DOWN
ON Q PAVEMENT EAST
27.5 E. OF Q S.R.235

PT "C" 3A
PK WASHER@2"DOWN
ON Q OF PAVEMENT EAST
2.2 LT. OF Q S.R. 235

PT "D" 3
PK WASHER @SURFACE
11.0 S. OF Q EAST
2.5 LT. OF Q S.R. 235
ON CL WEST

RESET MAGS & WASHERS
ALL FOUR POINTS
08-03-04
MC

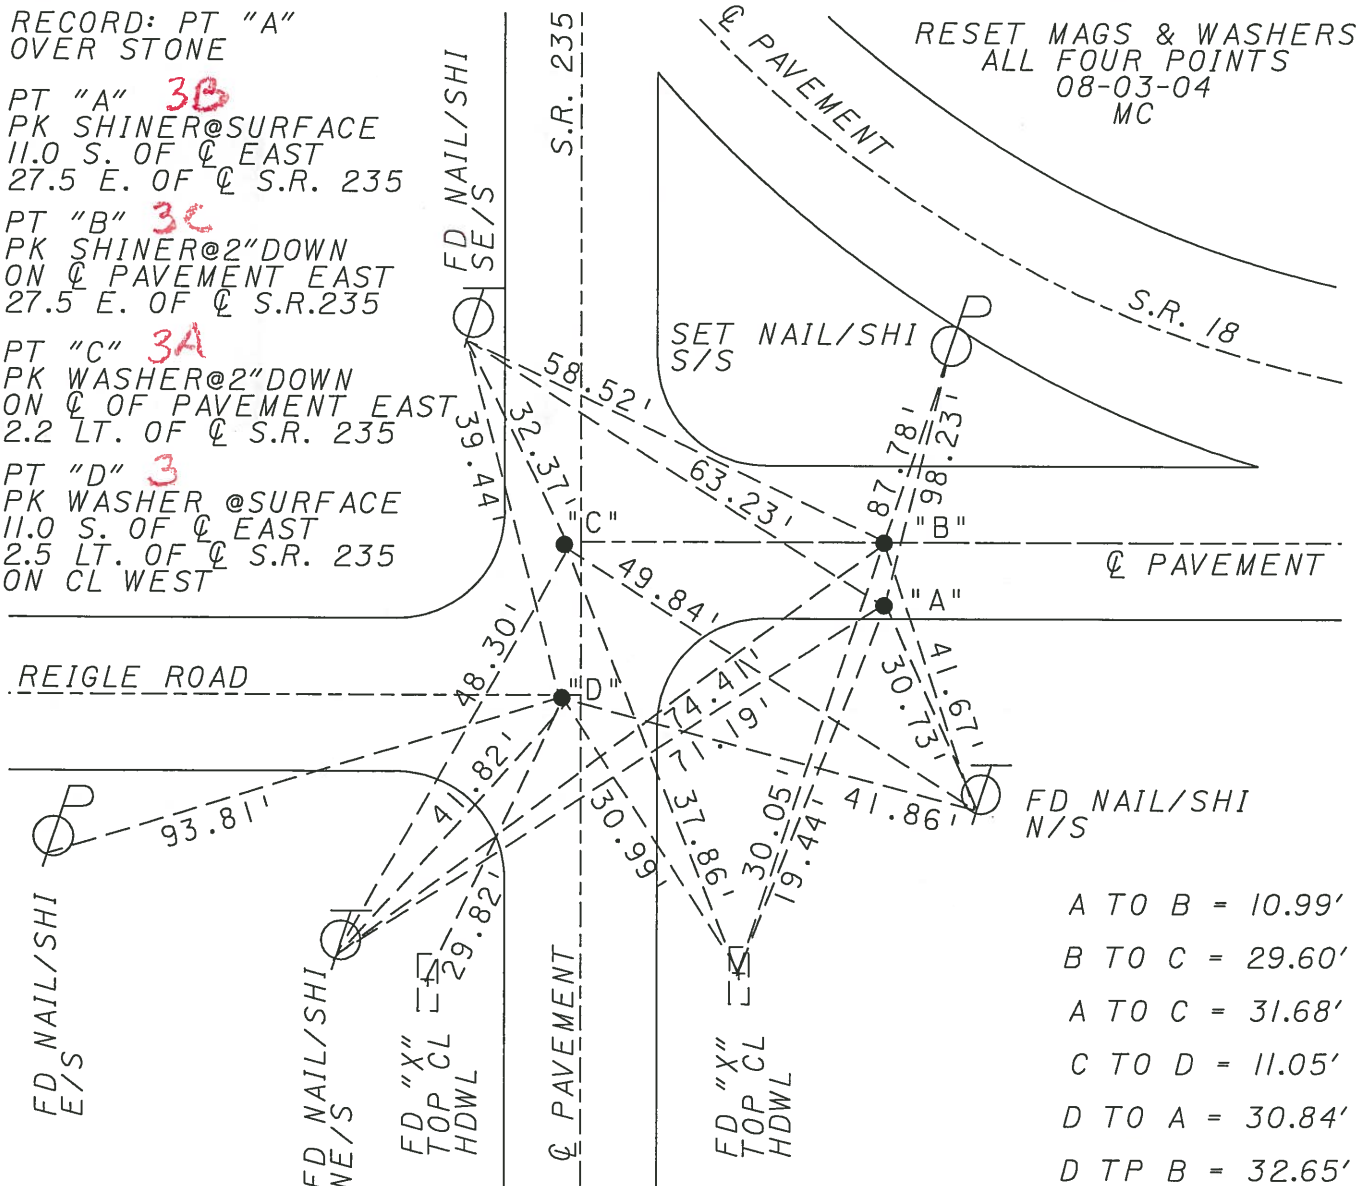

O.D.O.T. DISTRICT 2 SURVEY OFFICE

PERSONNEL

REFERENCE NO. 3

SHEET 3 OF 3

NOTES OTTO

H.C. Kusz

R.C. BARNHISEL

DATE 7-21-93

WEATHER cloudy

TEMP. +72°

ROUTE 5 R 18

COUNTY WOOD

TOWNSHIP JacksonSECTION 26

T3 NR 9 E


TYPE MONUMENT PK'S + WASHERS / PT "D" 1/2" I. PIN

ON SURFACE - ~~BELOW~~ yes ¹ 2 1/2" Down

LEFT - & PAN'T. - RIGHT INFO. BELOW

- TO - EDGE PAVEMENT

S.L.M. PT "D" 53+90

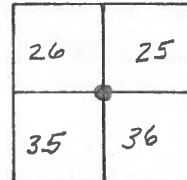

RECORD: PT "A")
OVER STONE }

PT "A" 3B

11.0 S. OF E EAST
27.5 E. OF E S.R. 235

PT "B" 3C

ON E PAUL EAST
27.5 E. OF E S.R. 235


PT "C" 3A

ON E OF PAUL EAST
2.2 LT OF E S.R. 235

PT "D" 3

11.0 S. OF E EAST
2.5 LT OF E S.R. 235
2 1/2" DOWN

RESET PK'S & WASHER
ALL FOUR POINTS
10-27-93
MB

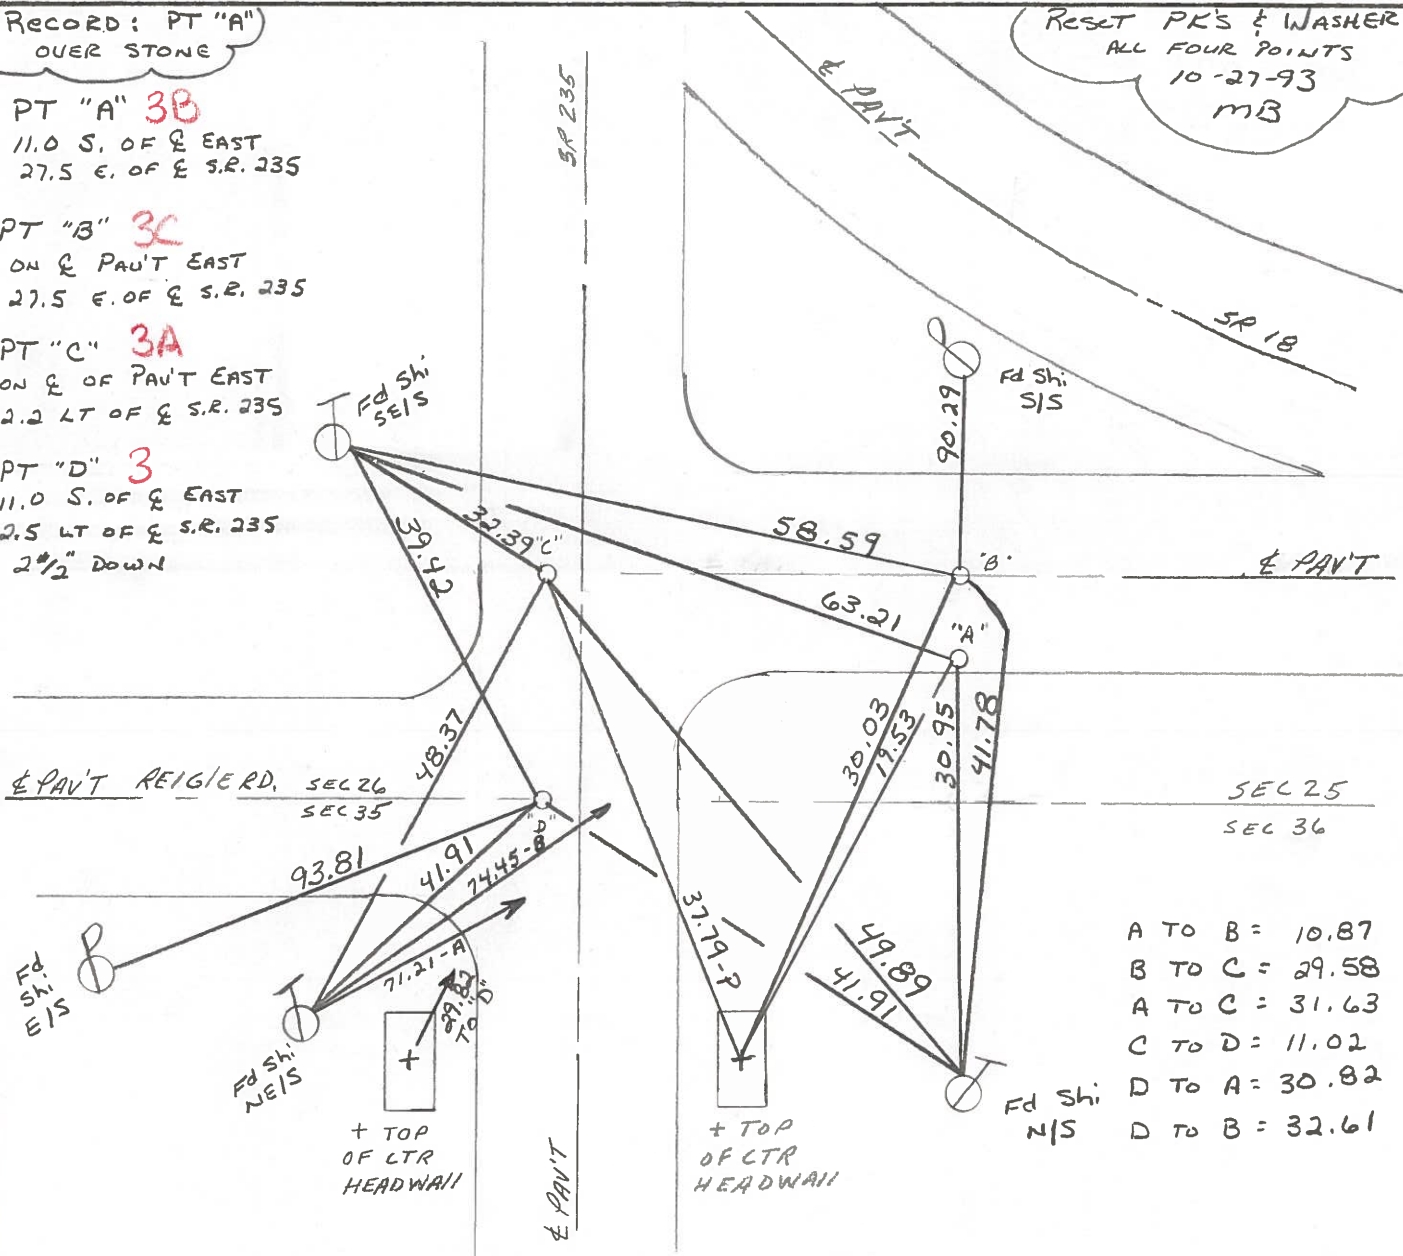

O.D.O.T. DISTRICT 2 SURVEY OFFICE

PERSONNEL

REFERENCE NO. 15

SHEET OF

NOTES BARNHISEL

H.C. Loehake

R.C. HOFFMAN

DATE 3-19-91

WEATHER cloudy - windy

TEMP. +45°

ROUTE 18 & 235

COUNTY Wood

TOWNSHIP JACKSON

SECTION 26

T 3 N R 9 E

TYPE MONUMENT P.K.'s & Washers


ON SURFACE - BELOW YES (ALL)

LEFT - & PAV'T. - RIGHT Information Below

- TO - EDGE PAVEMENT

S.L.M. NOT COVERED IN 1991 RESURFACING OF S.R. 18

PT. "D"
1/2" IRON PIN
1 1/2" DOWN

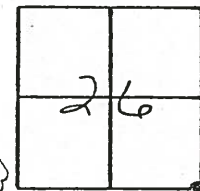

A TO B	=	10.86
B TO C	=	29.58
A TO C	=	31.63
C TO D	=	11.03
D TO A	=	30.83
D TO B	=	32.60

PT. "A"
11.0 S. OF & EAST,
27.5 E. OF & S.R. 235

PT. "B"
ON & PAVT E.
27.5 E. OF & S.R. 235

PT. "C"
ON & PAVT E.
2.2 W. OF & S.R. 235

PT. "D"
11.0 S. OF & E.
2.5 W. OF & S.R. 235
2" DOWN

