

O.D.O.T. DISTRICT 2 SURVEY OFFICE (USE ONLY)

PERSONNEL

REFERENCE NO. A 3

SHEET 4 OF 26

NOTES NIESE

DATE 10/28/24

ROUTE SR 235

H.C. NIESE

WEATHER CALM

COUNTY WOOD

R.C. PRESTON-COLVIN

TEMP. 42°

TOWNSHIP JACKSON

DWG BY BARRIERE

PID 101290

SECTION 26

T 3 N R 9 E

TYPE MONUMENT MAG NAIL/WASHER

ON SURFACE - BELOW ON

OFFSET $\angle$ PAVEMENT 2.5' LT LT : RT


TO EDGE PAVEMENT

STATION: 53+76.82

HORIZ.DATUM: NAD83(2011)/WOOD LDP GEOID: 2018


GRID: NORTHING: 376295.312 EASTING: 127046.020

LDP: NORTHING: 554946.152 EASTING: 1614978.692

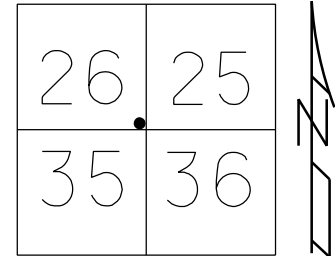

RECORD: P.I.
STA 346+43.13
1927 PLANS
FD P.K./WASHER
FD MAG/WASHER
5/6/04, RGN
SET MAG/WASHER
8-3-04, MC
FD MAG/WASHER
REFA3
6/1/18, JLL
4-27-21
9-16-21, JFO
1/11/23, JMR
2/1/23, JAM
8/14/23, TDN
SET MAG/WASHER
10/28/24, TDN

NOTE: SR 18 REF15A

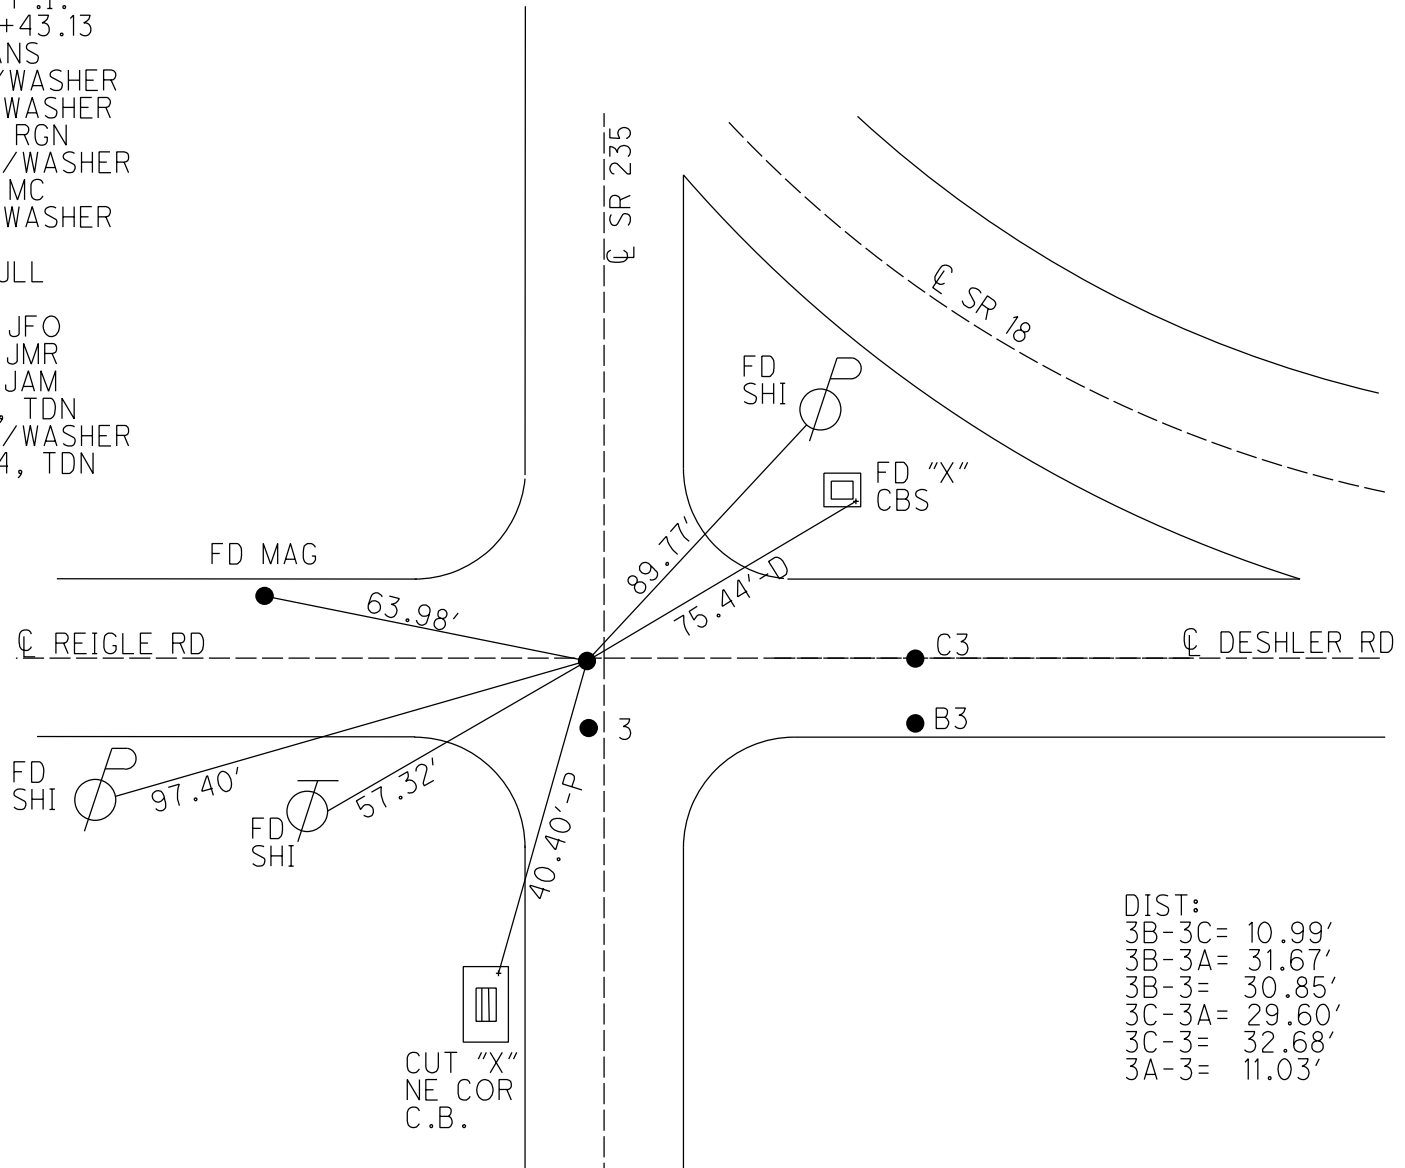

DIST:
3B-3C= 10.99'
3B-3A= 31.67'
3B-3= 30.85'
3C-3A= 29.60'
3C-3= 32.68'
3A-3= 11.03'

O.D.O.T. DISTRICT 2 SURVEY OFFICE (USE ONLY)

PERSONNEL

REFERENCE NO. 3 A

SHEET 6 OF 8

NOTES_____AUBLE

DATE 5-23-23

ROUTE SR 235H.C. NIESE

WEATHER CALM

COUNTY WOOD

R.C. AUBLE

TEMP. 74° F

TOWNSHIP JACKSONSECTION 26

T_3_N R_9_E

DWG BY AUBLEPID PAVETRAIN

TYPE MONUMENT MAG/WASHER

ON SURFACE - ~~BELOW~~ ON

OFFSET C PAVEMENT 2.5' LT : ~~RT~~


____TO____EDGE PAVEMENT

STATION: 53+76.82

HORZ.DATUM: NAD83(2011)


GEOID: NAVD88 2018

GRID: NORTHING: 554946.152

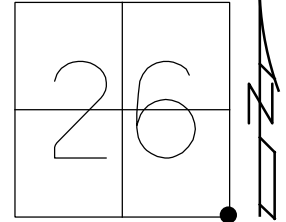EASTING: 1614978.692

RECORD: P.I.
STA 346+43.13
1927 PLANS
FD P.K./WASHER
FD MAG/WASHER
5/6/04, RGN
SET MAG/WASHER
8-3-04, MC
FD MAG/WASHER
REF A3
6/1/18, JLL
4-27-21
9-16-21, JFO
1/11/23, JMR
2/1/23, JAM
8/14/23, TDN

NOTE: SR 18 REF16A

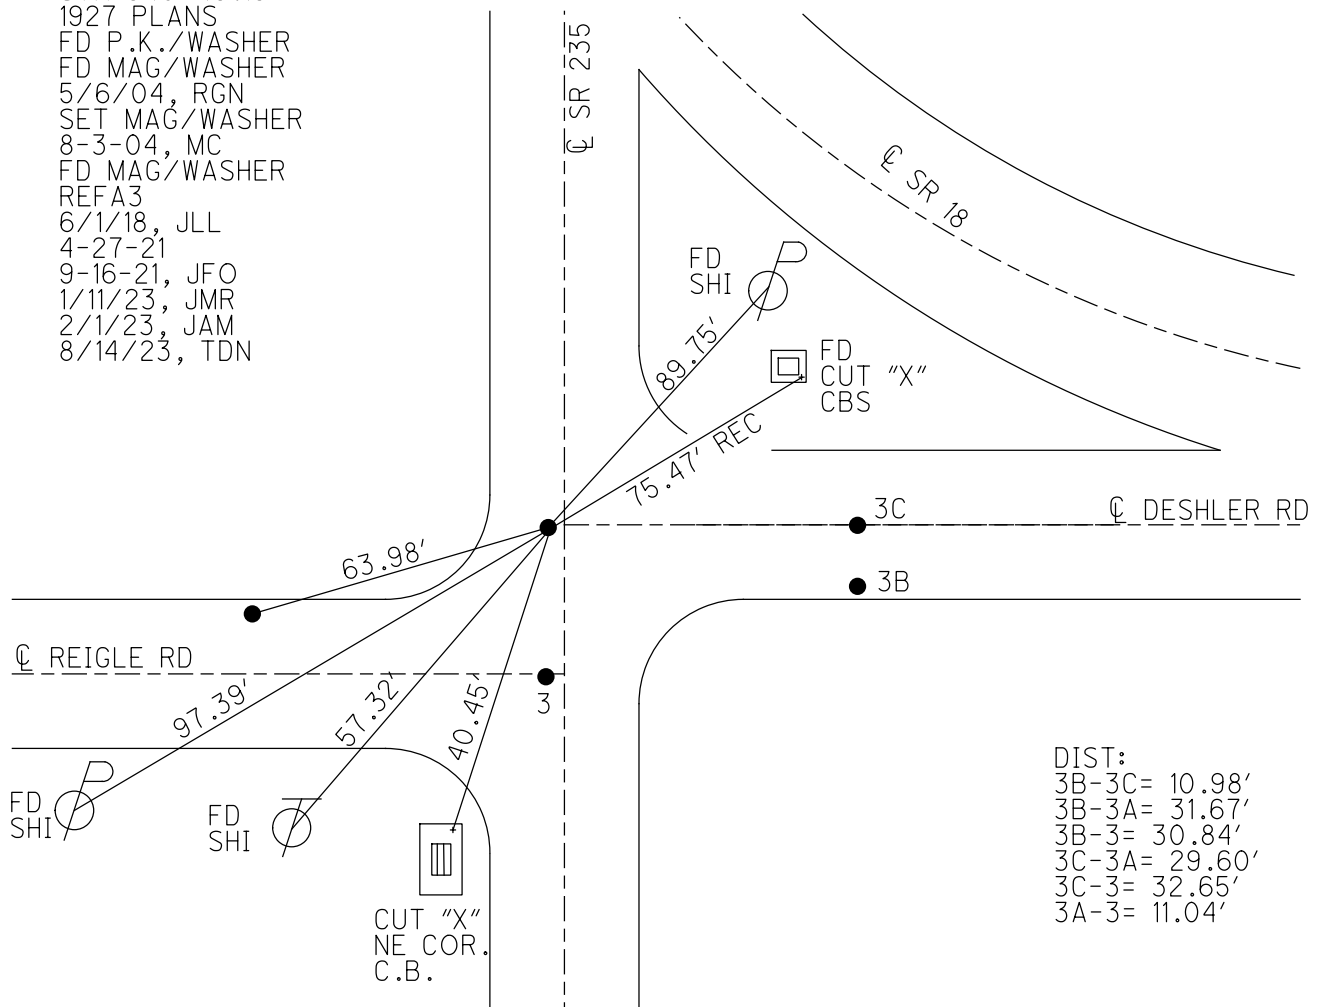

DIST:
 $3B-3C = 10.98'$
 $3B-3A = 31.67'$
 $3B-3 = 30.84'$
 $3C-3A = 29.60'$
 $3C-3 = 32.65'$
 $3A-3 = 11.04'$

O.D.O.T. DISTRICT 2 SURVEY OFFICE (USE ONLY)

PERSONNEL

REFERENCE NO. 3 A

SHEET 6 OF 8

NOTES RHOADES

DATE 4-27-21

ROUTE SR 235

H.C. O'DONNELL

WEATHER WINDY

COUNTY WOOD

R.C. RHOADES

TEMP. 64° F

TOWNSHIP JACKSON

SECTION 25

DWG BY AUBLE

PID PAVETRAIN

T 3 N R 9 E

TYPE MONUMENT MAG/WASHER

ON SURFACE - ~~BELOW~~ ON

OFFSET 2.5' LT : ~~RT~~

- TO - EDGE PAVEMENT


STATION: 53+76.82

HORZ.DATUM: NAD83(2011)


GEOID: NAVD88 2018

GRID: NORTHING: 554946.148

EASTING: 1614978.671

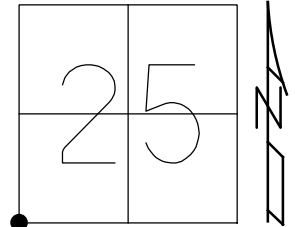

RECORD:
FD P.K./WASHER
FD MAG/WASHER
5/6/04, RGN
SET MAG/WASHER
8-3-04, MC
FD MAG/WASHER
REFA3
6/1/18, JLL
4-27-21
9-16-21, JFO
1/11/23, JMR

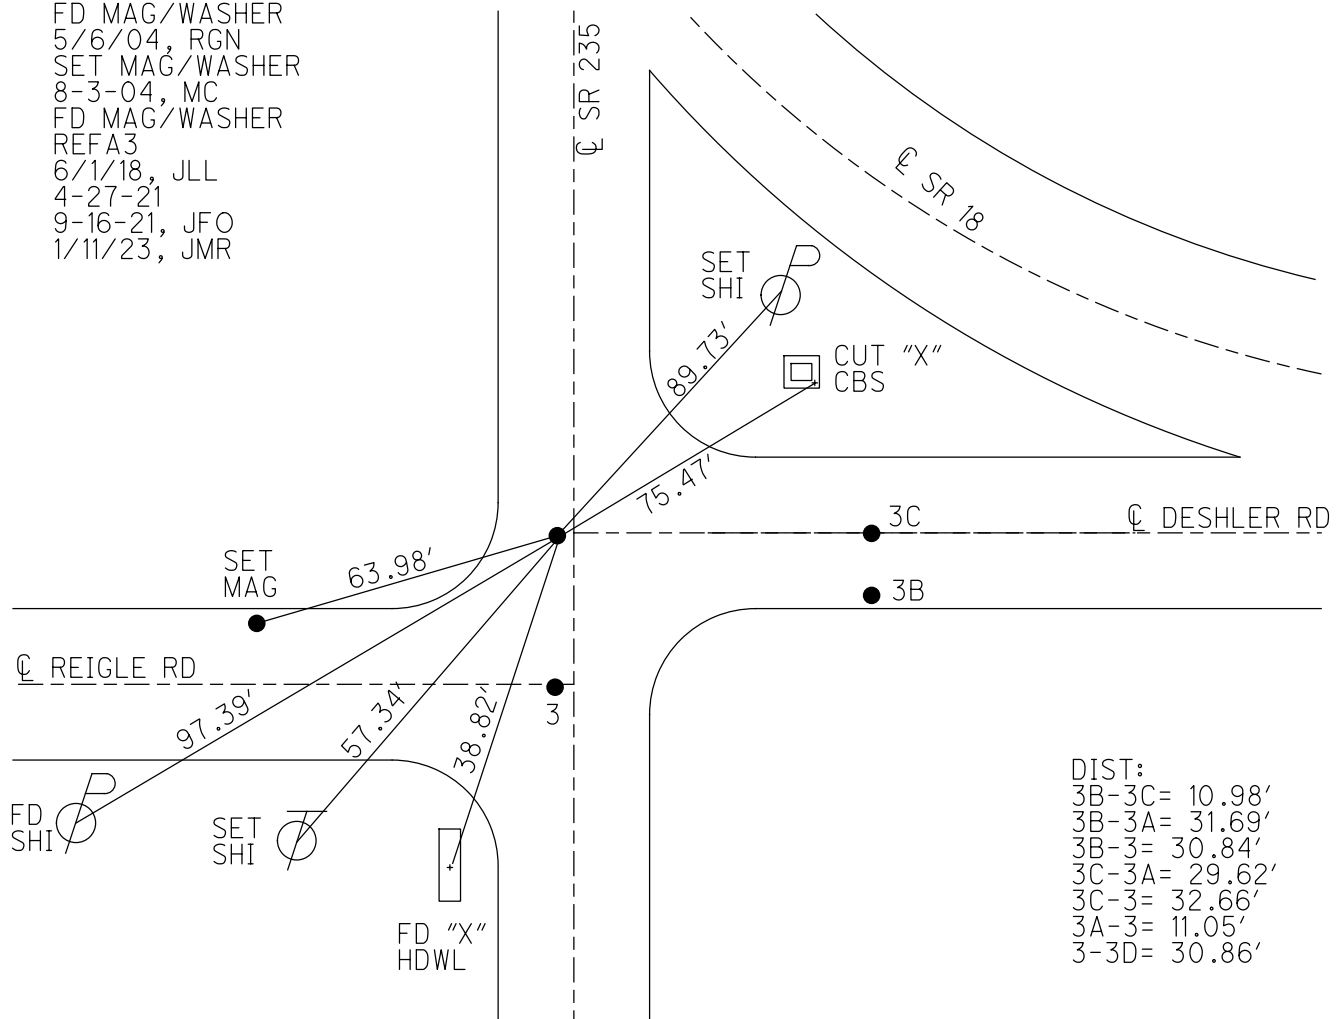

DIST:
3B-3C= 10.98'
3B-3A= 31.69'
3B-3= 30.84'
3C-3A= 29.62'
3C-3= 32.66'
3A-3= 11.05'
3-3D= 30.86'

O.D.O.T. DISTRICT 2 SURVEY OFFICE (USE ONLY)

PERSONNEL

REFERENCE NO. 3 A

SHEET 6 OF 8

NOTES RHOADES

DATE 4-27-21

ROUTE SR 235

H.C. O'DONNELL

WEATHER WINDY

COUNTY WOOD

R.C. RHOADES

TEMP. 64° F

TOWNSHIP JACKSON

SECTION 25

DWG BY AUBLE

PID PAVETRAIN

T 3 N R 9 E

TYPE MONUMENT MAG/WASHER

ON SURFACE - ~~BELOW~~ ON

OFFSET ℄ PAVEMENT 2.5' LT : ~~RT~~

- TO - EDGE PAVEMENT


STATION: 53+76.82

HORIZ.DATUM: NAD83(2011)

GEOID: NAVD88 2018

GRID: NORTHING: 554946.148

EASTING: 1614978.671

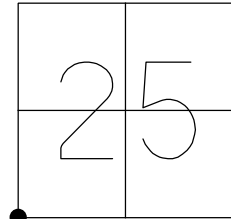

RECORD:

FD P.K./WASHER

FD MAG/WASHER

5/6/04, RGN

SET MAG/WASHER

8-3-04, MC


FD MAG/WASHER

REFA3

6/1/18, JLL

4-27-21

9-16-21, JFO

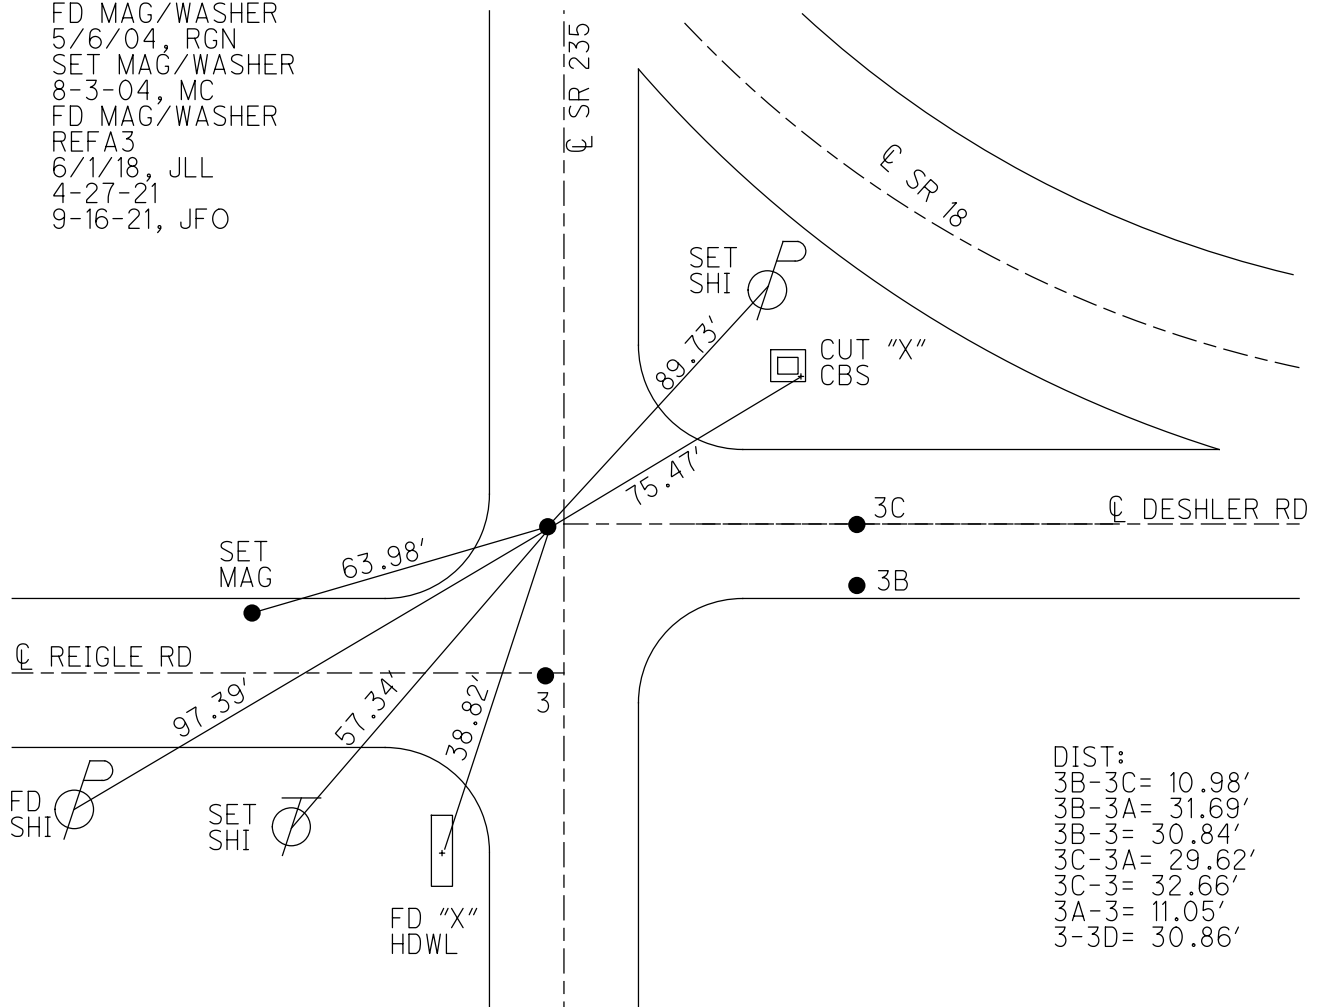

DIST:

3B-3C= 10.98'

3B-3A= 31.69'

3B-3= 30.84'

3C-3A= 29.62'

3C-3= 32.66'


3A-3= 11.05'

3-3D= 30.86'

O.D.O.T. DISTRICT 2 SURVEY OFFICE (USE ONLY)

PERSONNEL	REFERENCE NO. <u>3 A</u>	SHEET <u>6</u> OF <u>8</u>	
NOTES	DATE <u>5-06-04</u>	ROUTE <u>SR 235</u>	
H.C. <u>CANERBURY</u>	WEATHER <u>SUNNY</u>	COUNTY <u>WOOD</u>	
R.C. <u>ARMS</u>	TEMP. <u>65°F</u>	TOWNSHIP <u>JACKSON</u>	
		SECTION <u>25</u>	
		T <u>3</u> N R <u>9</u> E	

TYPE MONUMENT MAG/WASHER
 ON SURFACE - ~~BELOW~~ ON
 LEFT - CL PAV'T - ~~RIGHT~~ 2.2'
- TO - EDGE PAVEMENT
 S.L.M. 53+87.81

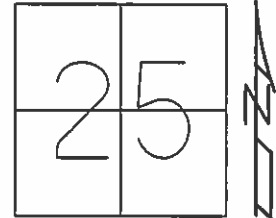


Grid: Northing: 554946.224 Easting: 1614978.645

RECORD:
 PK WASHER@2"DOWN
 ON CL OF PAVEMENT EAST
 2.2 LT. OF CL S.R. 235

SET MAG/WASHER
 ALL FOUR POINTS
 08-03-04, MC

REF 3B TO REF 3C = 10.99'
 REF 3B TO REF 3A = 31.68'
 REF 3B TO REF 3 = 30.84'
 REF 3C TO REF 3A = 29.60'
 REF 3C TO REF 3 = 32.65'
 REF 3A TO REF 3 = 11.05'

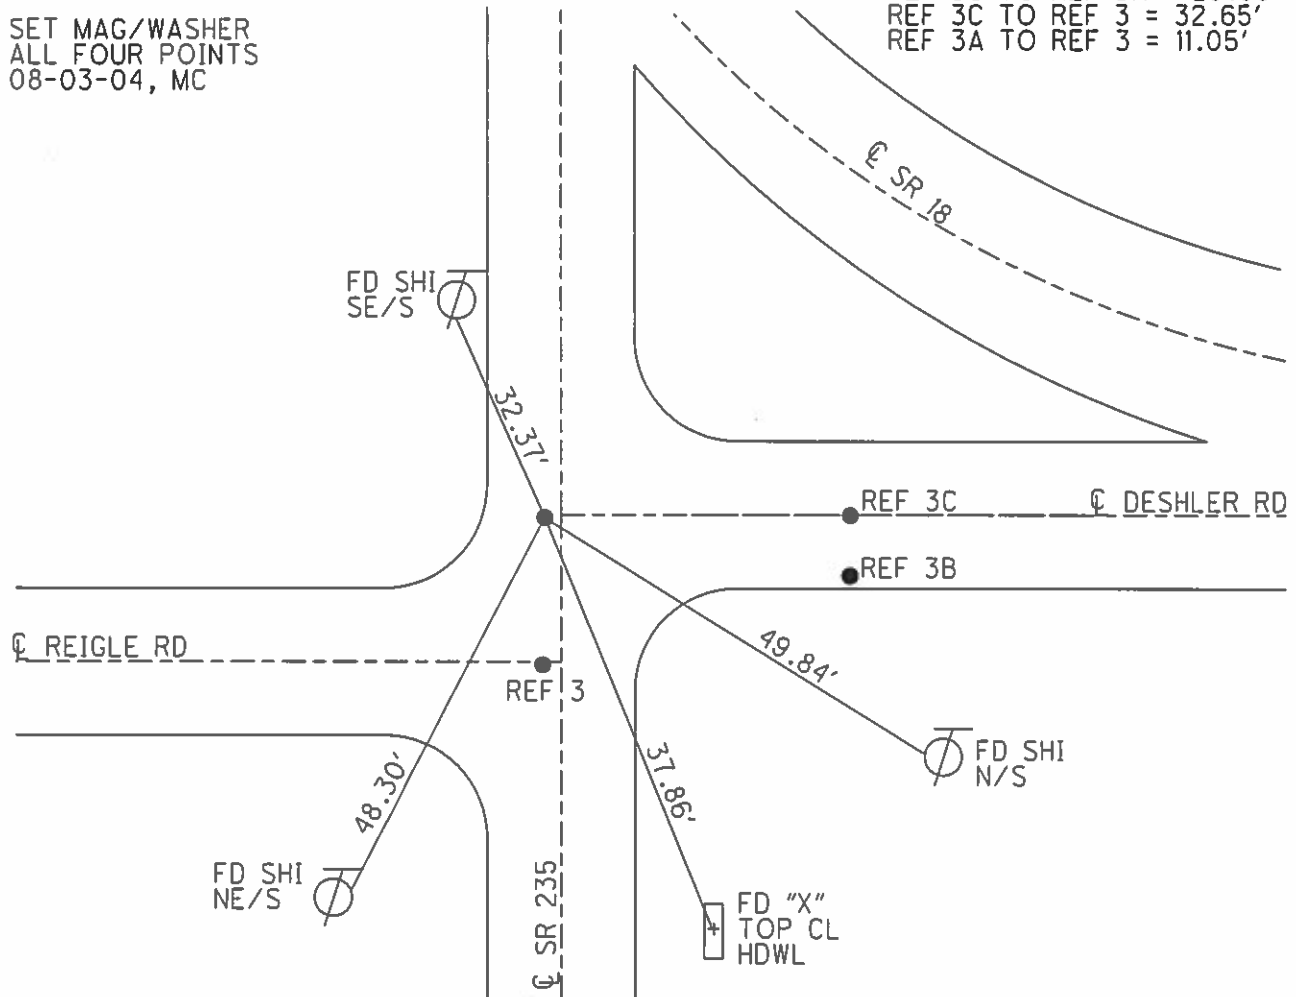

O.D.O.T. DISTRICT 2 SURVEY OFFICE

PERSONNEL

REFERENCE NO. 3

SHEET 5 OF 5

NOTES NUHFER
H.C. CANTERBURY
R.C. ARMS

DATE 5-06-04
WEATHER SUN
TEMP. +65°

ROUTE S.R. 235
COUNTY WOOD
TOWNSHIP JACKSON
SECTION 26
T 3 N R 9 E

TYPE MONUMENT P.K. / WASHER
ON SURFACE PT "D" 1/2" IPIN>>
LEFT-CL PAV'T-RIGHT INFO. BELOW
TO EDGE PAVEMENT
S.L.M. PT "D" 53+90

26	25
35	36



RECORD: PT "A"
OVER STONE

PT "A" **3B**
PK SHINER@SURFACE
11.0 S. OF CL EAST
27.5 E. OF CL S.R. 235


PT "B" **3C**
PK SHINER@2"DOWN
ON CL PAVEMENT EAST
27.5 E. OF CL S.R.235

PT "C" **3A**
PK WASHER@2"DOWN
ON CL OF PAVEMENT EAST
2.2 LT. OF CL S.R. 235

PT "D" **3**
PK WASHER @SURFACE
11.0 S. OF CL EAST
2.5 LT. OF CL S.R. 235
ON CL WEST

RESET MAGS & WASHERS
ALL FOUR POINTS
08-03-04
MC

REIGLE ROAD

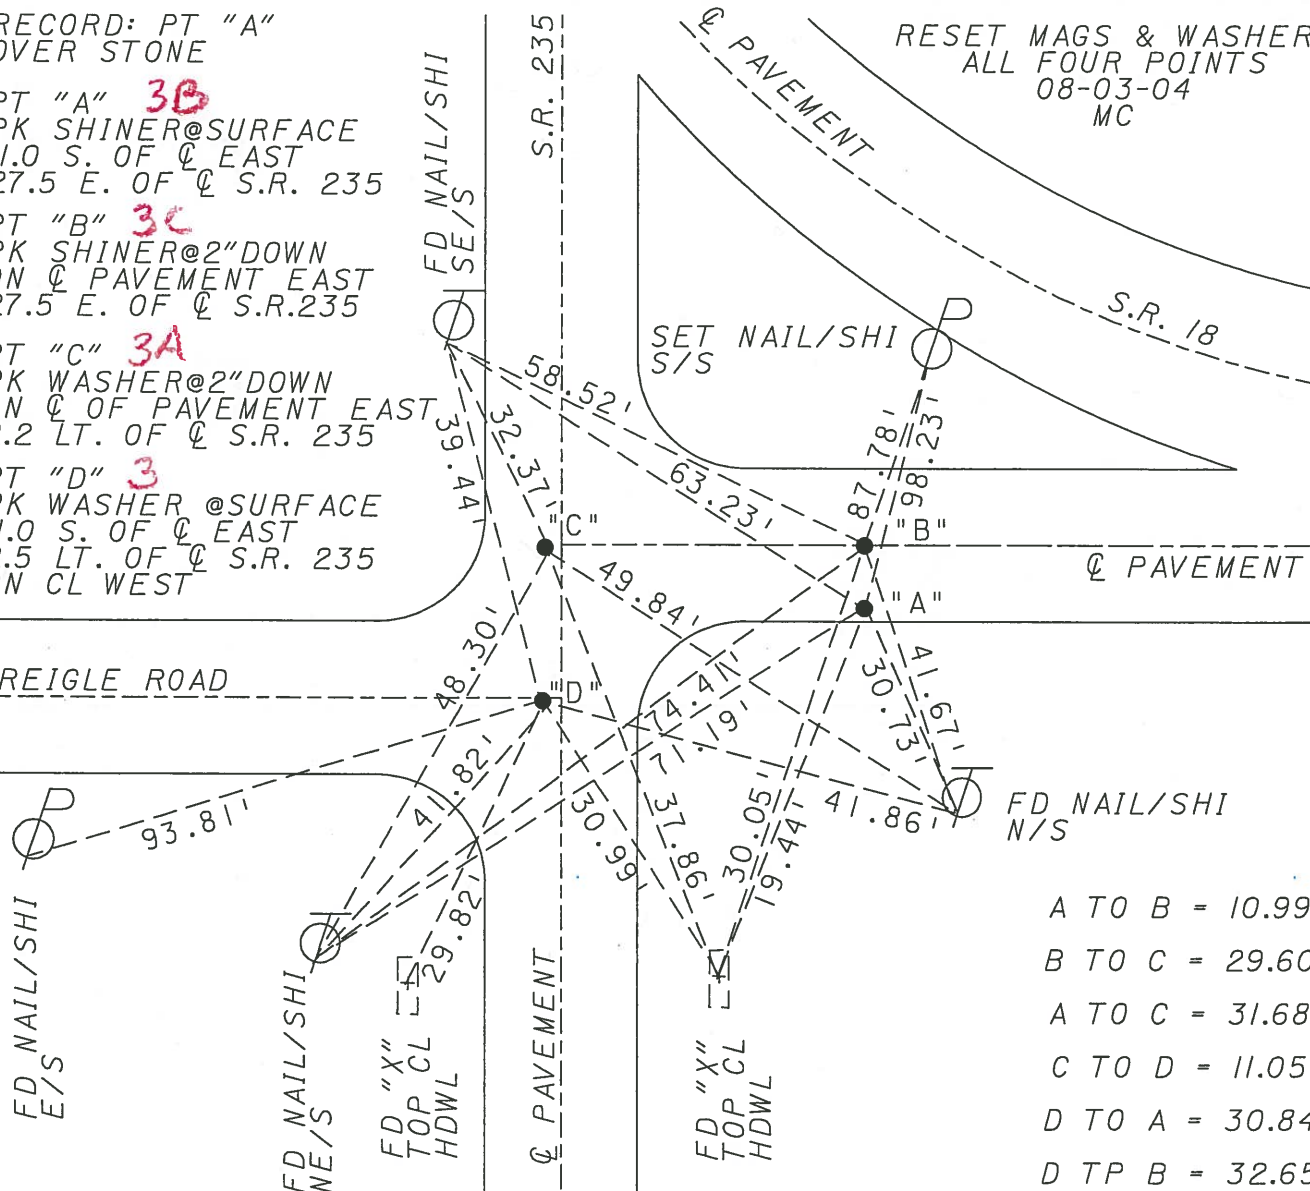

A TO B = 10.99'
B TO C = 29.60'
A TO C = 31.68'
C TO D = 11.05'
D TO A = 30.84'
D TO B = 32.65'

O.D.O.T. DISTRICT 2 SURVEY OFFICE

PERSONNEL

REFERENCE NO. 3

SHEET 3 OF 3

NOTES OTTO

H.C. Kusz

R.C. BARNHISEL

DATE 7-21-93

WEATHER cloudy

TEMP. +72°

ROUTE SR 18

COUNTY *Wood*

TOWNSHIP Jackson

SECTION 26


T3 NR 9 E

TYPE MONUMENT PK's + WASHERS / PT "D" 1/2" I. PIN
ON SURFACE - BELOW yes 2 1/2" Down

LEFT - & PAN'T. - RIGHT INFO. BELOW

- TO - EDGE PAVEMENT

S.L.M. PT "D" 53+90

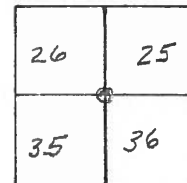

RECORD: PT "A")
OVER STONE }


PT "A" 3B
11.0 S. OF E EAST
27.5 E. OF E S.R. 235

PT "B" 3C
ON E PAUL EAST
27.5 E. OF E S.R. 235

PT "C" 3A
ON E OF PAUL EAST
2.2 LT OF E S.R. 235

PT "D" 3
11.0 S. OF E EAST
2.5 LT OF E S.R. 235
2 1/2" DOWN

RESET PK'S & WASHER
ALL FOUR POINTS
10-27-93
MB

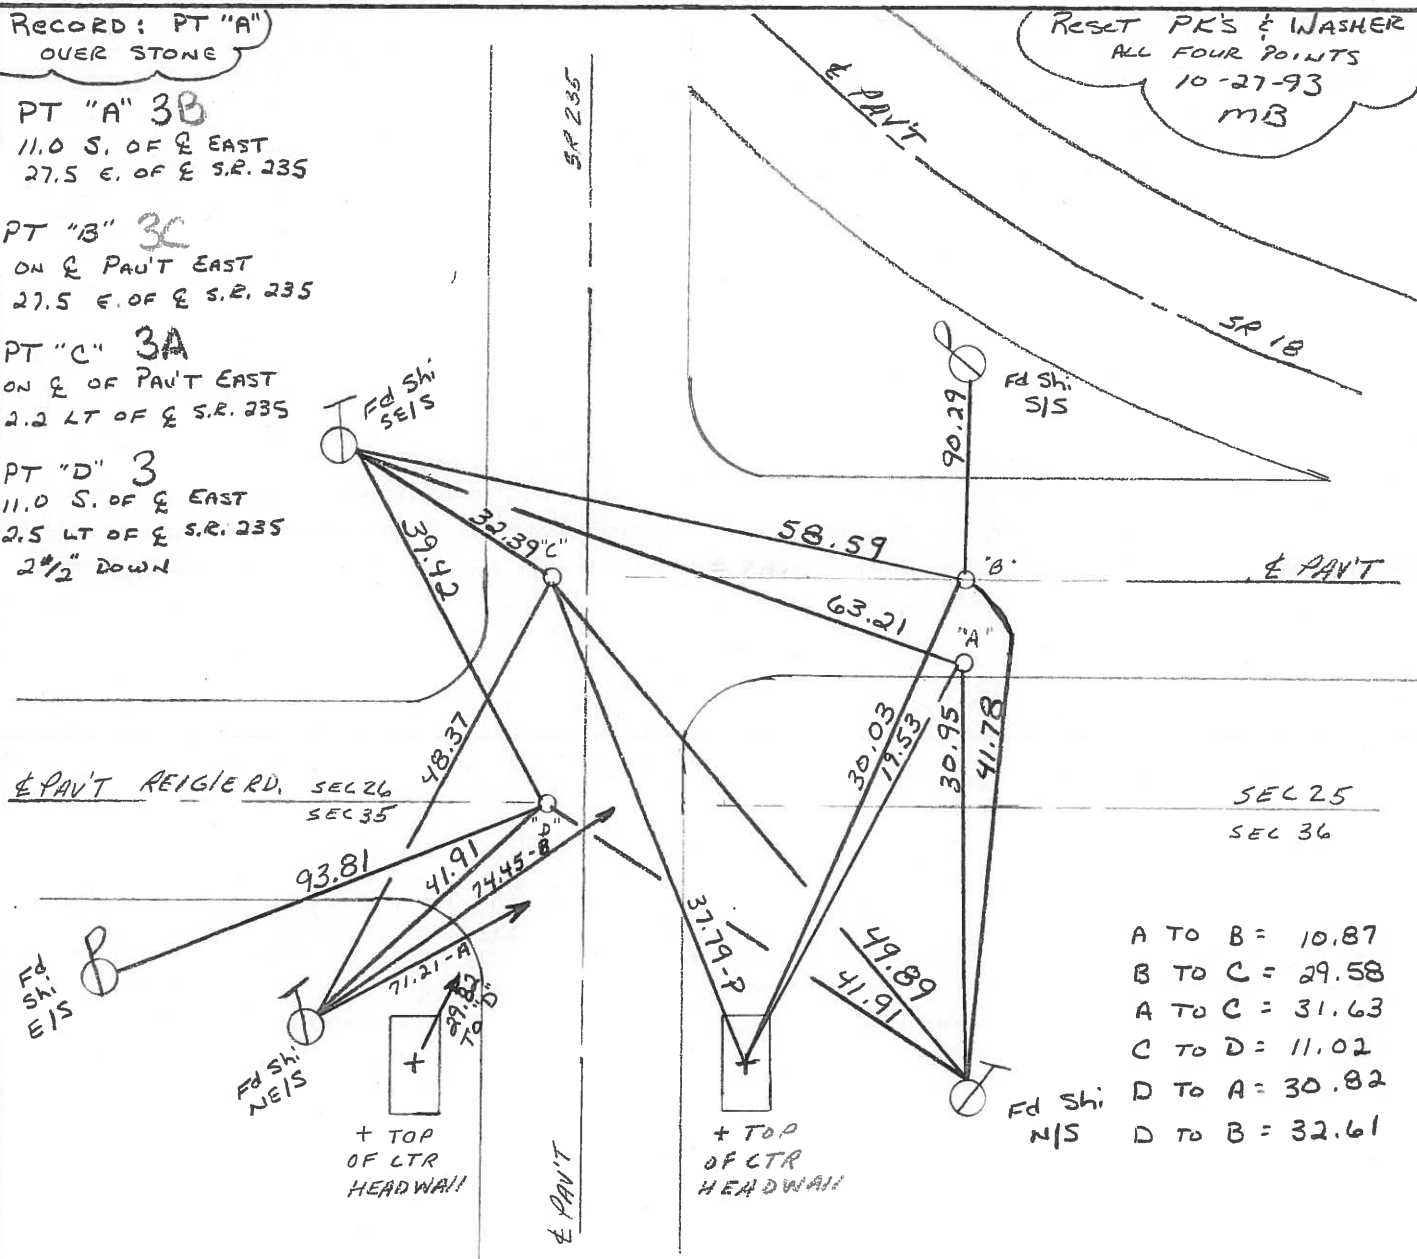

A TO B = 10.87
B TO C = 29.58
A TO C = 31.63
C TO D = 11.02
D TO A = 30.82
D TO B = 32.61

O.D.O.T. DISTRICT 2 SURVEY OFFICE

PERSONNEL

REFERENCE NO. 15

SHEET OF

NOTES BARNHISEL

H.C. Loehake

DATE 3-19-91

ROUTE 18 & 235

R.C. HOFFMAN

WEATHER cloudy - Windy

COUNTY Wood

TEMP. +45°

TOWNSHIP JACKSON

SECTION 26

T 3 N R 9 E

TYPE MONUMENT P.K.'s & Washers


ON SURFACE - BELOW YES (ALL)

LEFT - ℄ PAV'T. - RIGHT Information Below

- TO - EDGE PAVEMENT

S.L.M. NOT COVERED IN 1991 RESURFACING OF S.R. 18

PT. "D"
1/2" IRON PIN
1 1/2" DOWN

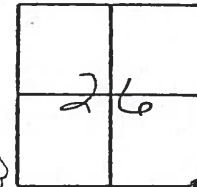


PT. "A"
11.0 S. OF E EAST,
27.5 E. OF E S.R. 235

A TO B = 10.86
B TO C = 29.58
A TO C = 31.63
C TO D = 11.03
D TO A = 30.83
D TO B = 32.60

PT. "B"
ON E PAV'T E.
27.5 E. OF E S.R. 235

PT. "C"
ON E PAV'T E.
2.2 W. OF E S.R. 235

PT. "D"
11.0 S. OF E E.
2.5 W. OF E S.R. 235
2" DOWN

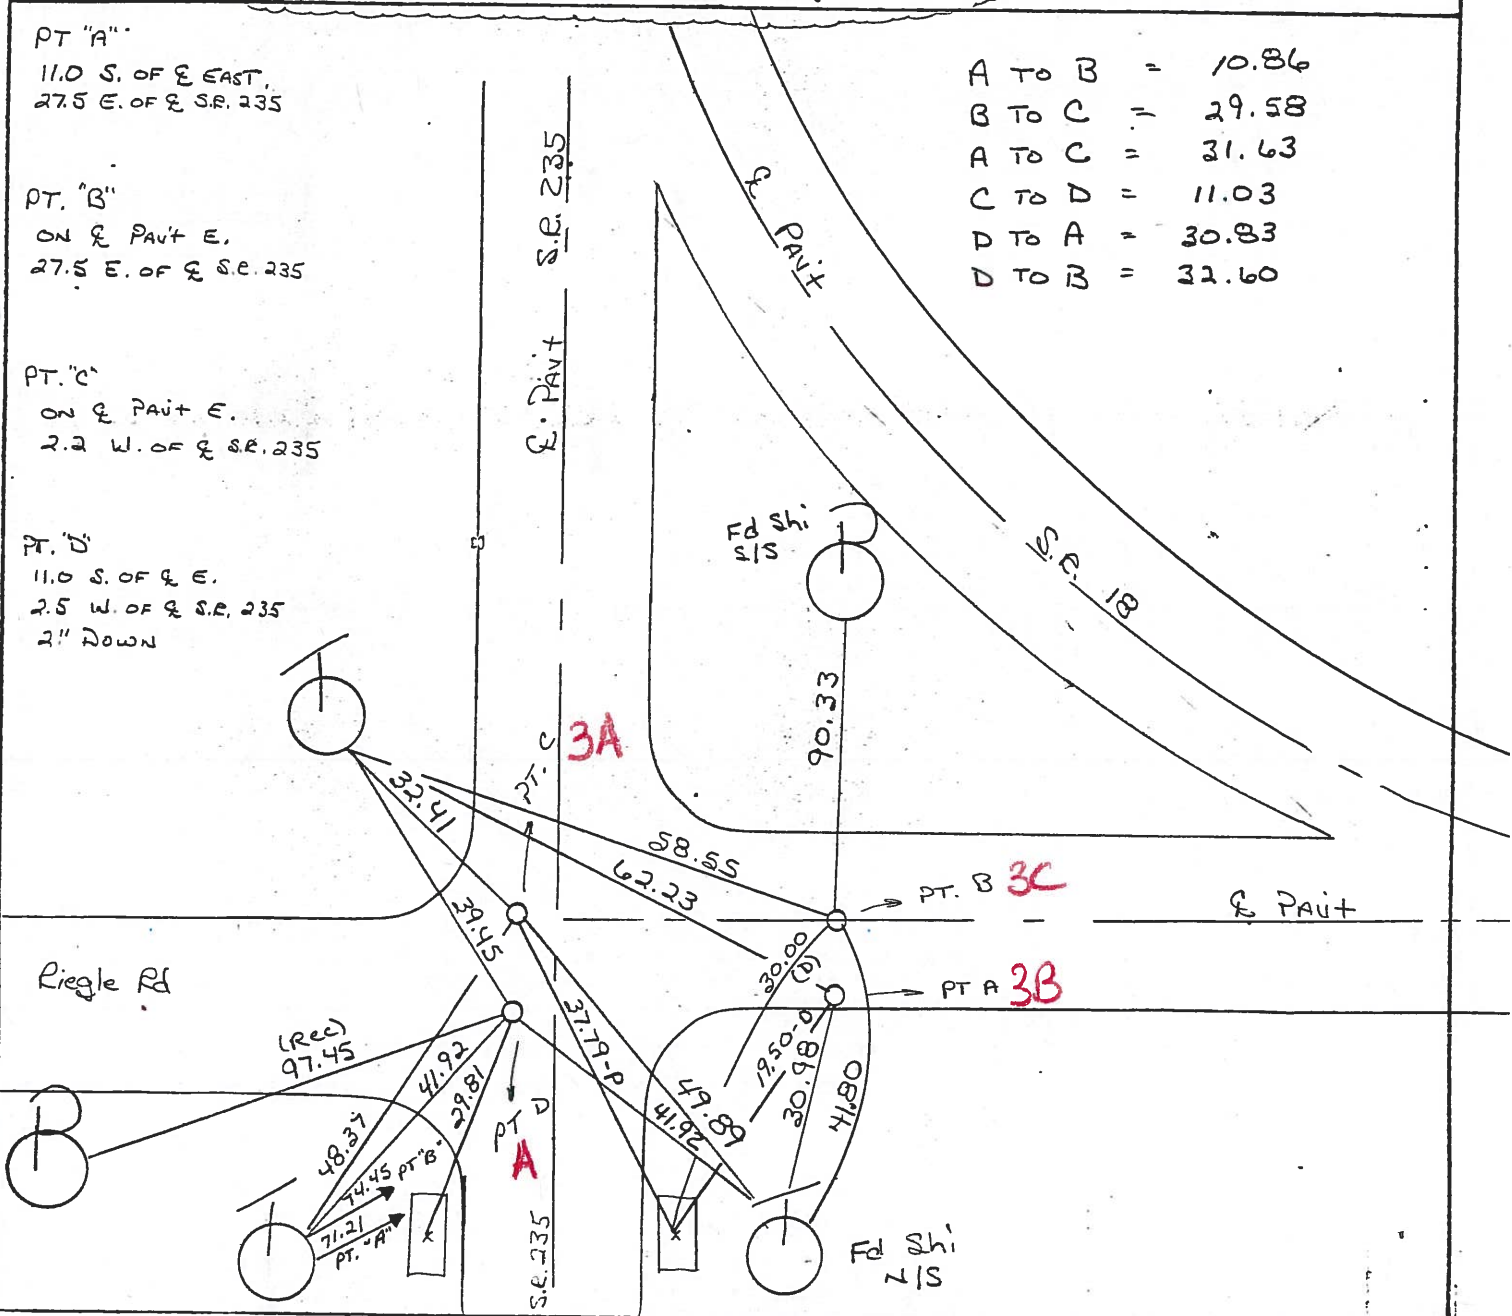

℄ "X" ON BOTH SIDES

Q.D.O.T. DISTRICT 2 SURVEY OFFICE

SHEET ~~13~~ OF

County WOOD S.R. 18

Township JACKSON

Section 26

T N, R E

Personnel BARNHISEL

HOUSEHOLDER


LOEHRE

#3

Date 11-28-83

Weather RAIN, CLOUDY

Temp. +40°

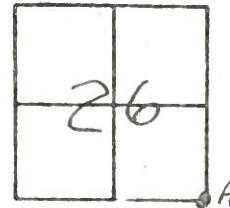


"A" RR SPIKE @ SURFACE OVER STONE
SLM 53+75 (SR 235)
10.9 S of & PAVT 18
27.1 E of & PAVT 235

"C" RR SPIKE @ SURFACE
SLM 53+86 (SR 235)
ON & PAVT SR 18 E
2.5' W of & PAVT 235

#15

"B" BOAT SPIKE @ SURFACE
SLM 53+86 (SR 235)
ON CL PAVT 18
27.1 E of & PAVT 235

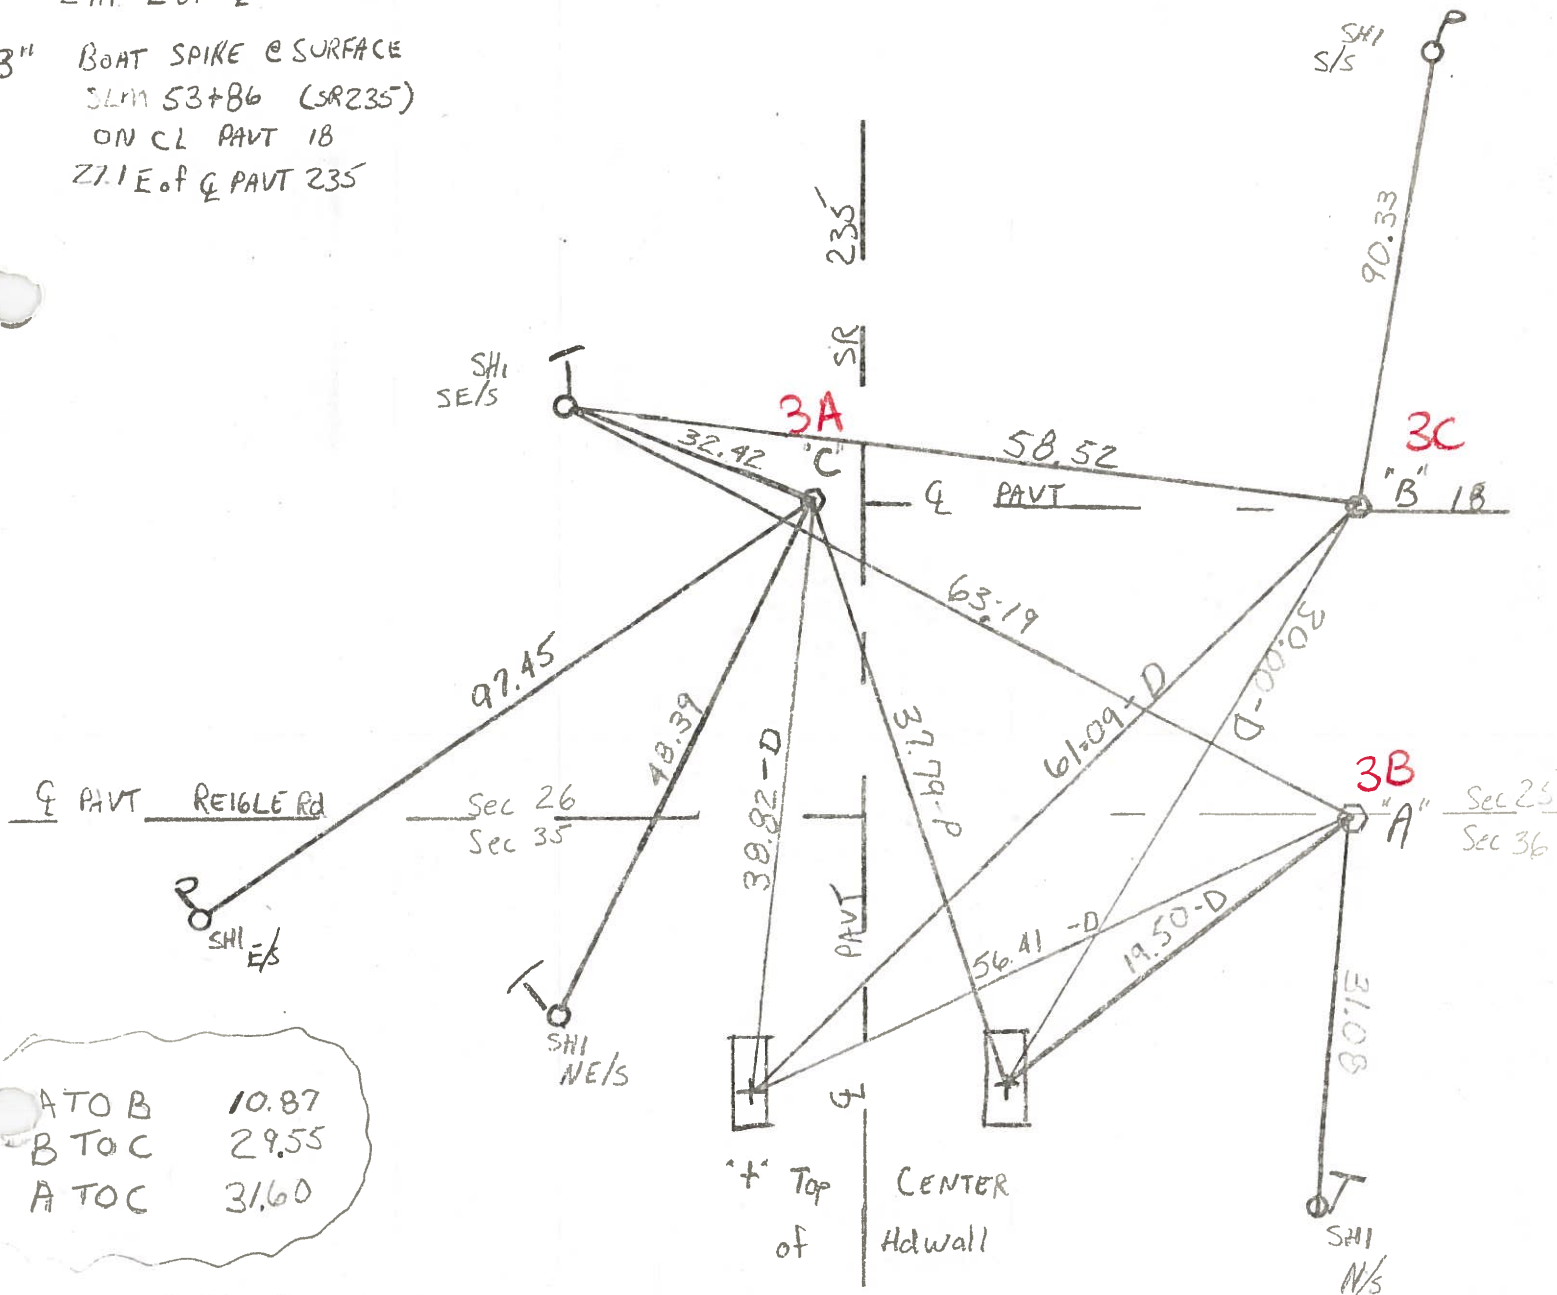

ATO B 10.87
B TO C 29.55
A TO C 31.60

COUNTY Wood DATE 5-1-72
S. R. 235 E 18 WEATHER SHOWERS

SEC. _____ TEMP. +62°

CONTROL POINTS @ S.R. 235 & S.R. 18

JOB NO. _____

