

O.D.O.T. DISTRICT 2 SURVEY OFFICE (USE ONLY)

PERSONNEL

REFERENCE NO. B 3

SHEET 4 OF 26

NOTES NIESE
H.C. NIESE
R.C. PRESTON-COLVIN

DATE 10/28/24
WEATHER CALM
TEMP. 42°

ROUTE SR 235
COUNTY WOOD
TOWNSHIP JACKSON
SECTION 25

DWG BY BARRIERE PID 101290

T 3 N R 9 E

TYPE MONUMENT MAG NAIL/WASHER

ON SURFACE - BELOW ON

OFFSET $\varnothing$ PAVEMENT 28.6' RT LT : RT

TO EDGE PAVEMENT

STATION: 53+77

HORIZ.DATUM: NAD83(2011)/WOOD LDP GEOID: 2018

GRID: NORTHING: 376284.612 EASTING: 127075.797


LDP: NORTHING: 554935.061 EASTING: 1615008.323

26	25
35	36



RECORD:
SW COR. SEC. 25
FD P.K./WASHER
OVER STONE
FD MAG/WASHER
5/6/04, RGN
SET MAG/WASHER
8/3/04, MC
FD MAG/WASHER
2" DOWN
REFB3
6/1/18, JLL
FD SM.R.R.SPIKE
1 1/2" DOWN
REFB3
4/27/21
9/16/21, JFO
1/11/23, JMR
FD SM RSPK
2" DOWN
REFB3
2/1/23, JAM
8/14/23, TDN
SET MAG/WASHER
10/28/24, TDN

NOTE: SR 18 REFC15

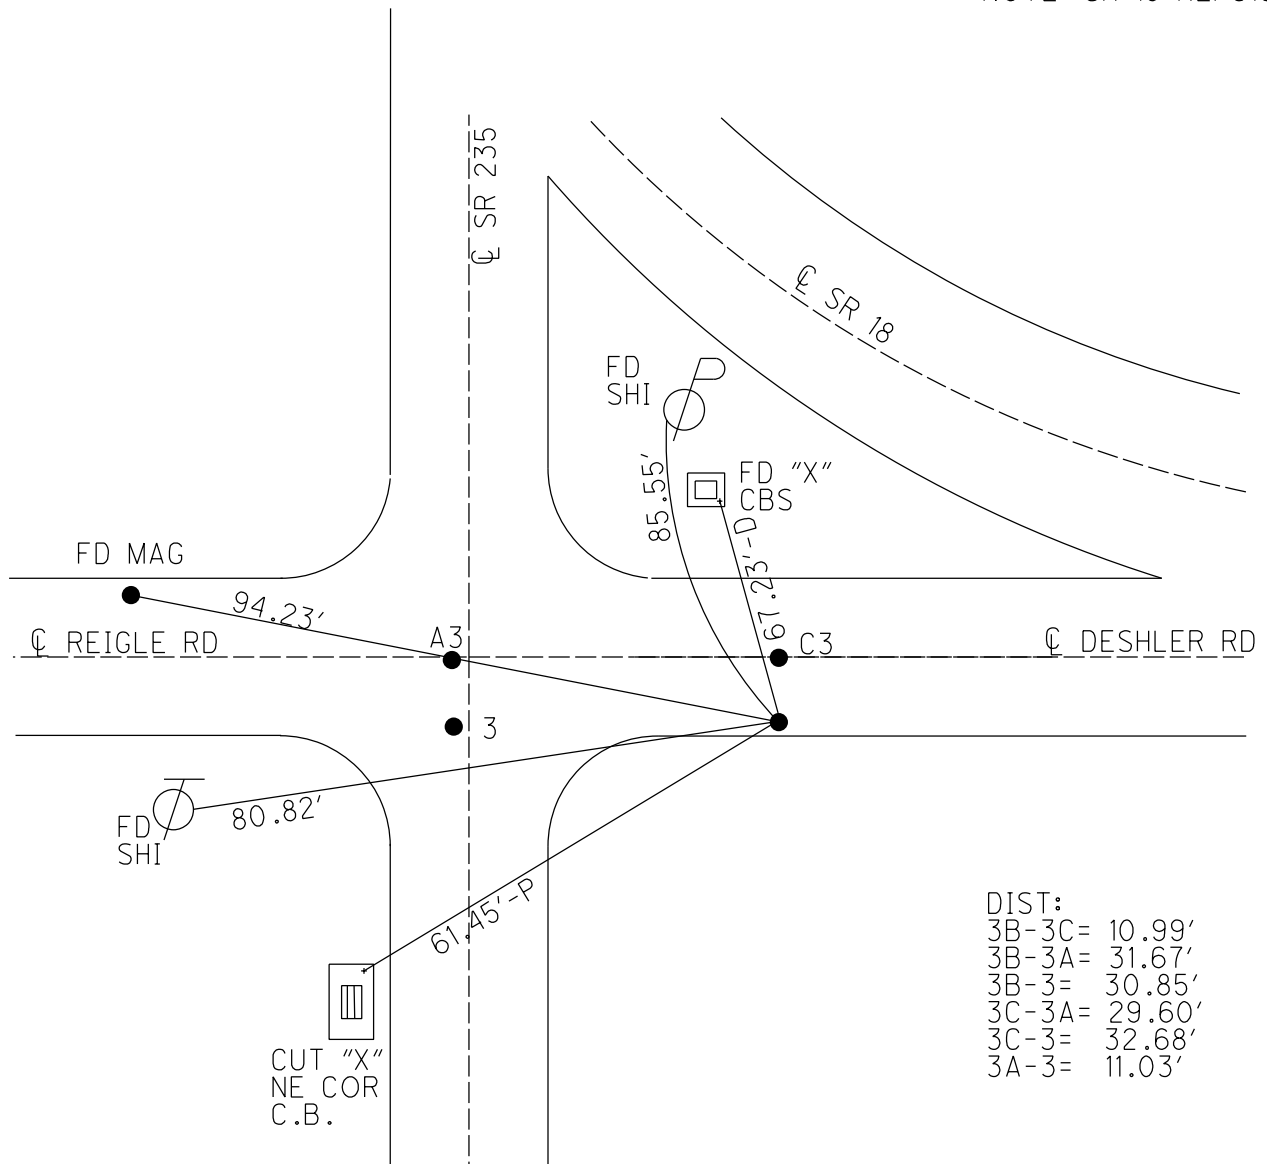

DIST:
3B-3C= 10.99'
3B-3A= 31.67'
3B-3= 30.85'
3C-3A= 29.60'
3C-3= 32.68'
3A-3= 11.03'

O.D.O.T. DISTRICT 2 SURVEY OFFICE (USE ONLY)

PERSONNEL

REFERENCE NO. 3 B

SHEET 7 OF 8

NOTES AUBLE

DATE 5-23-23

ROUTE SR 235

H.C. NIESE

WEATHER CALM

COUNTY WOOD

R.C. AUBLE

TEMP. 74° F

TOWNSHIP JACKSON

SECTION 25

DWG BY AUBLE

PID PAVETRAIN

T 3 N R 9 E

TYPE MONUMENT SM.R.R.SPIKE

~~ON SURFACE~~ - BELOW 1 1/2"

OFFSET Q PAVEMENT 28.6' ~~LT~~ : RT

- TO - EDGE PAVEMENT


STATION: 53+77

HORZ.DATUM: NAD83(2011)

GEOID: NAVD88 2018


GRID: NORTHING: 554935.061

EASTING: 1615008.323

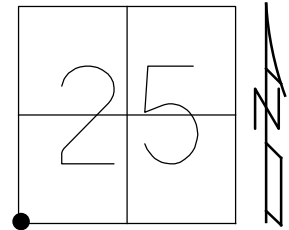

RECORD:
SW COR. SEC. 25
FD P.K./WASHER
OVER STONE
FD MAG/WASHER
5/6/04, RGN
SET MAG/WASHER
8/3/04, MC
FD MAG/WASHER
2" DOWN
REFB3
6/1/18, JLL
FD SM.R.R.SPIKE
1 1/2" DOWN
REFB3
4/27/21
9/16/21, JFO
1/11/23, JMR
FD SM RSPK
2" DOWN
REFB3
2/1/23, JAM
8/14/23, TDN

NOTE: SR 18 REF15C

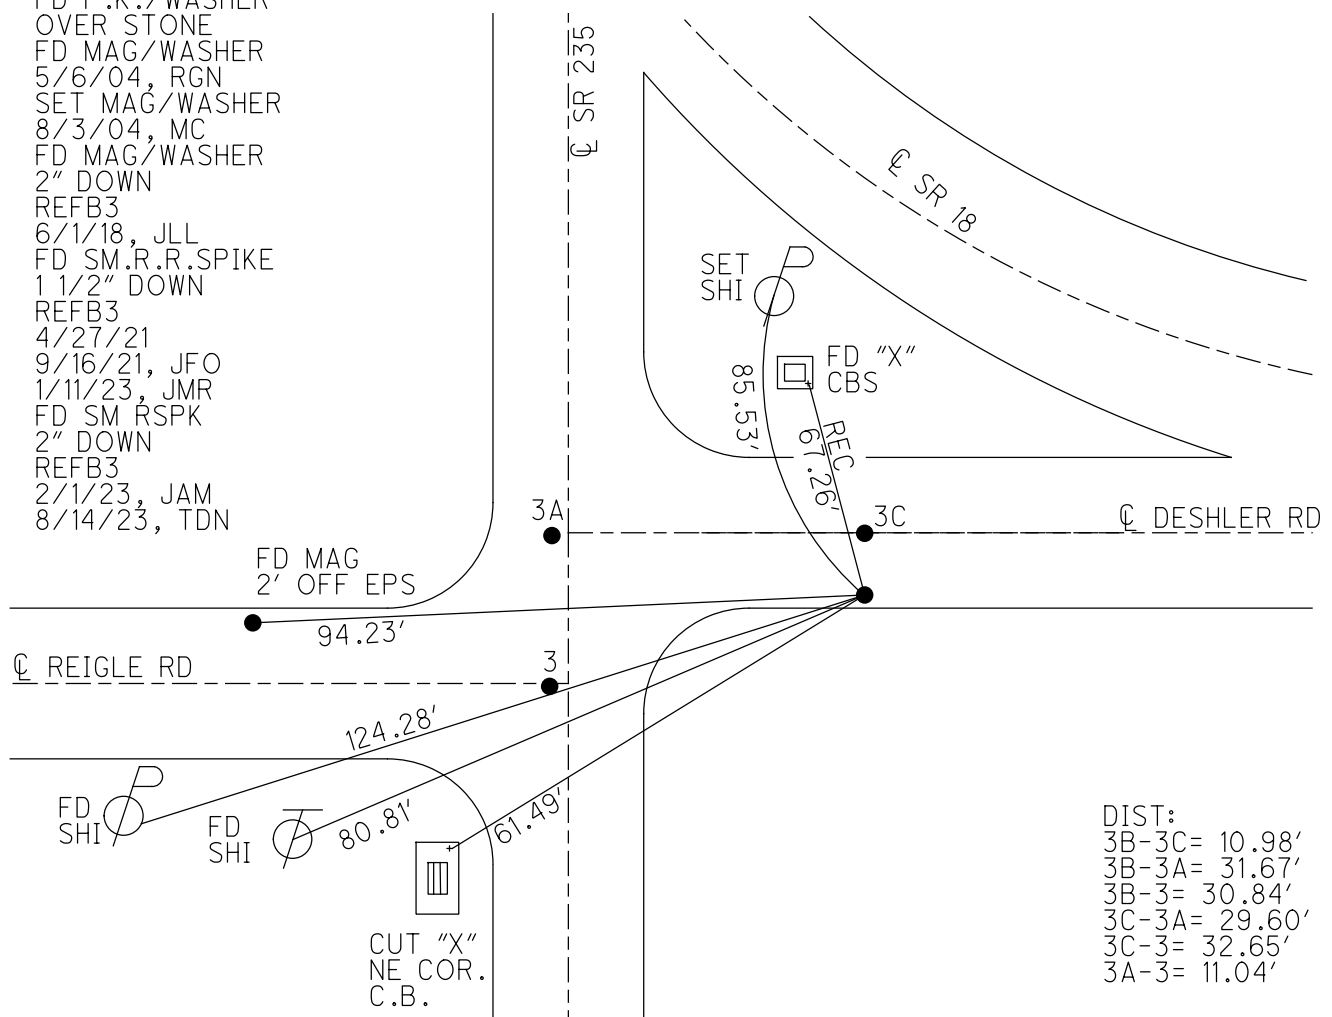

DIST:
3B-3C= 10.98'
3B-3A= 31.67'
3B-3= 30.84'
3C-3A= 29.60'
3C-3= 32.65'
3A-3= 11.04'

O.D.O.T. DISTRICT 2 SURVEY OFFICE (USE ONLY)

PERSONNEL

REFERENCE NO. 3 B

SHEET 7 OF 8

NOTES RHOADES

DATE 4-27-21

ROUTE SR 235

H.C. O'DONNELL

WEATHER WINDY

COUNTY WOOD

R.C. RHOADES

TEMP. 64° F

TOWNSHIP JACKSON

DWG BY AUBLE

PID PAVETRAIN

SECTION 25

T 3 N R 9 E

TYPE MONUMENT SM.R.R.SPIKE

~~ON SURFACE~~ - BELOW 1 1/2"

OFFSET CL PAVEMENT 28.6' ~~LT~~ : RT

- TO - EDGE PAVEMENT


STATION: 53+77

HORIZ.DATUM: NAD83(2011)


GEOID: NAVD88 2018

GRID: NORTHING: 554935.079

EASTING: 1615008.332

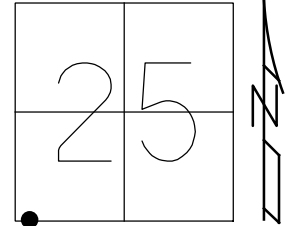

RECORD:
FD P.K./WASHER
OVER STONE
FD MAG/WASHER
5/6/04, RGN
SET MAG/WASHER
8/3/04, MC
FD MAG/WASHER
2" DOWN
REFB3
6/1/18, JLL
FD SM.R.R.SPIKE
1 1/2" DOWN
REFB3
4/27/21
9/16/21, JFO
1/11/23, JMR

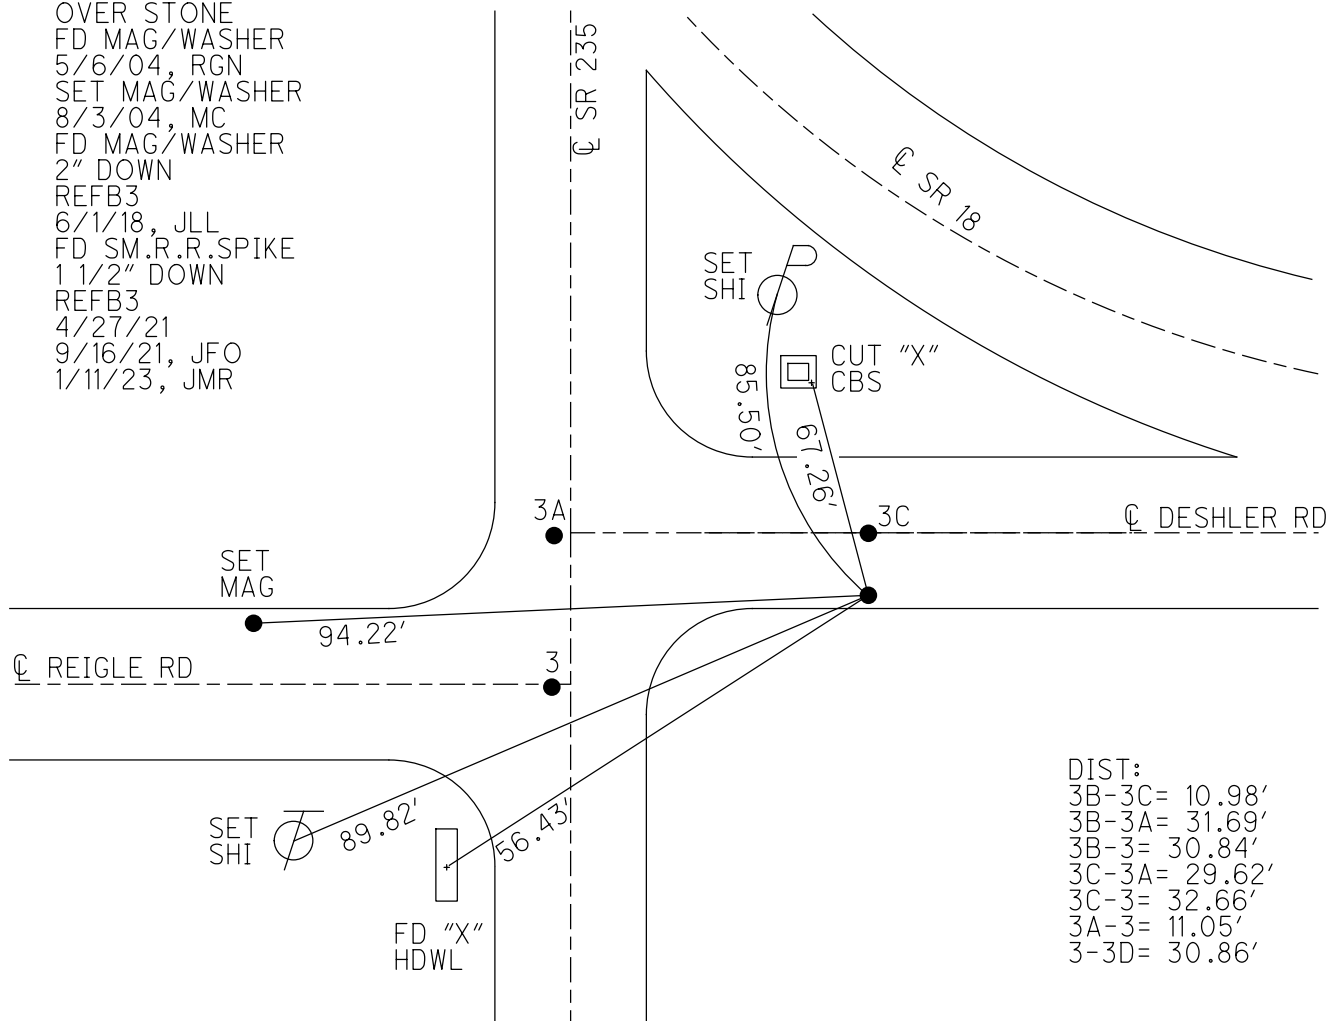

DIST:
3B-3C= 10.98'
3B-3A= 31.69'
3B-3= 30.84'
3C-3A= 29.62'
3C-3= 32.66'
3A-3= 11.05'
3-3D= 30.86'

O.D.O.T. DISTRICT 2 SURVEY OFFICE (USE ONLY)

PERSONNEL

REFERENCE NO. 3 B

SHEET 7 OF 8

NOTES RHOADES

DATE 4-27-21

ROUTE SR 235

H.C. O'DONNELL

WEATHER WINDY

COUNTY WOOD

R.C. RHOADES

TEMP. 64° F

TOWNSHIP JACKSON

SECTION 25

DWG BY AUBLE PID PAVETRAIN

T 3 N R 9 E

TYPE MONUMENT SM.R.R.SPIKE

~~ON SURFACE~~ - BELOW 1 1/2"

OFFSET CL PAVEMENT 28.6' ~~LT~~ : RT

- TO - EDGE PAVEMENT


STATION: 53+77

HORZ.DATUM: NAD83(2011)


GEOID: NAVD88 2018

GRID: NORTHING: 554935.079

EASTING: 1615008.332

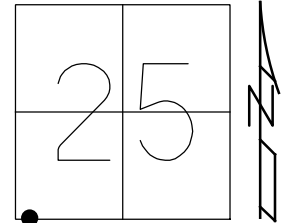

RECORD:
FD P.K./WASHER
OVER STONE
FD MAG/WASHER
5/6/04, RGN
SET MAG/WASHER
8/3/04, MC
FD MAG/WASHER
2" DOWN
REFB3
6/1/18, JLL
FD SM.R.R.SPIKE
1 1/2" DOWN
REFB3
4/27/21
9/16/21, JFO

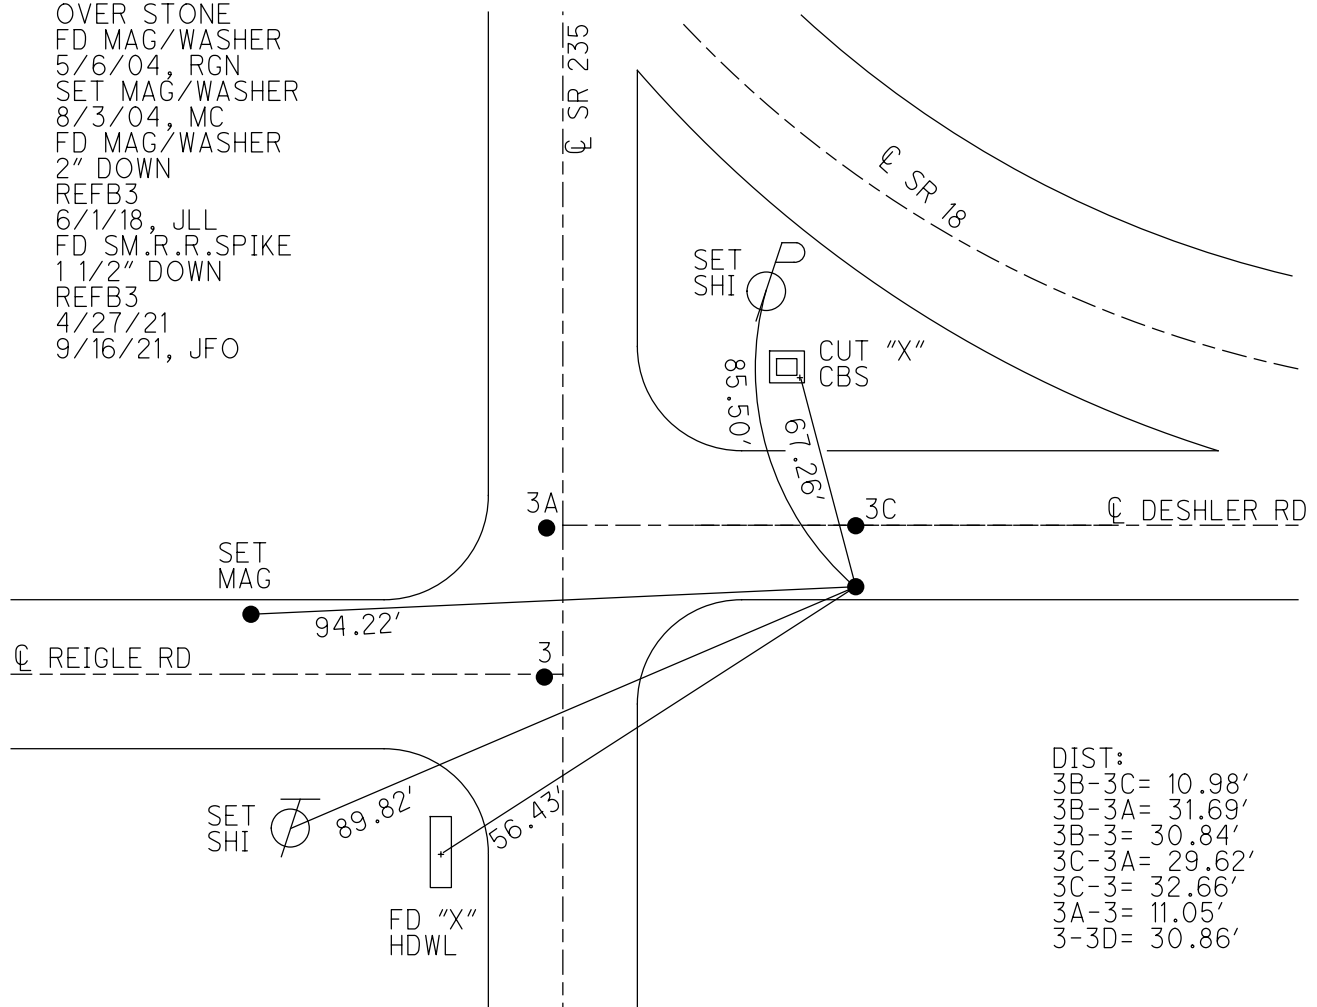


DIST:
3B-3C= 10.98'
3B-3A= 31.69'
3B-3= 30.84'
3C-3A= 29.62'
3C-3= 32.66'
3A-3= 11.05'
3-3D= 30.86'

O.D.O.T. DISTRICT 2 SURVEY OFFICE (USE ONLY)

PERSONNEL _____ REFERENCE NO. 3 B SHEET 7 OF 8

NOTES NUHFER DATE 5-06-04 ROUTE SR 235
H.C. CANERBURY WEATHER SUNNY COUNTY WOOD
R.C. ARMS TEMP. 65°F TOWNSHIP JACKSON
SECTION 25
T 3 N R 9 E

TYPE MONUMENT MAG/WASHER
ON SURFACE - ~~BELOW~~ ON _____
~~LEFT~~ - ℄ PAV'T - RIGHT 27.5'
- TO - EDGE PAVEMENT
S.L.M. 53+77

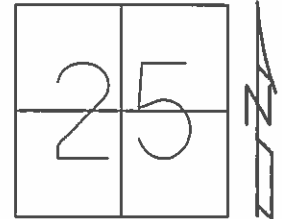


Grid: Northing: 554935.000 Easting: 1615008.353

RECORD:
OVER STONE

PK SHINER@SURFACE
11.0 S. OF ℄ EAST
27.5 E. OF ℄ S.R. 235

SET MAG/WASHER
ALL FOUR POINTS
08-03-04, MC

REF 3B TO REF 3C = 10.99'
REF 3B TO REF 3A = 31.68'
REF 3B TO REF 3 = 30.84'
REF 3C TO REF 3A = 29.60'
REF 3C TO REF 3 = 32.65'
REF 3A TO REF 3 = 11.05'

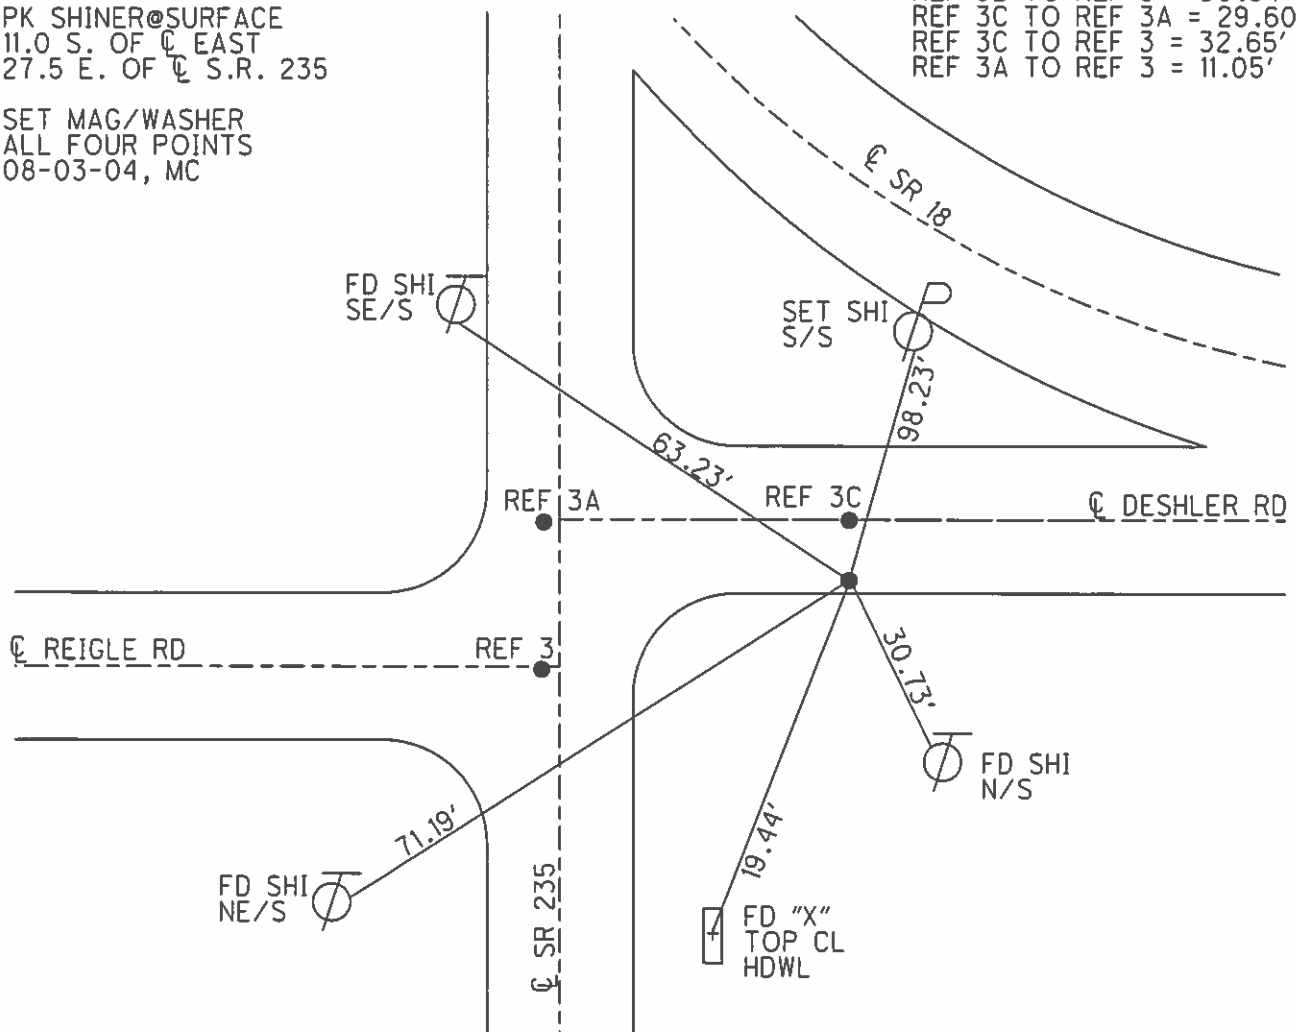

FD "X"
TOP CL
HDWL

O.D.O.T. DISTRICT 2 SURVEY OFFICE

PERSONNEL

REFERENCE NO. 3

SHEET 5 OF 5

NOTES NUHFER

DATE 5-06-04

ROUTE S.R. 235
S.R. 18

H.C. CANTERBURY

WEATHER SUN

COUNTY WOOD

R.C. ARMS

TEMP. +65°

TOWNSHIP JACKSON

SECTION 26

T 3 N R 9 E

TYPE MONUMENT P.K. / WASHER
PT "D" 1/2" IPIN>>

ON SURFACE YES

LEFT-Q PAV'T-RIGHT INFO. BELOW

TO EDGE PAVEMENT

S.L.M. PT "D" 53+90

26	25
35	36



RECORD: PT "A"
OVER STONE

PT "A" **3B**
PK SHINER@SURFACE
11.0 S. OF Q EAST
27.5 E. OF Q S.R. 235


PT "B" **3C**
PK SHINER@2"DOWN
ON Q PAVEMENT EAST
27.5 E. OF Q S.R.235

PT "C" **3A**
PK WASHER@2"DOWN
ON Q OF PAVEMENT EAST
2.2 LT. OF Q S.R. 235

PT "D" **3**
PK WASHER @SURFACE
11.0 S. OF Q EAST
2.5 LT. OF Q S.R. 235
ON CL WEST

RESET MAGS & WASHERS
ALL FOUR POINTS
08-03-04
MC

REIGLE ROAD

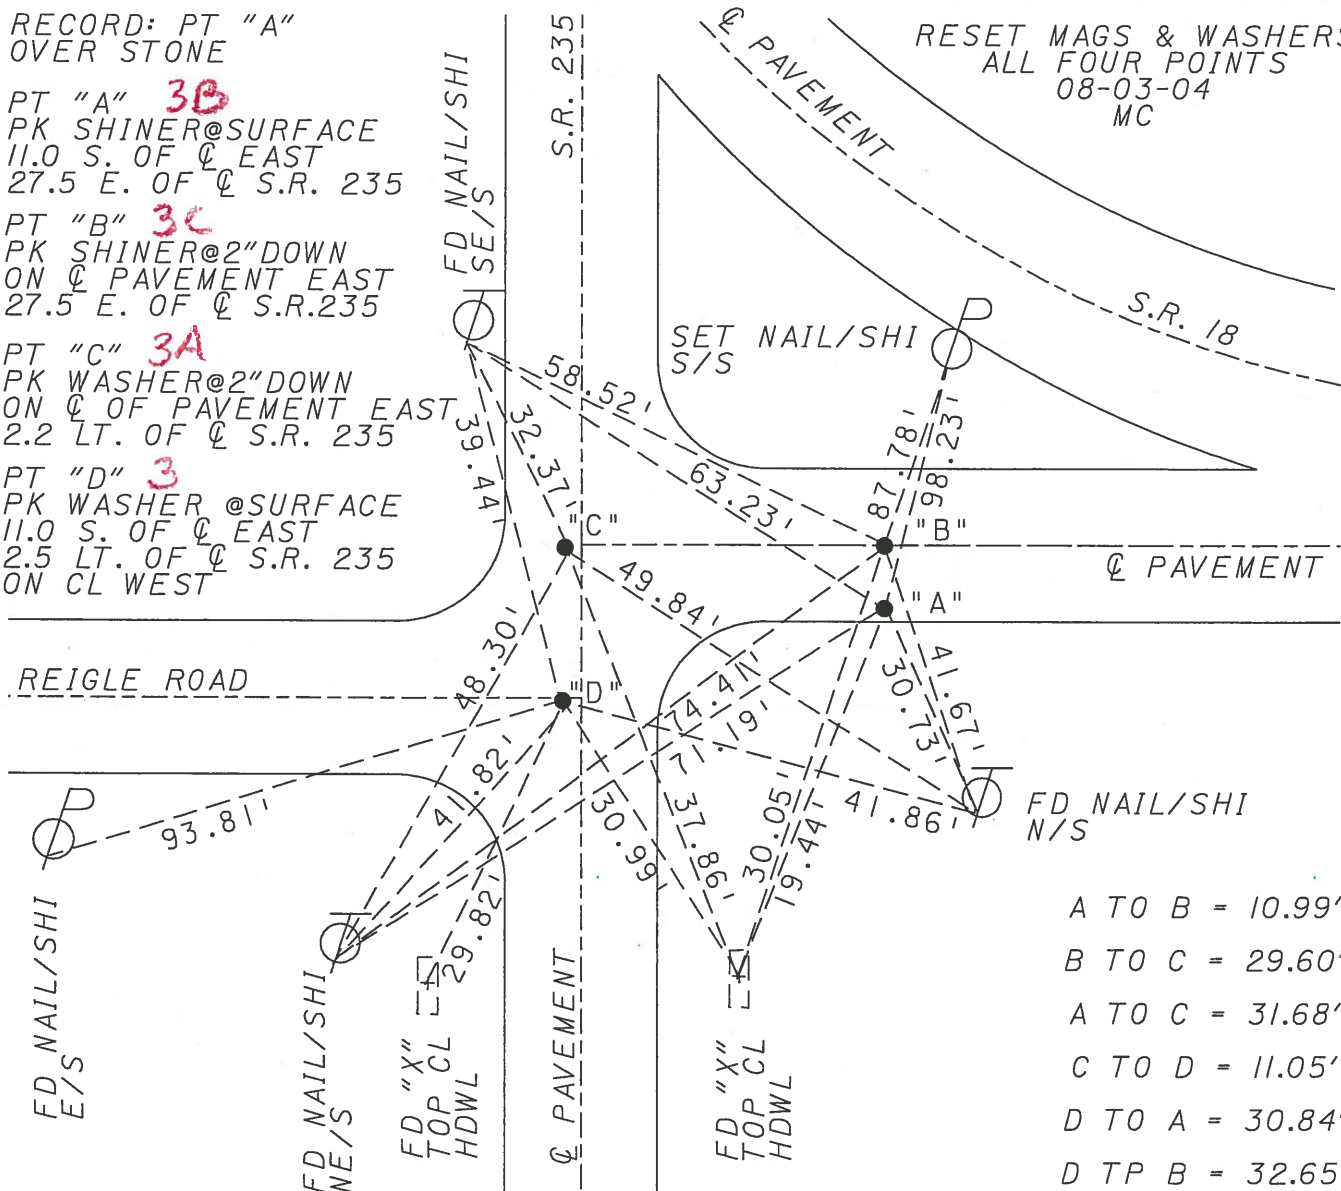

A TO B = 10.99'
B TO C = 29.60'
A TO C = 31.68'
C TO D = 11.05'
D TO A = 30.84'
D TP B = 32.65'

O.D.O.T. DISTRICT 2 SURVEY OFFICE

PERSONNEL

REFERENCE NO. 3

SHEET 3 OF 3

NOTES OTTO

H.C. Kusz

R.C. BARNHISEL

DATE 7-21-93

WEATHER cloudy

TEMP. +72°

ROUTE SR 18


COUNTY *WOOD*

TOWNSHIP Jackson

SECTION 26

T3 NR 9 E

TYPE MONUMENT PK'S + WASHERS / PT "D" 1/2" I. PIN
ON SURFACE - BELOW yes 2 1/2" Down
LEFT - CL PAV'T. - RIGHT INFO. BELOW
- TO - EDGE PAVEMENT
S.L.M. PT "D" 53+90

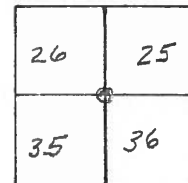

RECORD: PT "A")
OVER STONE }


PT "A" 3B
11.0 S. OF E EAST
27.5 E. OF E S.R. 235

PT "B" 3C
ON E PAUL EAST
27.5 E. OF E S.R. 235

PT "C" 3A
ON E OF PAUL EAST
2.2 LT OF E S.R. 235

PT "D" 3
11.0 S. OF E EAST
2.5 LT OF E S.R. 235
2 1/2" DOWN

Reset PK'S & WASHER
ALL FOUR POINTS
10-27-93
MB

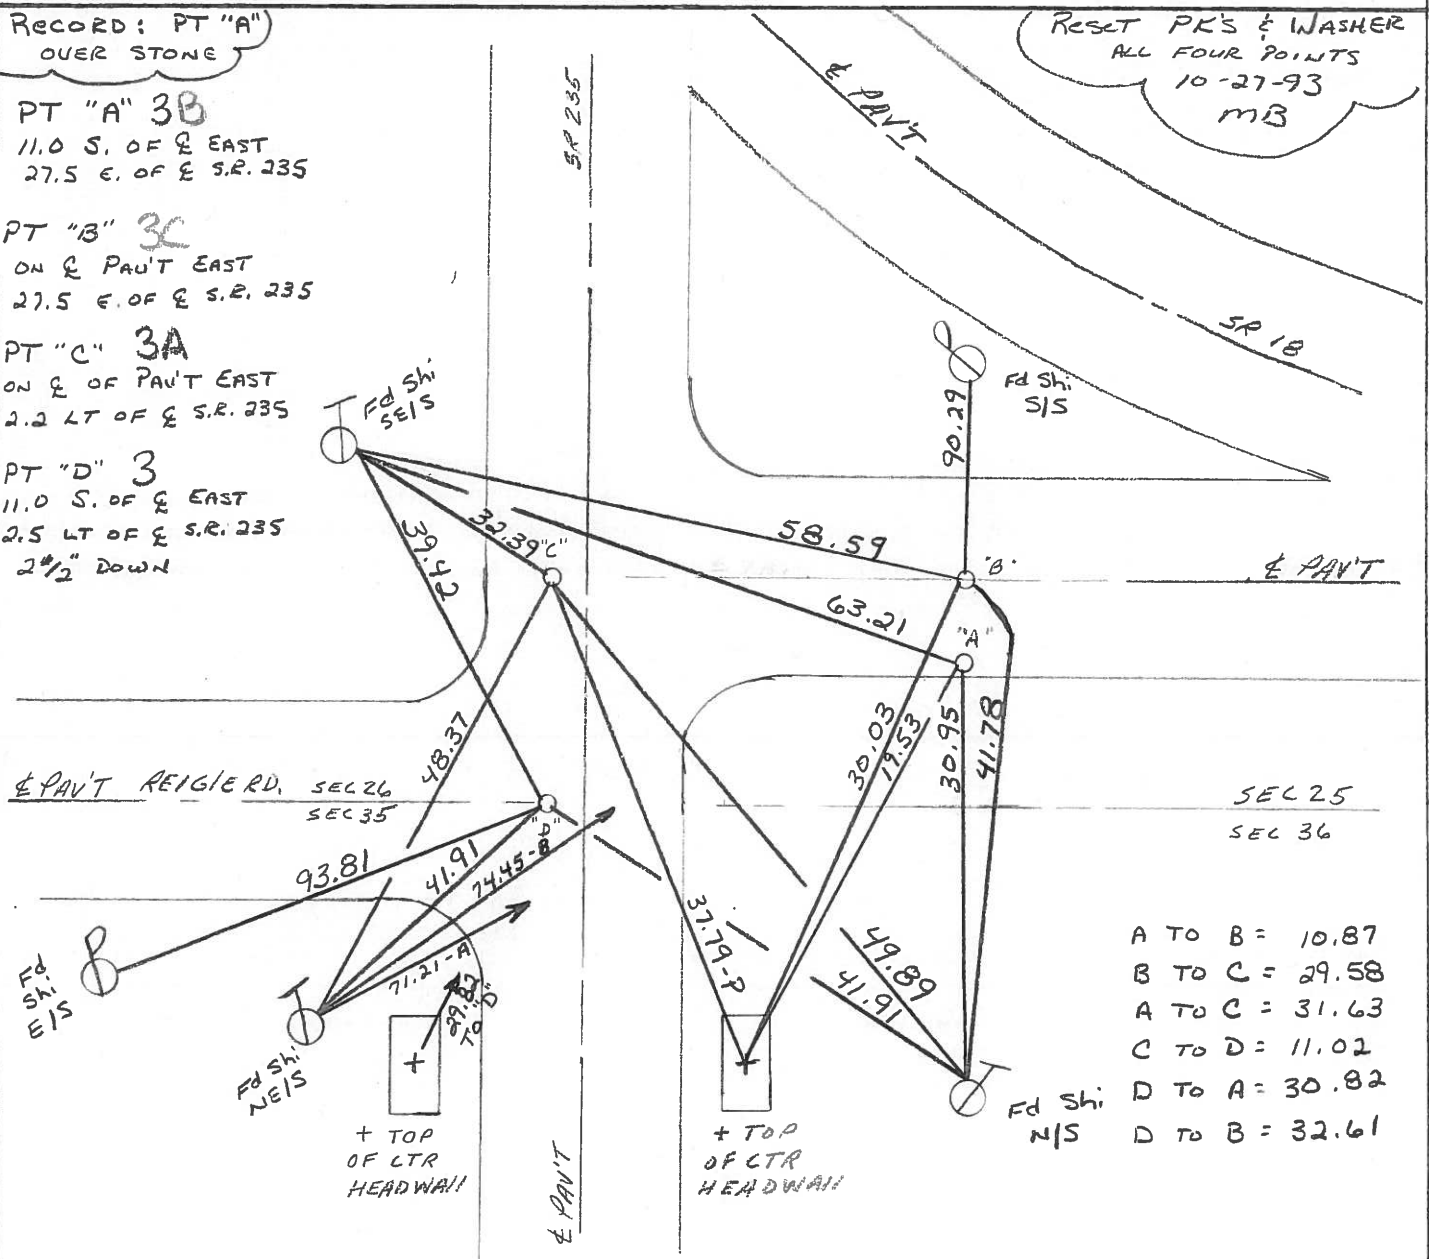

A TO B = 10.87
B TO C = 29.58
A TO C = 31.63
C TO D = 11.02
D TO A = 30.82
D TO B = 32.61

O.D.O.T. DISTRICT 2 SURVEY OFFICE

PERSONNEL

REFERENCE NO. 15

SHEET OF

NOTES BARNHISEL

H.C. Loehake

DATE 3-19-91

ROUTE 18 & 235

R.C. HOFFMAN

WEATHER cloudy - Windy

COUNTY Wood

TEMP. +45°


TOWNSHIP JACKSON

SECTION 26

T 3 N R 9 E

TYPE MONUMENT P.K.'s & Washers
ON SURFACE - BELOW YES (ALL)
LEFT - ℄ PAV'T. - RIGHT Information Below
- TO - EDGE PAVEMENT

PT. "D"
1/2" IRON PIN
1 1/2" DOWN

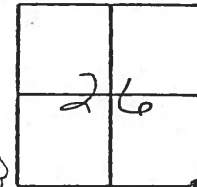

S.L.M. NOT COVERED IN 1991 RESURFACING OF S.R. 18


PT. "A"
11.0 S. OF & EAST,
27.5 E. OF & S.R. 235

A TO B = 10.86
B TO C = 29.58
A TO C = 31.63
C TO D = 11.03
D TO A = 30.83
D TO B = 32.60

PT. "B"
ON & PAVT E.
27.5 E. OF & S.R. 235

PT. "C"
ON & PAVT E.
2.2 W. OF & S.R. 235

PT. "D"
11.0 S. OF & E.
2.5 W. OF & S.R. 235
2" DOWN

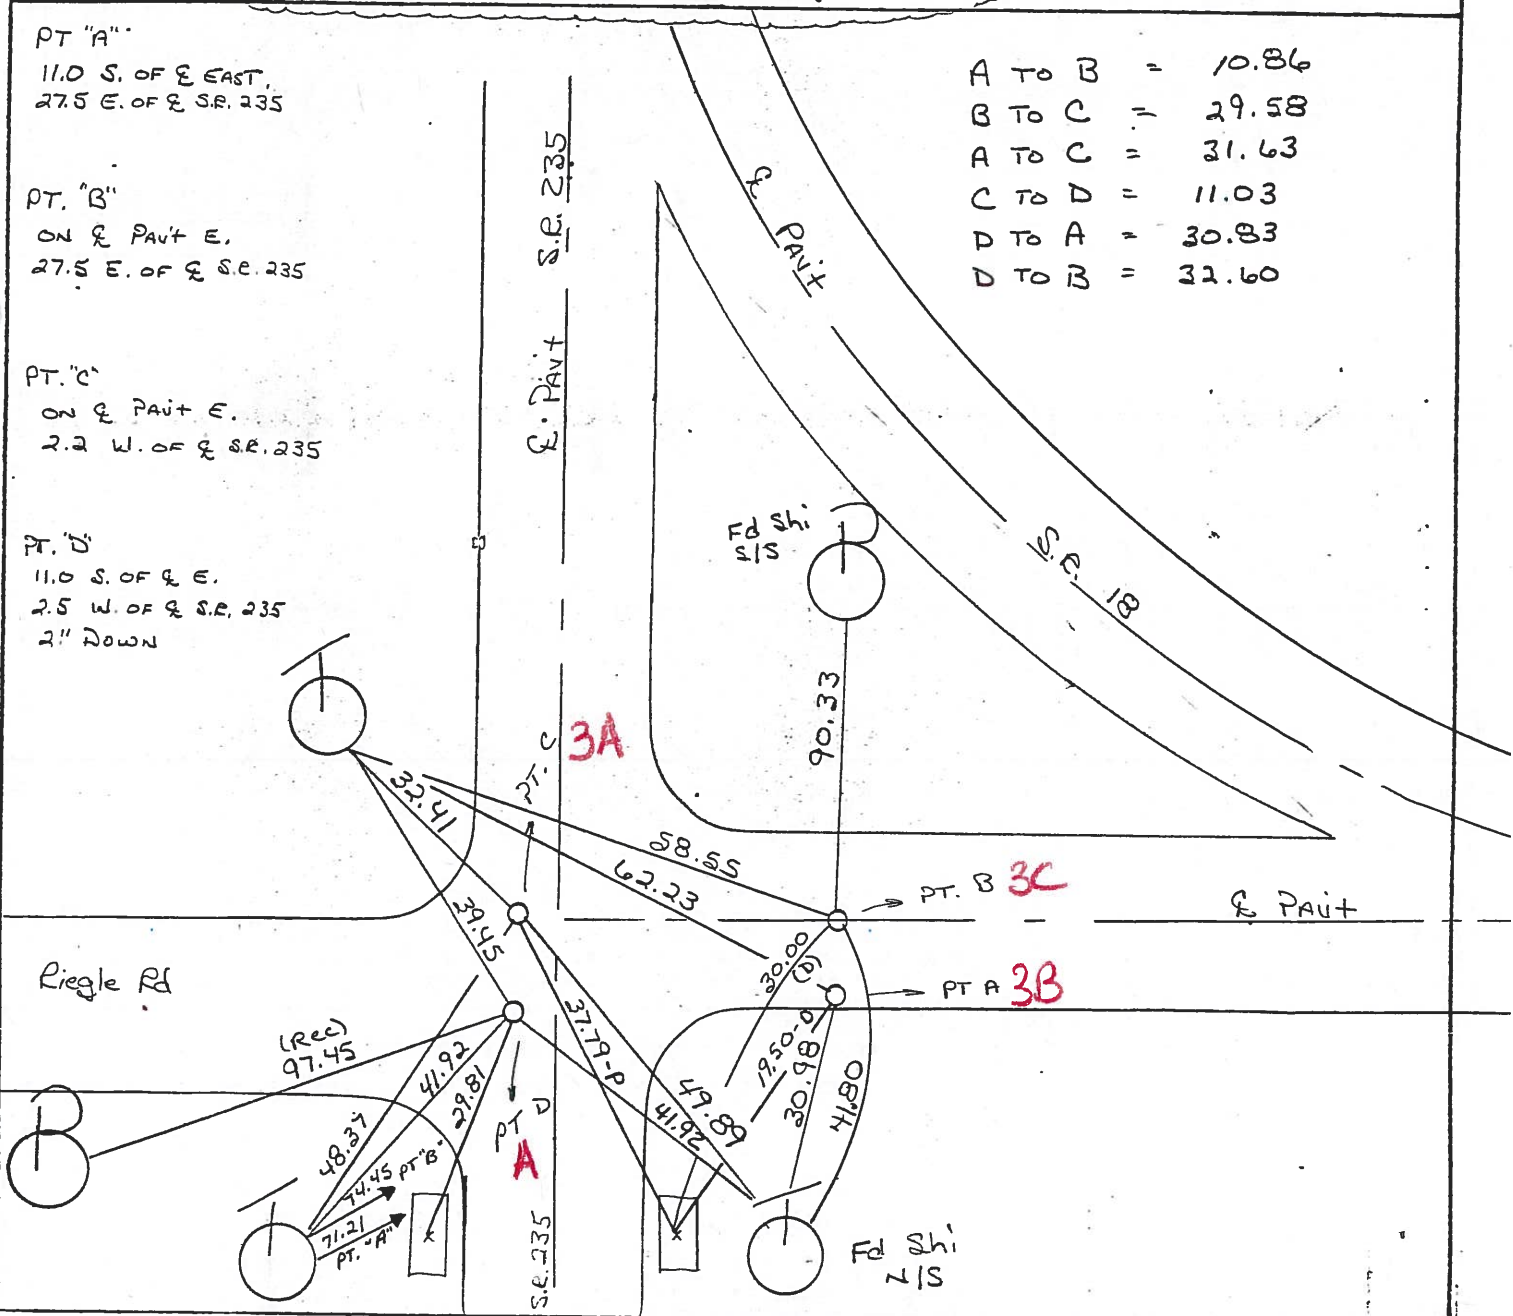

Ed "X" ON BOTH SIDES

Q.D.O.T. DISTRICT 2 SURVEY OFFICE

SHEET ~~13~~ OF

County WOOD S.R. 18

Township JACKSON

Section 26

T N, R E

Personnel BARNHISEL

HOUSEHOLDER


LOEHKE

#3

Date 11-28-83

Weather RAIN, CLOUDY

Temp. +40°

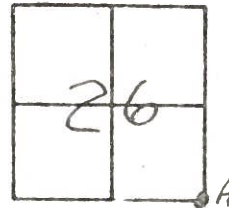


"A" RR SPIKE @ SURFACE OVER STONE
SLM 53+75 (SR 235)
10.9 S of & PAVT 18 #45
27.1 E of & PAVT 235

"C" RR SPIKE @ SURFACE
SLM 53+86 (SR 235)
ON & PAVT SR 18 E
2.5' W of & PAVT 235

#15

"B" BOAT SPIKE @ SURFACE
SLM 53+86 (SR 235)
ON CL PAVT 18
27.1 E of & PAVT 235

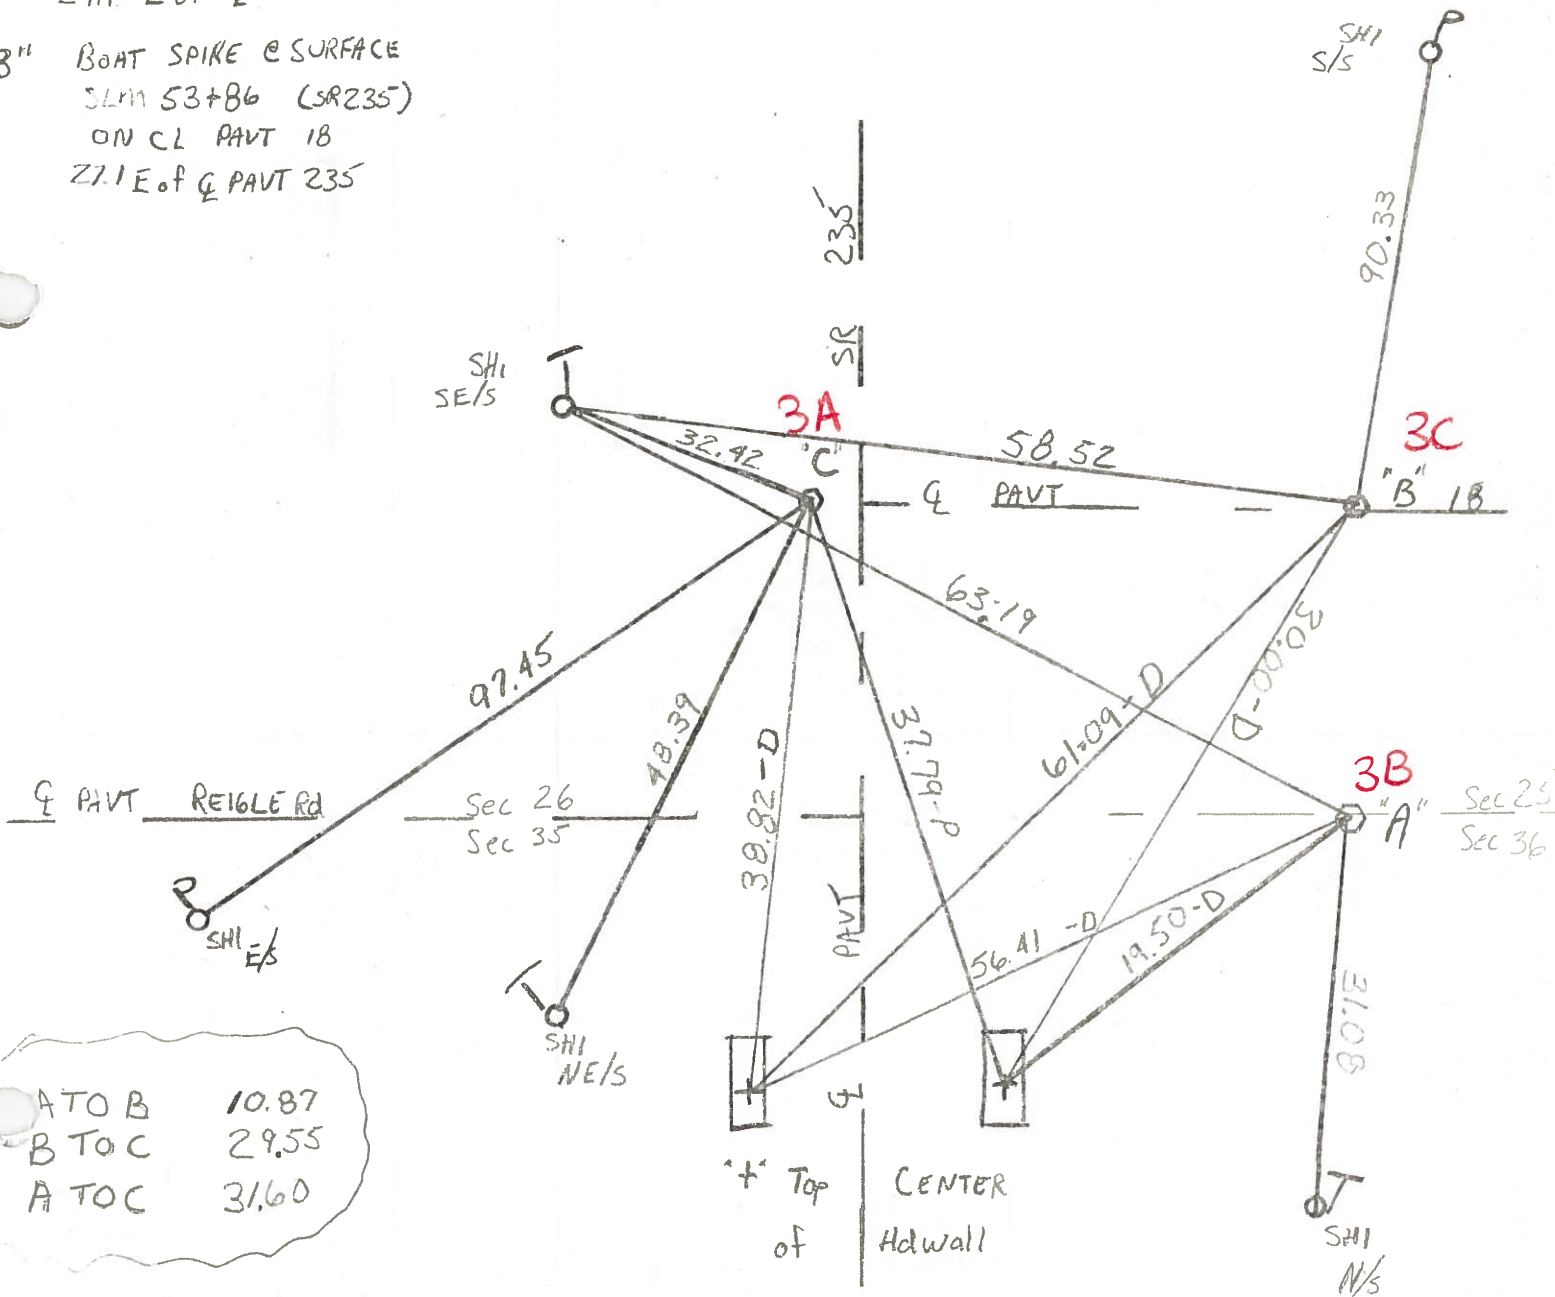

ATO B 10.87
B TO C 29.55
A TO C 31.60

PERSONNEL	TITLE	PERSONNEL	TITLE
BURNSIDE			
SMITH			
BOWERS			
MEAD			

COUNTY WOOD DATE 12-8-75

S. R. 235 WEATHER CLOUDY

SEC. S.E. COR SEC. 26 JACKSON TWP TEMP. + 36°

DESCRIPTION CONTROL TIES @ S.R. 235 & S.R. 18 JOB NO. _____

