

O.D.O.T. DISTRICT 2 SURVEY OFFICE (USE ONLY)

PERSONNEL

REFERENCE NO. C 3

SHEET 4 OF 26

NOTES NIESE
H.C. NIESE
R.C. PRESTON-COLVIN

DATE 10/28/24
WEATHER CALM
TEMP. 42°

ROUTE SR 235
COUNTY WOOD
TOWNSHIP JACKSON
SECTION 25

DWG BY BARRIERE PID 101290

T 3 N R 9 E

TYPE MONUMENT MAG NAIL/WASHER

ON SURFACE - BELOW ON

OFFSET Q PAVEMENT 27.5' RT LT : RT

TO EDGE PAVEMENT

STATION: 53+87

HORIZ.DATUM: NAD83(2011)/WOOD LDP GEOID: 2018

GRID: NORTHING: 376284.612 EASTING: 127075.797


LDP: NORTHING: 554935.061 EASTING: 1615008.323

26	25
35	36



RECORD:
FD P.K./WASHER
2" DOWN
FD MAG/WASHER
5/6/04, RGN
SET MAG/WASHER
8-3-04, MC
SET MAG/WASHER
REFC3
6/1/18, JLL
FD MAG/WASHER
REFC3
4-27-21
9-16-21, JFO
1/11/23, JMR
2/1/23, JAM
8/14/23, TDN
SET MAG/WASHER
10/28/24, TDN

NOTE: SR 18 REFB15

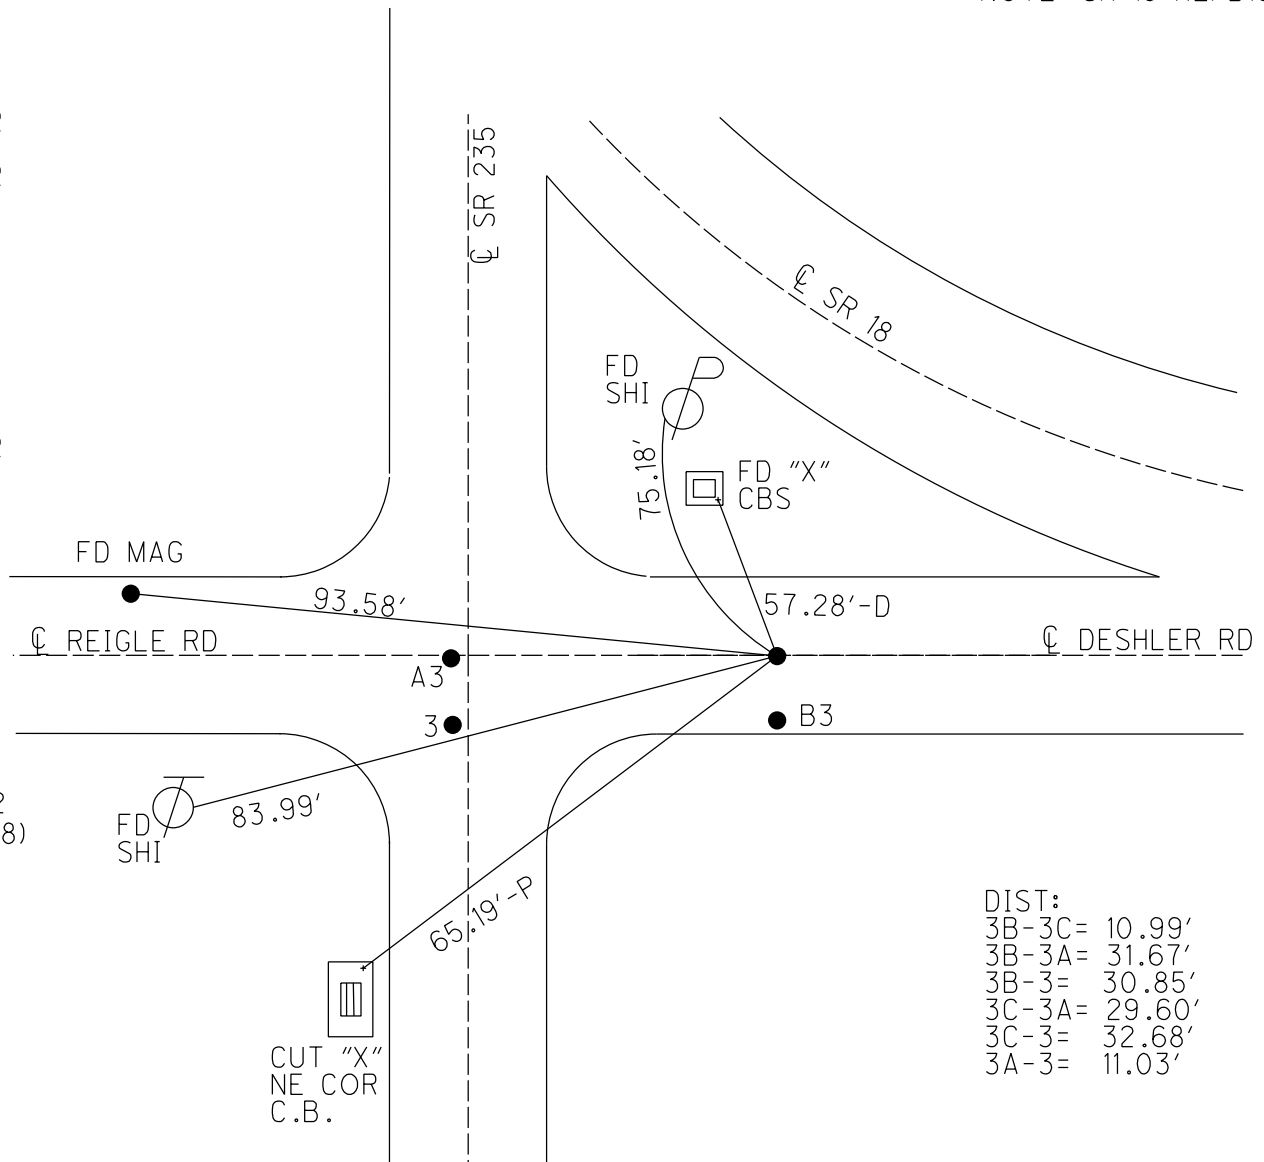

RECORD: P.I.
REC STA. 346+42
1927 PLANS (SR-18)
 $\Delta = 90^\circ 39'$
D = $19^\circ 0'$
R = 302.943
T = 306.423
L = 477.105
E = 127.932

DIST:
3B-3C= 10.99'
3B-3A= 31.67'
3B-3= 30.85'
3C-3A= 29.60'
3C-3= 32.68'
3A-3= 11.03'

O.D.O.T. DISTRICT 2 SURVEY OFFICE (USE ONLY)

PERSONNEL

REFERENCE NO. 3 C

SHEET 8 OF 8

NOTES AUBLE

DATE 5-23-23

ROUTE SR 235

H.C. NIESE

WEATHER CALM

COUNTY WOOD

R.C. AUBLE

TEMP. 74° F

TOWNSHIP JACKSON

SECTION 25

DWG BY AUBLE

PID PAVETRAIN

T 3 N R 9 E

TYPE MONUMENT MAG/WASHER

ON SURFACE - ~~BELOW~~ ON

OFFSET Q PAVEMENT 27.5' ~~LT~~ : RT

- TO - EDGE PAVEMENT


STATION: 53+87

HORZ.DATUM: NAD83(2011)

GEOID: NAVD88 2018


GRID: NORTHING: 554946.037

EASTING: 1615008.286

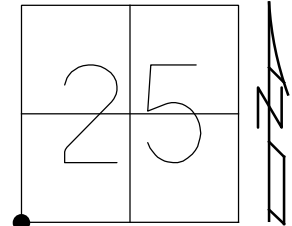

RECORD:
FD P.K./WASHER
2" DOWN
FD MAG/WASHER
5/6/04, RGN
SET MAG/WASHER
8-3-04, MC
SET MAG/WASHER
REFC3
6/1/18, JLL
FD MAG/WASHER
REFC3
4-27-21
9-16-21, JFO
1/11/23, JMR
2/1/23, JAM
8/14/23, TDN

NOTE: SR 18 REF15B

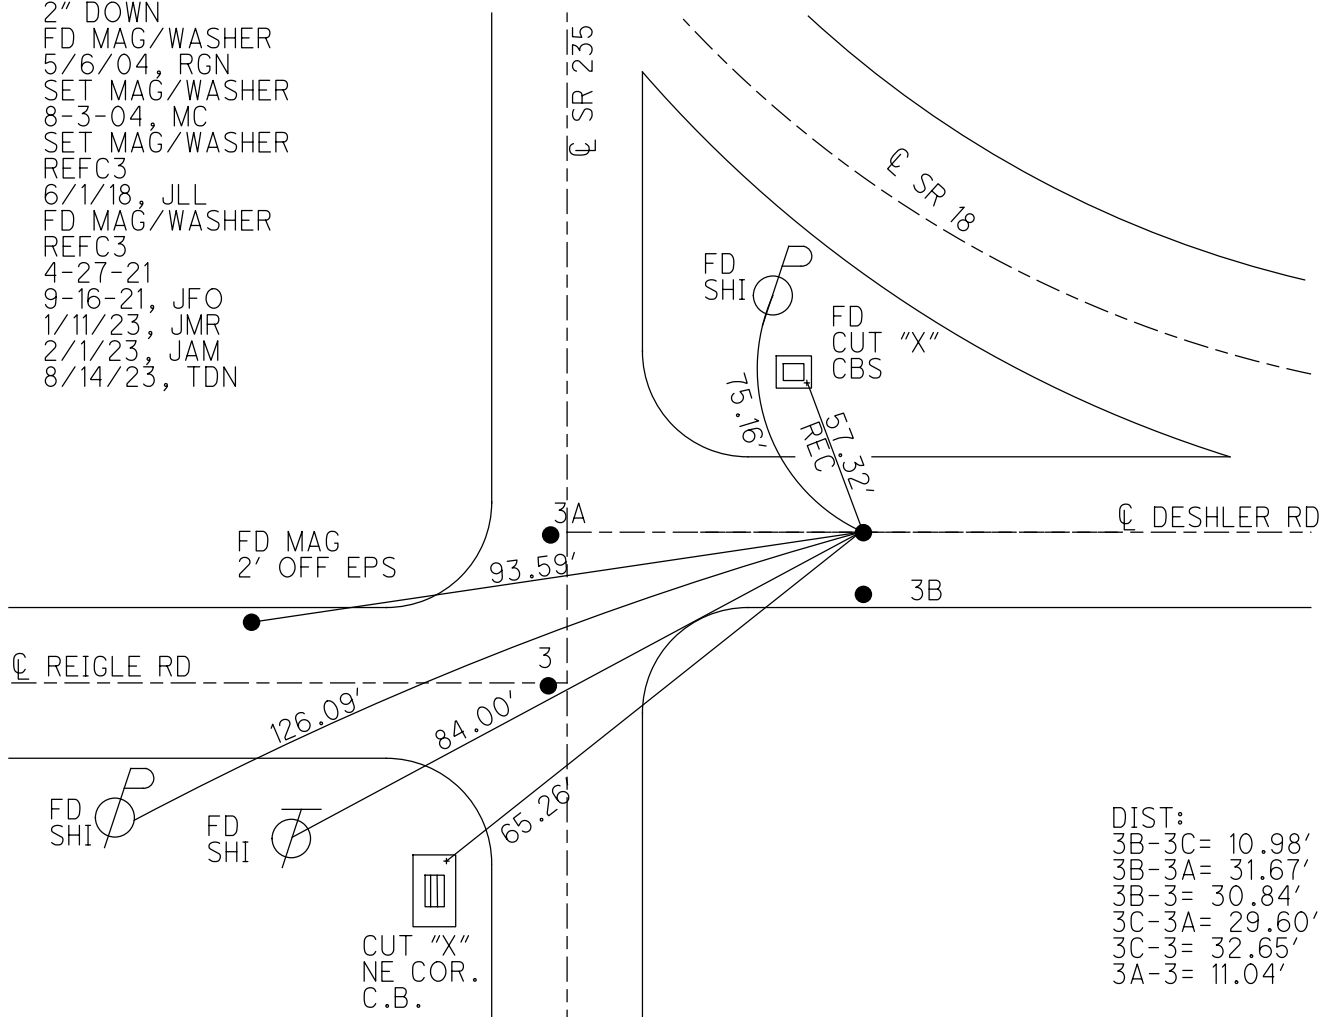

DIST:
3B-3C= 10.98'
3B-3A= 31.67'
3B-3= 30.84'
3C-3A= 29.60'
3C-3= 32.65'
3A-3= 11.04'

O.D.O.T. DISTRICT 2 SURVEY OFFICE (USE ONLY)

PERSONNEL

REFERENCE NO. 3 C

SHEET 8 OF 8

NOTES RHOADES

DATE 4-27-21

ROUTE SR 235

H.C. O'DONNELL

WEATHER WINDY

COUNTY WOOD

R.C. RHOADES

TEMP. 64° F

TOWNSHIP JACKSON

SECTION 25

DWG BY AUBLE

PID PAVETRAIN

T 3 N R 9 E

TYPE MONUMENT MAG/WASHER

ON SURFACE - ~~BELOW~~ ON

OFFSET Q PAVEMENT 27.5' ~~LT~~ : RT

- TO - EDGE PAVEMENT


STATION: 53+87

HORIZ.DATUM: NAD83(2011)


GEOID: NAVD88 2018

GRID: NORTHING: 554946.043

EASTING: 1615008.293

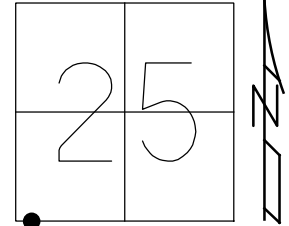

RECORD:
FD P.K./WASHER
2" DOWN
FD MAG/WASHER
5/6/04, RGN
SET MAG/WASHER
8-3-04, MC
SET MAG/WASHER
REFC3
6/1/18, JLL
FD MAG/WASHER
REFC3
4-27-21
9-16-21, JFO
1/11/23, JMR

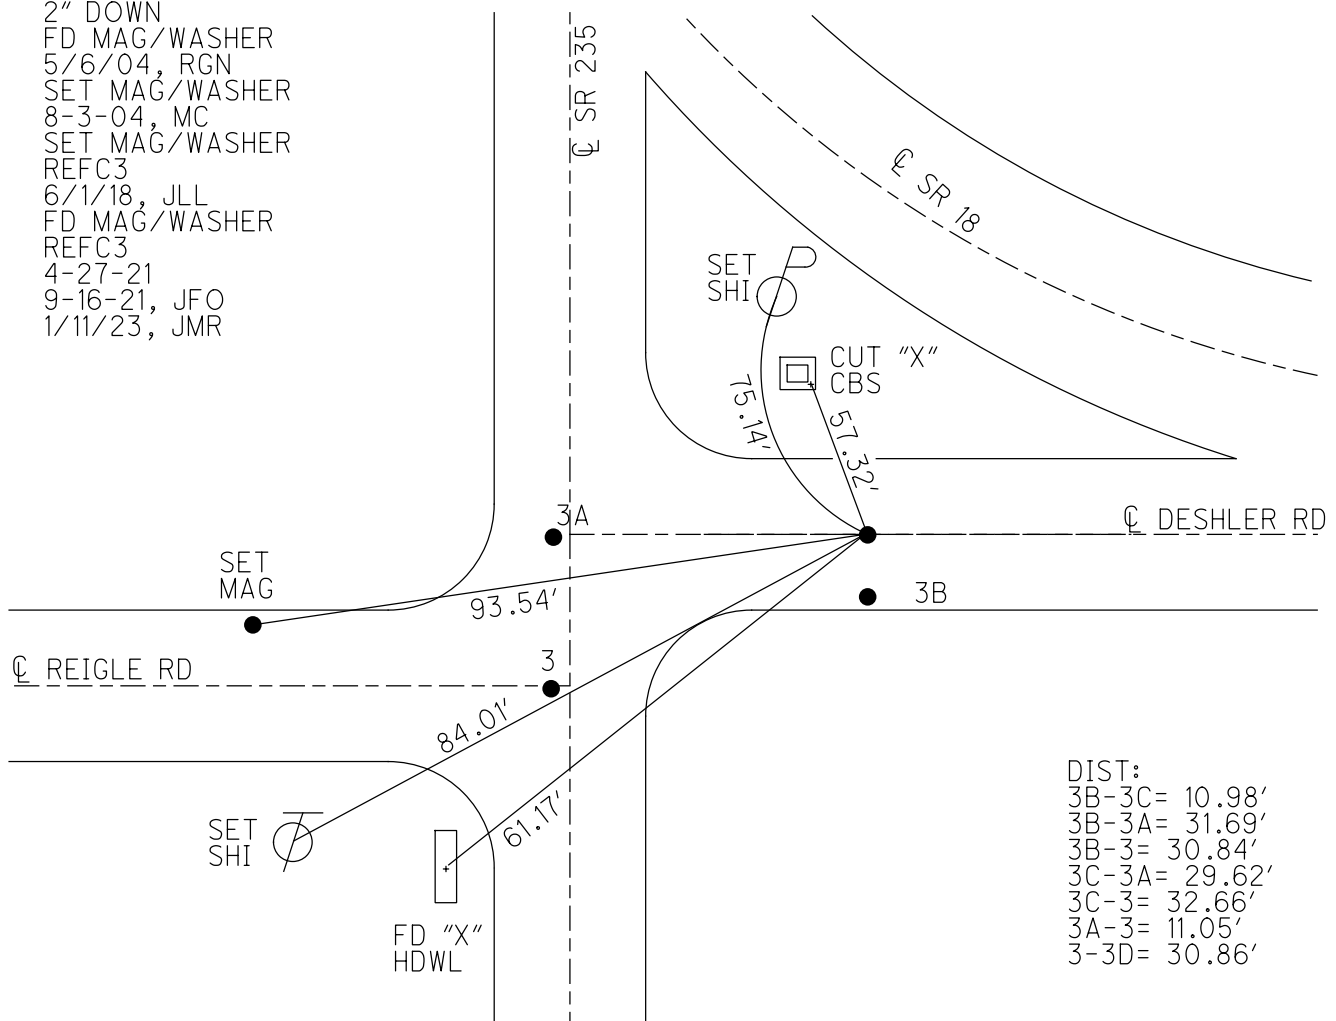

DIST:
3B-3C= 10.98'
3B-3A= 31.69'
3B-3= 30.84'
3C-3A= 29.62'
3C-3= 32.66'
3A-3= 11.05'
3-3D= 30.86'


O.D.O.T. DISTRICT 2 SURVEY OFFICE (USE ONLY)

PERSONNEL _____ REFERENCE NO. 3 C SHEET 8 OF 8

NOTES NUHFER DATE 5-06-04 ROUTE SR 235
H.C. CANERBURY WEATHER SUNNY COUNTY WOOD
R.C. ARMS TEMP. 65°F TOWNSHIP JACKSON
SECTION 26
T 3 N R 9 E

TYPE MONUMENT MAG/WASHER
ON SURFACE - ~~BELOW~~ ON _____
~~LEFT~~ - CL PAV'T - RIGHT 27.5'
- TO - EDGE PAVEMENT
S.L.M. 53+87


Grid: Northing: 554945.976 Easting: 1615008.281

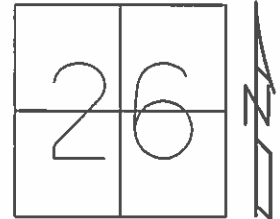

RECORD:
PK SHINER @ 2" DOWN
ON CL PAVEMENT EAST
27.5 E. OF CL S.R.235

SET MAG/WASHER
ALL FOUR POINTS
08-03-04, MC

REF 3B TO REF 3C = 10.99'
REF 3B TO REF 3A = 31.68'
REF 3B TO REF 3 = 30.84'
REF 3C TO REF 3A = 29.60'
REF 3C TO REF 3 = 32.65'
REF 3A TO REF 3 = 11.05'

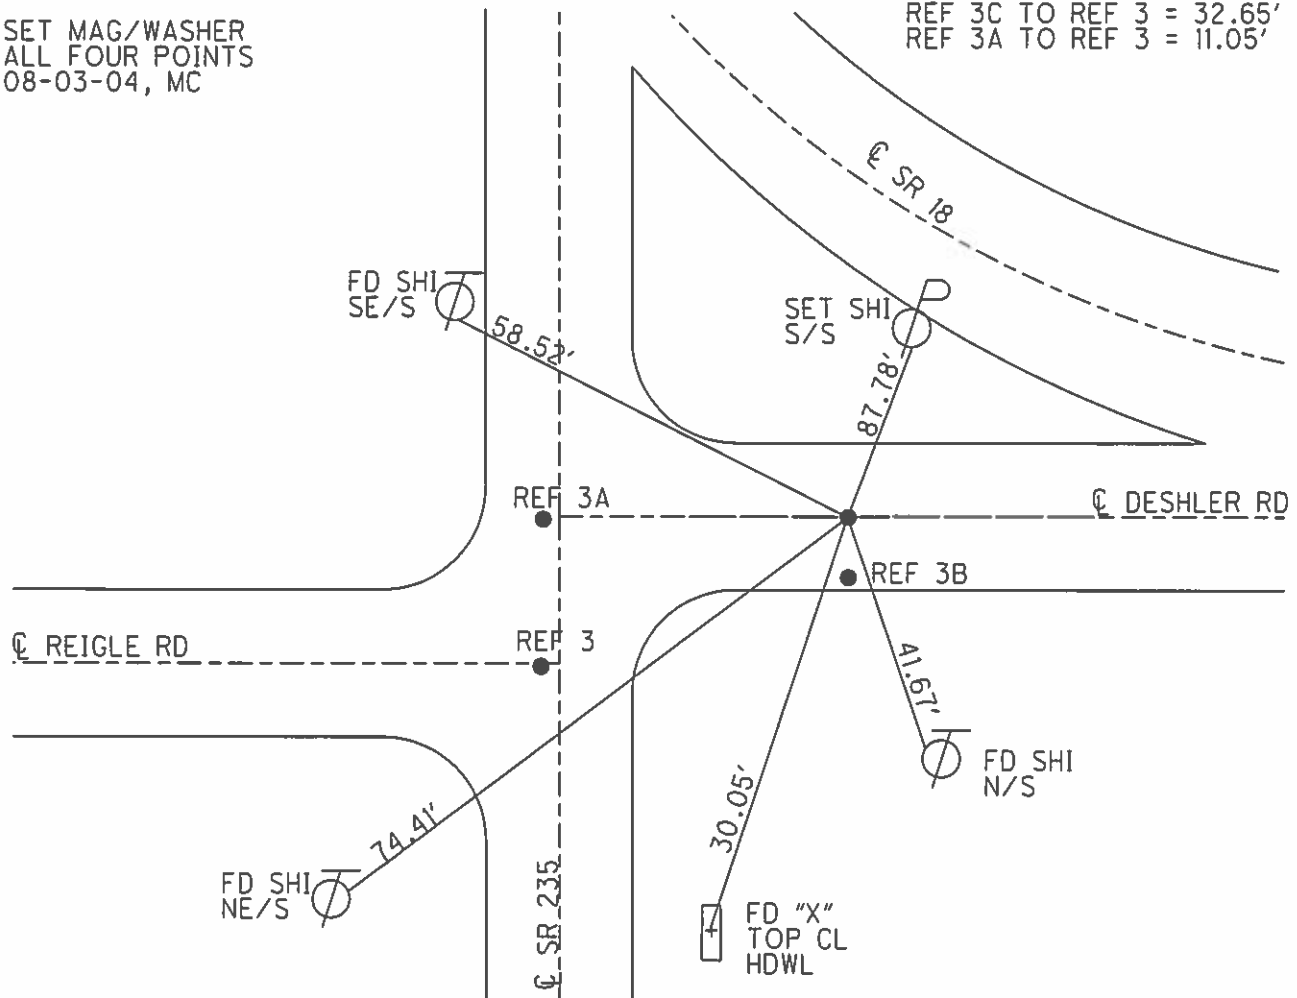

O.D.O.T. DISTRICT 2 SURVEY OFFICE

PERSONNEL

REFERENCE NO. 3

SHEET 5 OF 5

NOTES NUHFER

DATE 5-06-04

ROUTE S.R. 235
S.R. 18

H.C. CANTERBURY

WEATHER SUN

COUNTY WOOD

R.C. ARMS

TEMP. +65°

TOWNSHIP JACKSON

SECTION 26

T 3 N R 9 E

TYPE MONUMENT P.K. / WASHER
PT "D" 1/2" IPIN>>

ON SURFACE YES

LEFT-Q PAV'T-RIGHT INFO. BELOW

TO EDGE PAVEMENT

S.L.M. PT "D" 53+90

26	25
35	36



RECORD: PT "A"
OVER STONE

PT "A" **3B**
PK SHINER@SURFACE
11.0 S. OF Q EAST
27.5 E. OF Q S.R. 235


PT "B" **3C**
PK SHINER@2"DOWN
ON Q PAVEMENT EAST
27.5 E. OF Q S.R.235

PT "C" **3A**
PK WASHER@2"DOWN
ON Q OF PAVEMENT EAST
2.2 LT. OF Q S.R. 235

PT "D" **3**
PK WASHER @SURFACE
11.0 S. OF Q EAST
2.5 LT. OF Q S.R. 235
ON CL WEST

RESET MAGS & WASHERS
ALL FOUR POINTS
08-03-04
MC

REIGLE ROAD

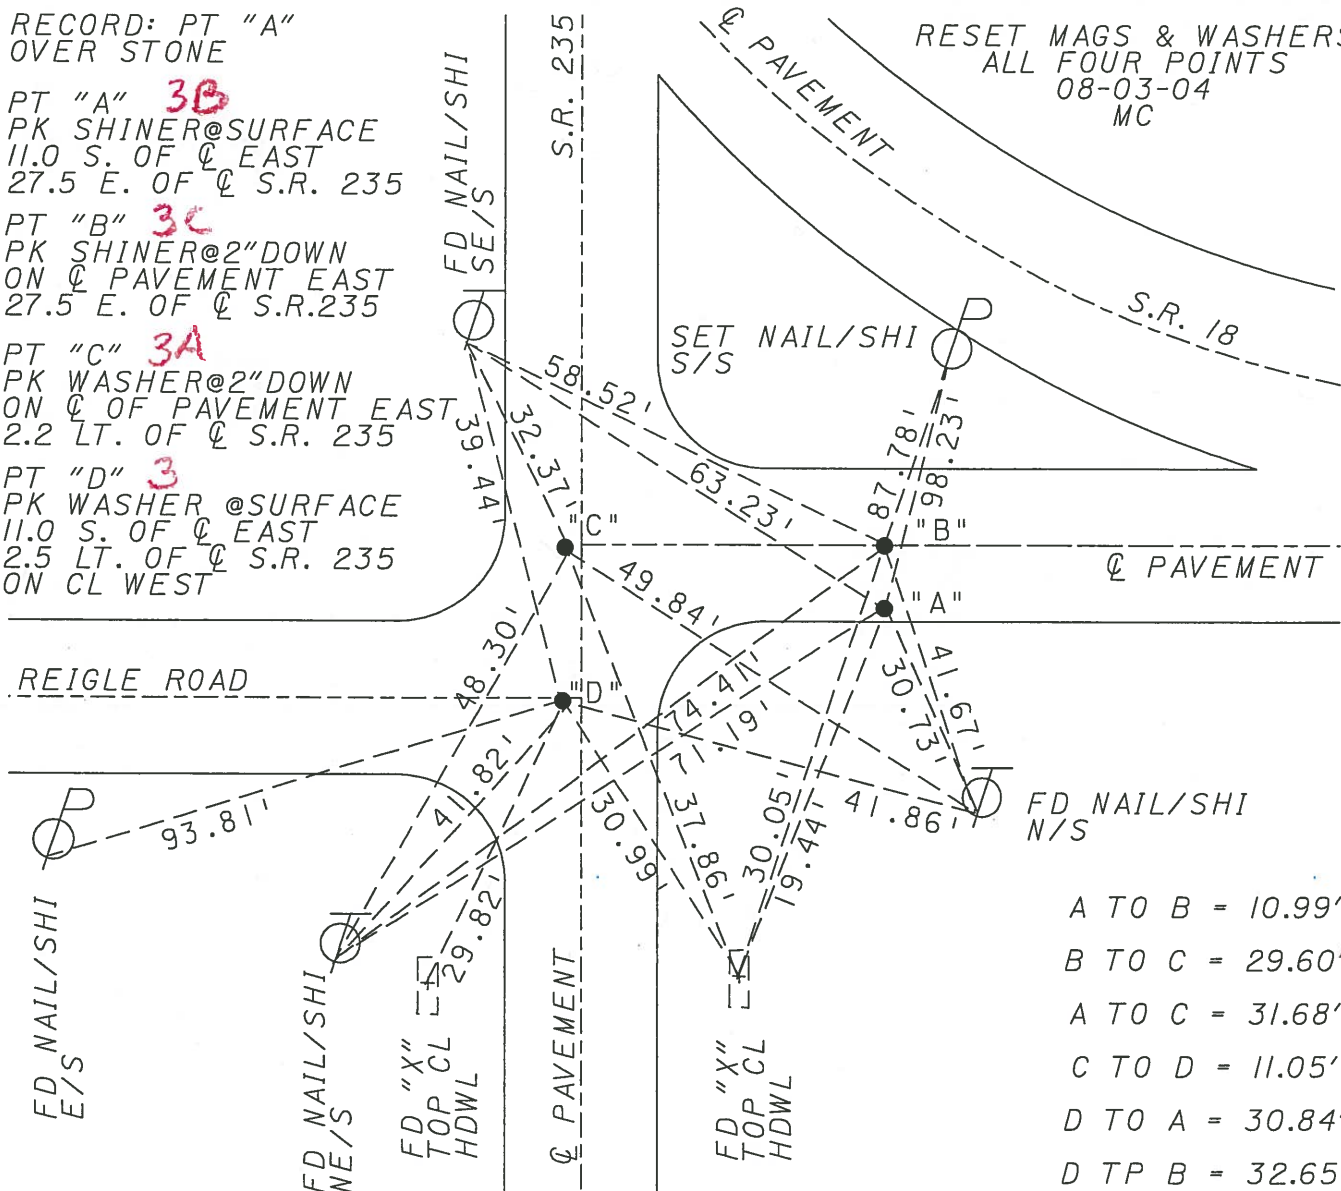

A TO B = 10.99'
B TO C = 29.60'
A TO C = 31.68'
C TO D = 11.05'
D TO A = 30.84'
D TO B = 32.65'

O.D.O.T. DISTRICT 2 SURVEY OFFICE

PERSONNEL

REFERENCE NO. 3

SHEET 3 OF 3

NOTES OTTO

H.C. KUSZ

R.C. BARNHISEL

DATE 7-21-93

WEATHER cloudy

TEMP. +72°

ROUTE SR 18

COUNTY WOOD

TOWNSHIP Jackson

SECTION 26

T 3 N R 9 E

TYPE MONUMENT PK'S + WASHERS / PT "D" 1/2" I. PIN
 ON SURFACE - BELOW yes 2 1/2" DOWN
 LEFT- & PAV'T. - RIGHT INFO. BELOW
 - TO - EDGE PAVEMENT
 S.L.M. PT "D" 53+90

26	25
35	36



RECORD: PT "A"
OVER STONE


PT "A" 3B
11.0 S. OF & EAST
27.5 E. OF & S.R. 235

PT "B" 3C
ON & PAV'T EAST
27.5 E. OF & S.R. 235

PT "C" 3A
ON & OF PAV'T EAST
2.2 LT OF & S.R. 235

PT "D" 3
11.0 S. OF & EAST
2.5 LT OF & S.R. 235
2 1/2" DOWN

RESET PK'S & WASHER
ALL FOUR POINTS
10-27-93
MB

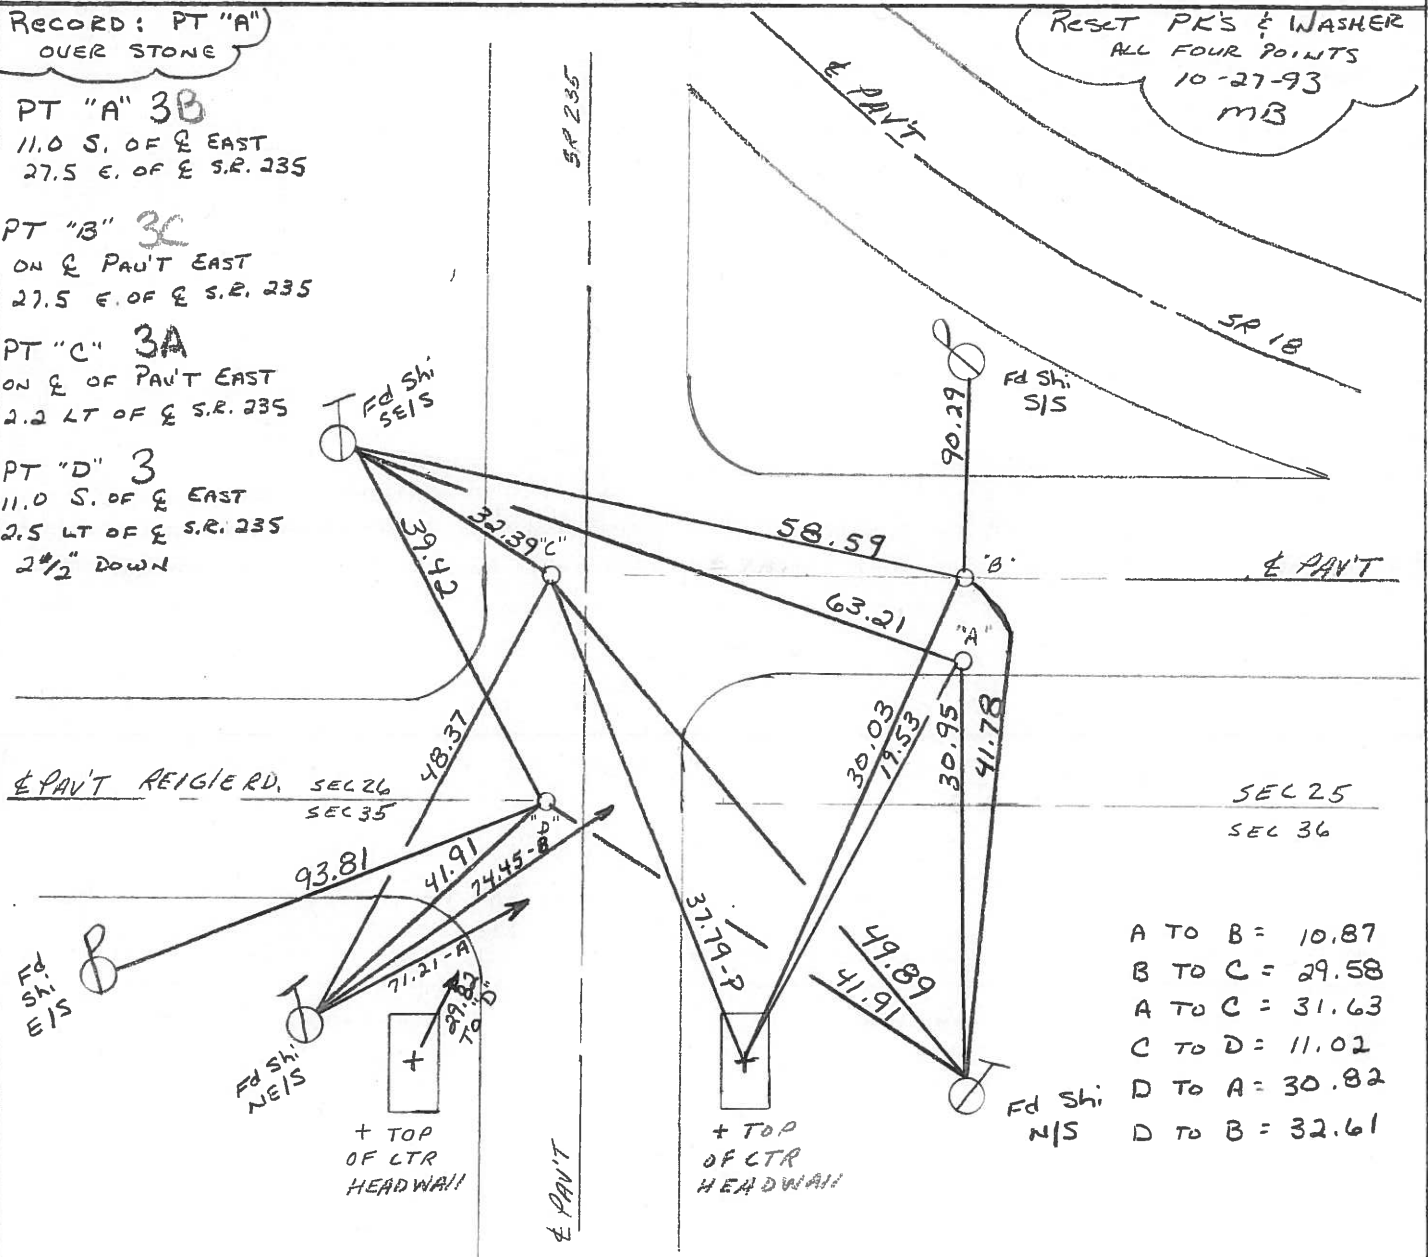

O.D.O.T. DISTRICT 2 SURVEY OFFICE

PERSONNEL

REFERENCE NO. 15

SHEET OF

NOTES BARNHISEL

H.C. Loehake

DATE 3-19-91

ROUTE 18 & 235

R.C. HOFFMAN

WEATHER cloudy - Windy

COUNTY Wood

TEMP. +45°

TOWNSHIP JACKSON

SECTION 26

T 3 N R 9 E

TYPE MONUMENT P.K.'s & Washers


ON SURFACE - BELOW YES (ALL)

LEFT - ℄ PAV'T. - RIGHT Information Below

- TO - EDGE PAVEMENT

S.L.M. NOT COVERED IN 1991 RESURFACING OF S.R. 18

PT. "D"
1/2" IRON PIN
1 1/2" DOWN

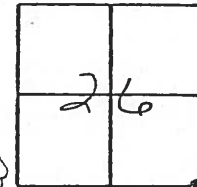


PT. "A"
11.0 S. OF & EAST,
27.5 E. OF & S.R. 235

A TO B = 10.86
B TO C = 29.58
A TO C = 31.63
C TO D = 11.03
D TO A = 30.83
D TO B = 32.60

PT. "B"
ON & PAVT E.
27.5 E. OF & S.R. 235

PT. "C"
ON & PAVT E.
2.2 W. OF & S.R. 235

PT. "D"
11.0 S. OF & E.
2.5 W. OF & S.R. 235
2" DOWN

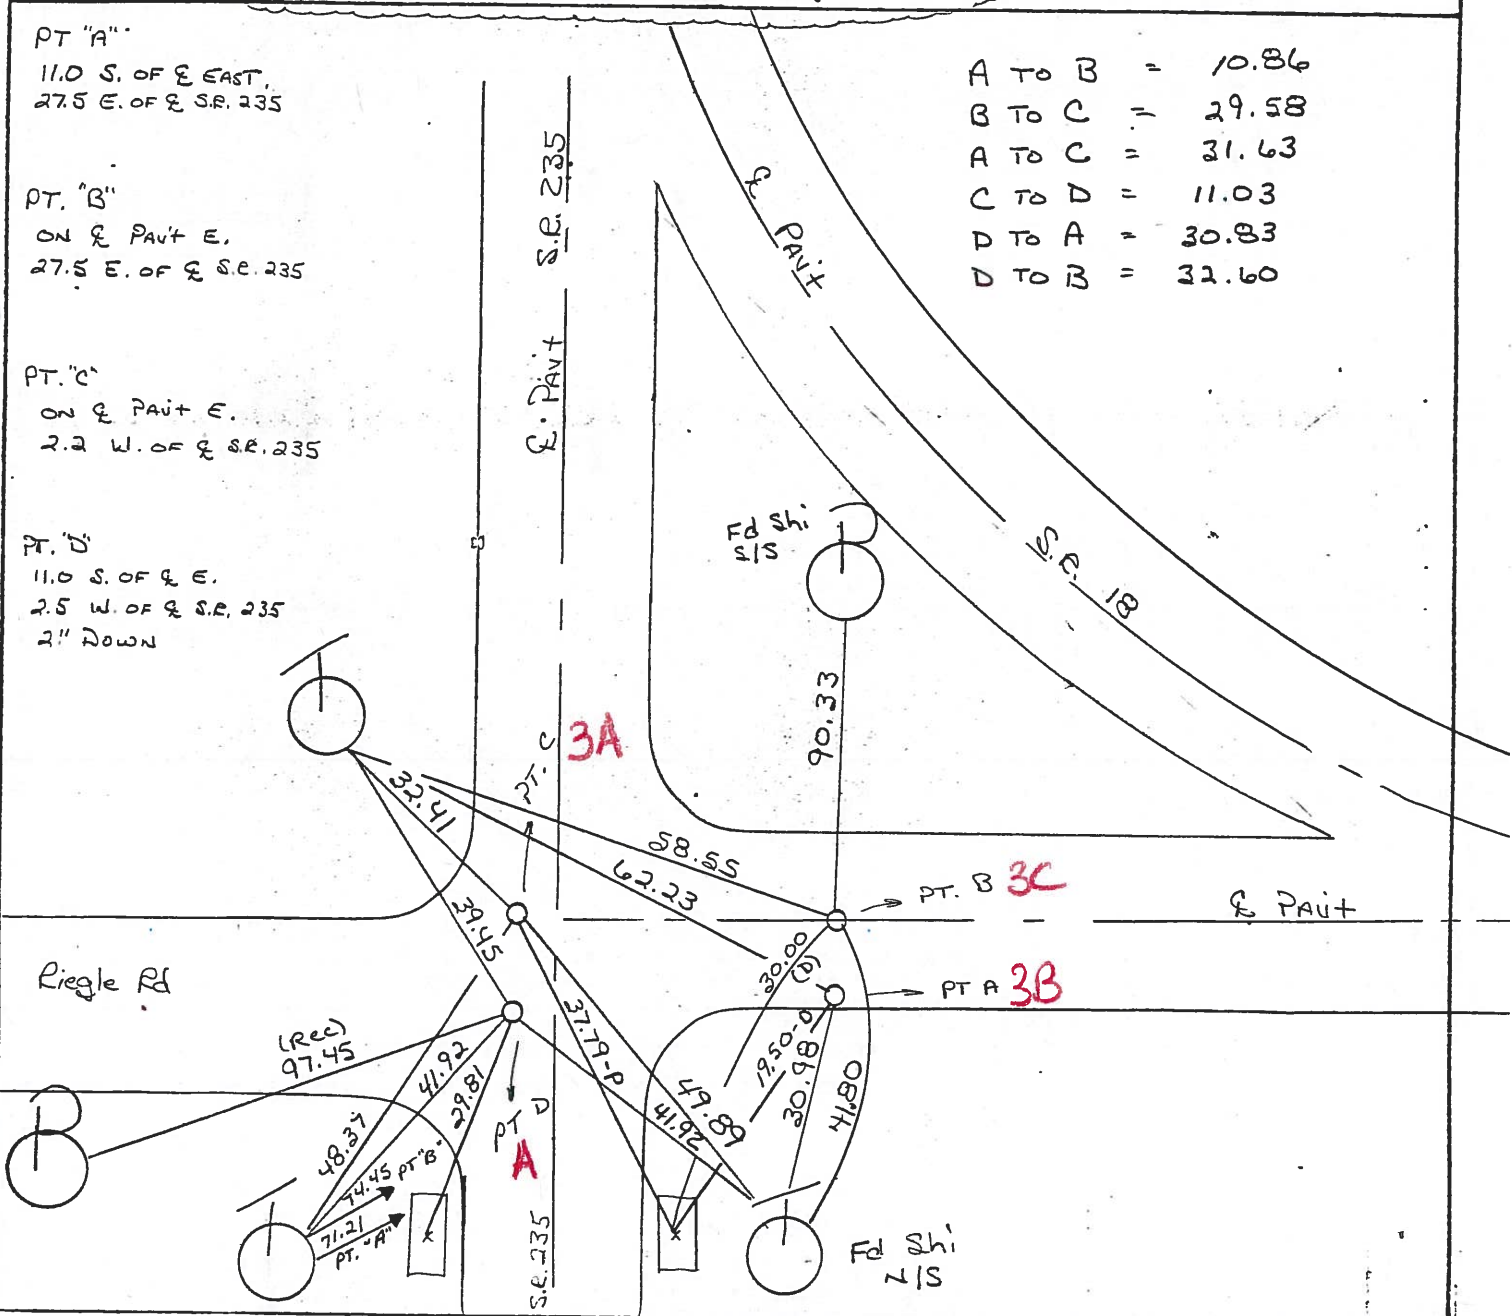

Ed "X" ON BOTH SIDES

Q.D.O.T. DISTRICT 2 SURVEY OFFICE

SHEET 13 OF 14

County WOOD S.R. 18

Township JACKSON

Section 26

T N, R E

Personnel BARNHISEL

HOUSEHOLDER


LOEHRE

#3

Date 11-28-83

Weather RAIN, CLOUDY

Temp. +40°

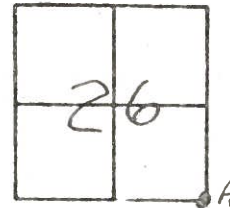


"A" RR SPIKE @ SURFACE OVER STONE
SLM 53+75 (SR 235)
10.9 S of & PAVT 18
27.1 E of & PAVT 235

"C" RR SPIKE @ SURFACE
SLM 53+86 (SR 235)
ON & PAVT SR 18 E
2.5' W of & PAVT 235

#15

"B" BOAT SPIKE @ SURFACE
SLM 53+86 (SR 235)
ON CL PAVT 18
27.1 E of & PAVT 235

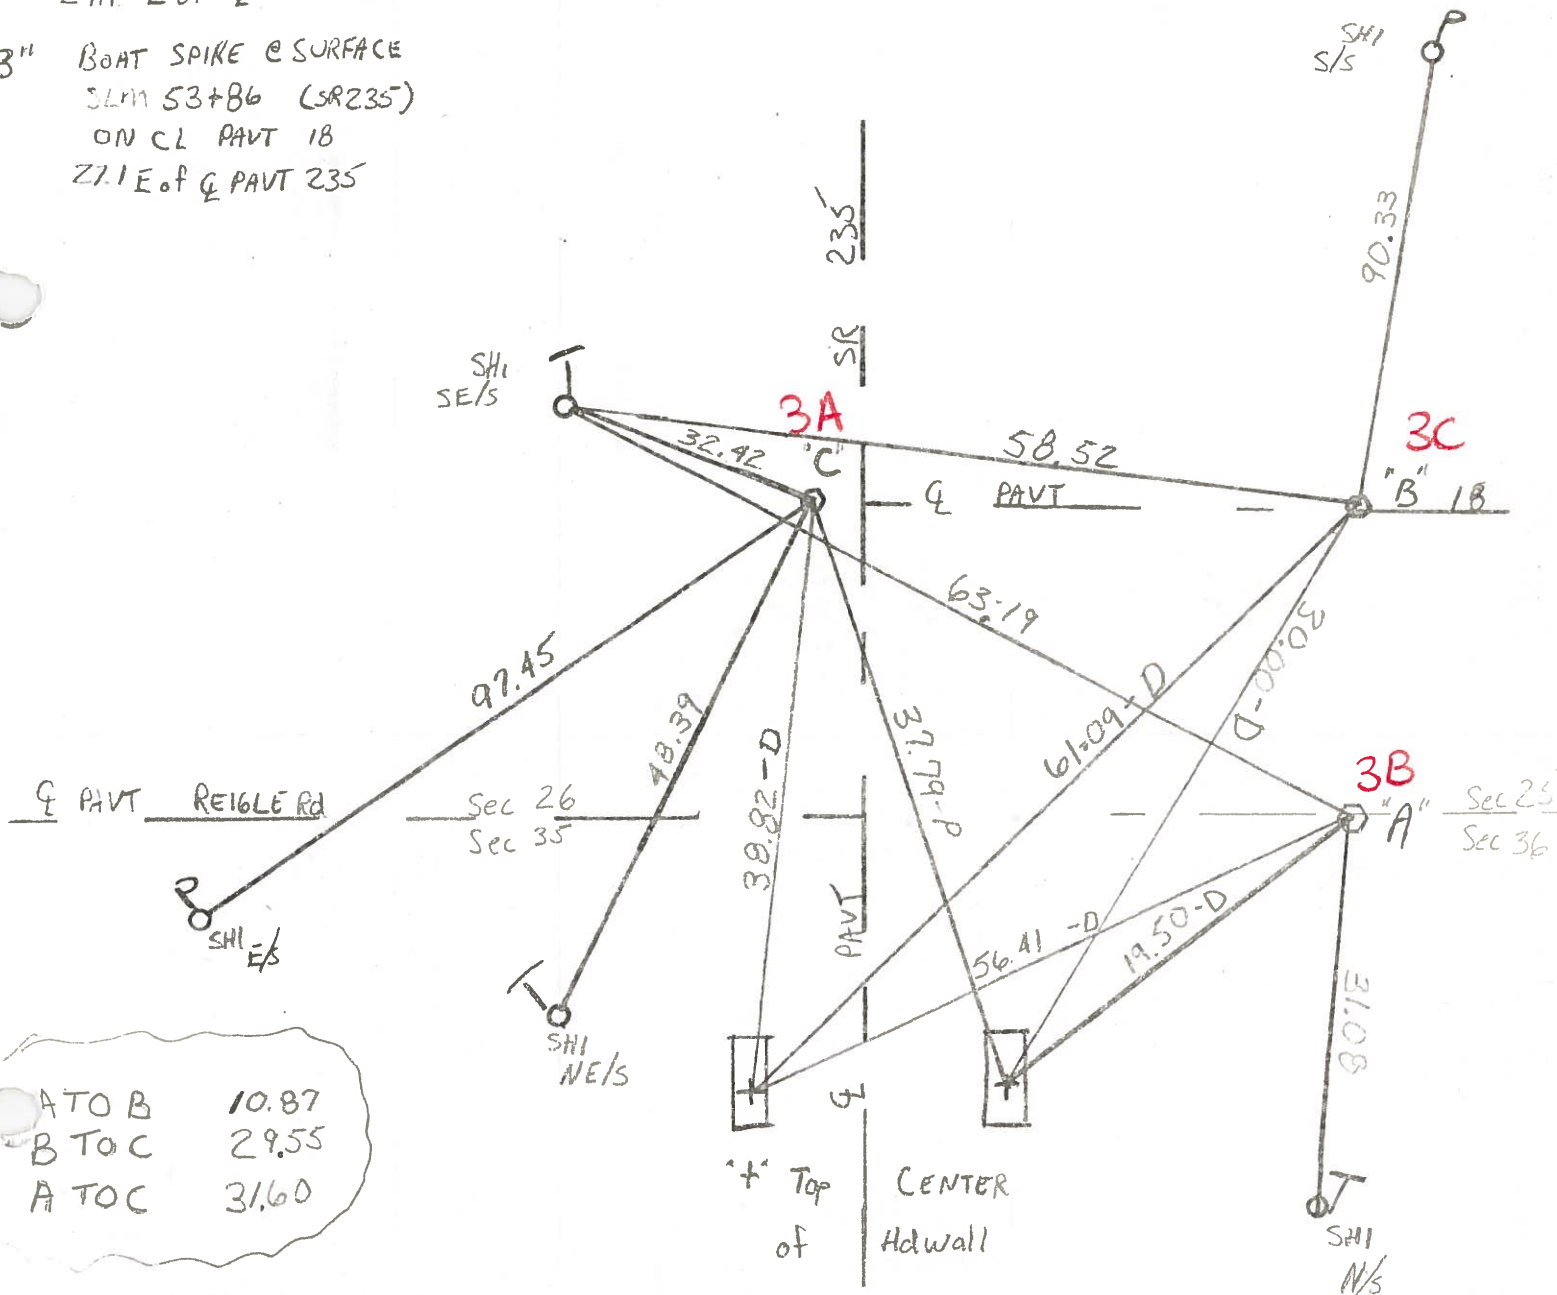

PERSONNEL	TITLE	PERSONNEL	TITLE
BURNSIDE			
SMITH			
BOWERS			

COUNTY Wood DATE 5-1-72
S. R. 235 & 18 WEATHER SHOWERS

SEC. _____ TEMP. +62°

DESCRIPTION	LEFT	CENTER LINE	RIGHT	JOB NO.
CONTROL POINTS @ S.R. 235 & S.R. 18				

