

O.D.O.T. DISTRICT 2 SURVEY OFFICE (USE ONLY)

PERSONNEL

REFERENCE NO. A4

SHEET 4 OF 26

NOTES NIESE

DATE 10/28/24

ROUTE SR 235

H.C. NIESE

WEATHER CLEAR

COUNTY WOOD

R.C. PRESTON-COLVIN

TEMP. 47°

TOWNSHIP JACKSON

DWG BY BARRIERE

PID 101290

SECTION 25

T 3 N R 9 E

TYPE MONUMENT MAG NAIL/WASHER

ON SURFACE - BELOW ON

OFFSET $\varnothing$ PAVEMENT 1.6' RT LT : RT


TO EDGE PAVEMENT

STATION: 106+47.77

HORIZ.DATUM: NAD83(2011)/WOOD LDP GEOID: 2018


GRID: NORTHING: 381555.564 EASTING: 127071.129

LDP: NORTHING: 560205.168 EASTING: 1615073.130

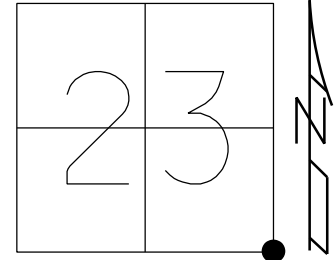

SET PK/WASHER
4-17-91, MB
SET MAG/WASHER
7/26/05, DCH
FD MAG/WASHER
REF13 (SR18)
6/12/20
9/16/21, JFO
FD MAG/WASHER
REF5 (SR235)
2/1/23, JAM
SET MAG/WASHER
(REF13 SR18)
10/28/24, TDN

NOTE: SR 18 REF13

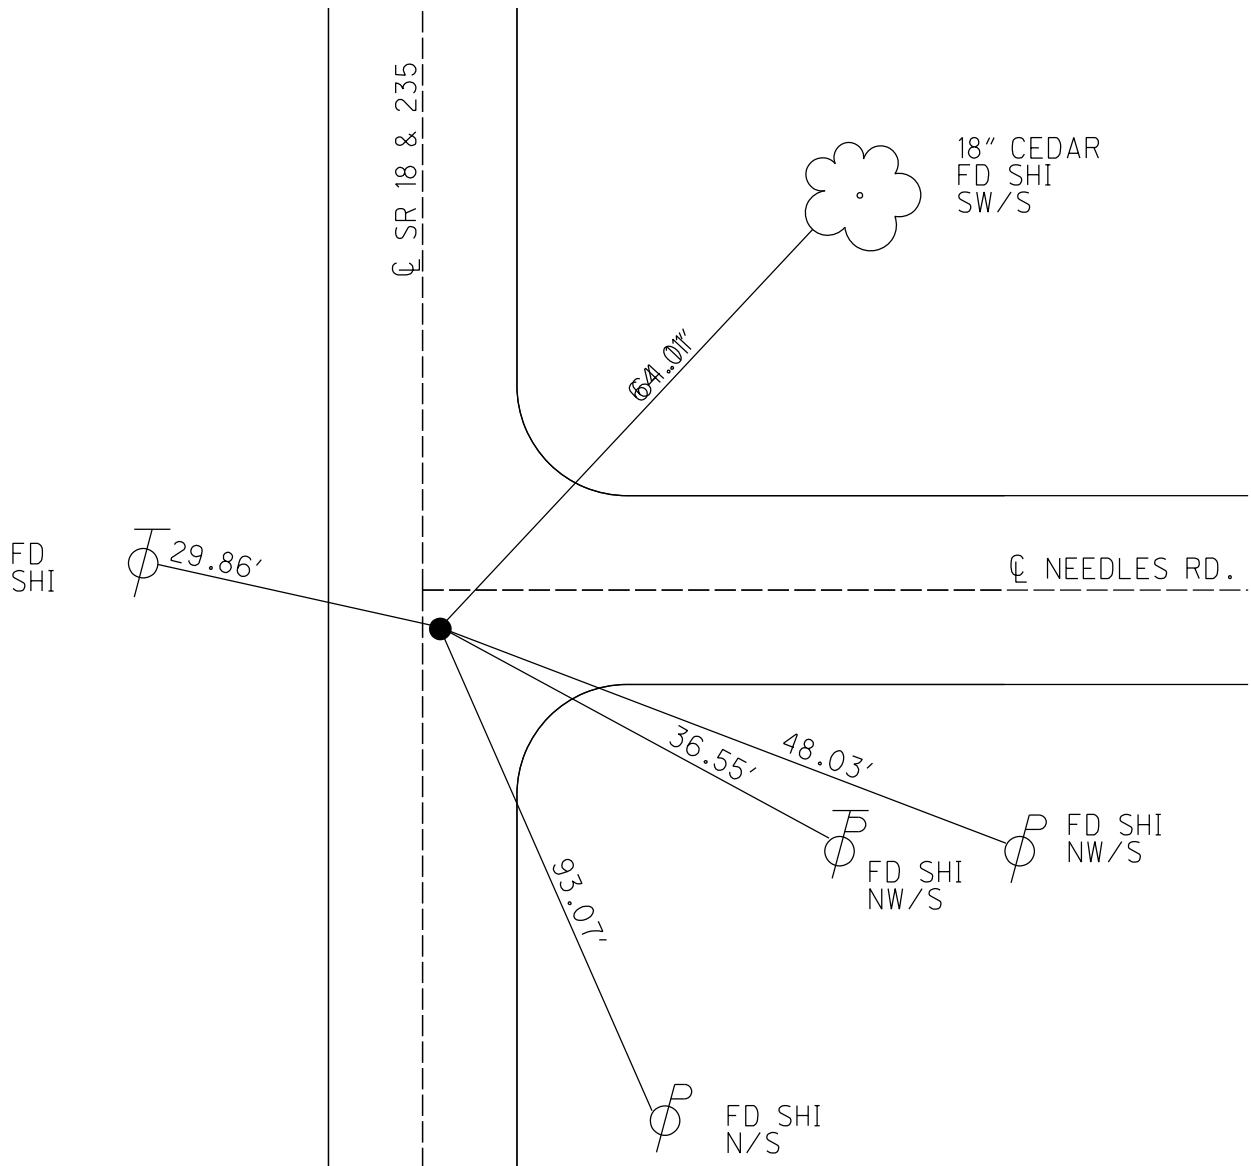


O.D.O.T. DISTRICT 2 SURVEY OFFICE (USE ONLY)


PERSONNEL _____ REFERENCE NO. 5 SHEET 2 OF 26
NOTES HOMAN DATE 9-24-03 ROUTE SR 235
H.C. NUHFER WEATHER CLDY COUNTY WOOD
R.C. BALLMER TEMP. 60°F TOWNSHIP JACKSON
SECTION 23
T 3 N R 9 E

TYPE MONUMENT PK/WASHER
ON SURFACE - ~~BELOW~~ ON
~~LEFT~~ - Q PAV'T - RIGHT 1.6'
11.5' TO RT EDGE PAVEMENT
S.L.M. 106+47.77

Grid: Northing: 560205.196 Easting: 1615073.094

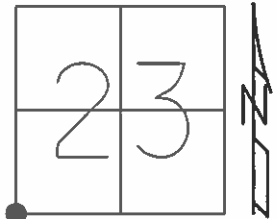

SET PK/WASHER
4-17-91, MB

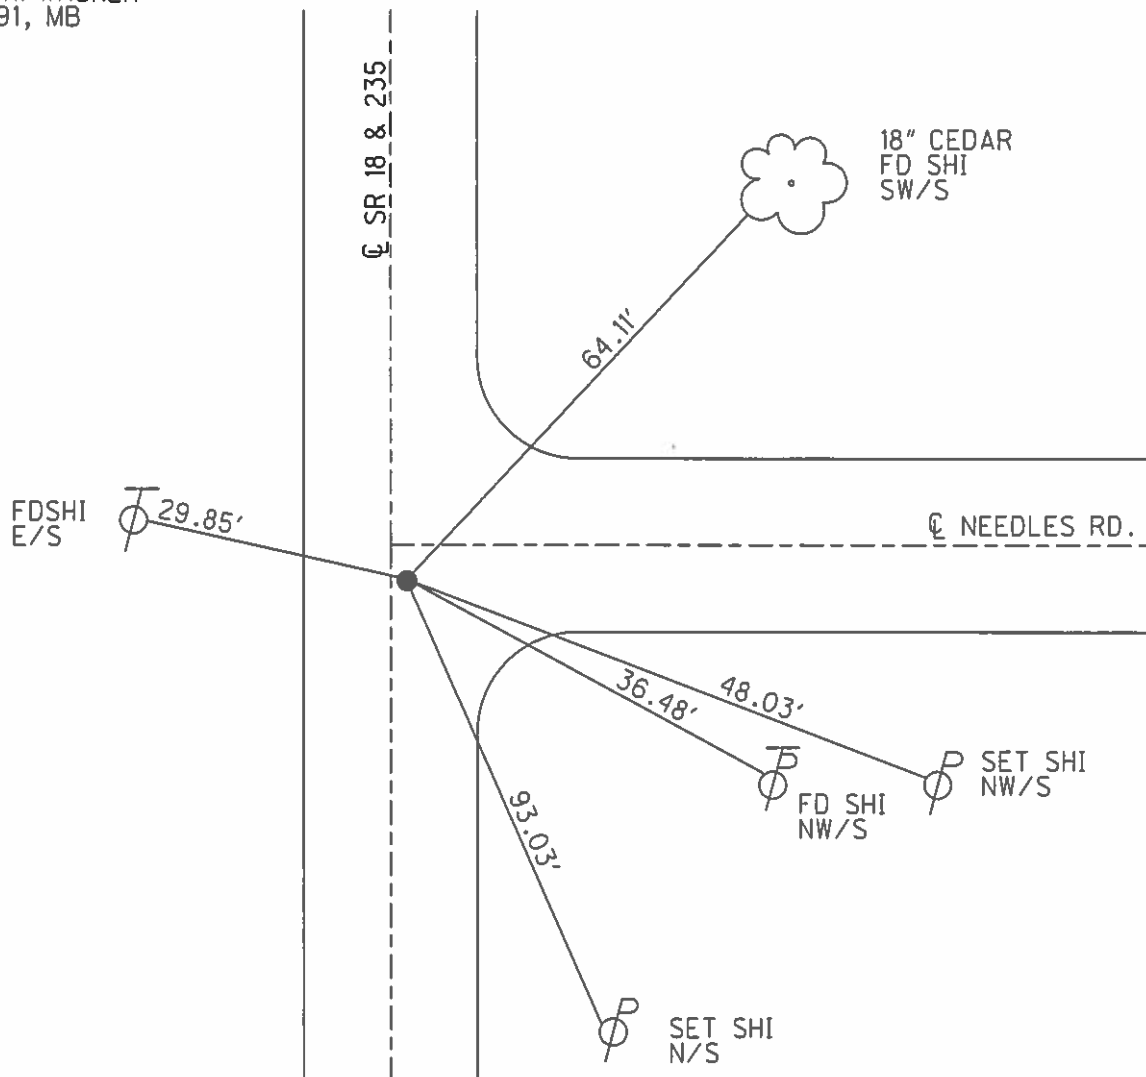

O.D.O.T. DISTRICT 2 SURVEY OFFICE

PERSONNEL

REFERENCE NO. 13

SHEET 1 OF 23

NOTES Homan

DATE 9-24-03

ROUTE 18

H.C. Nuhfer

WEATHER Cloudy

COUNTY WOOD

R.C. Ballmer

TEMP. 60°

TOWNSHIP JACKSON

SECTION 23

T 3 N R 9 E


TYPE MONUMENT PK & Washer

ON SURFACE - BELOW on surface

LEFT - Q PAV'T - RIGHT 1.6


11.5 TO RT EDGE PAVEMENT

S.L.M. 293+39 3.0 S of Q Needles Rd

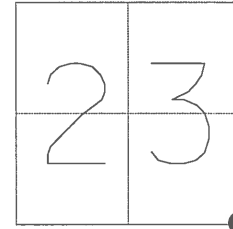

5

Set PK & Washer
4-17-91
MB

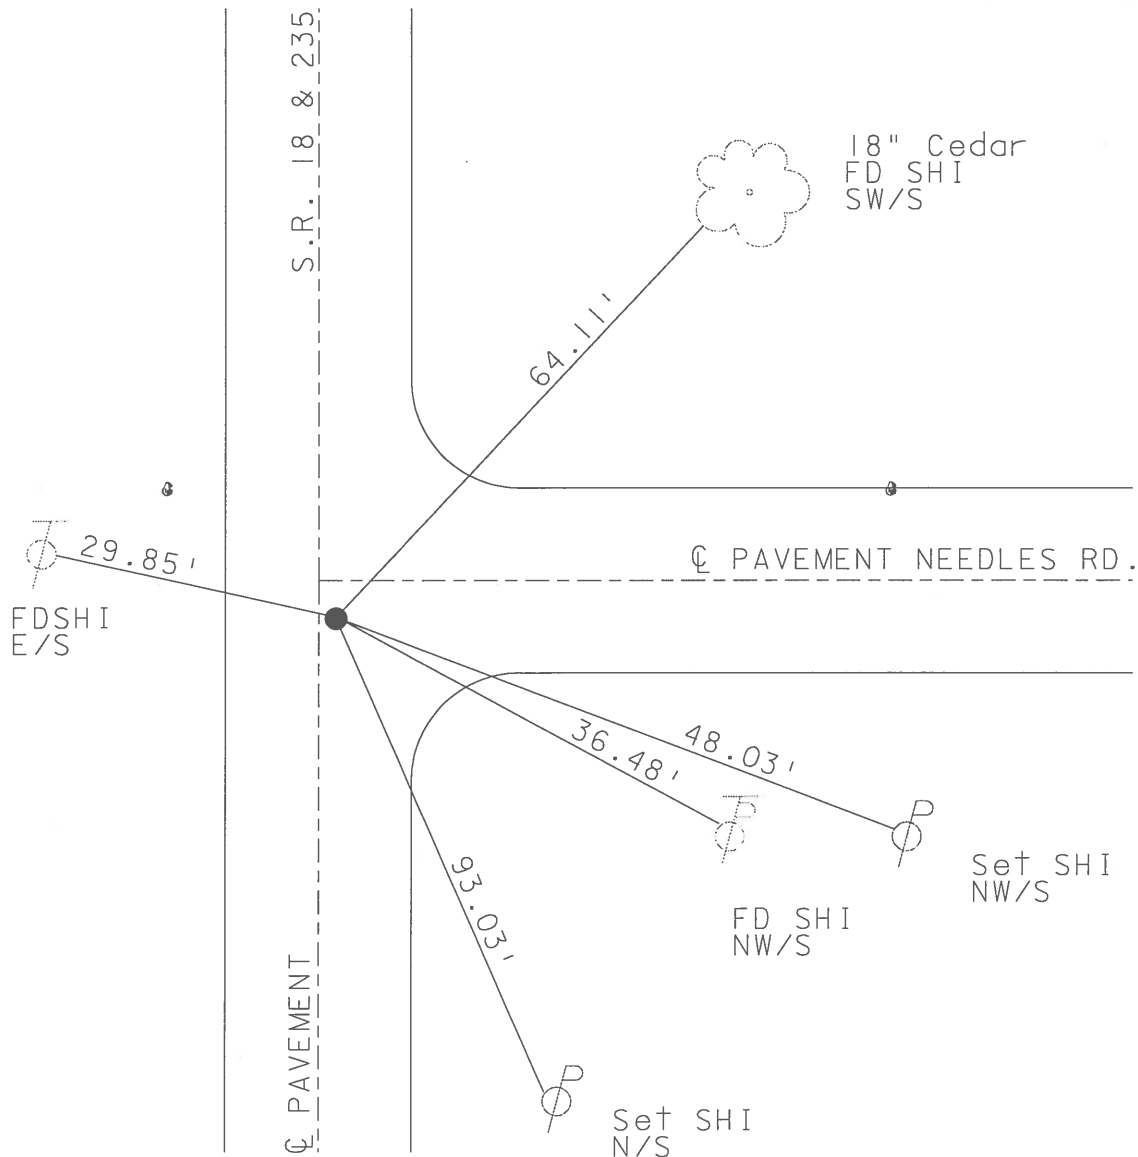

Resurfaced 2003 - Begun North of Point #4

O.D.O.T. DISTRICT 2 SURVEY OFFICE

PERSONNEL

REFERENCE NO. 13

SHEET OF

NOTES BARNHISEL

H.C. Loehke

R.C. Hoffman

DATE 3-19-91

WEATHER cloudy - windy

TEMP. +45°

ROUTE 18

COUNTY Wood

TOWNSHIP Town

SECTION 23

T 2 R 1


TYPE MONUMENT P.K. & Washer

ON SURFACE - BELOW 1/5

LEFT - & PAW'T. - RIGHT 1.6

11.5 TO RT EDGE PAVEMENT

S.L.M. 293739

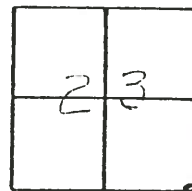

5

Set AK. / Washer
4-17-91
MJB

