

O.D.O.T. DISTRICT 2 SURVEY OFFICE (USE ONLY)

PERSONNEL

REFERENCE NO. 7

SHEET 4 OF 26

NOTES PRESTON-COLVIN

DATE 8-2-24

ROUTE SR 235

H.C. ASTON

WEATHER CLOUDY

COUNTY WOOD

R.C. NIESE

TEMP. 73°

TOWNSHIP JACKSON

DWG BY PRESTON-COLVIN PID CHIPSEAL

SECTION 23

T 3 N R 9 E

TYPE MONUMENT MAG/WASHER

ON SURFACE - BELOW ON

OFFSET Q PAVEMENT 7.7" ± : RT

1.3' TO RT EDGE PAVEMENT

STATION: 159+40.11

HORIZ.DATUM: NAD83 (2011)


GEOID: 2018

GRID: NORTHING: 565497.971

EASTING: 1615080.459

LDP: NORTHING: 386848.5

EASTING: 127008.7

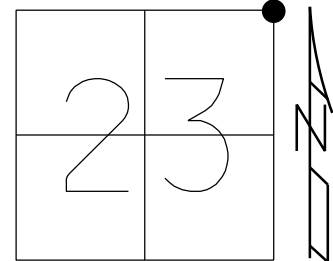

RECORD:
SET SM R.R. SPIKE
6-26-86, MDB


SET MAG/WASHER
11-3-03, DCH

GPS, REF7
8-27-15

SET MAG/WASHER
GPS, NEWREF7
7-28-16, DCH

FD MAG/WASHER
REF7
8-2-24, TDN

FD MAG/WASHER
9-18-24

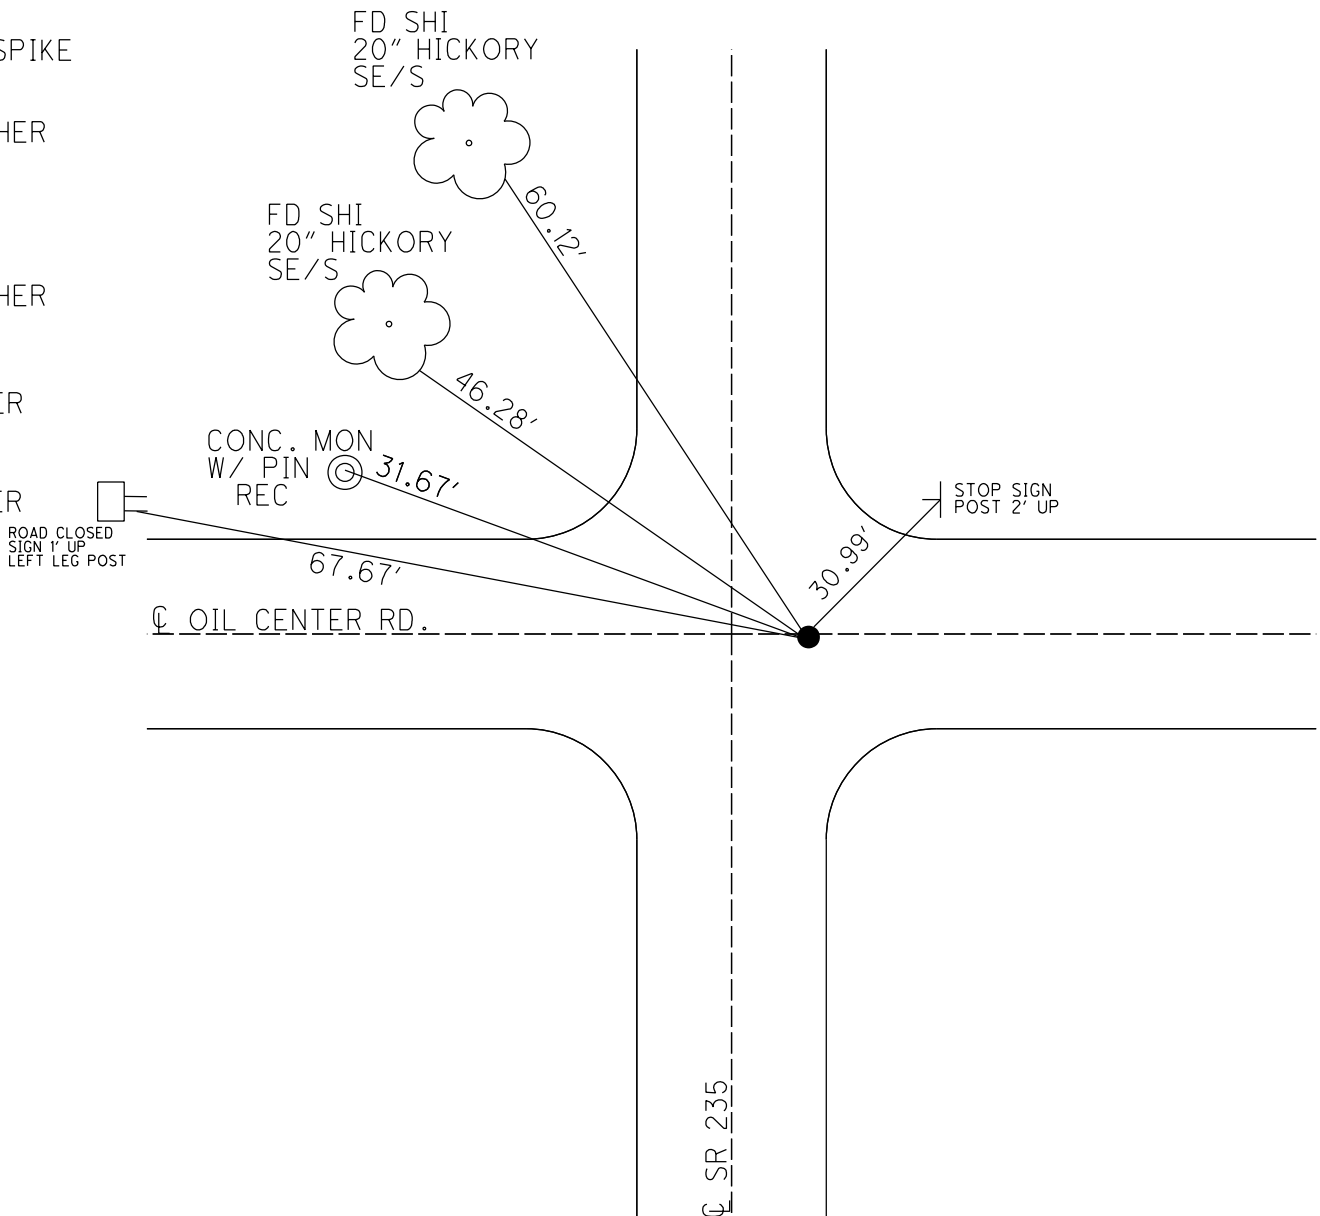

O.D.O.T. DISTRICT 2 SURVEY OFFICE (USE ONLY)

PERSONNEL

REFERENCE NO. 7

SHEET 4 OF 26

NOTES RHOADES

DATE 8-27-15

ROUTE SR 235

H.C. O'DONNELL

WEATHER CLOUDY

COUNTY WOOD

R.C. RHOADES

TEMP. 70°F

TOWNSHIP JACKSON

SECTION 23

T 3 N R 9 E

TYPE MONUMENT MAG/WASHER


ON SURFACE - ~~BELOW~~ ON

~~LEFT~~ - ℄ PAV'T - RIGHT 7.7'

1.3' TO RT EDGE PAVEMENT

S.L.M. 159+40.11

Grid: Northing: 565497.971 Easting: 1615080.459

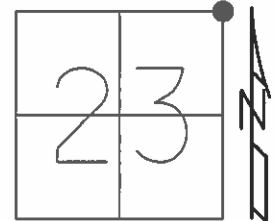

RECORD:
SET SM R.R. SPIKE
6-26-86, MDB

FD SHI
20" HICKORY
SE/S

SET MAG/WASHER
11-3-03, DCH

GPS, REF7
8-27-15

FD SHI
20" HICKORY
SE/S

SET MAG/WASHER
GPS, NEWREF7
7-28-16, DCH

CONC. MON
W/ PIN

℄ OIL CENTER RD.

SET MAG NAIL
1' N OF E ℄

33.44'

60.15'

46.33'

31.67'

℄ SR 235

O.D.O.T. DISTRICT 2 SURVEY OFFICE

PERSONNEL

REFERENCE NO. 7

SHEET 3 OF 23

NOTES Homan

DATE 9-24-03

ROUTE 235

H.C. Nuhfer

WEATHER Cloudy

COUNTY WOOD

R.C. Ballmer

TEMP. 50°

TOWNSHIP JACKSON

SECTION 23

T 3 N R 9 E



TYPE MONUMENT PK & Washer

ON SURFACE - BELOW On Surface

~~LEFT~~ - CL PAV'T - RIGHT 7.7' RT

1.3 TO RT EDGE PAVEMENT

S.L.M. 158+38 (1.4' N of CL Oil Center)

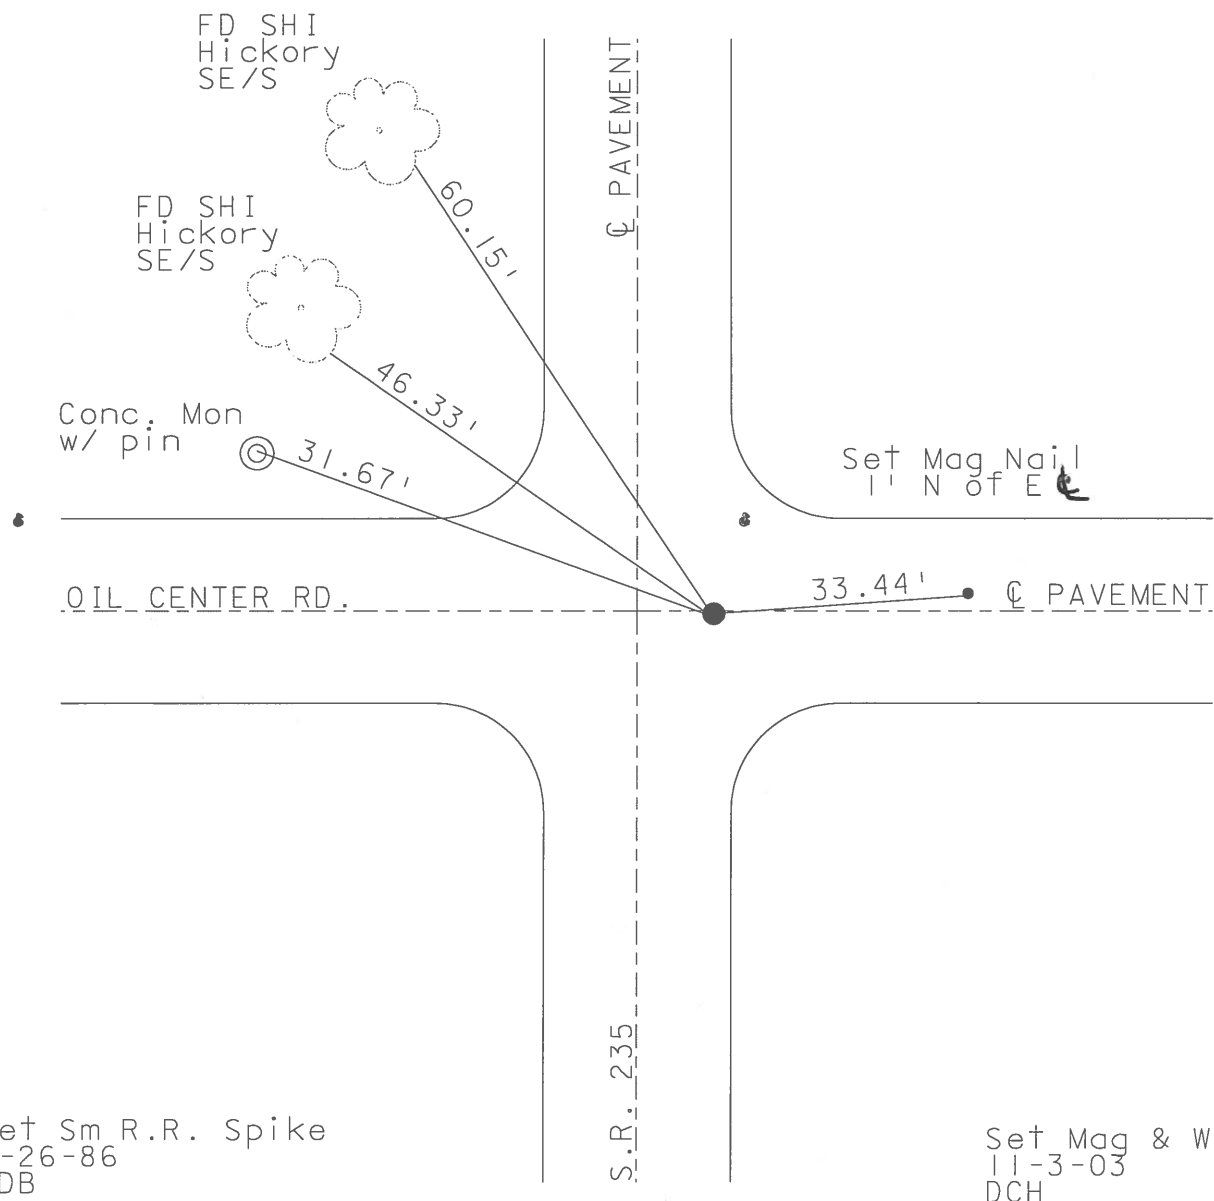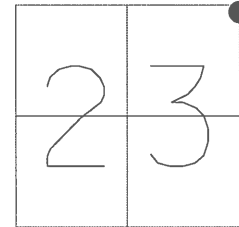

O.D.O.T. DISTRICT 2 SURVEY OFFICE

PERSONNEL

REFERENCE NO. 7

SHEET 2 OF 28

NOTES Huss

H.C. Moser

R.C. Huss

DATE 05-21-96

WEATHER Sunny

TEMP. +66°F

ROUTE 235

COUNTY Wood

TOWNSHIP Jackson

SECTION 23

T3 N R 9 E


TYPE MONUMENT Small RR Spike

ON SURFACE - ~~BELOW~~ Yes

LEFT-PAV'T.-RIGHT 7.7' Rt.


1.3' TO Rt. EDGE PAVEMENT

S.L.M. 158+38 (1.5' N. of Oil Center Rd-East)

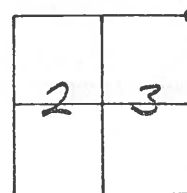

Record
Set Sm RR Spike
6-26-86
M.D.B.

(Set PK/Washer
10-7-96
B.U.D.)

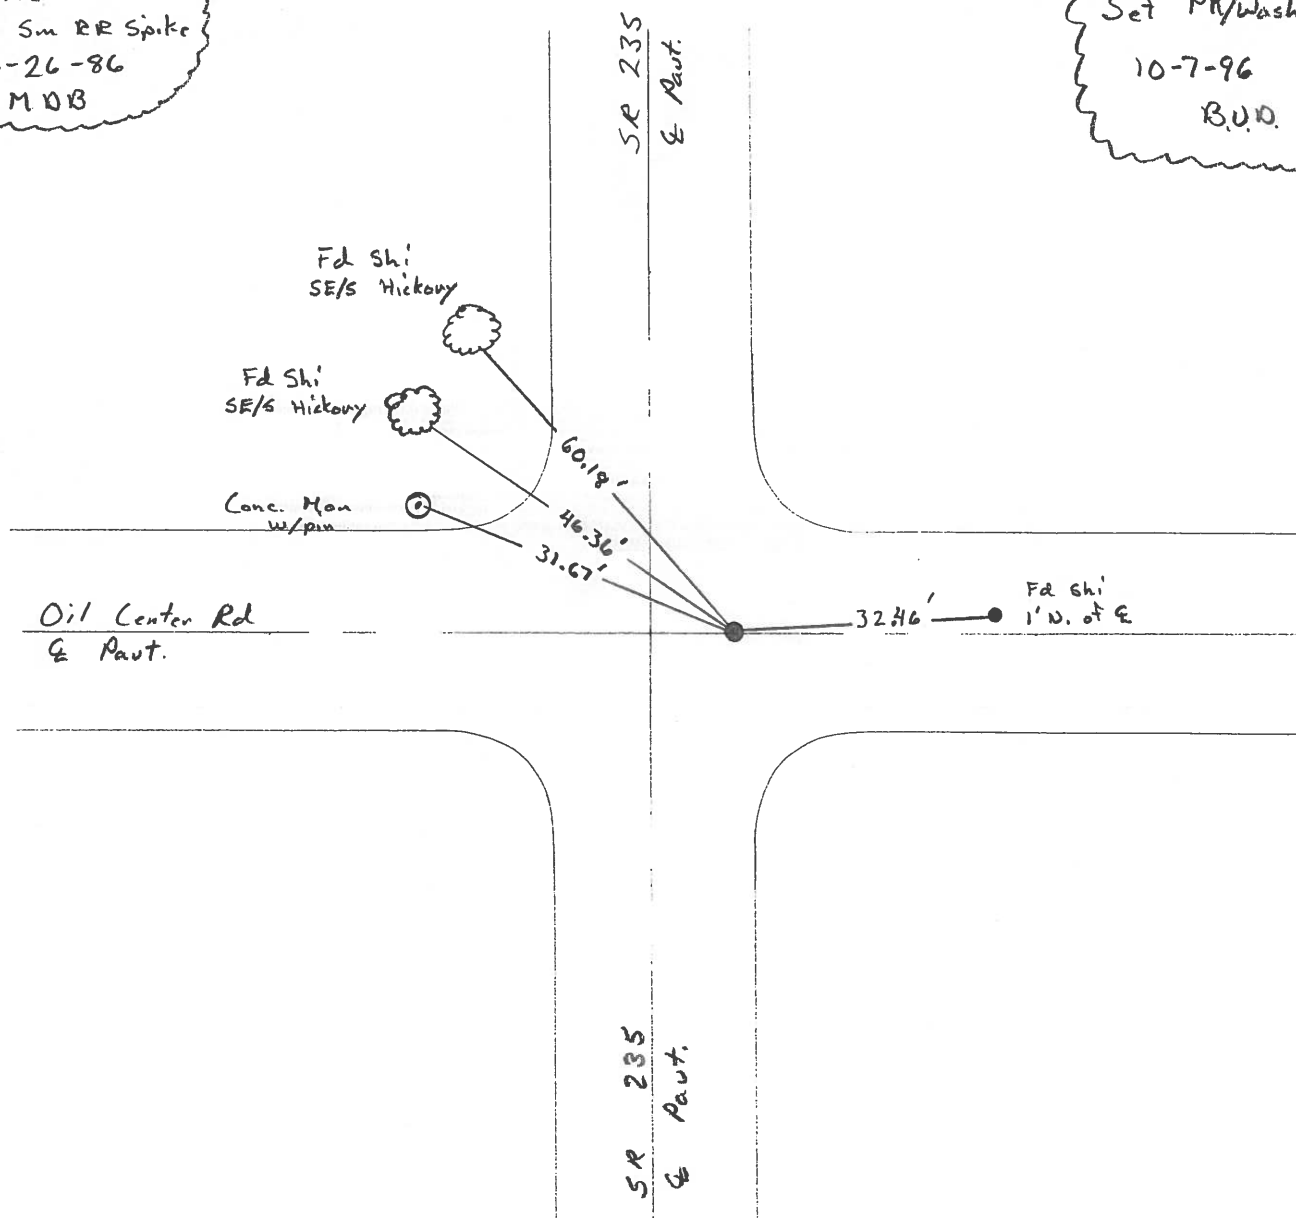

O.D.O.T. DISTRICT 2 SURVEY OFFICE

PERSONNEL

REFERENCE NO. 7

SHEET OF

NOTES BARNHISEL

H.C. Loehrke

R.C. Hoffman

DATE 6-3-86

WEATHER SUNNY

TEMP. +50°

ROUTE 235

COUNTY WOOD

TOWNSHIP JACKSON

SECTION 23

T. 3 N R. 9 E

TYPE MONUMENT Sm RR Spk


ON SURFACE - ~~BELOW~~ yes

~~LEFT~~ - & PAV'T. - RIGHT 8.0


- TO - EDGE PAVEMENT

S.L.M. 158+38

Set Sm RR Spk
6-26-86
MAB

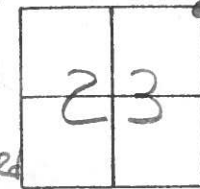

1.5 N. OF E Oil Center Rd
EAST

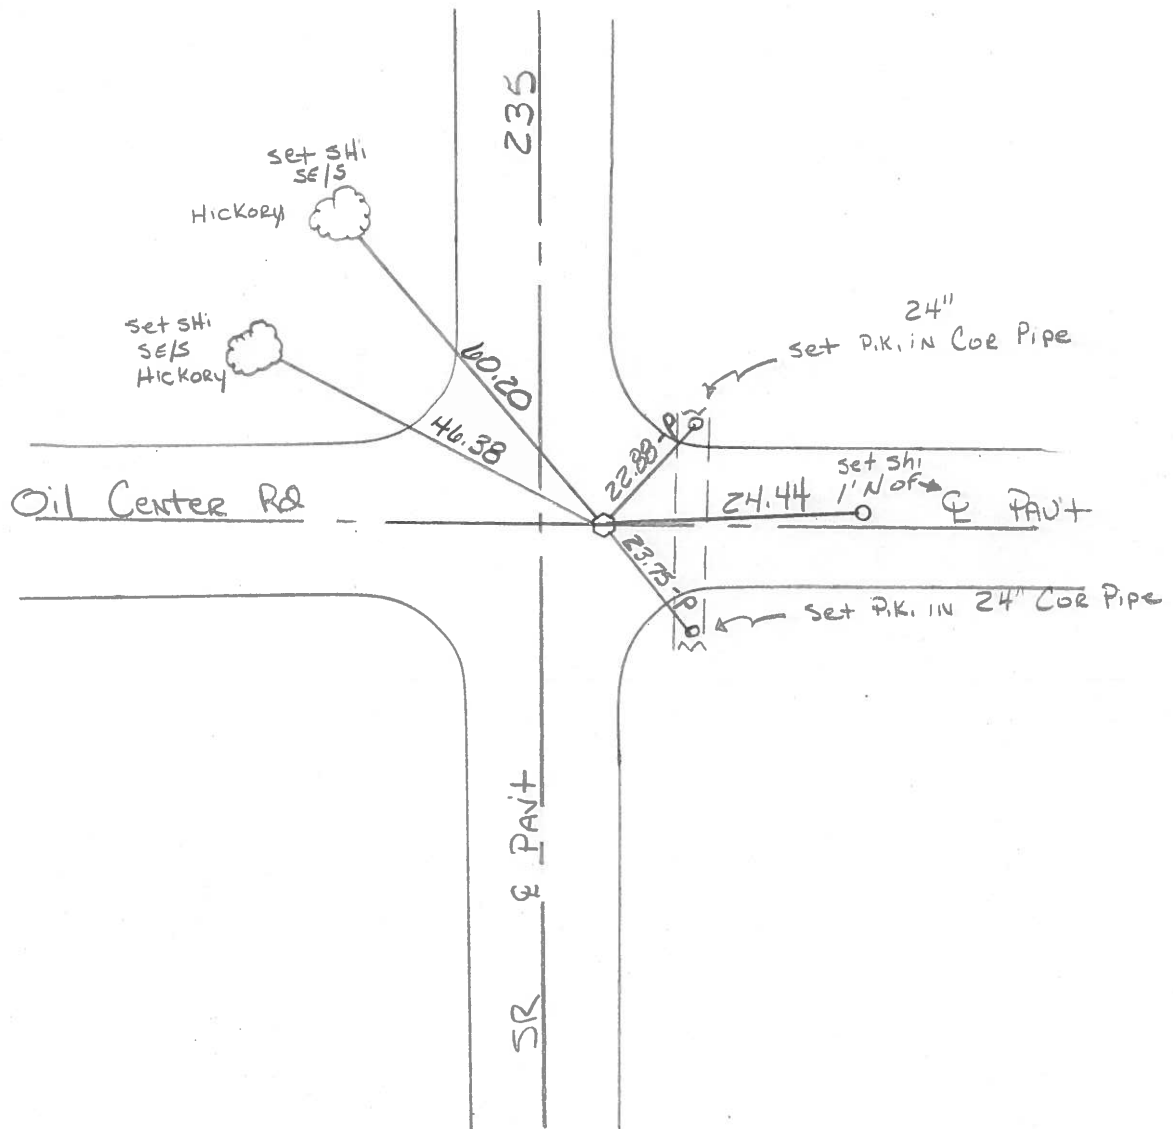

PERSONNEL	TITLE	PERSONNEL	TITLE
BURNSIDE			
SMITH			
BOWERS			
MEAD			

COUNTY Wood DATE 12-8-75
S. R. 235 WEATHER Pt. Cloudy
SEC. N.W. COR. SEC. 24 TEMP. +36°


DESCRIPTION CONTROL TIES

LEFT


CENTER LINE

RIGHT

JOB NO.

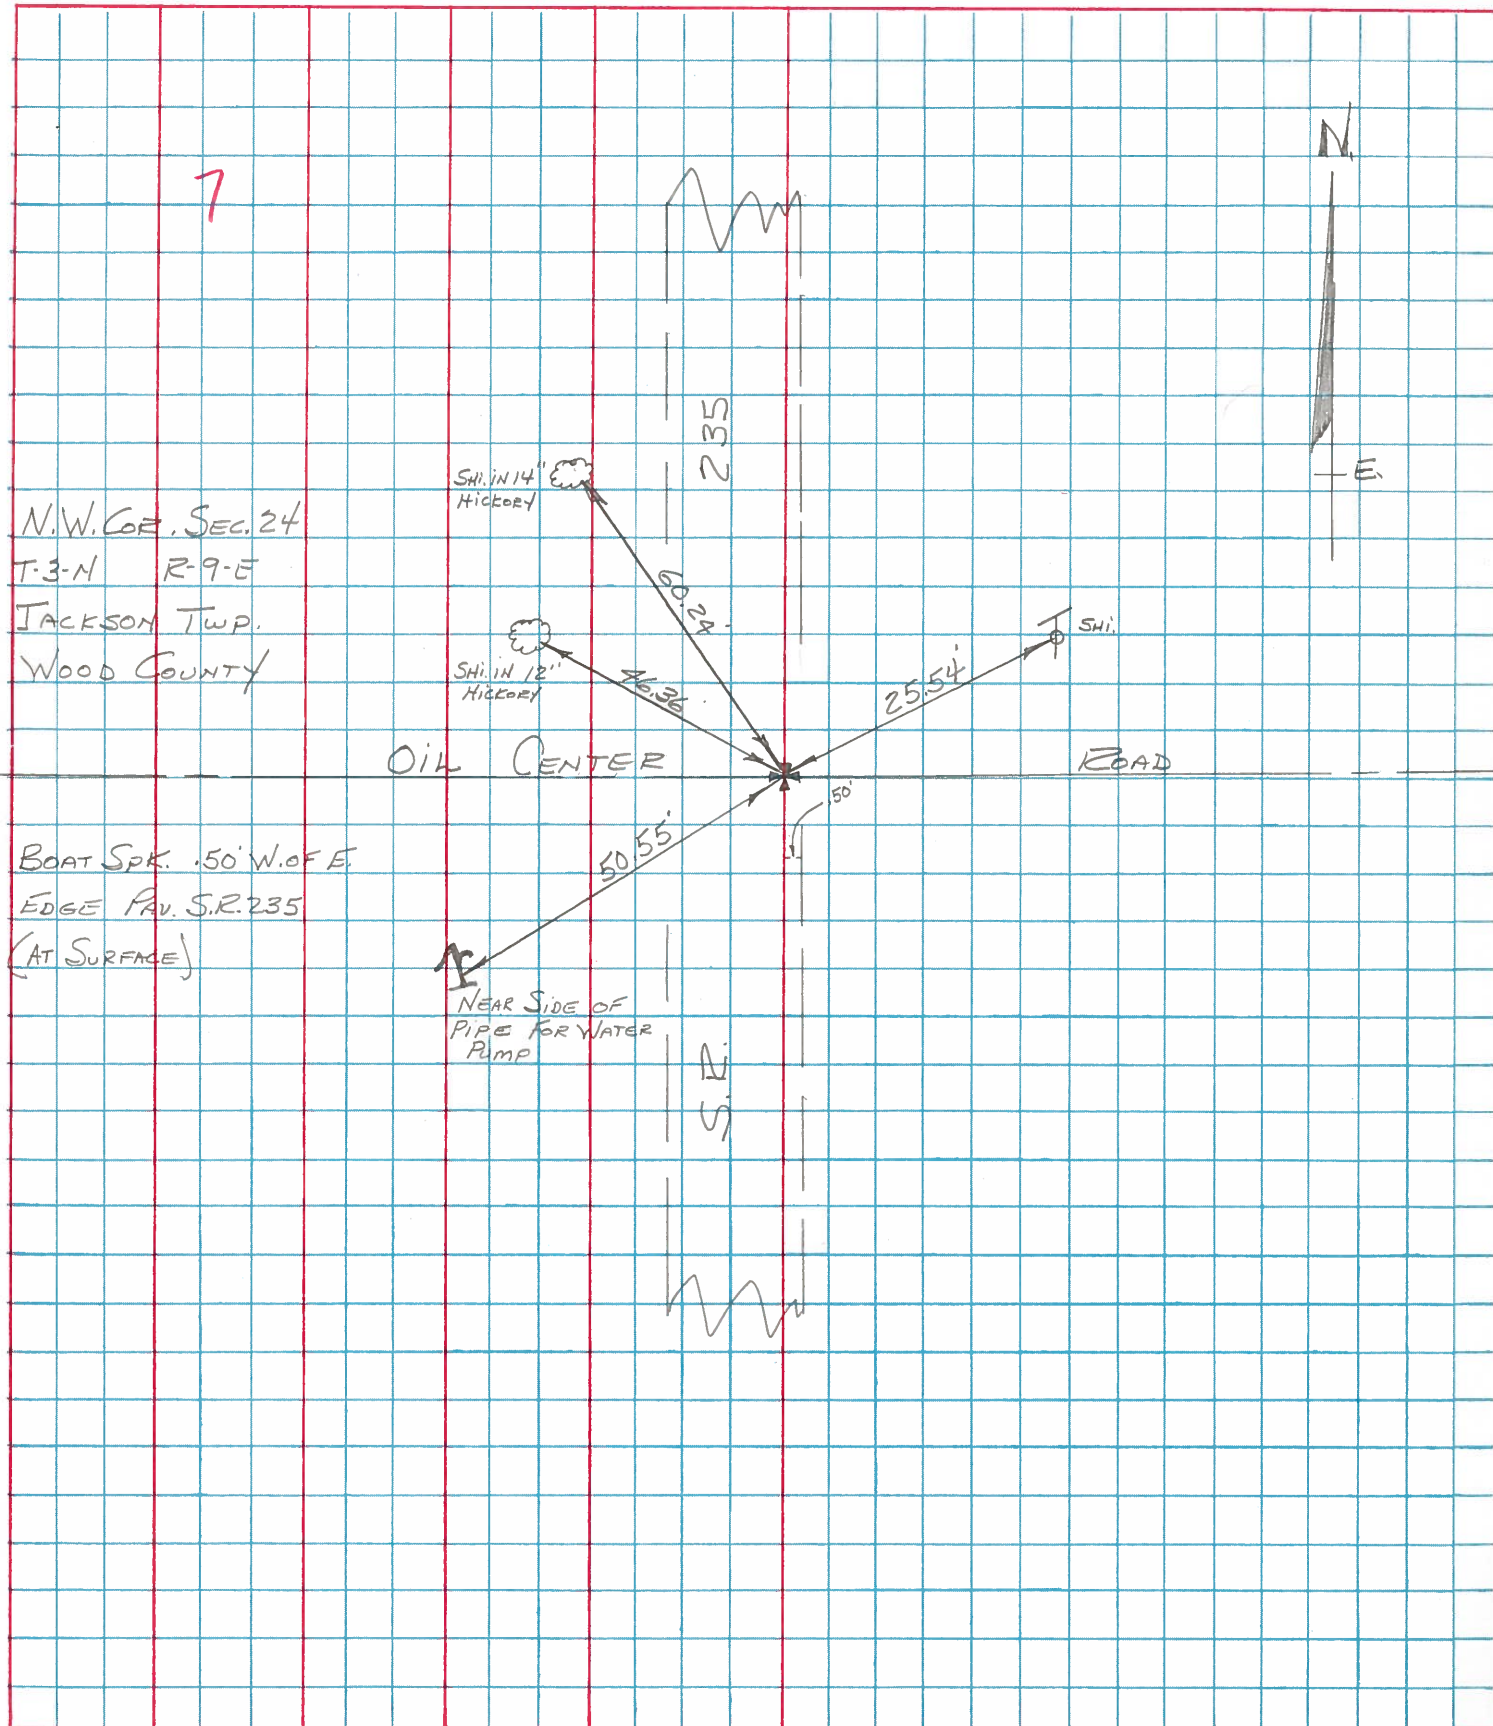

PERSONNEL	TITLE	PERSONNEL	TITLE	COUNTY	DATE	S. R.	WEATHER	SEC.	TEMP.
MORRISON				Wood.	April, 23, 1969	#235 old SR#69	Cloudy & Windy.	from SR#18 North.	+40°
DESCRIPTION <u>Ties to Control Points</u>									
LEFT			CENTER LINE		RIGHT			JOB NO.	

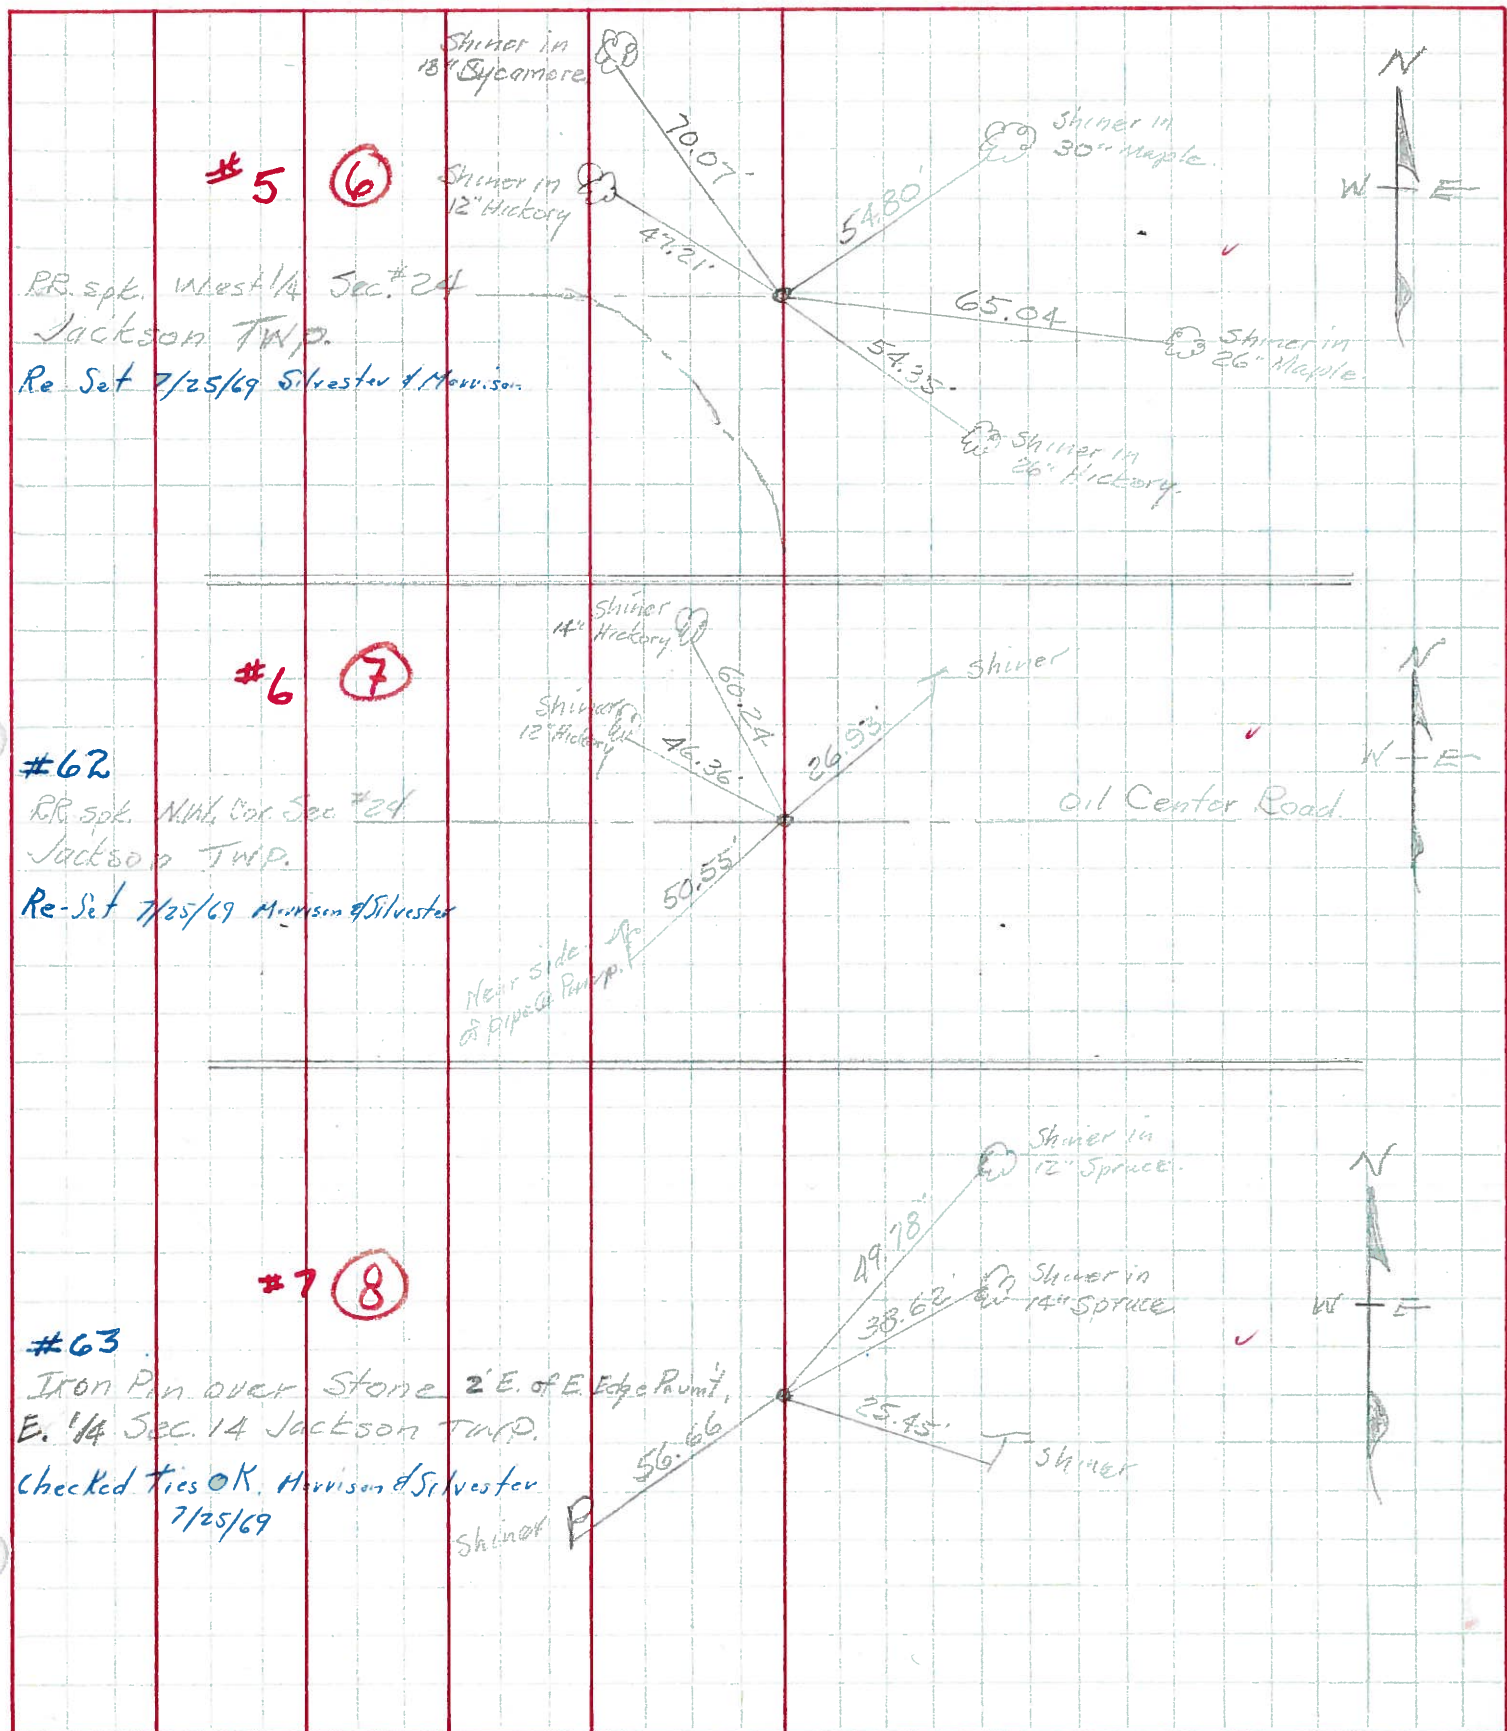

PERSONNEL

TITLE

PERSONNEL

TITLE

COUNTY.

DATE _____

S. R.

WEATHER

SEC.

TEMP

DESCRIPTION

LEFT

CENTER LINE

RIGHT

JOB NO.

Wood

12-13-57

4-14-60

1-18-66

#69

A, B, C

From Hoytsville - North

S.E. Cor. Sec. 14 Jackson
Twp. Iron pin over
stone. O. Center Rd.

#62

7

E. 1/4 post sec. 14 Jackson
Twp. Iron pin over stone
2' E. of E. Edge Pav't

#63

8

N.E. Cor. sec. 14 Jackson
Twp. R.R. Spk. over stone
Hammansburg Rd.

#64

9

W¹/₄ of the S.W. ¹/₄ Sec. 12
Found stoner

#65

9-A

E. 1/4 past sec. 11 Jackson
Twp. (Ties No Good 12-13-57)
" " " (1-18-66)

66

10

✓ Shi. in 12" Hickory N.W.	46.38
✓ Shi. in Tele. Pole N.E.	26.95
Conc. man. (N.G.) N.E.	25.12
✓ Conc. man. (Leaning) N.W.	32.00 31.54
Conc. man. (Gone) W.S.W.	34.0'
✓ Vertical pipe of water well S.W.	50.52
✓ Shi. in 12" Hickory N.N.W.	60.23

✓ Conc. man. Broke	W. N. 2. (N. 6.)	35.37
✓ Conc. man. Not Plumb	N. E.	35.70 35.87
Conc. man. (Gone)	N. of E.	19.45 19.76
✓ Shi. in T. Pole	S. E.	25.45' 25.63
✓ Shi. in 14" spruce	N. E.	38.62'
✓ Shi. in 14" spruce	N. N. E.	49.78
Shi. in P. Pole	S. W.	56.66'

S. to x-on N. and W. about.	No Good	8.60'
E.S.E. to x-on N. and E. about.	No Good	36.50'
N.S.E. to shiner in T.P.		52.57 52.55
N.S.W. to shiner in P.P.		37.85
N.W. to mory. (leaning) Plumb		36.83'
N. shi. in T. Pole	N.W.	40.55
N. shi. in T. Pole	N.E.	79.32

✓ Stone W. of Wedge of post.	16.2'
✓ E. of C.B. S.E.	2.0'
1st iron fence post N.N.W. Gone	16.20'
Iron sign post stake S.S.W.	13.0'
✓ Anchor post W.	5.60'
Shi. in '30" oak S.E.	88.40'
Shi. in T.P. N.N.E.	109.20'

Br. oak	10"	SE.	1.77'
Center of C.B.		SW.	24 Lbs