

O.D.O.T. DISTRICT 2 SURVEY OFFICE (USE ONLY)

PERSONNEL

REFERENCE NO. 8

SHEET 5 OF 26

NOTES PRESTON-COLVIN

DATE 8-2-24

ROUTE SR 235

H.C. ASTON

WEATHER CLOUDY

COUNTY WOOD

R.C. NIESE

TEMP. 73°

TOWNSHIP JACKSON

DWG BY PRESTON-COLVIN PID CHIPSEAL

SECTION 14

T 3 N R 9 E

TYPE MONUMENT MAG/WASHER

~~ON SURFACE~~ - BELOW 1"

OFFSET Q PAVEMENT 10.5' ~~LT~~ : RT

ON TO RT EDGE PAVEMENT

STATION: 186+45.24

HORIZ.DATUM: NAD83 (2011)


GEOID: 2018

GRID: NORTHING: 567202.4013

EASTING: 1615101.2521

LDP: NORTHING: 389553.2

EASTING: 126993.9

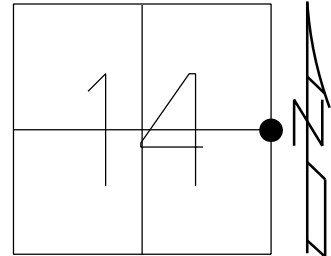


RECORD:
SET SM R.R. SPIKE
6-26-86, MDB

GPS REF8
8-27-15

SET MAG/WASHER
GPS, NEWREF8
7-28-16,DCH

FD MAG/WASHER
REF7
8-2-24,TDN

FD MAG/WASHER
9-18-24,TDN

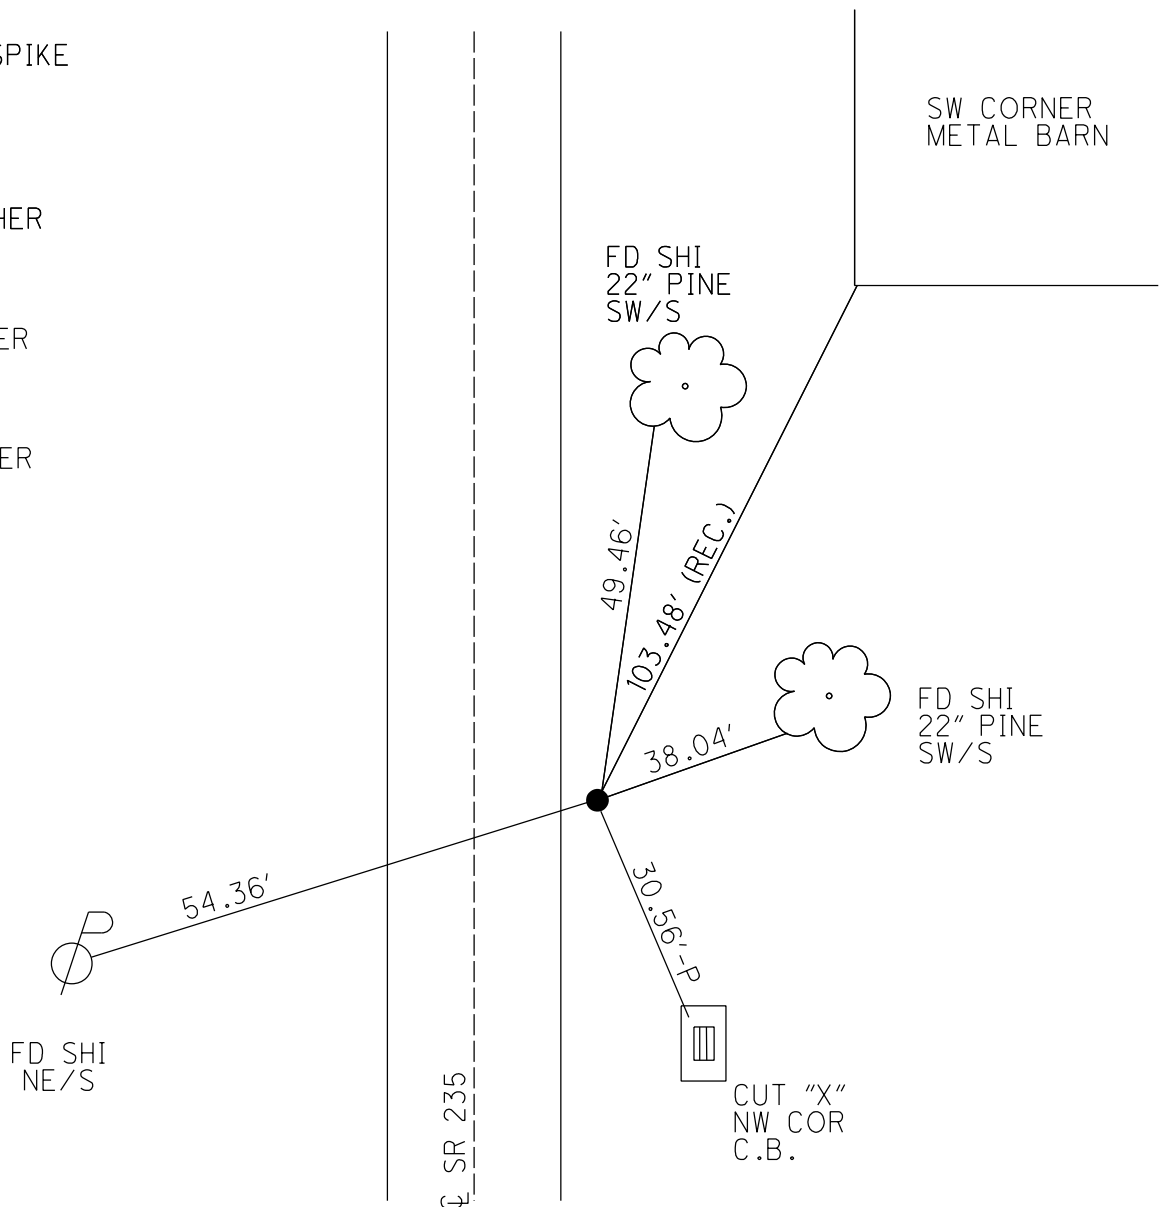

O.D.O.T. DISTRICT 2 SURVEY OFFICE (USE ONLY)

PERSONNEL	REFERENCE NO. <u>8</u>	SHEET <u>5</u> OF <u>26</u>
NOTES <u>RHOADES</u>	DATE <u>8-27-15</u>	ROUTE <u>SR 235</u>
H.C. <u>O'DONNELL</u>	WEATHER <u>CLOUDY</u>	COUNTY <u>WOOD</u>
R.C. <u>RHOADES</u>	TEMP. <u>70°F</u>	TOWNSHIP <u>JACKSON</u>
		SECTION <u>14</u>
		T <u>3</u> N R <u>9</u> E

TYPE MONUMENT PK/WASHER


~~ON SURFACE~~ - BELOW 1"

~~LEFT~~ - Q PAV'T - RIGHT 10.5'

ON TO RT EDGE PAVEMENT

S.L.M. 186+45.24


Grid: Northing: 568202.4013 Easting: 1615101.2521

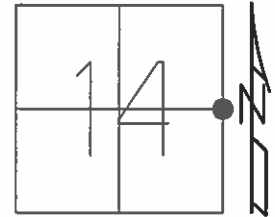

RECORD:
SET SM R.R. SPIKE
6-26-86, MDB

GPS REF8
8-27-15

SET MAG/WASHER
GPS, NEWREF8
7-28-16, DCH

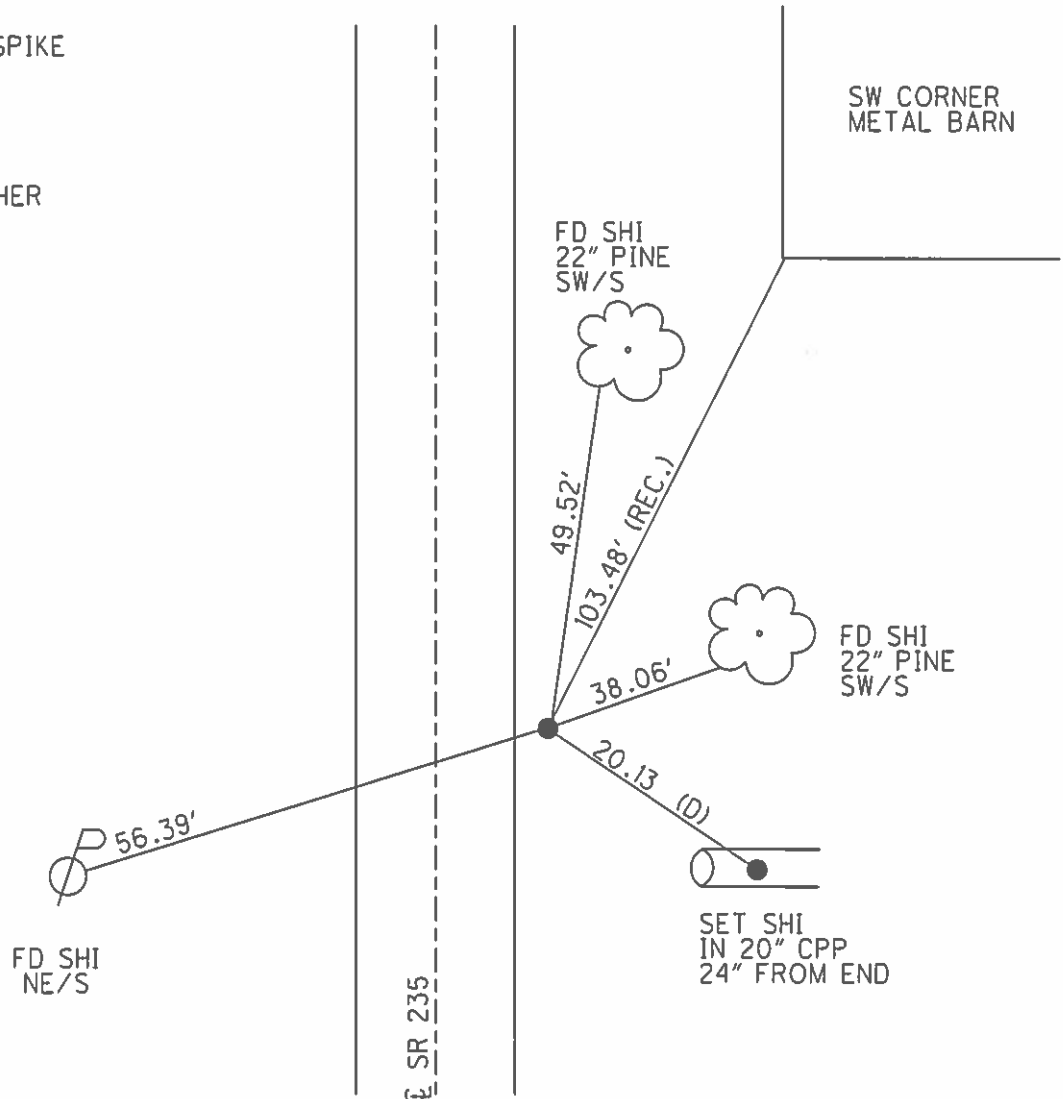

O.D.O.T. DISTRICT 2 SURVEY OFFICE

PERSONNEL

REFERENCE NO. 8

SHEET 4 OF 23

NOTES Homan

DATE 9-24-03

ROUTE 235

H.C. Nuhfer

WEATHER Rain

COUNTY WOOD

R.C. Ballmer

TEMP. 50°

TOWNSHIP JACKSON

SECTION 14

T 3 N R 9 E


TYPE MONUMENT PK & Washer

ON SURFACE - BELOW on surface

~~LEFT~~ - ~~CL~~ ~~PAV'T~~ - ~~RIGHT~~ 10.5


1' L TO RT EDGE PAVEMENT

S.L.M. 185+56

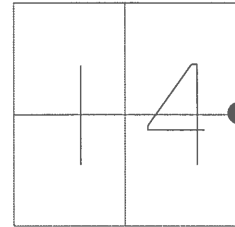

Set Sm R.R. Spike
6-26-86
MDB

POINT NOT DISTURBED 2003

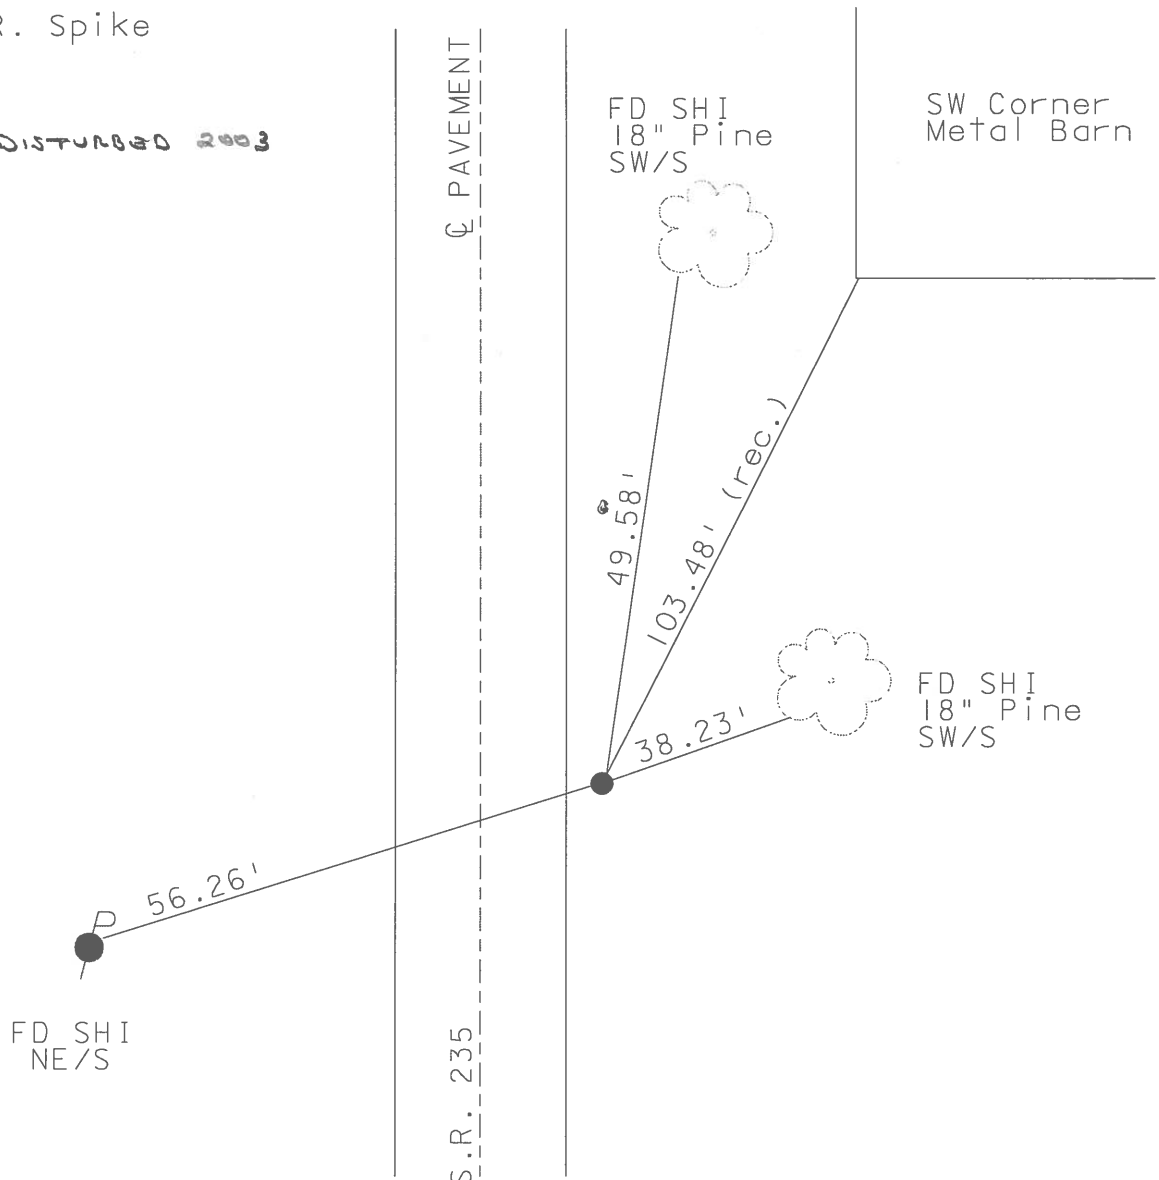

O.D.O.T. DISTRICT 2 SURVEY OFFICE

PERSONNEL

REFERENCE NO. 8

SHEET 3 OF 28

NOTES HUSS

H.C. MOSEB

R.C. HUSS

DATE 5-21-96

WEATHER SUNNY

TEMP. +69°F

ROUTE 235

COUNTY WOOD

TOWNSHIP JACKSON

SECTION 14

T 3 N R 9 E


TYPE MONUMENT Lg. R.R. Spk

ON SURFACE - BELOW 2"

LEFT-~~E~~ PAV'T. - RIGHT 10.5

1" LT TO RT. EDGE PAVEMENT

S.L.M. 185 +56

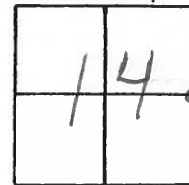

RECORD:

SET SM. RR SPK
6-26-86
MDB

SET PK/WASAER
10-7-96
BUD

S.R. 235

S.W. COR.
METAL
BARN

FO SHI
18" PINE
SW/S

49.69'
35.45'

103.48 (REC.)

CONC. MON
IRON PIN

38.34'

FO SHI 18" PINE
SW/S

56.26'

SET SHI
NE/S

E PAVT

O.D.O.T. DISTRICT 2 SURVEY OFFICE

PERSONNEL

REFERENCE NO. 8

SHEET OF

NOTES BARNHISEL

H.C. Loehrke

R.C. HOFFMAN

DATE 6-3-86

WEATHER Sunny

TEMP. +52°

ROUTE 235

COUNTY WOOD

TOWNSHIP JACKSON

SECTION 14

T 3 N R 9 E

TYPE MONUMENT Lg RR Spk



ON SURFACE - BELOW 2"

LEFT - & PAV'T. - RIGHT 10.5

1/4 TO RT EDGE PAVEMENT Berm

S.L.M. 185+56

Set Sm RR Spk
6-26-86
MDB

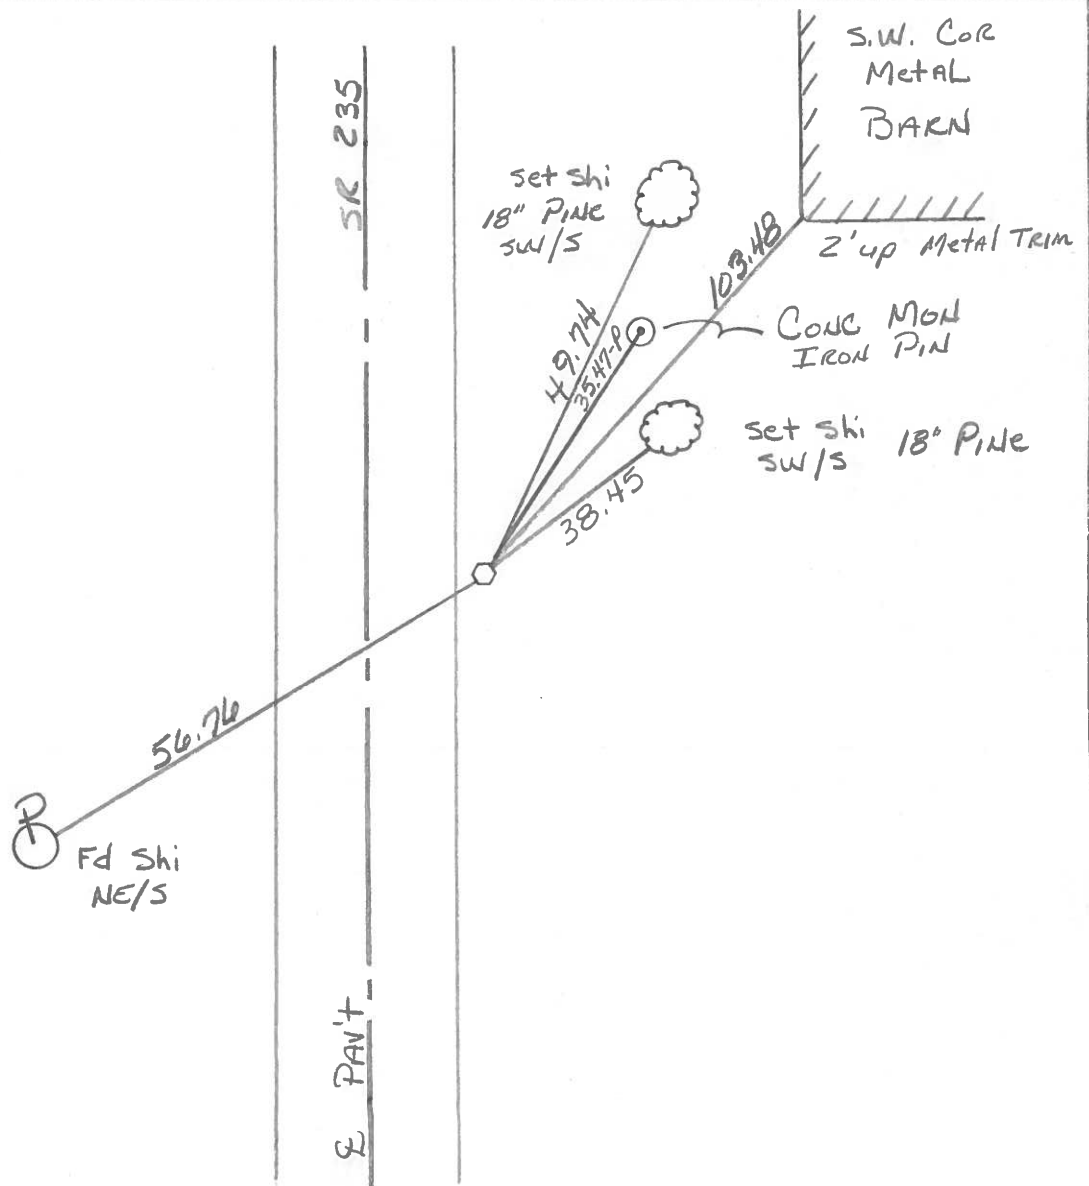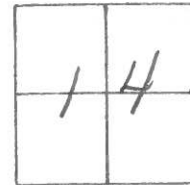

PERSONNEL TITLE PERSONNEL TITLE
 MORRISON _____
 COUNTY Wood. DATE April, 23, 1969
 S. R. #235 old SR#69 WEATHER Cloudy & Windy
 SEC from SR#18 North. TEMP. +40°

DESCRIPTION Ties to Control Points LEFT CENTER LINE RIGHT JOB NO.

