

O.D.O.T. DISTRICT 2 SURVEY OFFICE (USE ONLY)

PERSONNEL

REFERENCE NO. 9

SHEET 6 OF 26

NOTES ASTON

DATE 8-21-24

ROUTE SR 235

H.C. NIESE

WEATHER CLEAR

COUNTY WOOD

R.C. PRESTON-COLVIN

TEMP. 65°

TOWNSHIP JACKSON

SECTION 14

DWG BY PRESTON-COLVIN PID CHIPSEAL

T 3 N R 9 E

TYPE MONUMENT MONBOX

~~ON SURFACE~~ - BELOW 1"

OFFSET $\varnothing$ PAVEMENT 19.0' LT : ~~RT~~

9.8' TO RT EDGE PAVEMENT

STATION: 213+50.79

HORIZ.DATUM: NAD83 (2011)


GEOID: 2018

GRID: NORTHING: 570907.9

EASTING: 1615120

LDP: NORTHING: 392258.8

EASTING: 126976.7

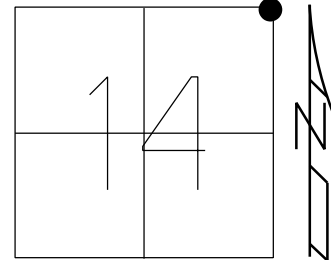

RECORD:
SET SM R.R. SPIKE
6-26-86, MDB


FD STONE
IN MONBOX
GPS, REF9

NEWMONBOX
8-27-15

FD STONE IN MONBOX
1.5' DEEP
REF9

8-21-24, TDN

FD MONBOX
9-18-24

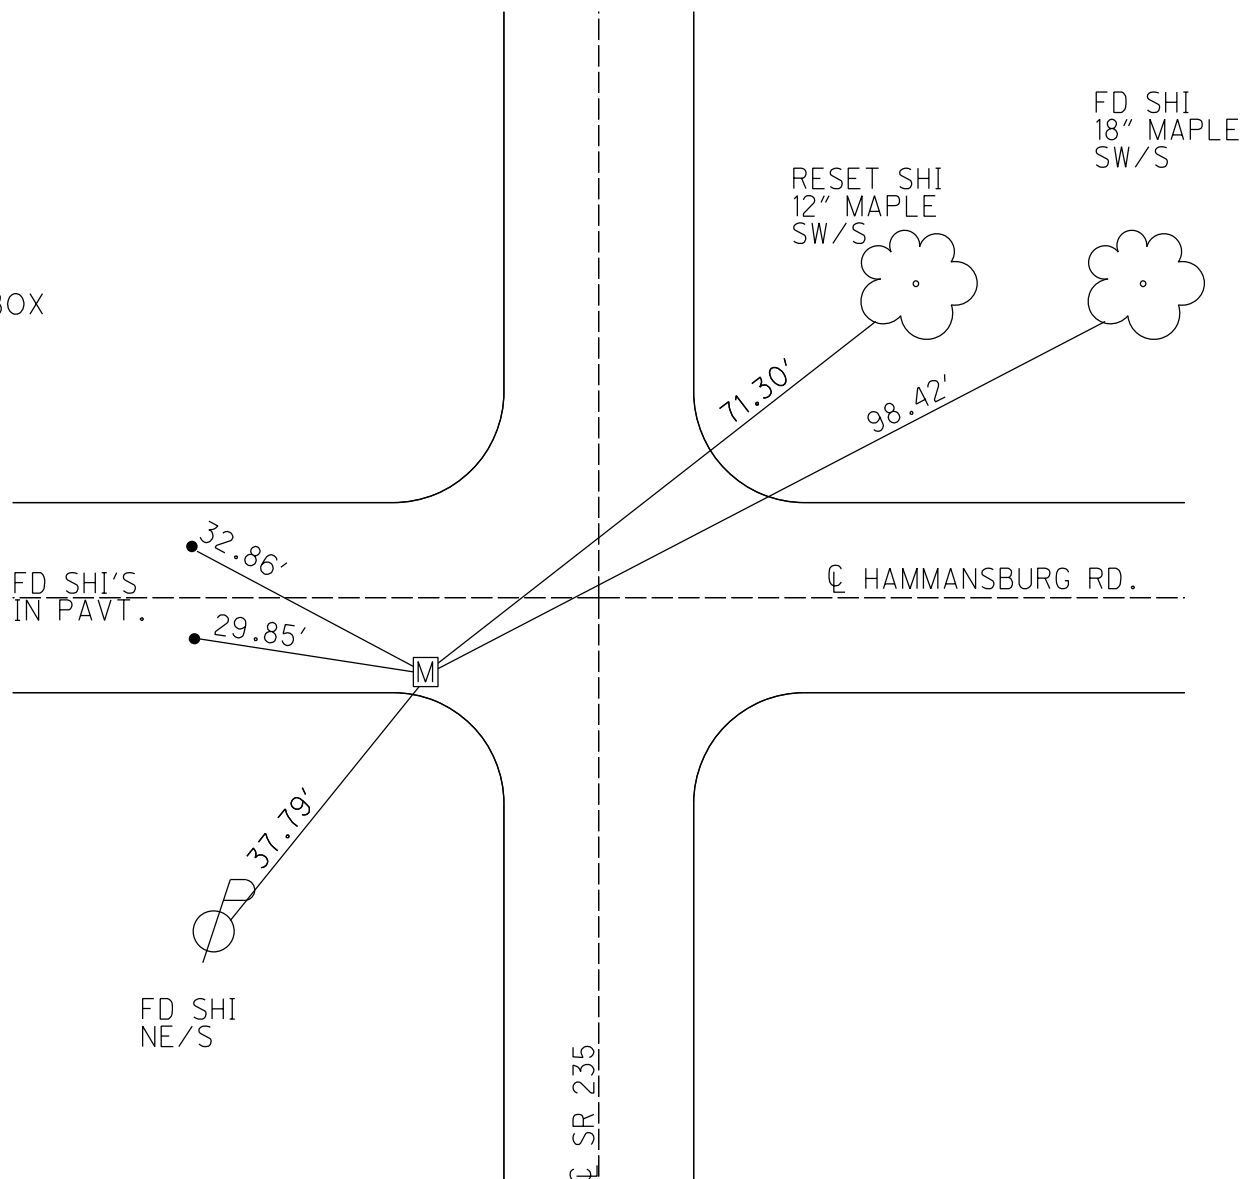

O.D.O.T. DISTRICT 2 SURVEY OFFICE (USE ONLY)

PERSONNEL

REFERENCE NO. 9

SHEET 6 OF 26

NOTES RHOADES

DATE 8-27-15

ROUTE SR 235

H.C. O'DONNELL

WEATHER CLOUDY

COUNTY WOOD

R.C. RHOADES

TEMP. 50°F

TOWNSHIP JACKSON

SECTION 14

T 3 N R 9 E

TYPE MONUMENT MONBOX


~~ON SURFACE~~ - BELOW 1"

LEFT - Q PAV'T - ~~RIGHT~~ 19.0'

9.8' TO RT EDGE PAVEMENT

S.L.M. 213+50.79

Grid: Northing: 570908.022 Easting: 1615119.846

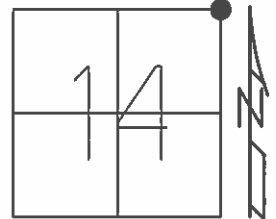

RECORD:
SET SM R.R. SPIKE
6-26-86, MDB

FD STONE
IN MONBOX
GPS, REF9

NEWMONBOX
8-27-15

FD SHI
18" MAPLE
SW/S


RESET SHI
12" MAPLE
SW/S

FD SHI'S
IN PAVT.

Q HAMMANSBURG RD.

Q SR 235

FD SHI
NE/S

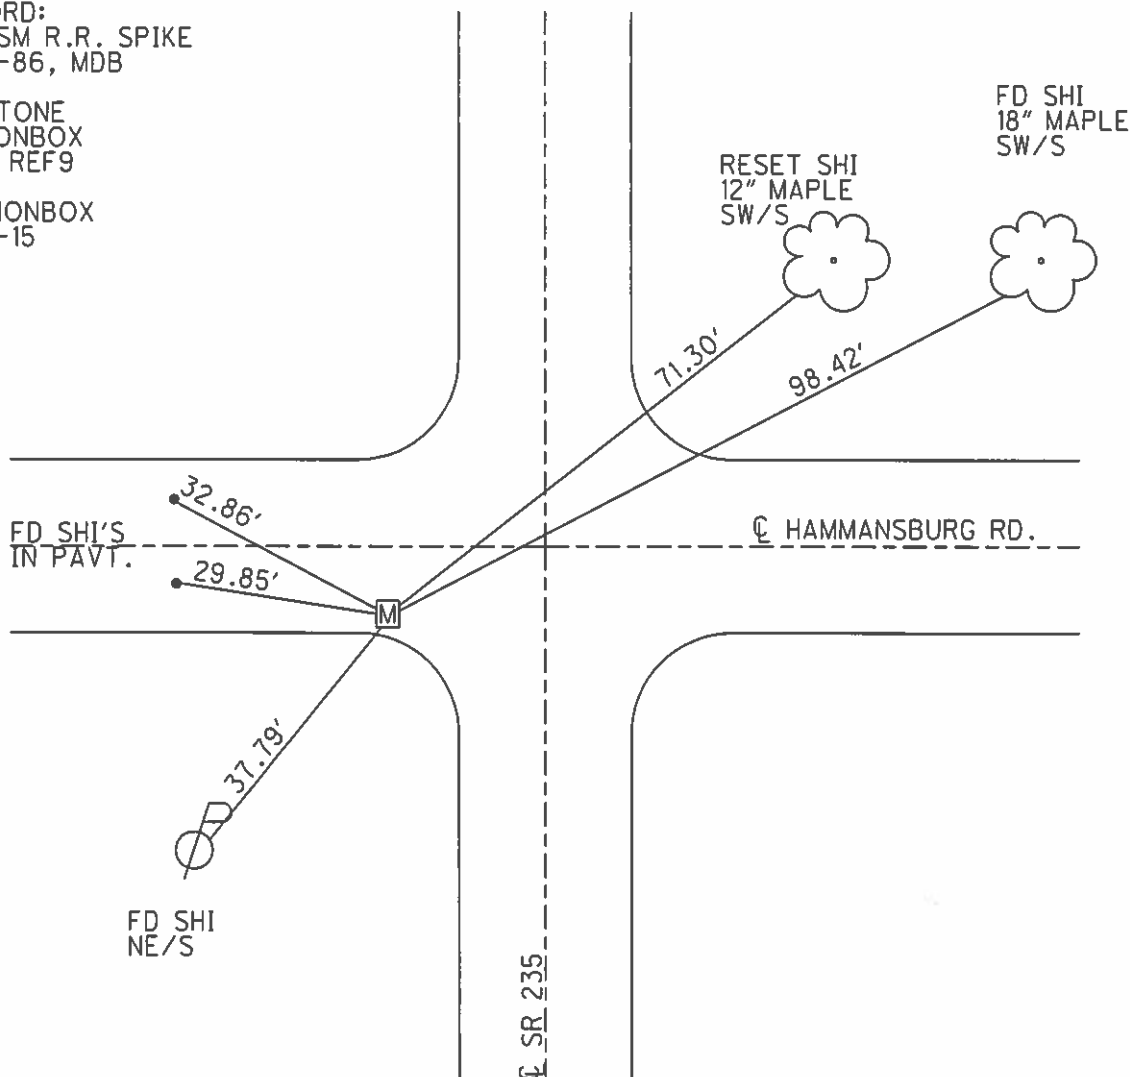

O.D.O.T. DISTRICT 2 SURVEY OFFICE

PERSONNEL

REFERENCE NO. 9

SHEET 5 OF 23

NOTES Homan

DATE 9-24-03

ROUTE 235

H.C. Nuhfer

WEATHER Rain

COUNTY WOOD

R.C. Ballmer

TEMP. 50°

TOWNSHIP JACKSON

SECTION 14

T 3 N R 9 E


TYPE MONUMENT Sm R.R. Spike

~~ON SURFACE~~ - BELOW 1"

~~LEFT - C PAV'T - RIGHT~~ 19,0'

9.8 TO RT EDGE PAVEMENT

S.L.M. 212+64 (8' S of C Hamm Rd W)

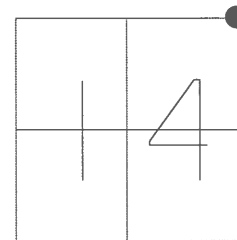


Set Sm R.R. Spike
6-26-86
MDB

POINT NOT DISTURBED 2003

Reset SHI
12" Maple
SW/S

FD SHI
18" Maple
SW/S

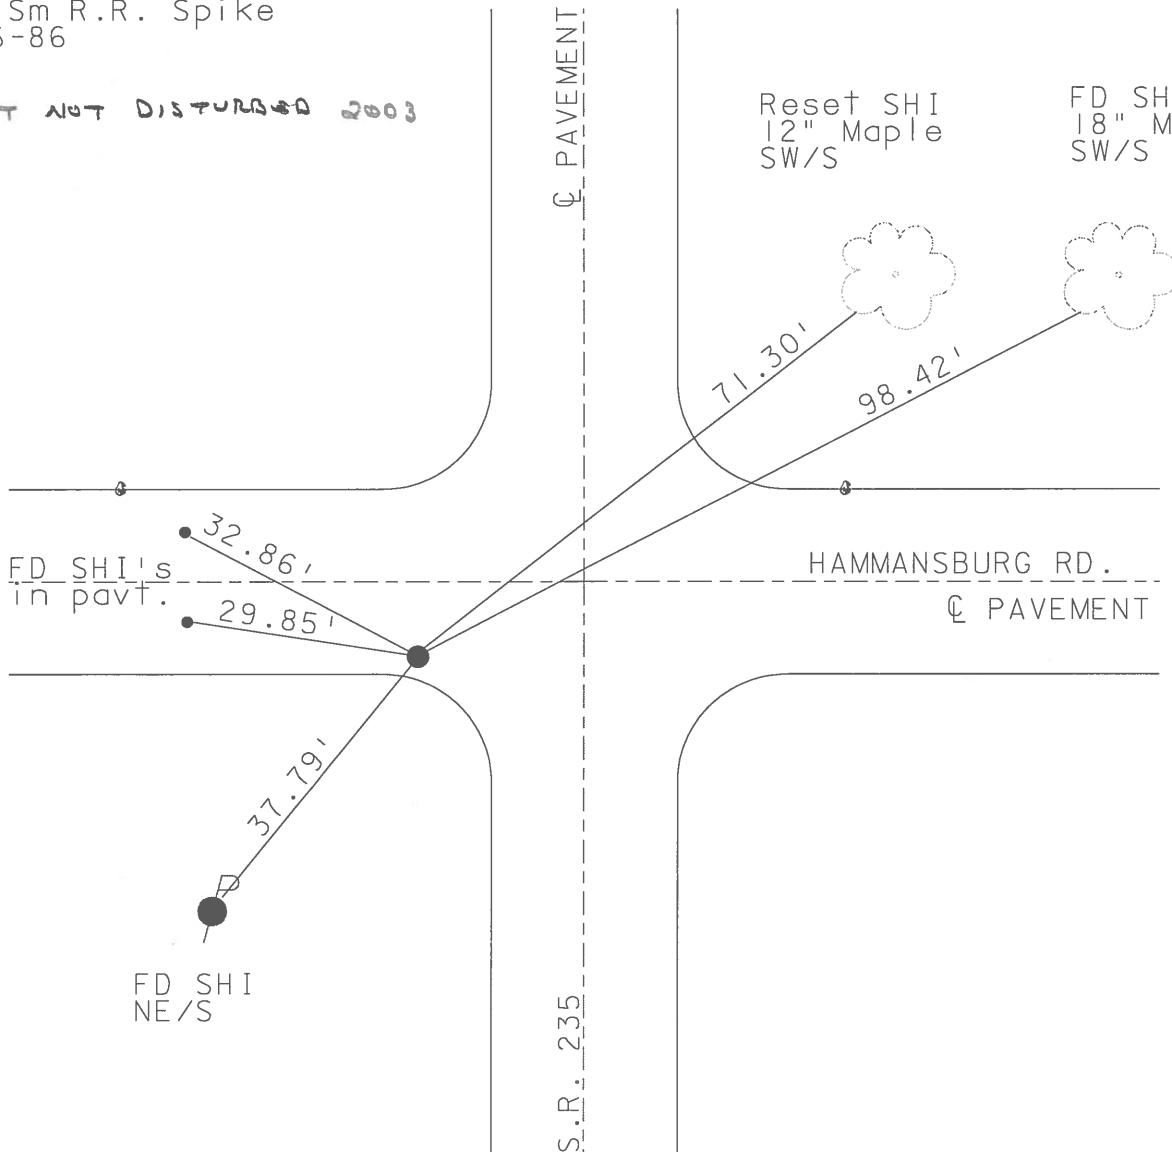

O.D.O.T. DISTRICT 2 SURVEY OFFICE

PERSONNEL

REFERENCE NO. 9

SHEET 4 OF 28

NOTES Huss

H.C. Moser

R.C. Huss

DATE 5-21-96

WEATHER Sunny

TEMP. +69°F

ROUTE 235

COUNTY Wood

TOWNSHIP Jackson

SECTION 14

T 3 N R 9 E


TYPE MONUMENT Sm RR Spk

ON SURFACE - ~~BENOW~~ Yes

LEFT - & PAV'T. - RIGHT 19.0'


9.8' TO Rt. EDGE PAVEMENT

S.L.M. 212+64 (8' S. of & Hamm Rd W.)

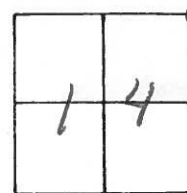

Record Set Sm RR Spk
6-26-86
MWB

Set PK/Washen
10-7-96
BUD

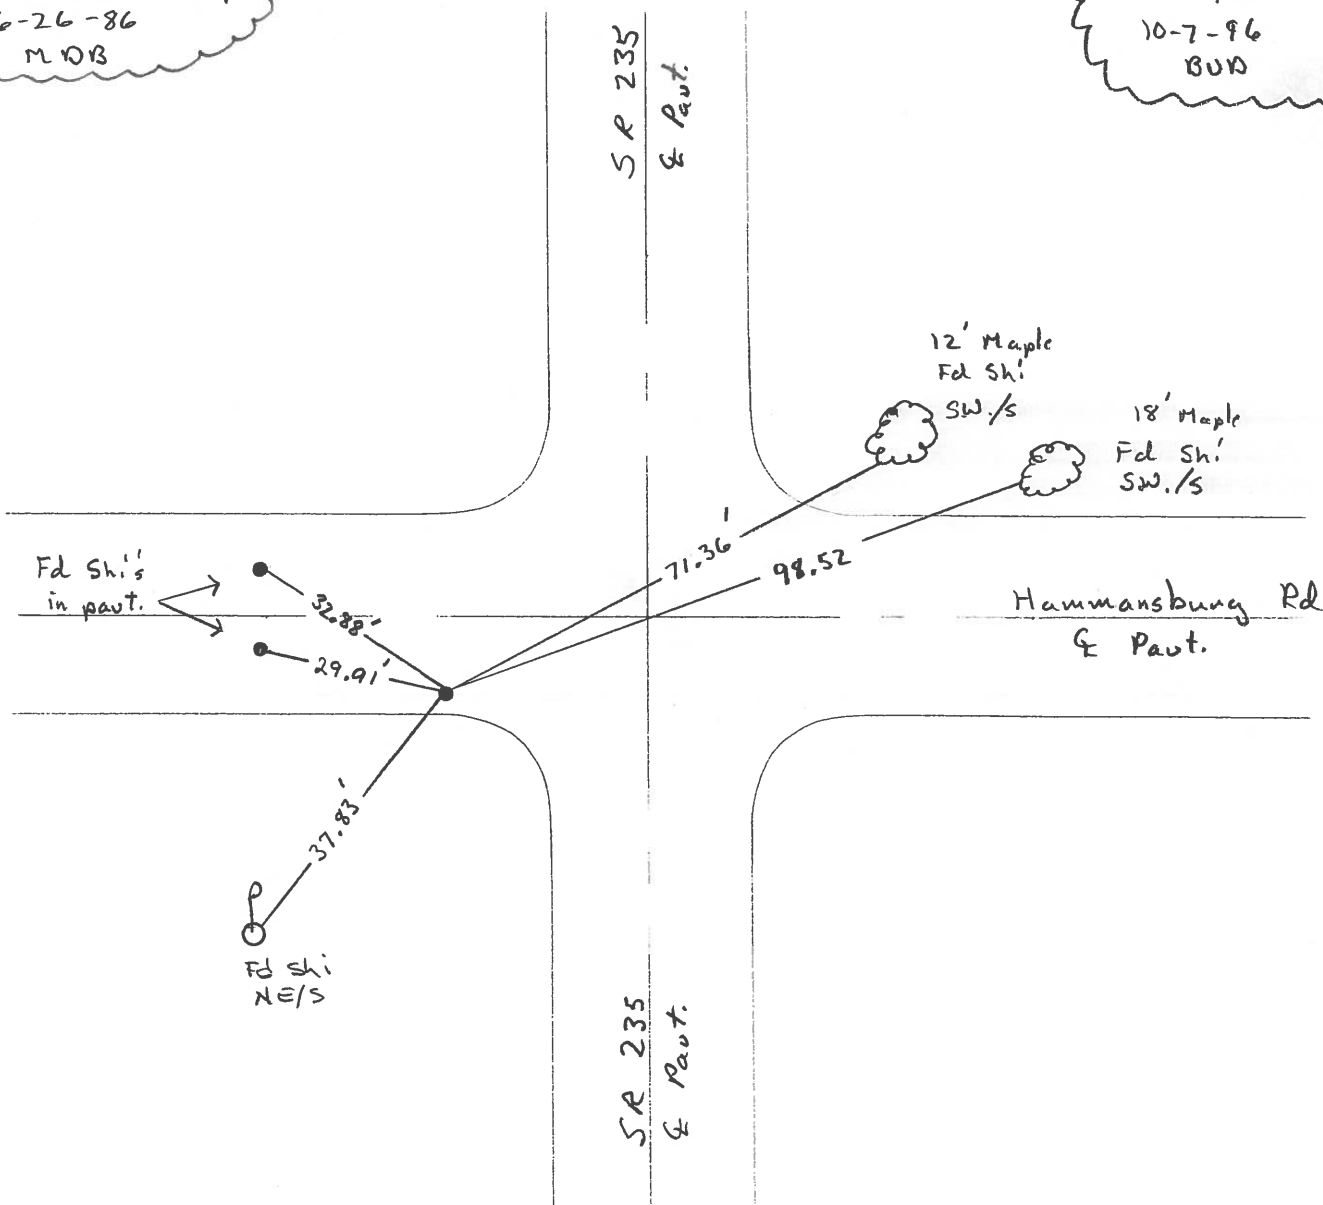

O.D.O.T. DISTRICT 2 SURVEY OFFICE

PERSONNEL

REFERENCE NO. 9 SHEET OF

NOTES BARNHISEL

H.C. Loehrke

R.C. HOFFMAN

DATE 6-3-86

WEATHER SUNNY

TEMP. + 52°

ROUTE 235

COUNTY WOOD

TOWNSHIP JACKSON

SECTION 14

T 3 N R 9 E

TYPE MONUMENT 5m RR Spk

ON SURFACE - BELOW yes



LEFT- & PAV'T. - RIGHT 19.0

- TO - EDGE PAVEMENT

S.L.M. 212+54

8' S. of & Hamm. Rd W.


Set 5m RR Spk
6-26-86
M.D.B.

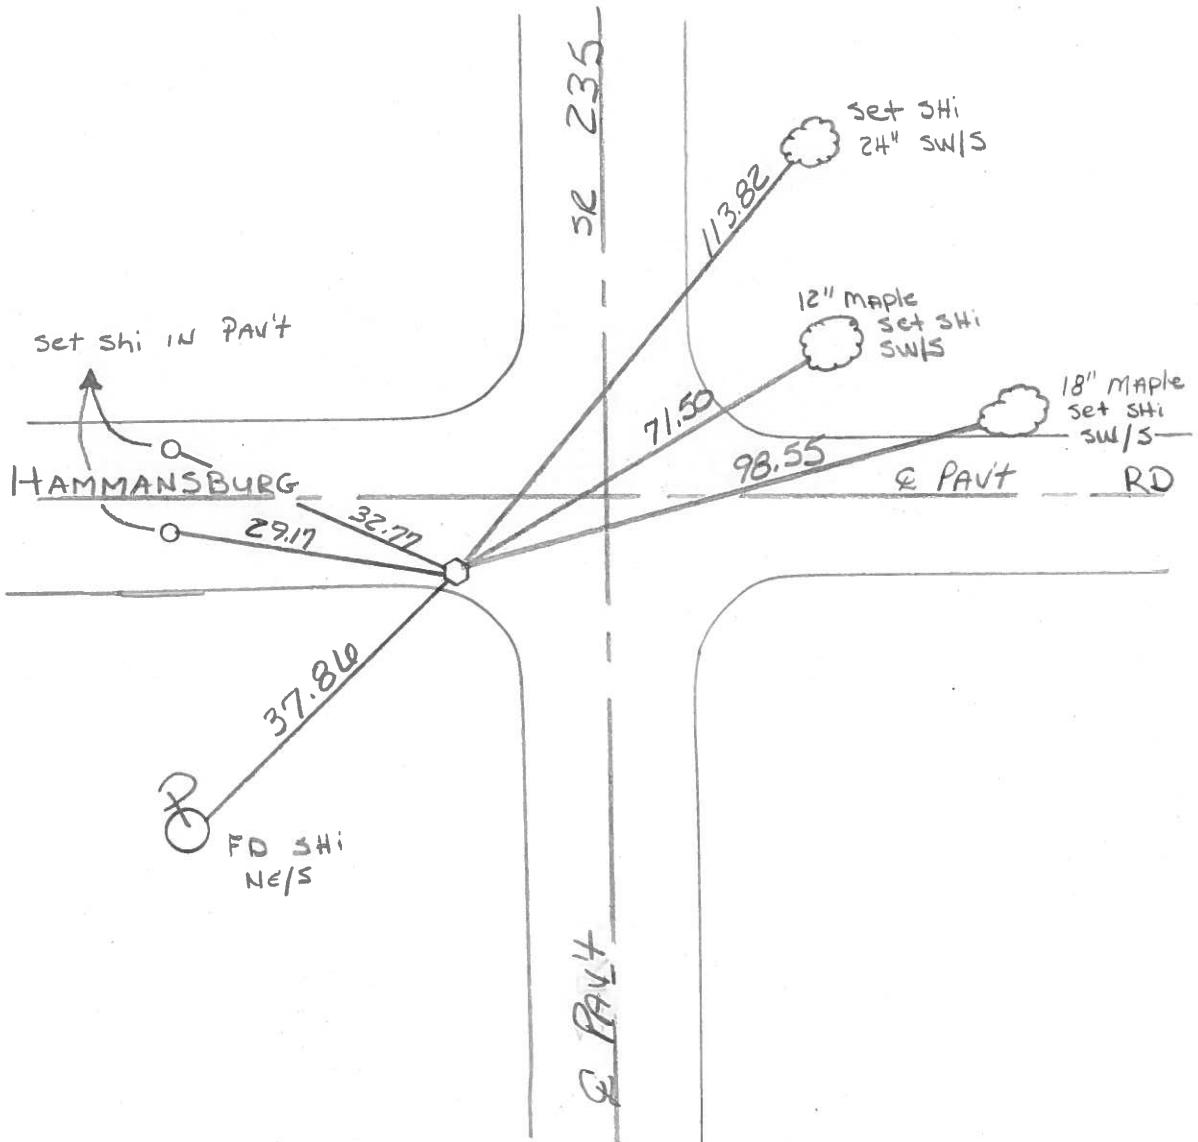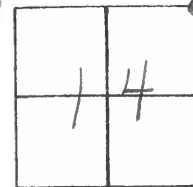

PERSONNEL	TITLE	PERSONNEL	TITLE	COUNTY	DATE
BURNSIDE				WOOD	12-8-75
SMITH				S. R. 235	WEATHER Cloudy
BOWERS				SEC. HAMMANSBURG RD.	TEMP. +36°
MEAD					

DESCRIPTION ± CONTROL TIES

LEFT CENTER LINE RIGHT JOB NO.

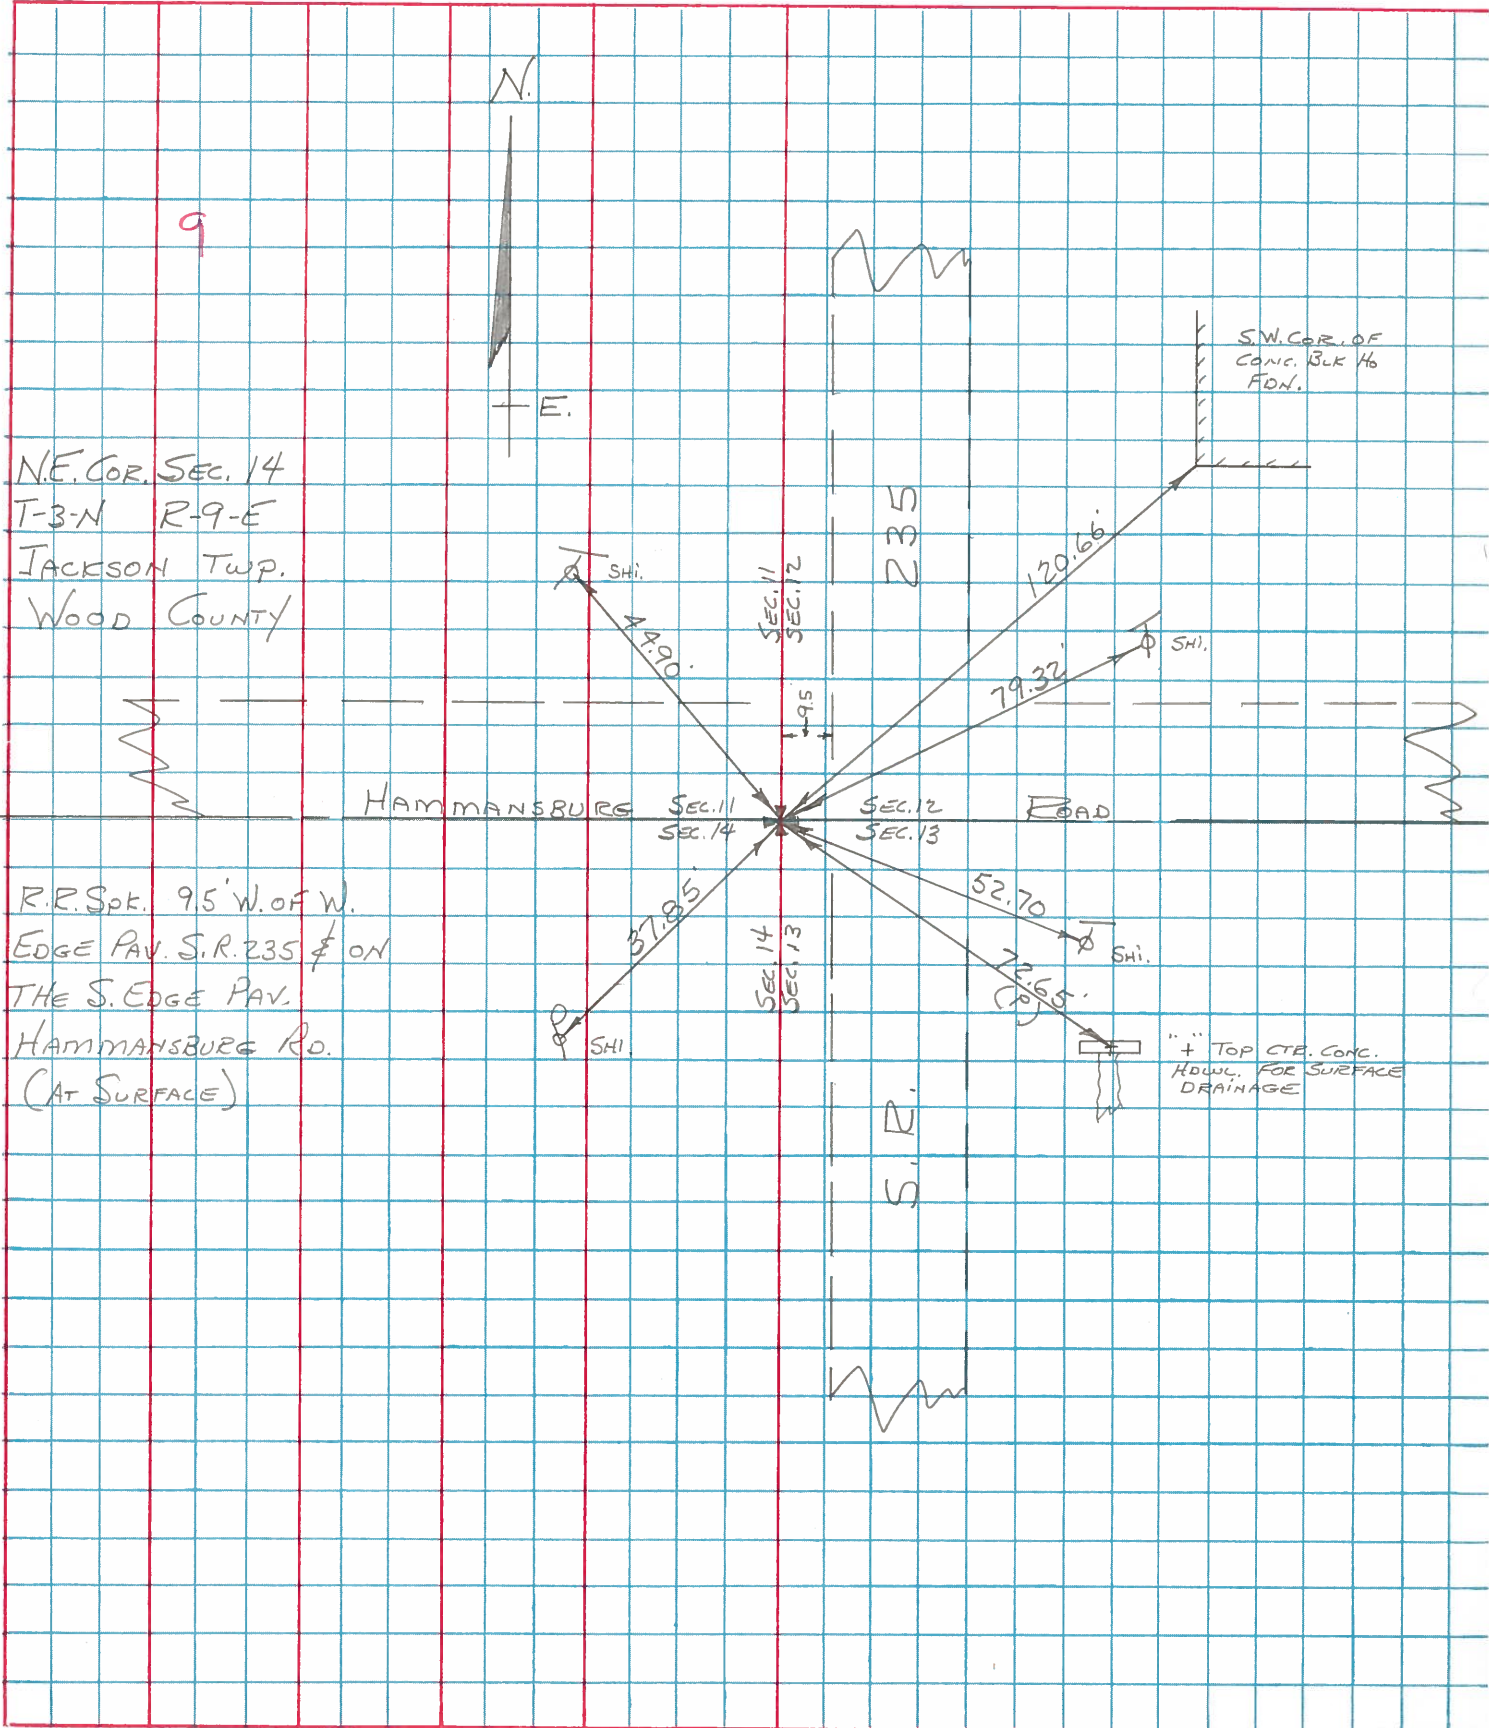

PERSONNEL TITLE PERSONNEL TITLE

COUNTY Wood.

DATE April 23, 1969

S. R. #235 (old SR#69) WEATHER Cloudy & Rain

SEC. Hammansburg Rd. North TEMP. $\pm 45^{\circ}$

DESCRIPTION

Ties to Control points

LEFT

CENTER LINE

RIGHT

JOB NO.


#64

#8

(9)

N.E. Cor. Sec. #14 Jackson Twp.
Hammansburg Road.

Checked ties OK. 7-25-69 Morrison & Silvester

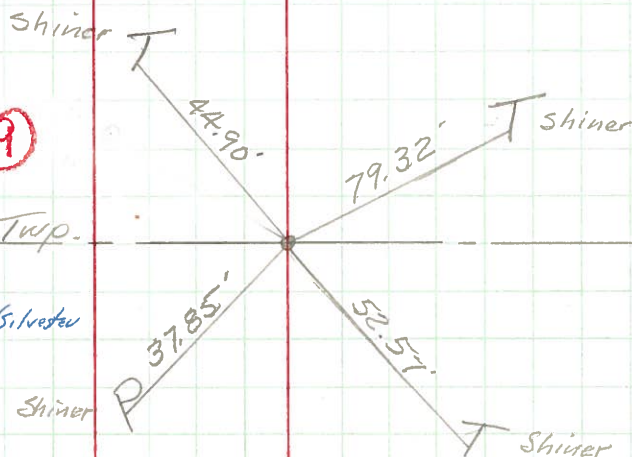

#65

#9

(9A)


Checked ties OK. 7/25/69 Morrison & Silvester

Stone in bottom of ditch.

W 1/4 of SW 1/4 Sec. #12

Jackson Twp.

Stone is W. of W. Edge Pavmt 16.2

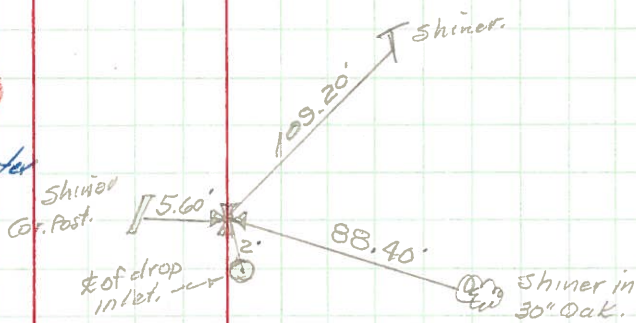

#66 E 1/4 Post Sec. #11 Jackson Twp. wit. gone

(10)

#67

#11


RR Spk. 8.90' West of W. edge pavement.

S.W. Cor. Sec. #1 Jackson Twp.

Checked ties OK 7/25/69 Morrison & Silvester

S.E. Cor. of S. Hdwl S.W. 20.91'

N.E. Cor. of N. Hdwl N.W. 10.51'

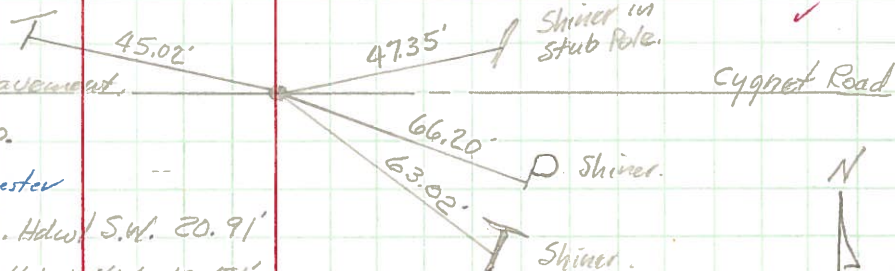

PERSONNEL

TITLE

PERSONNEL

TITLE

COUNTY Wood

DATE OK 12-13-57

S. R. #69

WEATHER 4-14-60
1-18-66

SEC. A, B, C

TEMP.

DESCRIPTION From Hoytsville - North

JOB NO.

LEFT

CENTER LINE

RIGHT

S.E. cor. sec. 14 Jackson
Twp. Iron pin over
stone. O. Center Rd.

#62

7

E. 1/4 post sec. 14 Jackson
Twp. Iron pin over stone
2' E. of E. Edge Part

#63

8

N.E. Cor. sec. 14 Jackson
Twp. E.P. spk. over stone
Hammansburg Rd.

#64

9

W. 1/4 of the S.W. 1/4 sec. 12
Found stone

#65

9-A

E. 1/4 post sec. 11 Jackson
Twp. (Ties No Good 12-13-57)
" " " (1-18-66)

#66

10

✓ Shi. in 12" Hickory N.W. 46.38
 ✓ Shi. in Tele. Pole N.E. 26.95
 Conc. man. (No Go) N.E. 25.72
 ✓ Conc. man. (Leaning) N.W. 32.00 31.51
 Conc. man. (Gone) W.S.W. 34.0
 ✓ Vertical pipe of water well S.W. 50.5
 ✓ Shi. in 12" Hickory N.N.W. 60.23

Conc. man. Broke W.N.W. (N.G.) 35.3
 ✓ Conc. man. Not Plumb N.E. 35.70 35.81
 Conc. man. (Gone) N. of E. 19.45 19.76
 ✓ Shi. in T. Pole S.E. 25.45 25.63
 ✓ Shi. in 14" spruce N.E. 38.62
 ✓ Shi. in 14" spruce N.N.E. 49.78
 Shi. in P. Pole S.W. 56.66

S. to x-on N. end W. about, No Good 8.60'
 E.S.E. to x-on N. end E. about, No Good 36.50'
 ✓ S.E. to shiner in T.P. 52.57 52.55
 ✓ S.S.W. to shiner in P.P. 37.85
 ✓ N.W. to man. (Leaning) Plumb 36.83'
 ✓ Shi. in T. Pole N.W. 40.55
 ✓ Shi. in T. Pole N.E. 79.32

✓ Stone W. of wedge of part. 16.2'
 ✓ E. of C.B. S.E. 2.0'
 1st iron fence post N.N.W. Gone 16.20'
 Iron sign post stake S.S.W. 13.0'
 ✓ Anchor post W. 5.60'
 Shi. in 30" oak S.E. 88.40
 Shi. in T.P. N.N.E. 109.20

Br. oak 10" S.E. 1.97'
 Center of C.B. S.W. 24 lbs