

O.D.O.T. DISTRICT 2 SURVEY OFFICE (USE ONLY)

PERSONNEL

REFERENCE NO. 9A

SHEET 7 OF 26

NOTES ASTON

DATE 8-21-24

ROUTE SR 235

H.C. NIESE

WEATHER CLEAR

COUNTY WOOD

R.C. PRESTON-COLVIN

TEMP. 65°

TOWNSHIP JACKSON

SECTION 11

DWG BY PRESTON-COLVIN PID CHIPSEAL

T 3 N R 9 E

TYPE MONUMENT STONE

~~ON SURFACE~~ - BELOW 8"

OFFSET Q PAVEMENT 24' LT : ~~RT~~

14' TO LT EDGE PAVEMENT

STATION: 226+40.03

HORIZ.DATUM: NAD83 (2011)


GEOID: 2018

GRID: NORTHING: 572198

EASTING: 1615114


LDP: NORTHING: 393548.9

EASTING: 126953.9

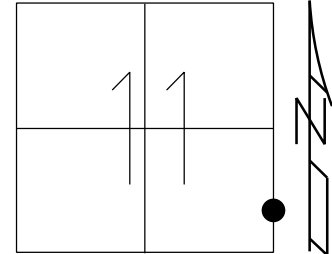

RECORD:
FD STONE
8" BELOW
GPS, REF10
10-22-14

FD STONE
REF10
8-21-24,TDN

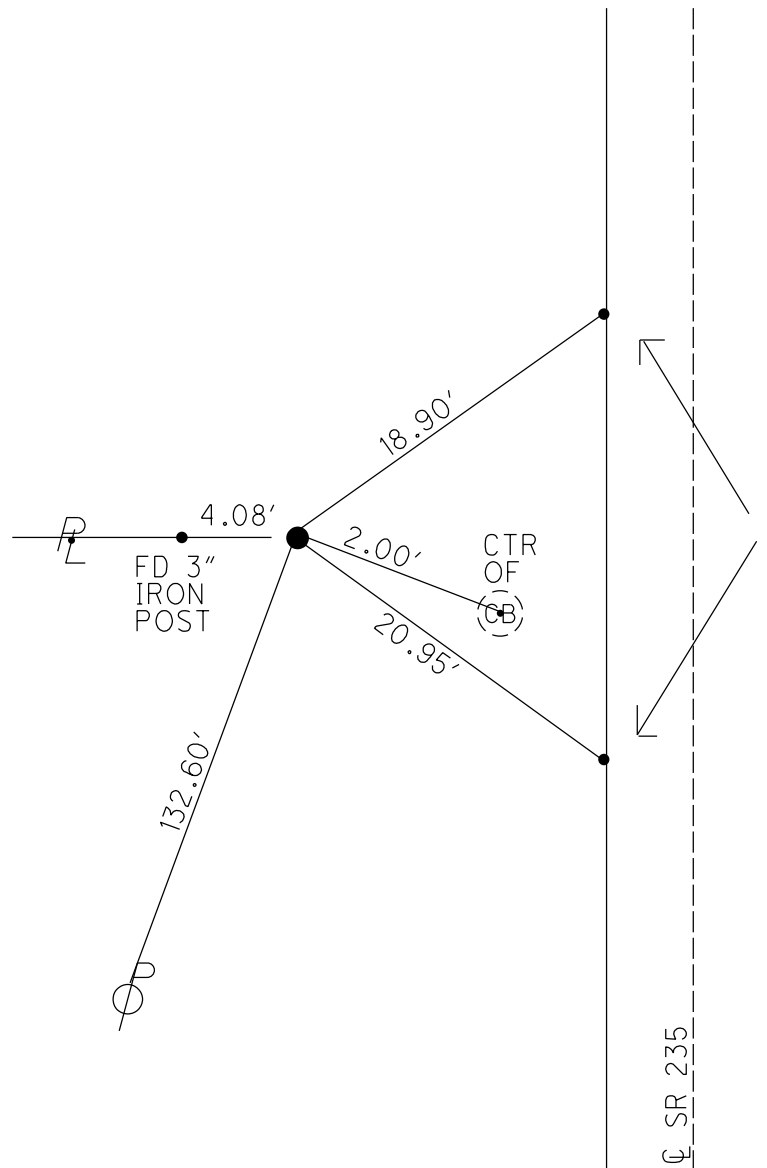

PK & WASHER
ON WHITE LINE
10-7-96 BVD

Q SR 235

O.D.O.T. DISTRICT 2 SURVEY OFFICE (USE ONLY)

PERSONNEL

REFERENCE NO.

9 A

SHEET 7 OF 26

NOTES RHOADES

DATE 8-27-15

ROUTE SR 235

H.C. O'DONNELL

WEATHER CLOUDY

COUNTY WOOD

R.C. RHOADES

TEMP. 50°F

TOWNSHIP JACKSON

SECTION 11

T 3 N R 9 E

TYPE MONUMENT STONE


~~ON SURFACE~~ - BELOW 8"

LEFT - Q PAV'T - ~~RIGHT~~ 24.0'


14' L TO LT EDGE PAVEMENT

S.L.M. 226+40.03

Grid: Northing: 572198.049 Easting: 1615114.001

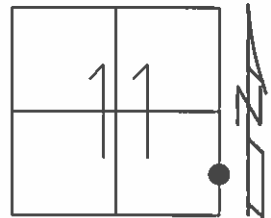

RECORD:
FD STONE
8" BELOW
GPS, REF10
10-22-14

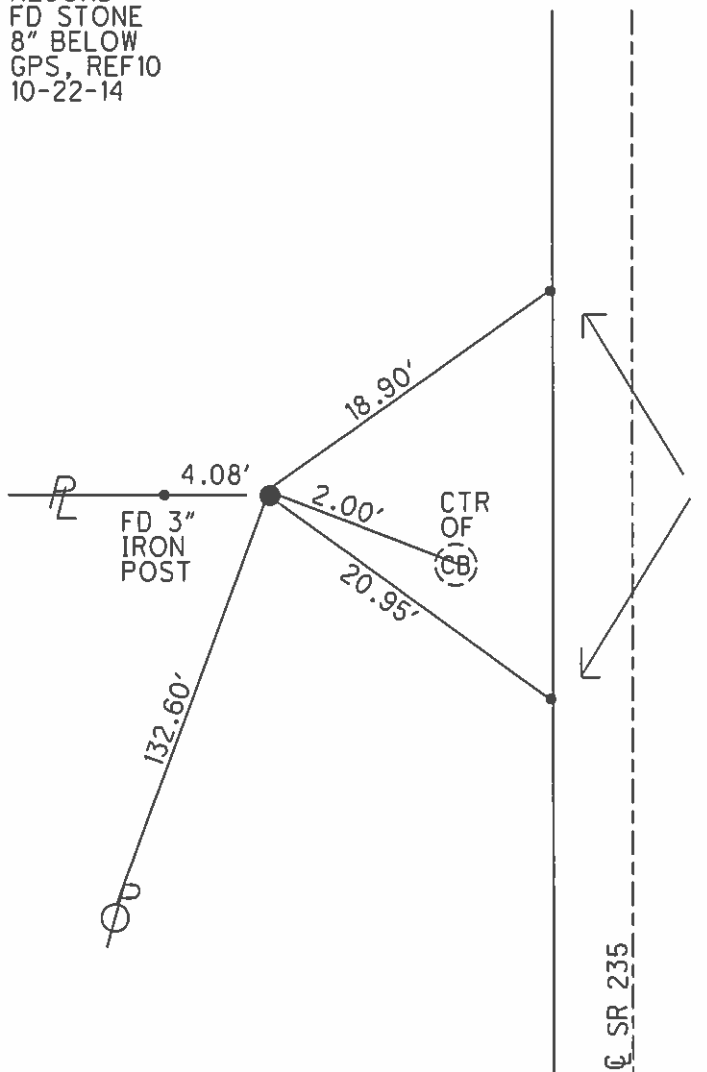

PK & WASHER
ON WHITE LINE
10-7-96 BVD

O.D.O.T. DISTRICT 2 SURVEY OFFICE

PERSONNEL

REFERENCE NO. 9-A

SHEET 6 OF 23

NOTES Homan

DATE 9-24-03

ROUTE 235

H.C. Nuhfer

WEATHER cloudy

COUNTY WOOD

R.C. Ballmer

TEMP. 50°

TOWNSHIP JACKSON

SECTION 11

T 3 N R 9 E


TYPE MONUMENT Stone

~~ON SURFACE~~ - BELOW 4"


~~LEFT - C PAV'T - RIGHT~~ 24.0'

14' L TO LT EDGE PAVEMENT

S.L.M. 225+37

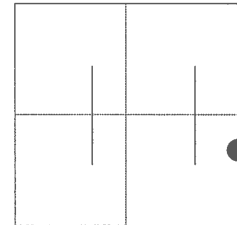

Point Not Disturbed 2003

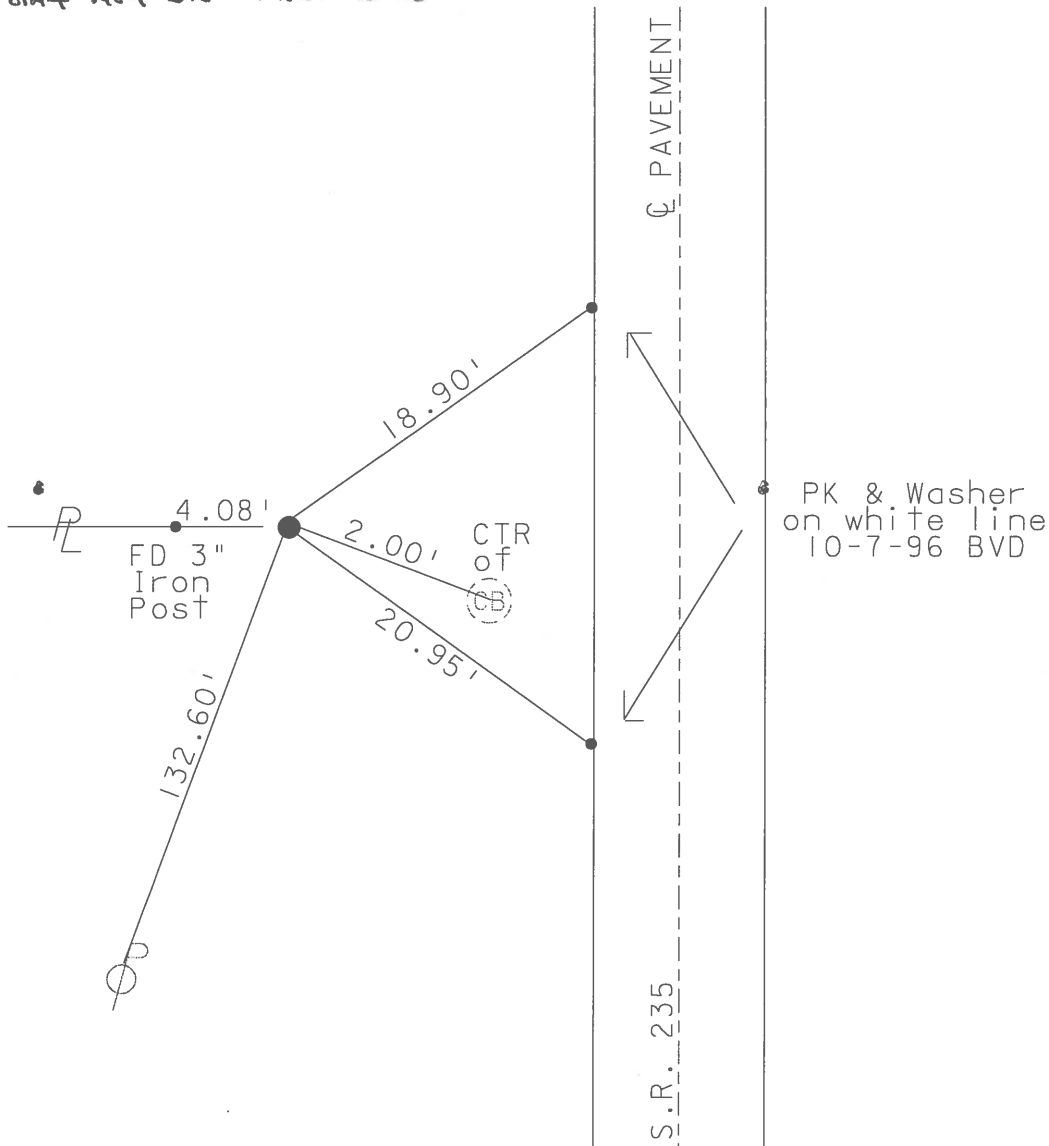

O.D.O.T. DISTRICT 2 SURVEY OFFICE

PERSONNEL

REFERENCE NO. 9-A

SHEET 5 OF 28

NOTES HUSS

H.C. MOSEB

R.C. HUSS

DATE 5-21-96

WEATHER SUNNY

TEMP. +71°F

ROUTE 235

COUNTY WOOD

TOWNSHIP JACKSON

SECTION 11

T 3 N R 9 E



TYPE MONUMENT STONE

ON SURFACE - BELOW YES

LEFT - ~~C~~ PAV'T. - RIGHT 24.0'

14' LT TO LT EDGE PAVEMENT

S.L.M. 225+37

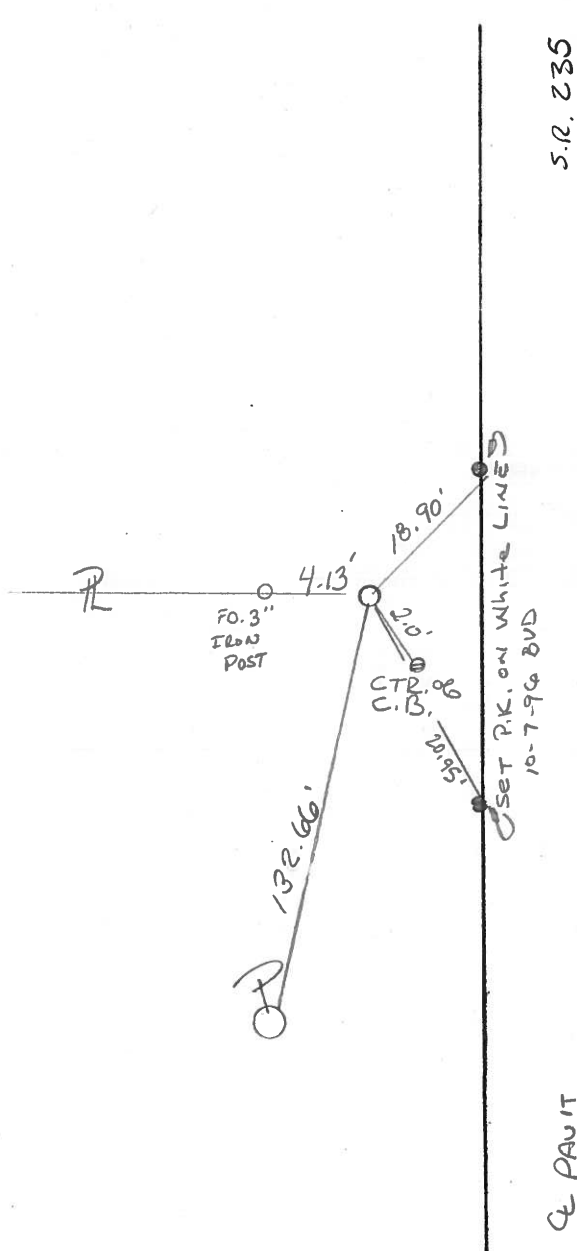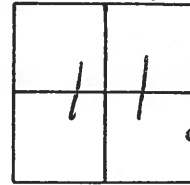

O.D.O.T. DISTRICT 2 SURVEY OFFICE

PERSONNEL

REFERENCE NO. 9-A SHEET OF

NOTES BARNHISEL

H.C. Loehrke

R.C. HOFFMAN

DATE 6-3-86

WEATHER SUNNY

TEMP. +52°

ROUTE 235

COUNTY WOOD

TOWNSHIP JACKSON

SECTION 11

T 3 N R 9 E



TYPE MONUMENT STONE

ON SURFACE - ~~BELOW~~ YES

LEFT - ~~Q~~ PAV'T. - ~~RIGHT~~ 24'

14.6 TO LT EDGE PAVEMENT

S.L.M. 225+47

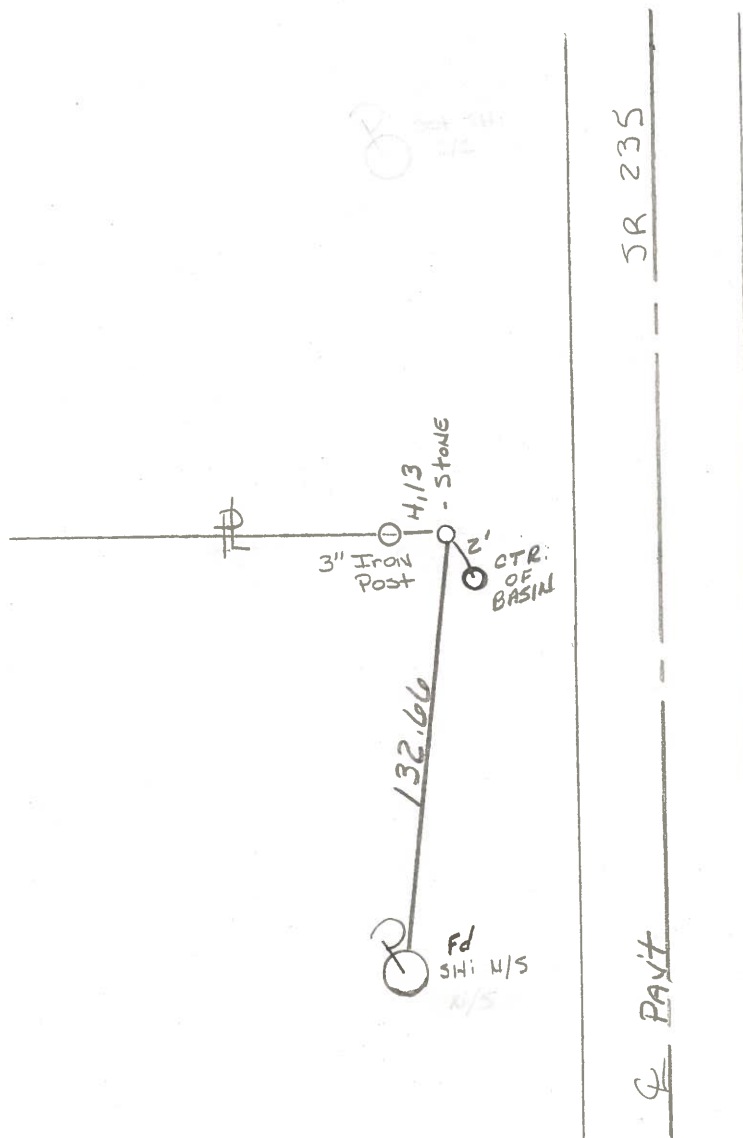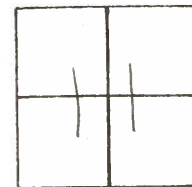

PERSONNEL TITLE PERSONNEL TITLE
 BURNSIDE
 SMITH
 BOWERS
 MEAD

COUNTY Wood

DATE 12-17-75

S. R. 235

WEATHER Cloudy

SEC. 12 & 11

TEMP. +20°

DESCRIPTION & CONTROL TIES

LEFT


CENTER LINE

RIGHT

JOB NO.

10
 E 1/4 Post SEC. 11
 T-3-N R-9-E
 JACKSON TWP.
 WOOD COUNTY

Co. TIES GOOD
 SET 1/2" I. PIPE

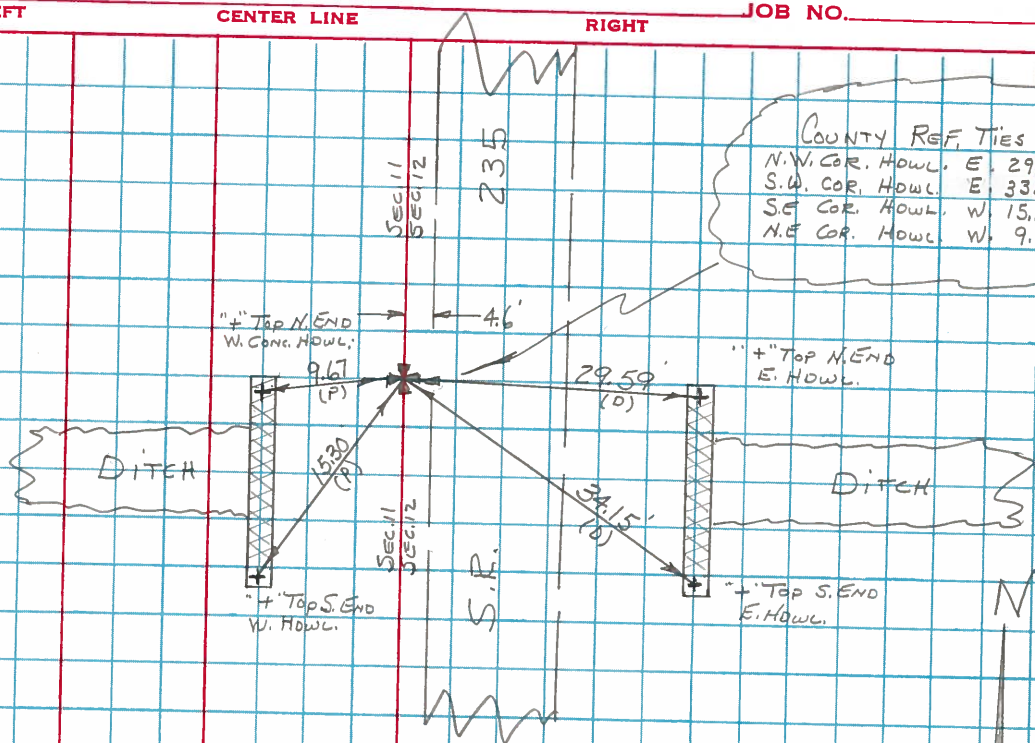


COUNTY REF. TIES
 N.W. COR. HOWL. E. 29.0'
 S.W. COR. HOWL. E. 33.9'
 S.E. COR. HOWL. W. 15.10
 N.E. COR. HOWL. W. 9.0

9-A

W 1/4 OF S.W. 1/4 SEC. 12
 T-3-N R-9-E
 JACKSON TWP.
 WOOD COUNTY

STONE - 16.2' W. OF W. EDGE
 PAVE. IN BOTTOM OF
 ROADWAY DITCH

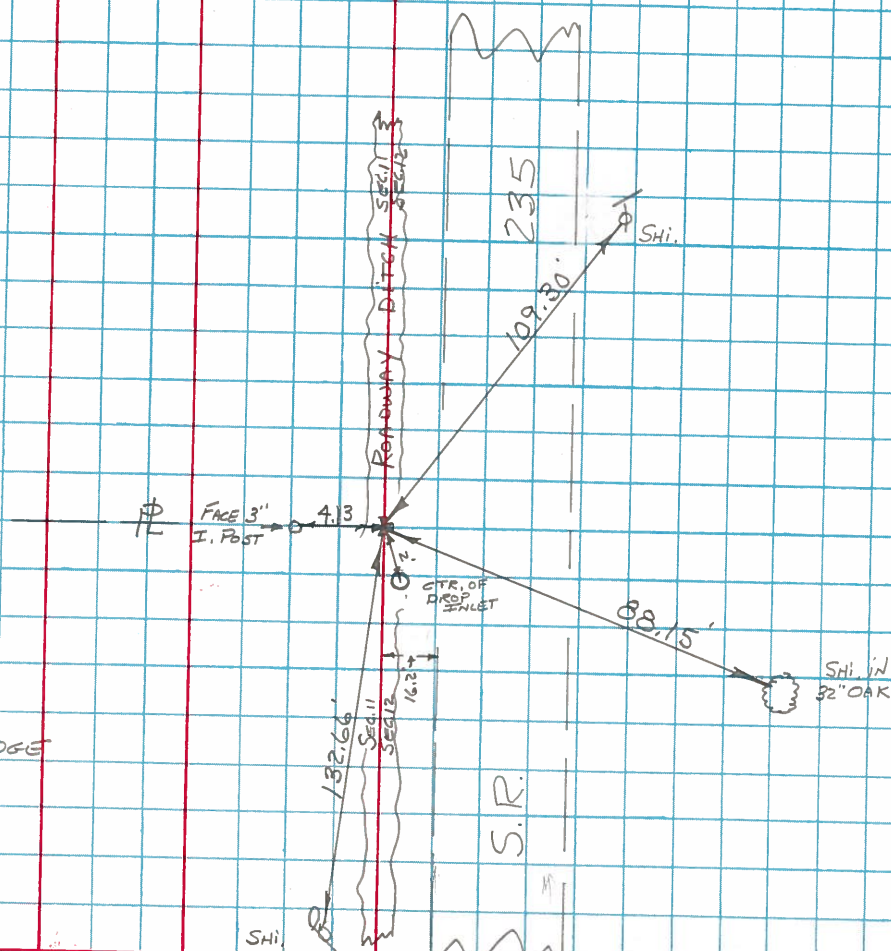

PERSONNEL TITLE PERSONNEL TITLE

COUNTY Wood. DATE April, 23, 1969S. R. #235 (old SR#69) WEATHER Cloudy & RainSEC. Hammansburg Ed. North TEMP. ± 45°DESCRIPTION Ties to Control points

JOB NO.

LEFT

CENTER LINE

RIGHT

#64

#8

(9)

N.E. Cor. Sec. #14 Jackson Twp.
Hammansburg Road
Checked Ties OK. 7-25-69 Morrison & Silvester

Shiner

44.90'

79.32'

Shiner

37.85'

52.57'

Shiner



#65

#9

(9A)

Checked Ties OK. 7/25/69 Morrison & Silvester
Stone in bottom of ditch.
W 1/4 of SW 1/4 Sec #12
Jackson Twp.
Stone 1/3 W. of W. Edge Permit 16.2

Shiner

Gr. Post

5.60'

2' of drop in let.

89.20'

Shiner

88.40'

Shiner in 30" Oak



#66 E 1/4 Post Sec. #11 Jackson Twp wit. gone

(10)

#67

#11

RR Spk. 8.90' West of Kledge pavement.
SW. Cor. Sec. #1 Jackson Twp.
Checked ties OK 7/25/69 Morrison & Silvester

45.02'

47.35'

Shiner in stub Pole

Cyphert Road

66.20'

63.02'

Shiner

Shiner

S.E. cor. of S. Hdwl S.W. 20.91'

N.E. cor. of N. Hdwl N.W. 10.51'

