

O.D.O.T. DISTRICT 2 SURVEY OFFICE (USE ONLY)

PERSONNEL

REFERENCE NO. 11

SHEET 9 OF 26

NOTES ASTON

DATE 8-21-24

ROUTE SR 235

H.C. NIESE

WEATHER CLEAR

COUNTY WOOD

R.C. PRESTON-COLVIN

TEMP. 65°

TOWNSHIP JACKSON

SECTION 11

DWG BY PRESTON-COLVIN PID CHIPSEAL

T 3 N R 9 E

TYPE MONUMENT MAG/WASHER

ON SURFACE - ~~BELOW~~ ON

OFFSET Q PAVEMENT 17.5" LT : ~~RT~~

- TO - EDGE PAVEMENT

STATION: 264+33.97

HORIZ.DATUM: NAD83 (2011)


GEOID: 2018

GRID: NORTHING: 575990.7

EASTING: 1615062

LDP: NORTHING: 397340.9

EASTING: 126851.9

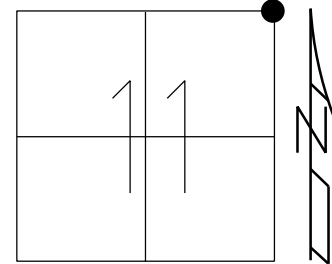


RECORD:
FD MAG SPIKE
@ SURFACE
GPS, REF12
10-22-14

GPS, REF11
8-27-15

SET MAG/WASHER
GPS, NEWREF11
7-28-16, DCH

FD MAG/WASHER
REF11
8-21-24, TDN

FD MAG/WASHER
9-18-24, TDN

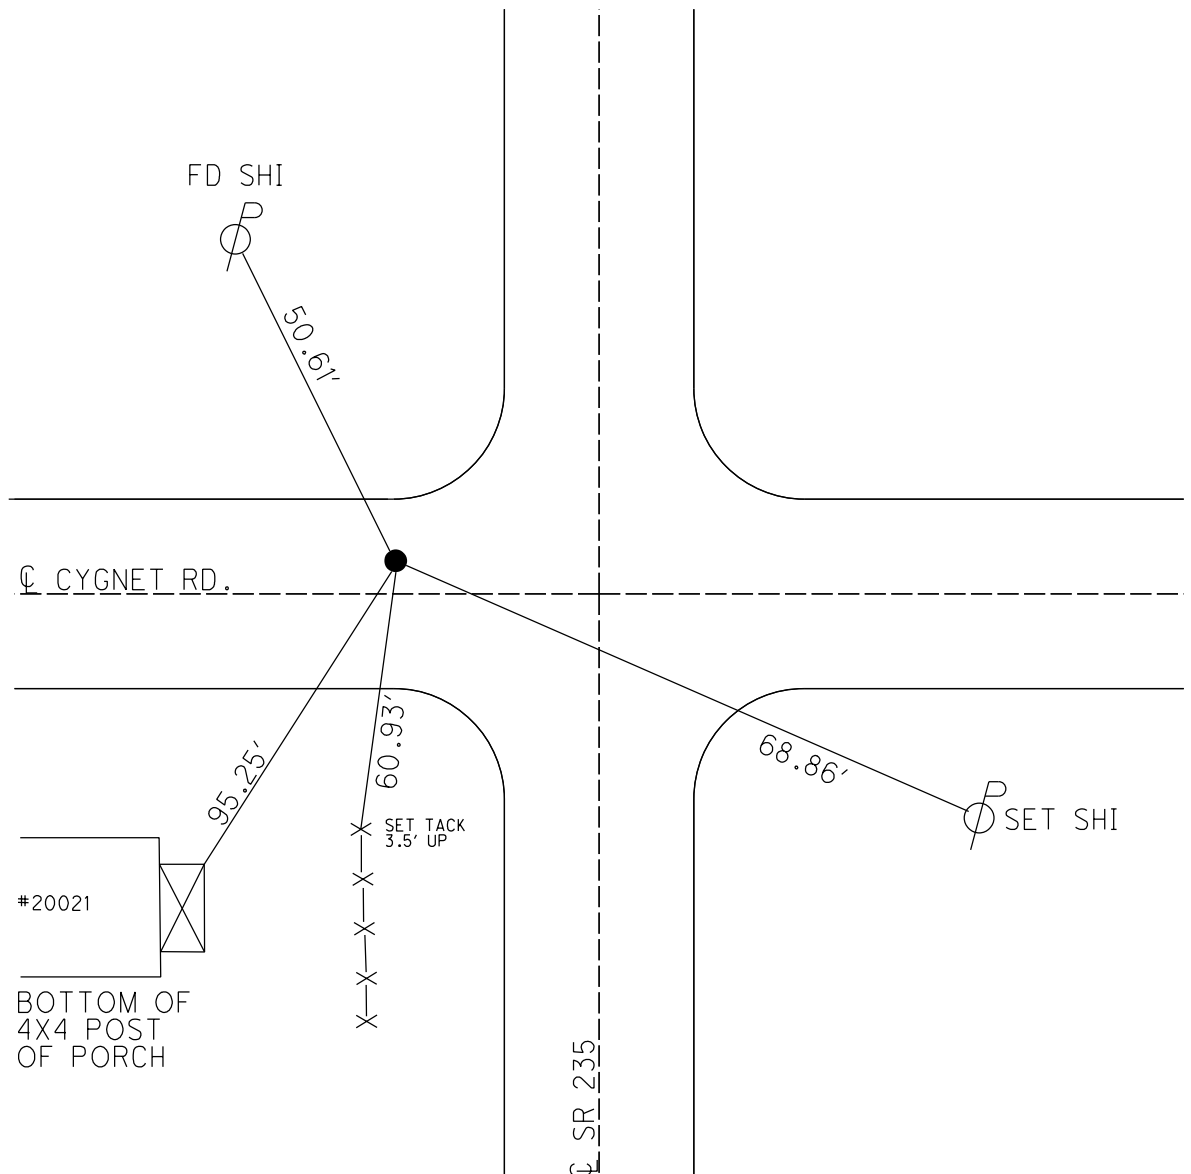

O.D.O.T. DISTRICT 2 SURVEY OFFICE (USE ONLY)

PERSONNEL

REFERENCE NO. 11

SHEET 9 OF 26

NOTES RHOADES

DATE 8-27-15

ROUTE SR 235

H.C. O'DONNELL

WEATHER SUNNY

COUNTY WOOD

R.C. RHOADES

TEMP. 62°F

TOWNSHIP JACKSON

SECTION 11

T 3 N R 9 E

TYPE MONUMENT MAG/WASHER


ON SURFACE - ~~BELOW~~ ON

LEFT - ℄ PAV'T - ~~RIGHT~~ 17.5'

- TO - EDGE PAVEMENT

S.L.M. 264+33.97

Grid: Northing: 575990.7971 Easting: 1615062.0183

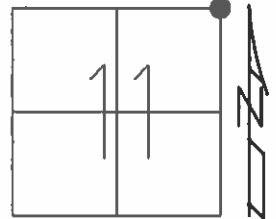


RECORD:
FD MAG SPIKE
@ SURFACE
GPS, REF12
10-22-14

GPS, REF11
8-27-15

SET MAG/WASHER
GPS, NEWREF11
7-28-16, DCH

FD SHI
SE/S

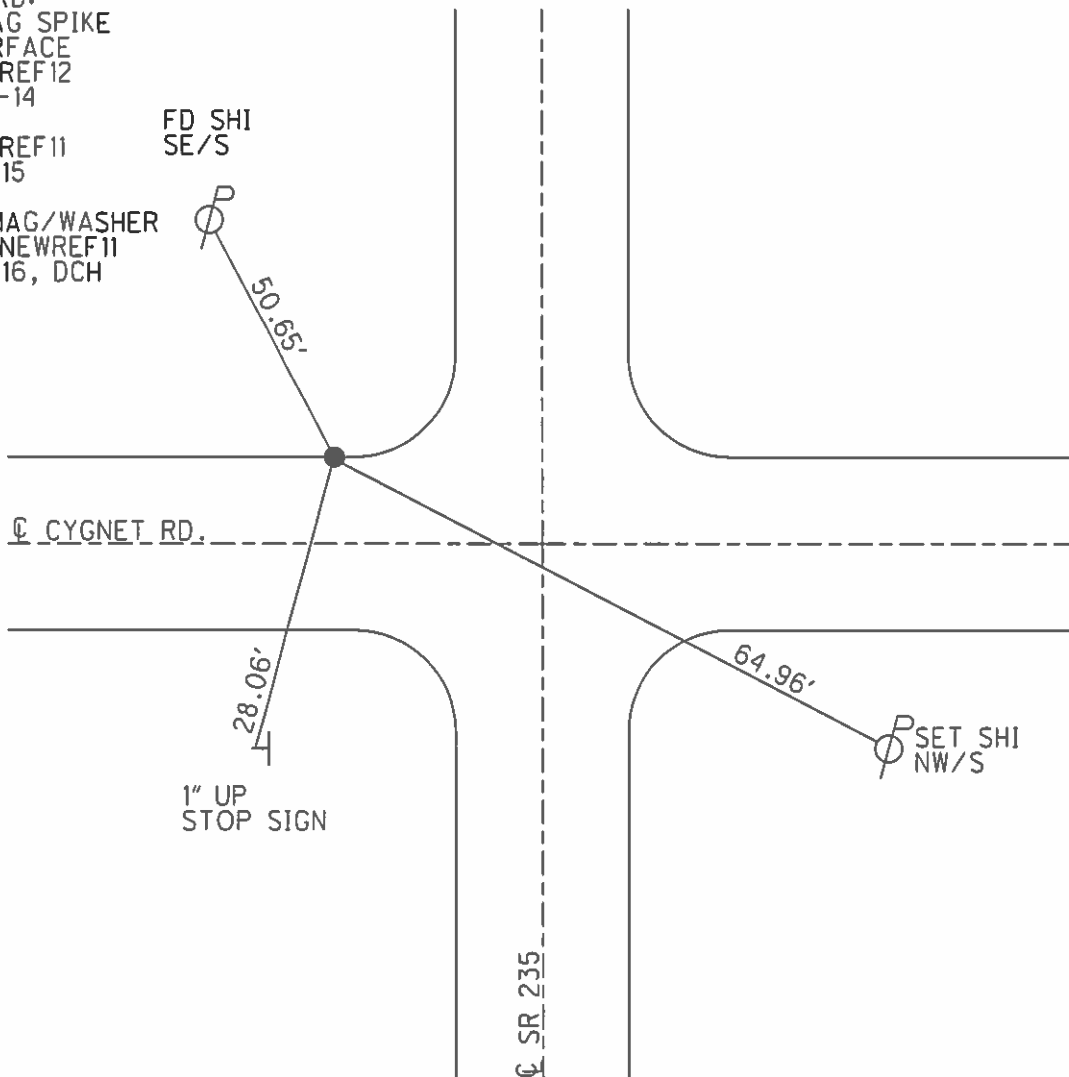

O.D.O.T. DISTRICT 2 SURVEY OFFICE

PERSONNEL

REFERENCE NO. 11

SHEET 8 OF 23

NOTES Homan

DATE 9-24-03

ROUTE 235

H.C. Nuhfer

WEATHER Rain

COUNTY WOOD

R.C. Ballmer

TEMP. 55°

TOWNSHIP JACKSON

SECTION 11

T 3 N R 9 E


TYPE MONUMENT Sm R.R. Spike

~~ON SURFACE~~ - BELOW 3"


~~LEFT - C PAVT - RIGHT~~ 17.5' LT C

TO EDGE PAVEMENT

S.L.M. 263+44

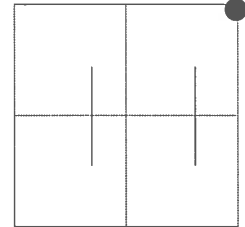

POINT Not Disturbed 2003

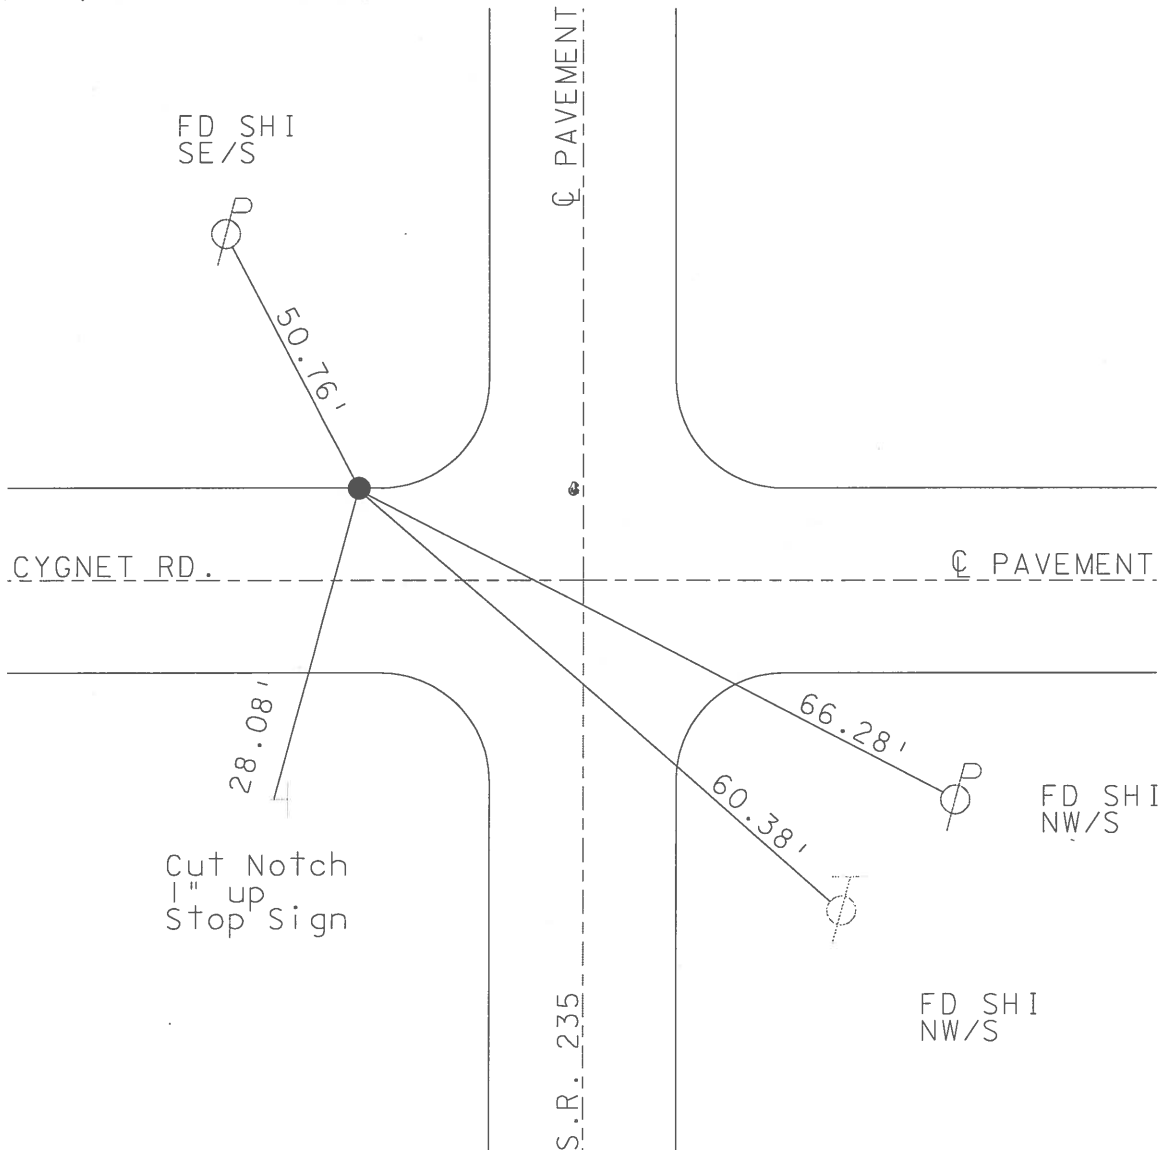

O.D.O.T. DISTRICT 2 SURVEY OFFICE

PERSONNEL

REFERENCE NO. 11

SHEET 7 OF 28

NOTES Barnhisel

H.C. Cordes

R.C. V. Scott

DATE 07-14-95

WEATHER Sunny

TEMP. +85° F

ROUTE 235

COUNTY Wood

TOWNSHIP Jackson

SECTION 11

T 3 N R 9 E


TYPE MONUMENT Sm. R.R. spk.

~~ON SURFACE~~ BELOW .5 below


LEFT- & PAV'T. WRIGHT 17.5' Lt of E

TO EDGE PAVEMENT

S.L.M. 263 + 44

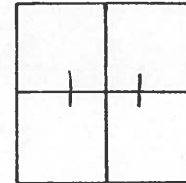

(Point Not Covered
10-07-96
BOR)

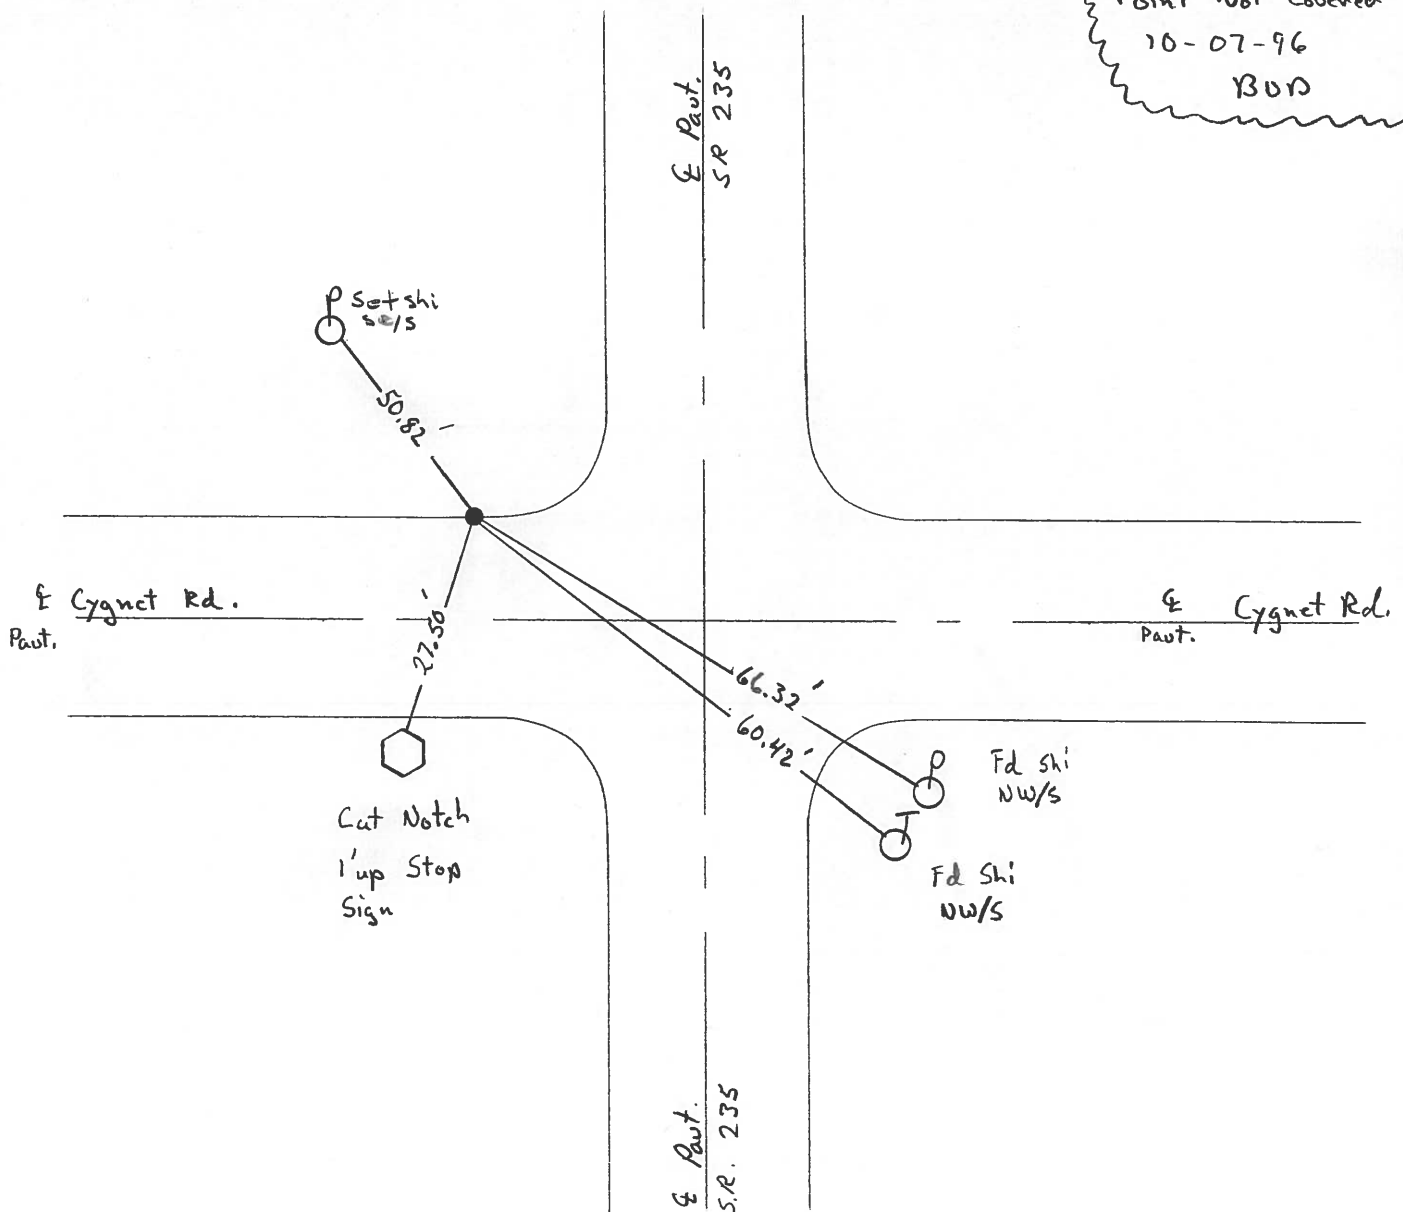

O.D.O.T. DISTRICT 2 SURVEY OFFICE

PERSONNEL

REFERENCE NO. 11

SHEET OF

NOTES BARNHISEL

H.C. Loehrke

R.C. HOFFMAN

DATE 6-3-86

WEATHER SUNNY

TEMP. +55°

ROUTE 235

COUNTY WOOD

TOWNSHIP JACKSON

SECTION 11

T 3 N R 9 E

TYPE MONUMENT Sm RR Spk



ON SURFACE - BELOW yes

LEFT-℄ PAV'T. - RIGHT 18.5

- TO - EDGE PAVEMENT 7/8 Edge of Cygnet West

S.L.M. 263+44

Set Sm RR Spk
6-26-86
7103

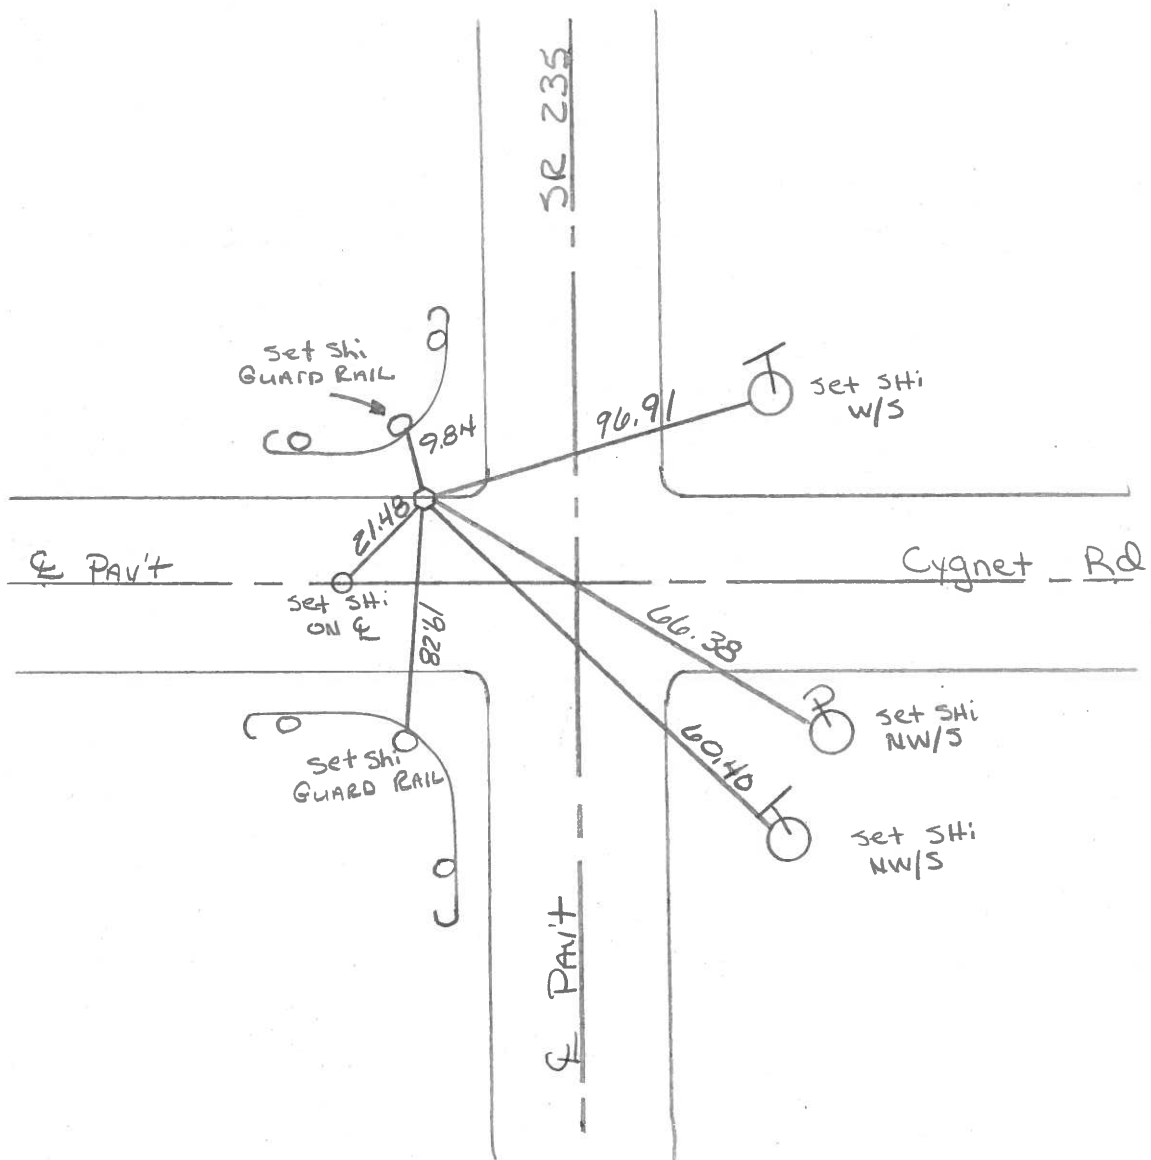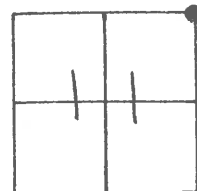

PERSONNEL	TITLE	PERSONNEL	TITLE
BURNSIDE			
SMITH			
BOWERS			
MEAD			

COUNTY Wood

DATE 12-23-75

S. R. 235

WEATHER Cloudy

SEC. N.E. COR. SEC. 11

TEMP. +27°

DESCRIPTION & CONTROL TIES

JOB NO.

LEFT

CENTER LINE

RIGHT

N.E. COR. SEC. 11
T-3-N R-9-E
JACKSON TWP.
WOOD COUNTY

CYGNET

N.E. COR.
TIE BLK.
HO. FDN.

FD. R.R. Spk.

FROM OLD TIES
(AT SURFACE)

Co. TIES

N.W. COR. HOWL. E. 29.0
S.W. COR. HOWL. E. 33.9
S.E. COR. HOWL. W. 15.10
N.E. COR. HOWL. W. 9.0'

SEC. 2
SEC. 1SEC. 2
SEC. 11SEC. 1
SEC. 12SEC. 11
SEC. 12

SHI.

B SHI.

SHI.

SHI.

ROAD

N.
E.

235

45.02'

47.40'

100.54'

66.24'

63.04'

9'

PERSONNEL	TITLE	PERSONNEL	TITLE	COUNTY	DATE
				Wood	12-13-57
				#69	4-14-60
					WEATHER 1-10-60
				SEC.	TEMP.

DESCRIPTION	LEFT	CENTER LINE	RIGHT	JOB NO.
SW. cor. sec. 1 Jackson Twp. Stone set R.R. spk. Cygnus Rd. #67			Shi. in Anchor Post E. 47.35 Shi. in T. Pole W.W.W. 45.04 Shiner in Pole 47.35 N.E. cor. N. Haul. N.W. 10.51 S.E. cor. S. Haul. S.W. 20.91 Shiner in T.P. S.E. 63.02 Shiner in T.P. S.W. 51.40 W. edge of pavement E. 8.90 W.W.W. Shiner T. Pole 45.02	
E 1/4 post sec. 2 Jackson Twp. Found Hub over Stone - set pipe #68			Conc. man. gone N.W. 37.2 Conc. man. S.W. 39.10 Shiner in 28" Apple N.E. 66.43 Shiner in T.P. S.E. 60.10 Shiner in P.P. W.S.W. 36.70 Shi. in T. Pole W.S.W. 74.58 N.W. cor. Haul. S.S.W. 17.60 S.W. cor. Haul. E.E. 33.58 Shiner in P.P. S.W. 49.55 East to Stone #70 33.18	
NE. cor. sec. 2 Jackson Twp. R.R. spk. Jerry City Rd. #69				
SW. cor. sec. 36, Milton Twp. Found Shiner Fd. Iron Pin Jerry City Rd. #70			Shi. in Guard Rail Post E.N.E. 27.67 N.W. cor. Haul. W.S.W. 43.43 Shiner in P.P. S.W. 74.75 Shiner in P.P. E.E. 43.76 N.E. cor. Stone Haul. S.S.E. 24.61 Shi. in Guard Rail Post No 23.92 Shi. in T.P. N.E. 35.17 Shiner in G. Post S.S.E. 19.90	
E 1/4 post of the S.E. 1/4 Sec. 36 Milton Twp. Stone Fd. R.R. Spk. 3' below surface #71			Stone 30.17 Shiner in T.P. S.W. 78.72 Shiner in T.P. S.E. 48.22 Shiner in P.P. W. cor. 37.74 Iron on S. N.E. 37.74 Shi. T. Pole N.N.E. 14.75	

PERSONNEL	TITLE	PERSONNEL	TITLE	COUNTY	DATE	WEATHER	TEMP
				Wood	12-13-57		
				#69	4-14-60		

DESCRIPTION	LEFT	CENTER LINE	RIGHT	JOB NO.
S.W. Cor. sec. 1 Jackson Twp. Stone Set R.R. Spt. ✓ Cygnet Rd. #67			Shi. in Anchor Post E. 47.35 Shi. in T. Pole W.N.W. 45.04 E. Shiner Stone Pole 47.30 N.E. Cor. N. Hdwl. N.W. 10.48 S.E. Cor. S. Hdwl. S.W. 20.91 32.72 Shiner in T.P. S.E. 63.02 53.02 Shiner in 30' Elm S.W. 51.40 Wedge of pavement E. 8.80 W.N.W. Shiner T. Pole 45.04	
E 1/4 post sec. 2 Jackson Twp. Found Hub over Stone - set pipe ✓ #68			Cons. man. N.W. 32.2 Cons. man. S.W. 34.10 Shiner in 14" Apple N.E. 66.43 Shiner in T.P. S.E. 60.10 Shiner in P.P. W.S.W. 33.71	
N.E. Cor. sec. 2 Jackson Twp. R.R. Spt. ✓ Jerry City Rd. #69			Shi. in T. Pole W.S.W. 74.53 N.W. Cor. Hdwl. S.E.W. 14.60 S.W. Cor. Hdwl. S.E. 33.52 Shiner in T.P. W.S. 40.50 East to Stone #70 53.18	
S.W. cor sec. 36 Milton Twp. Found Shiner Fd. Iron Pin Jerry city Rd. #70			Shi. in Guard Rail Post E.N.E. 27.6 N.W. Cor. Hdwl. W.S.W. 43.43 Shiner in P.P. S.W. 57.15 Shiner in P.P. S.E. 43.96 N.E. Cor. Stone Hdwl. S.E. 60.10 Shi. in Guard Rail Post No 23.92	
E 1/4 post of the S.E. 1/4 Sec. 35 Milton Twp. Stone Fd. R.R. Spt. 3" Below Surface #71			Stone W. 30.17 Shiner in T.P. S.W. 73.78 Shiner in T.P. S.E. 48.22 Shiner in P.P. W. 43.33 Iron Sign Spt N.E. 27.15 Shi. T. Pole N.N.E. 140.75 T. RAN FENCE POST (1) 33.00	

PERSONNEL TITLE PERSONNEL TITLE

COUNTY Wood

DATE 12-13-57

S. R. #69

4-14-60

WEATHER 1-18-66

SEC.

TEMP.

DESCRIPTION

LEFT

CENTER LINE

RIGHT

JOB NO.

60' 9" W

S.W. Cor. sec. 1 Jackson
Twp. - Stone set R.R. spk. r
Cygnat Rd.

#67

11

Shi. in Anchor Post E. 47.35'
Shi. in T. Pole W.N.W. 45.04'
E. Shiner Brace Pole 47.35'
N.E. Cor. N. Hdwl. N.W. 10.48'
S.E. Cor. S. Hdwl. S.W. 20.91 20.72'
Shiner in T.P. S.E. 63.02 63.02'
Shiner in 30' Elm S.W. 54.40'
W. edge of pavement E. 8.80'
W.N.W. Shiner T. Pole 45.04'

ck. 11-27-59
Jameison

E 1/4 post sec. 2 Jackson
Twp. Found Hub over
stone - set pipe r

#68

12

Conc. mon. N.W. 32.27'
Conc. mon. S.W. 39.10'
Shiner in 14" Apple N.E. 66.43'
Shiner in T.P. S.E. 60.10'
Shiner in P.P. W.S.W. 36.77'

N.E. Cor. sec. 2 Jackson
Twp. R.R. spk. r
Jerry City Rd.

#69

13

Shi. in T. Pole W.S.W. 74.53'
N.W. Cor. Hdwl. S.S.W. 19.60'
S.W. Cor. of Hdwl. E of S. 32.58'
Shiner in T.P. W of S. 40.50'
East to Stone #70 33.18'

S.W. Cor. sec. 36. Milton
Twp. Found Shiner Fd. Iron Pin
Jerry City Rd.

#70

14

Shi. in Guard Rail Post E.N.E. 27.67'
N.W. Cor. Hdwl. W.S.W. 43.43'
Shiner in P.P. S.W. 57.15'
~~Shiner in P.P. E of S. 42.96'~~
~~N.E. Cor. stone Hdwl. E.S.E. 24.61'~~
Shi. in Guard Rail Post No 23.92'

E 1/4 post of the S.E. 1/4
Sec. 35 Milton twp. - Stone
Fd. R.R. Spk. 3' Below Surface

#71

Stone W. 30.17'
~~Shiner in T.P. S.W. 98.78'~~
Shiner in T.P. S.E. 48.22'
~~Shiner in P.P. W. 33.60'~~
~~Iron sign stk N.E. 37.15'~~
Shi. T. Pole N.N.E. 140.75'

PERSONNEL	TITLE	PERSONNEL	TITLE

COUNTY Wood DATE 12-13-57S. R. #69 SR 235 WEATHER 4-14-60

SEC. _____ TEMP. _____

DESCRIPTION

LEFT

CENTER LINE

JOB NO.

60' R/W

RIGHT		
Shi. in Anchor Post E.	47.35	
Shi. in T. Pole N.W.	45.00	
E. Shiner Brace Pole	47.35	
N.E. Cor. N. Hdwl. N.W.	10.48	
S.E. Cor. S. Hdwl. S.W.	20.91	20.72
Shiner in T.P. S.E.	63.02	63.02
Shiner in 30' Elm S.W.	54.40	
W. edge of pavement E.	10.80	
W.N.W. Shiner T. Pole	45.04	

S.W. Cor. sec. 1 Jackson
Twp. - Stone set R.R. spt.
Cygnat Rd.

#67

9/10/65
MorrisonOK 11-27-59
Jameson

11

E 1/4 post sec. 2 Jackson
Twp. Found Hub over
Stone - set pipe

#68

12

Conc. mon. N.W.	32.52
Conc. mon. S.W.	39.35
Shiner in 14" Apple N.E.	66.32
Shiner in T.P. S.E.	60.0'
Shiner in P.P. W.S.W.	36.85

N.E. Cor. sec. 2 Jackson
Twp. R.R. spt.
Jerry City Rd.

#69

9/10/65
Morrison

13

Shi. in T. Pole W.S.W.	74.53
N.W. Cor. Hdwl. S.S.W.	14.5
S.W. Cor. of Hdwl. E. of S.	32.58
Shiner in T.P. W. of S.	40.50
East to stone #70	33.15

S.W. Cor. sec. 35, Milton
Twp. Found shiner
Jerry City Rd.

#70

14

Shi. in Guard Rail Post E.N.E.	27.52
N.W. Cor. Hdwl. W.S.W. Good	43.28
Shiner in P.P. S.W.	57.15
Shiner in P.P. E. of S. Gone	42.96
N.E. Cor. stone Hdwl. E.S.E. Good	24.61
Shi. in Guard Rail Post No	23.72

E 1/4 post of the S.E. 1/4
Sec. 35 Milton twp. - Stone

#71

Stone W.	30.17
Shiner in T.P. S.W.	98.78
Shiner in T.P. S.E.	48.22
Shiner in P.P. W. Gone	33.65
Iron sign stk N.E.	37.15