

O.D.O.T. DISTRICT 2 SURVEY OFFICE (USE ONLY)

PERSONNEL

REFERENCE NO. 12

SHEET 10 OF 26

NOTES ASTON
H.C. NIESE
R.C. PRESTON-COLVIN

DATE 8-21-24
WEATHER CLEAR
TEMP. 65°

ROUTE SR 235
COUNTY WOOD
TOWNSHIP JACKSON
SECTION 2
T 3 N R 9 E

DWG BY PRESTON-COLVIN PID CHIPSEAL

TYPE MONUMENT MAG/WASHER

ON SURFACE - ~~BELOW~~ ON

OFFSET Q PAVEMENT 9.5' LT : ~~RT~~

ON TO LT EDGE PAVEMENT

STATION: 290+84.86

HORIZ.DATUM: NAD83 (2011)


GEOID: 2018

GRID: NORTHING: 578641.6

EASTING: 1615076

LDP: NORTHING: 399991.9

EASTING: 126830.9

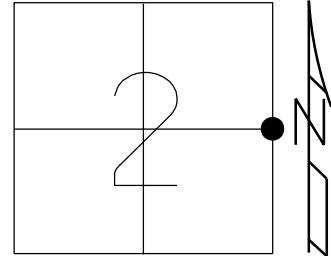

RECORD:
SET PK/WASHER
10-7-96,BVD


FD HARROW TOOTH
8" BELOW
GPS, REF13
10-22-14

GPS, REF12
8-27-15

SET MAG/WASHER
GPS, NEWREF12
7-28-16,DCH

FD MAG/WASHER
REF12
8-21-24,TDN

FD MAG/WASHER
9-18-24,TDN

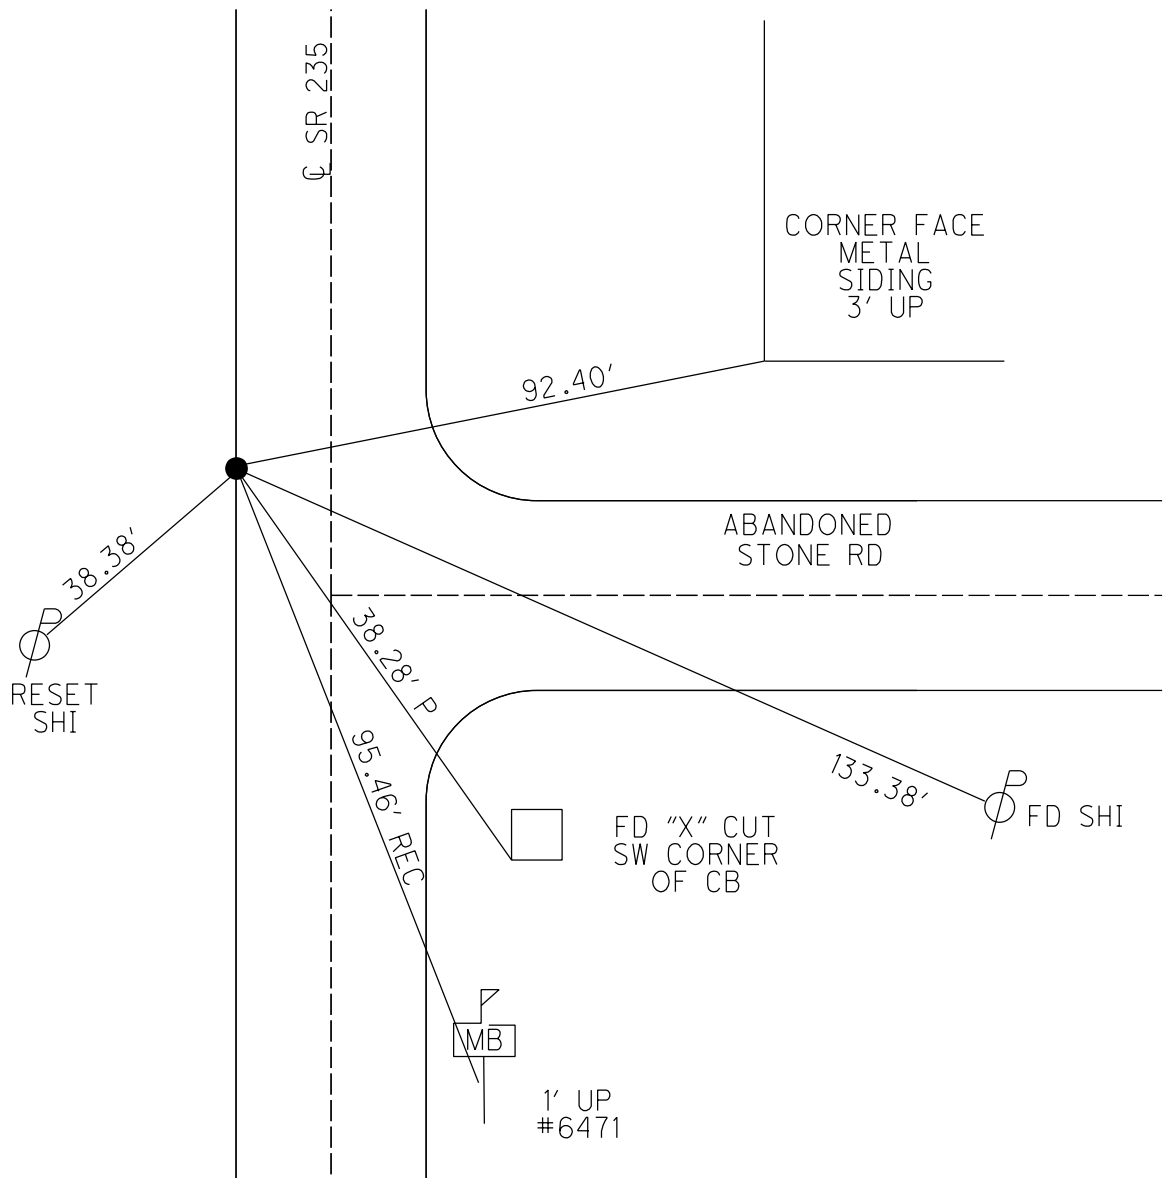

O.D.O.T. DISTRICT 2 SURVEY OFFICE (USE ONLY)

PERSONNEL	REFERENCE NO.	<u>12</u>	SHEET	<u>10</u>	OF	<u>26</u>
NOTES	<u>RHOADES</u>	DATE	<u>8-27-15</u>	ROUTE	<u>SR 235</u>	
H.C.	<u>O'DONNELL</u>	WEATHER	<u>SUNNY</u>	COUNTY	<u>WOOD</u>	
R.C.	<u>RHOADES</u>	TEMP.	<u>62°F</u>	TOWNSHIP	<u>JACKSON</u>	
				SECTION	<u>2</u>	
				T	<u>3</u>	N
				R	<u>9</u>	E

TYPE MONUMENT HARROW TOOTH


~~ON SURFACE~~ - BELOW 8"

LEFT - Q PAV'T - ~~RIGHT~~ 9.5'

ON TO LT EDGE PAVEMENT

S.L.M. 290+84.86

Grid: Northing: 578641.6211 Easting: 1615075.8824

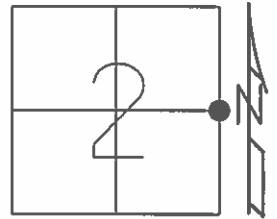


RECORD:
SET PK/WASHER
10-7-96,BVD

FD HARROW TOOTH
GPS, REF13
10-22-14

GPS, REF12
8-27-15

SET MAG/WASHER
GPS, NEWREF12
7-28-16,DCH

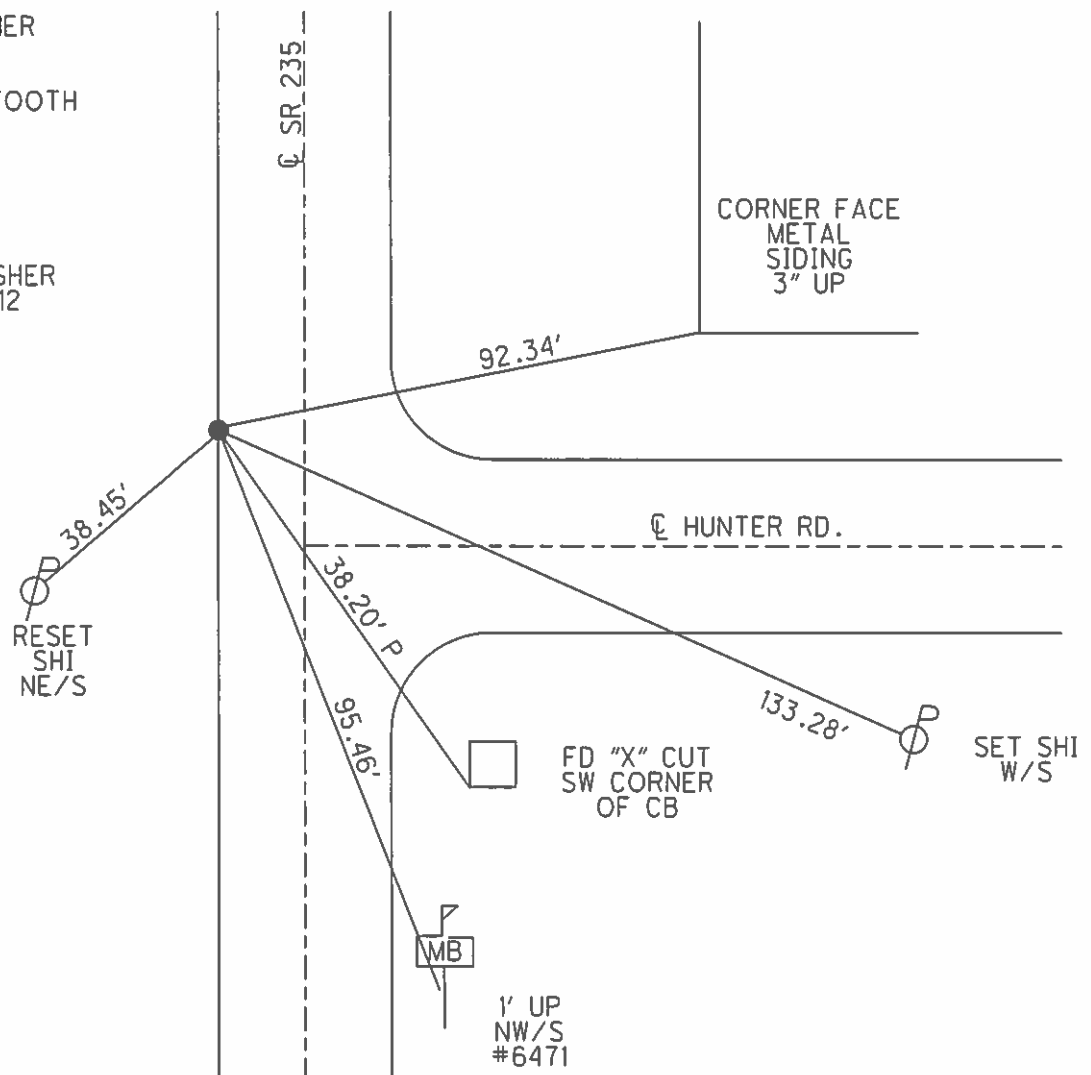

O.D.O.T. DISTRICT 2 SURVEY OFFICE

PERSONNEL

REFERENCE NO. 12

SHEET 9 OF 23

NOTES Homan

DATE 9-24-03

ROUTE 235

H.C. Nuhfer

WEATHER Cloudy

COUNTY WOOD

R.C. Ballmer

TEMP. 60°

TOWNSHIP JACKSON

SECTION 2

T 3 N R 9 E


TYPE MONUMENT PK & Washer

ON SURFACE - BELOW on surface

LEFT - Q PAV'T - RIGHT 9.5'


0 TO LT EDGE PAVEMENT

S.L.M. 290+00

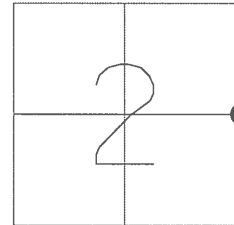

Set PK & Washer
10-7-96
BVD

Point Not
Disturbed 2003

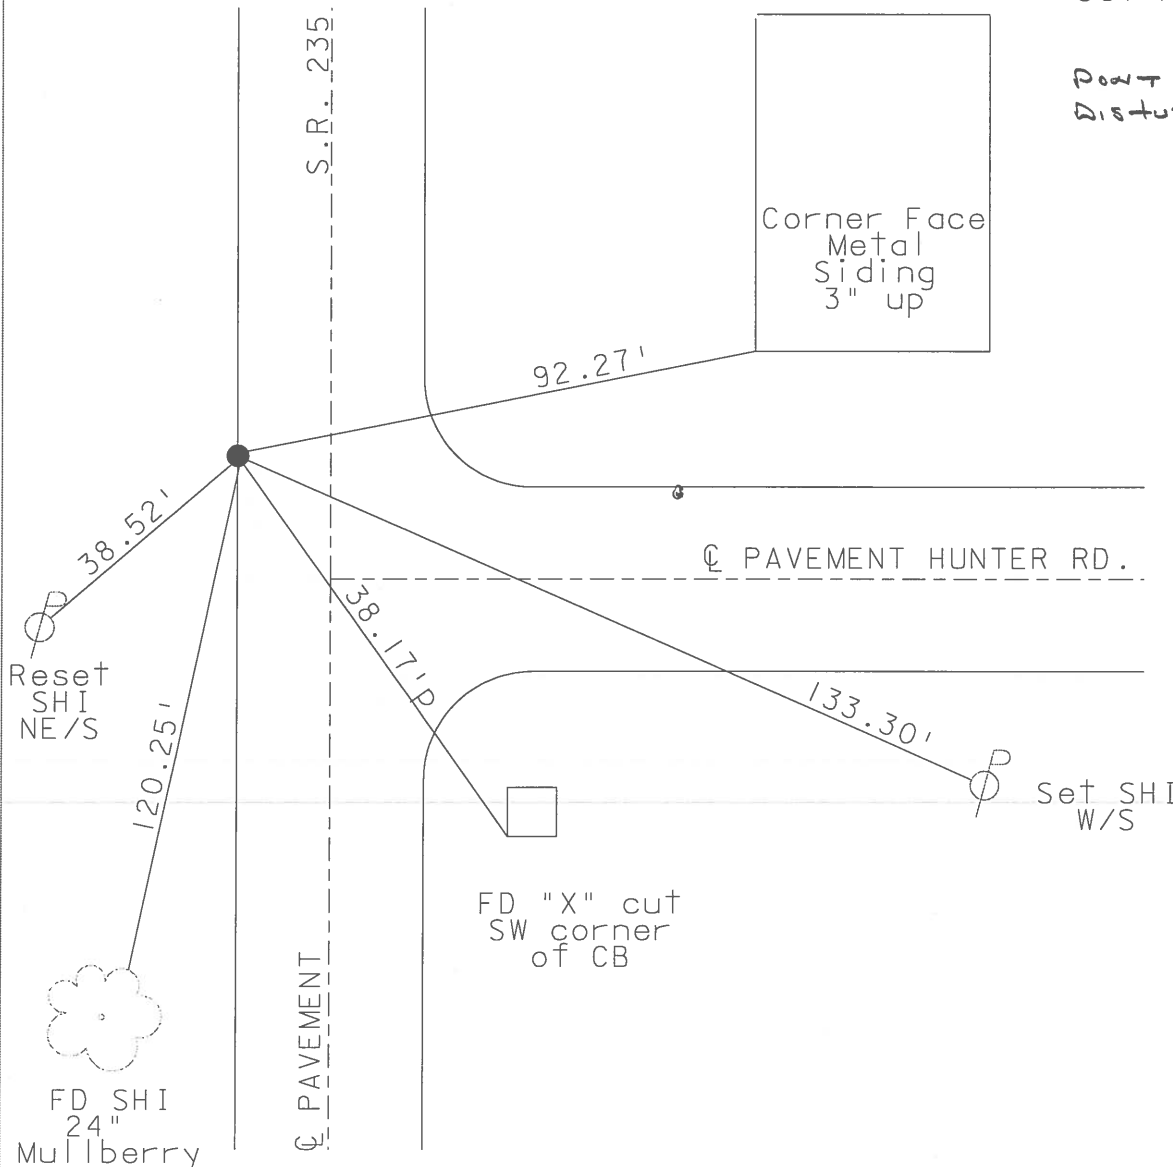

O.D.O.T. DISTRICT 2 SURVEY OFFICE

PERSONNEL

REFERENCE NO. 12

SHEET 8 OF 28

NOTES Huss

H.C. Messer

R.C. Huss

DATE 9-21-96

WEATHER Pt Cldy

TEMP. +73 °F

ROUTE 235

COUNTY Wood

TOWNSHIP Jackson

SECTION 2

T 3 N R 9 E


TYPE MONUMENT Sm. R.R. - Spk.

ON SURFACE - BELOW 1"


LEFT - PAV'T - RIGHT 9.5'

TO Lt EDGE PAVEMENT

S.L.M. 290+00

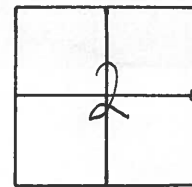

Set PK/Washer
10-07-96
BVD.

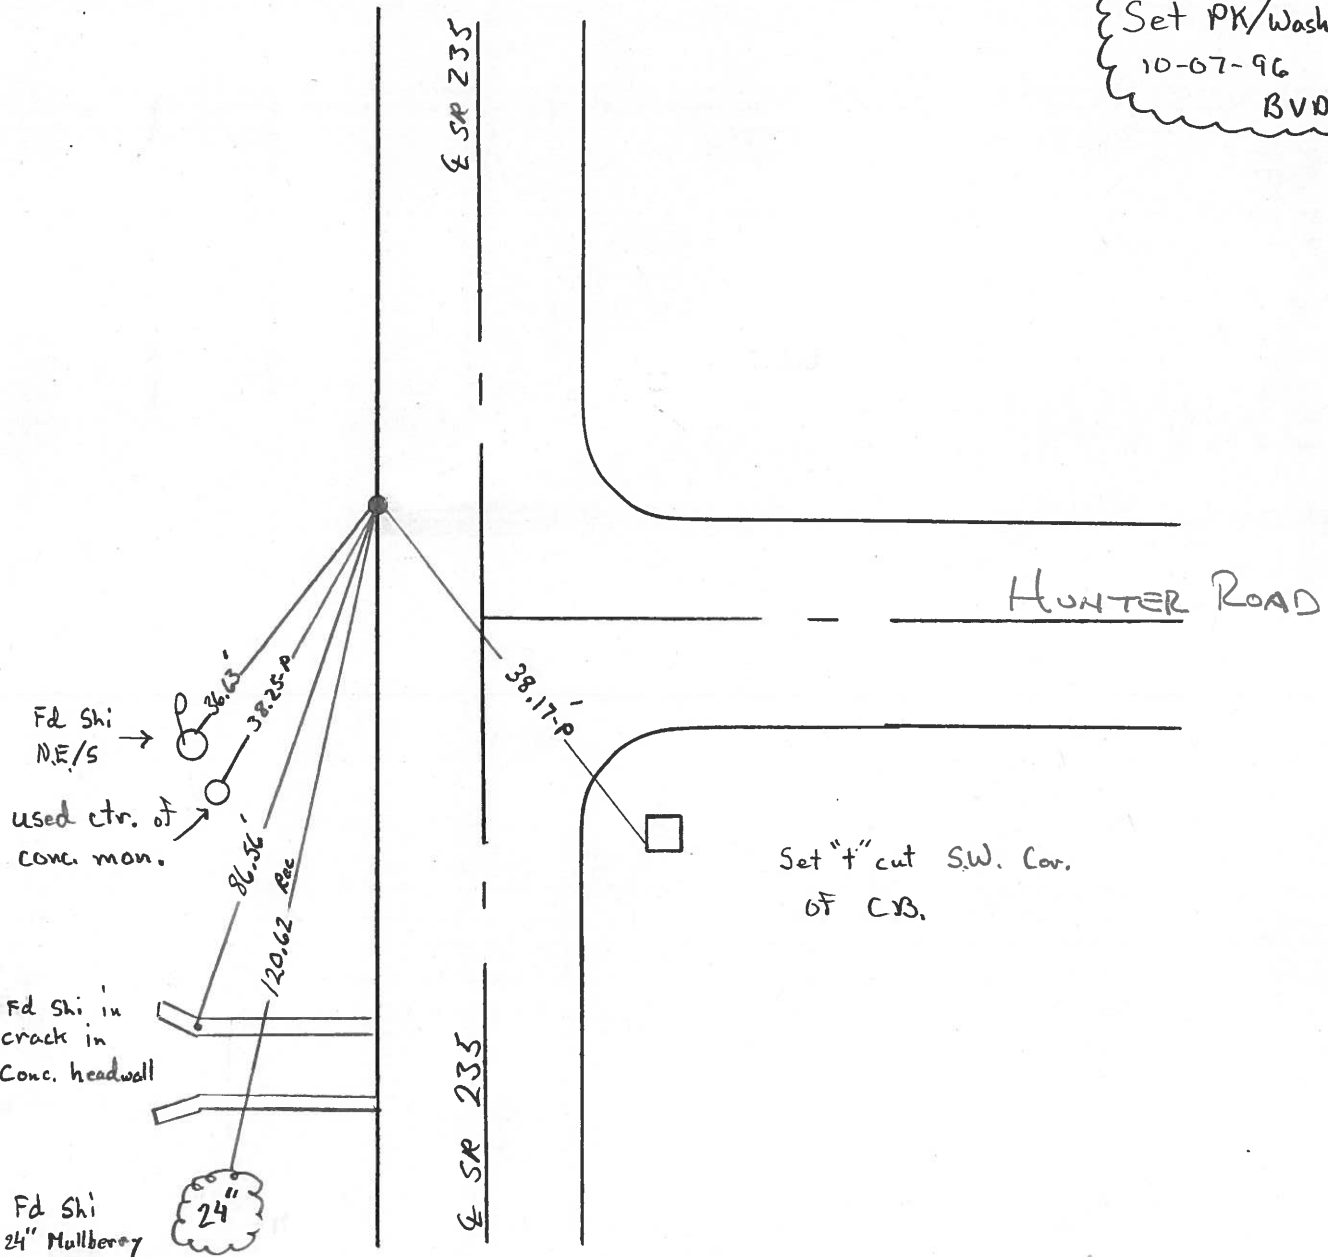

O.D.O.T. DISTRICT 2 SURVEY OFFICE

PERSONNEL

REFERENCE NO. 12

SHEET OF

NOTES BARNHISEL

H.C. Loehrke

R.C. HOFFMAN

DATE 6-3-86

WEATHER SUNNY

TEMP. +60°

ROUTE 235

COUNTY WOOD

TOWNSHIP JACKSON

SECTION 2

T 3 N R 9 E

TYPE MONUMENT Sm RR / spk



ON SURFACE - BELOW 1"

LEFT - & PAV'T. - RIGHT 9.3

ON ~~TO~~ LT EDGE PAVEMENT

S.L.M. 290 + 01

Set Sm RR Spk
6-26-84
MOB

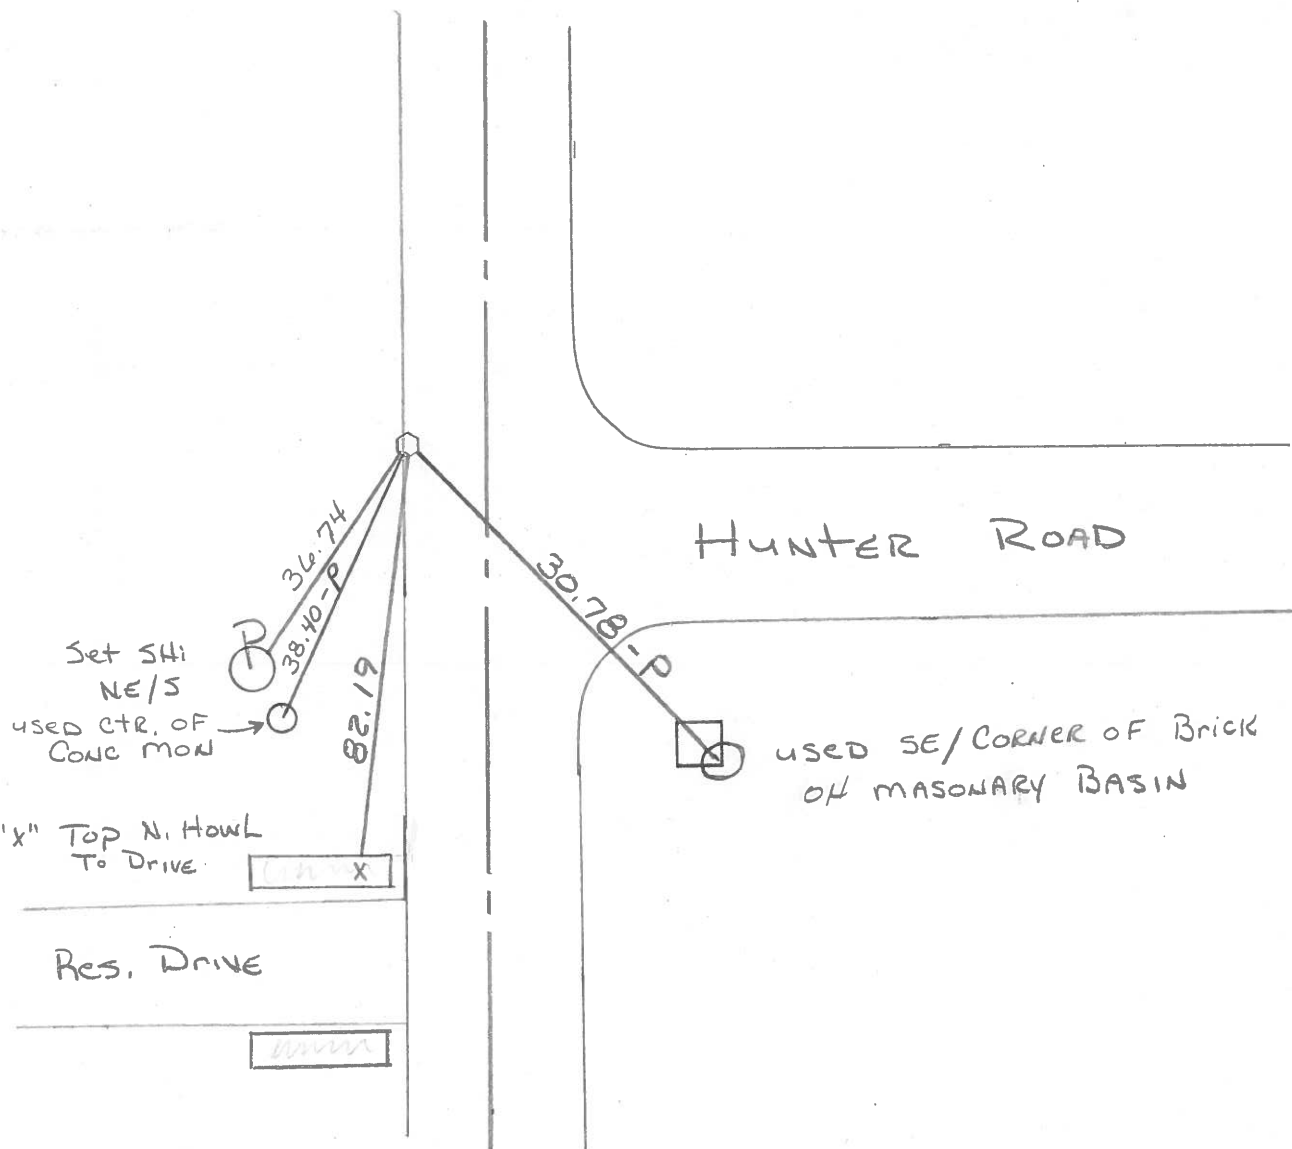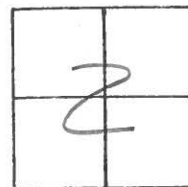

PERSONNEL	TITLE	PERSONNEL	TITLE	COUNTY	DATE	WEATHER	TEMP.
BURNSIDE				Wood	12-23-75	CLEARING	+27°
SMITH				S. R. 235			
BOWERS				SEC. E 1/4 Post SEC. 2			
MEAD							


DESCRIPTION ~~E~~ CONTROL TIES

JOB NO.

LEFT

CENTER LINE

RIGHT

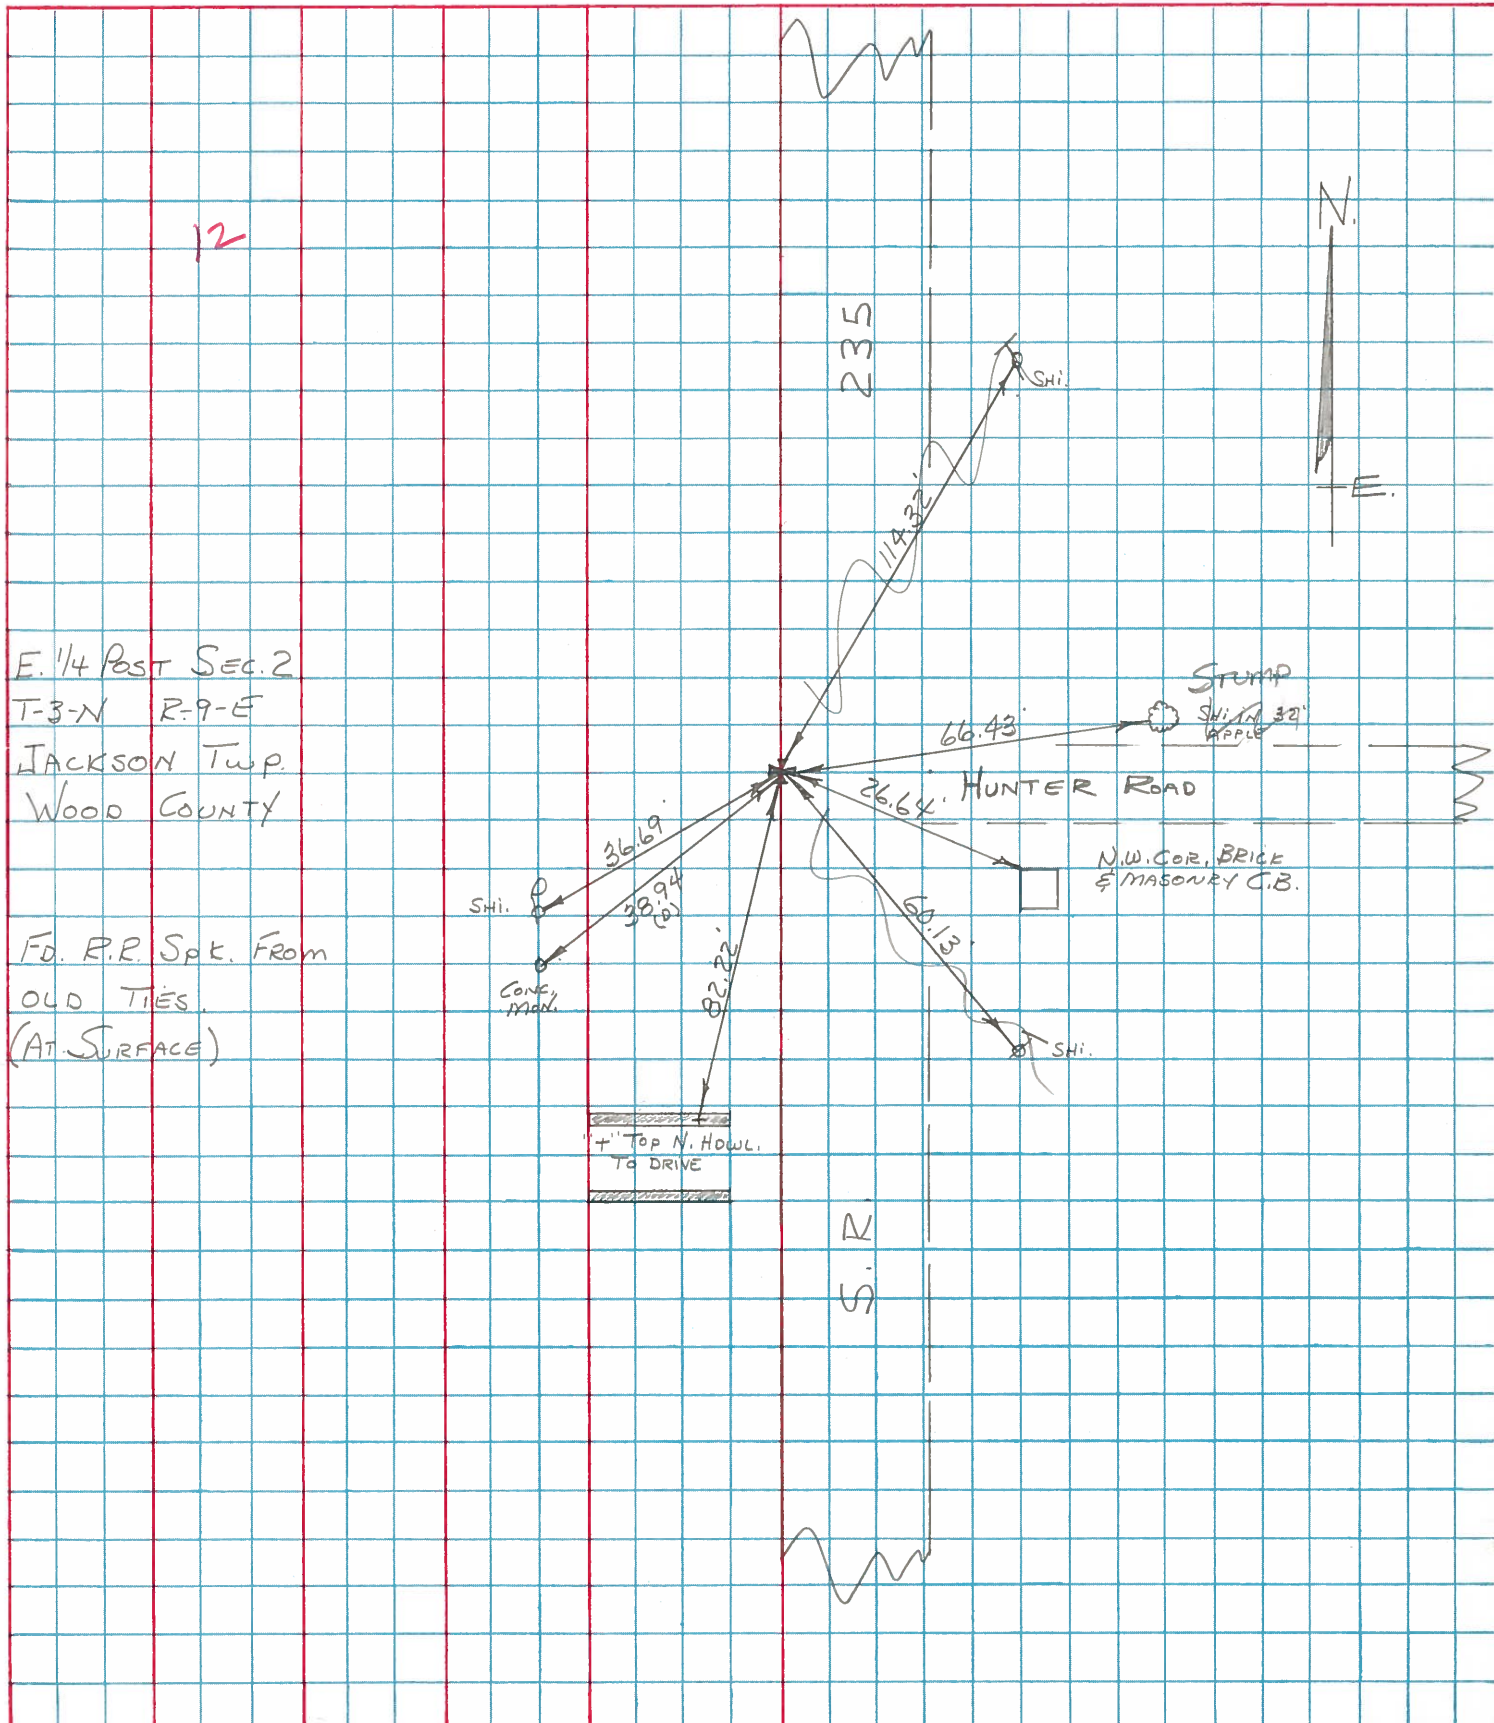

PERSONNEL TITLE PERSONNEL TITLE

SILVESTER

COUNTY Wood

DATE 7-69

S. R. # 235

WEATHER

SEC.

TEMP.

DESCRIPTION

LEFT

CENTER LINE

RIGHT

JOB NO.

#68 E 1/4 Post Sec 2 Jackson Twp Found Stone Set Pipe over Stone	#12	#69 Jerry City N.E. Cor. Sec. 2 Jackson Twp. R.R. Spk.	#13	#70 S.W. Cor. Sec. 36 Milton Twp Rd Iron Pin Jerry City Rd.	#13A (14)	#71 E 1/4 post of the S.E. 1/4 Sec 35 Milton Twp. Stone. Rd R.R. Spk on Top 3' below surface	#14 (14A)	#72 W. 1/4 Post Sec. 36 Milton Twp. Stone Rd.	#15

Conc. Mt S.W. 39.10

Shiner in 28" Apple N.E. 66.43 ✓

" " T.Pole S.E. 60.10

" " P. " W.S.W. 36.77

Shiner in T. Pole W.S.W. 74.53

N.W. Cor. Hd. Wall S.S.W. 14.60

Shiner " " " E. of S. 32.58

Shiner in P. Pole S.W. 49.55

E. to Stone #70 33.18

N.W. Cor Hd. Wall W.S.W. 43.43

Shiner in P. Pole S.W. 74.78

" " T. Pole N.E. 35.17

" " G. Rail Post S.S.E. 19.90

W. to Stone or R.R. Spk. 33.18

Stone W. 30.17

Shiner in T. Pole S.E. 48.22

Iron fence post W. 33.00

Shiner in T. Pole N.N.E. 140.75

Shiner in T. Pole E. 21.02

Stone E. 30.0

" W. 30.0

Shiner in P. Pole S.W. 43.30

" " W. Cherry E. 54.70

PERSONNEL

TITLE

PERSONNEL

TITLE

COUNTY

Wood.

DATE

March, 26, 1968
March, 25, 1968

S. R.

69

WEATHER

Clear.

SEC.

TEMP.

+40°

DESCRIPTION

Ties to Control p

JOB NO.

LEFT

CENTER LINE

RIGHT

S.W. Cor Sec. #1 Jackson Twp.

T3N; R9E.

Shiner I

45.05

47.35

T Shiner

66.20

P Shiner

63.05

T Shiner

CYGNET ROAD

E 1/4 Post Sec. #2

Jackson Twp.

T3N - R9E.

12

1" Pipe 2" deep
over stone.

Shiner P

36.77

39.10

Conc. Wht. Marker

66.48

Shiner in 30" Apple

60.10

T Shiner

NE Cor Sec. #2 Jackson Twp

T3N R9E

13

Jerry City Road

RR Spk

74.53

Shiner

49.55

Shiner P

14.60

RR Wht. S

32.58

33.18

Iron Pin

S.W. Cor Sec. #36 Milton Twp

T4N - R9E.

PERSONNEL	TITLE	PERSONNEL	TITLE	COUNTY	DATE
				Wood	12-13-57
				#69	4-14-60
					WEATHER 1-10-66
				SEC.	TEMP.

DESCRIPTION

LEFT

CENTER LINE

RIGHT

JOB NO.

SW. Cor. sec. 1 Jackson
Twp. Stone set R.R. Ept.
Cygnat Rd.
#67

11

E 1/4 post sec. 2 Jackson
Twp. Found Hub over
Stone set pipe
#68

12

N.E. Cor. sec. 2 Jackson
Twp. R.R. Ept.
Jerry City Rd.
#69

13

SW. Cor. sec. 36 Milton
Twp. Found Shiner Fd. Iron Pin
Jerry City Rd.
#70

14

E 1/4 post of the S.E. 1/4
Sec. 36 Milton Twp. Stone
Fd. R.R. Ept. 3' E-bow Surface
#71

Go' SW
Shi. in Anchor Post E. 47.35
Shi. in T. Pole W.N.W. 45.04
E. Shiner Eire Pole 47.3
N.E. Cor. N. Hwy. NW. 10.51
S.E. Cor. S. Hwy. SW 20.91
Shiner in T.P. S.E. 63.02
Shiner in 30' E-bow 3rd. 51.40
Wedge of pavement E. 8.90
W.N.W. Shiner T. Pole 45.02

~~Conc. man. gone NW. 55.2~~
~~Conc. man. SW. 59.16~~
Shiner in 28" Apple N.E. 66.42
Shiner in T.P. S.E. 60.10
Shiner in P.P. W.S.W. 36.7

Shi. in T. Pole W.S.W. 74.58
N.W. Cor. Hwy. S.S.W. 14.60
S.W. Cor. Hwy. E.E. 53.52
Shiner in P.P. S.W. 49.55
East to Stone #70 35.10

Shi. in Guard Rail Post E.N.E. 27.6
N.W. Cor. Hwy. W.S.W. 43.43
Shiner in P.P. SW. 74.18
Shiner in P.P. E.E. 42.76
N.E. Cor. Hwy. S.E. 55.5
Shi. in Guard Rail Post No. 23.92
Shi. in T.P. N.E. 35.17
Shiner in G. Post S.S.E. 19.90

Stone W. 30.17
Shiner in T.P. S.E. 78.77
Shiner in T.P. S.E. 48.22
Shiner in P.P. W. 50.01
Iron man. SW. 51.17
Shi. T. Pole N.N.E. 14.75

PERSONNEL	TITLE	PERSONNEL	TITLE	COUNTY	DATE
				Wood	12-13-57
				#69	4-14-60
				S. R.	WEATHER 1-18-66
				SEC.	TEMP.

DESCRIPTION	LEFT	CENTER LINE	RIGHT	JOB NO.
Sw. Cor. sec. 1 Jackson Twp. Stone set R.R. S. & E. Cygnus rd.	#67	11	Shi. in Anchor Post E. 47.35 Shi. in T. Pole W.N.W. 45.04 Shiner Brace Pole 47.3 N.E. Cor. N. H. H. N.W. 10.42 S.E. Cor. S. H. H. S.W. 20.91 20.72 Shiner in T.P. S.E. 63.02 33.01 Shiner in 30' E. in S.W. 51.43 W. edge of pavement S. 8.80 W.N.W. Shiner T. Pole 45.04	
E 1/4 post sec. 2 Jackson Twp. Found Hub over Stone - set pipe	#68	12	Conc. mon. N.W. 30.2 Conc. mon. E.W. 34.1 Shiner in 14" Apple N.E. 66.4 Shiner in T.P. S.E. 30.10 Shiner in P.P. N.S.W. 33.7	
N.E. Cor. sec. 2 Jackson Twp. R.R. spike Jerry City Rd.	#69	13	Shi. in T. Pole W.S.W. 74.53 N.W. Cor. H. H. S.W. 19.60 S.W. Cor. H. H. S.E. 33.5 Shiner in T.P. W. S. 40.53 East to Stone #70 38.18	
Sw. Cor. sec. 35 Milton Twp. Found Shiner Fd. Iron Pin Jerry City rd.	#70	14	Shi. in Guard Rail Post E.N.E. 27.6 N.W. Cor. H. H. W.S.W. 43.42 Shiner in P.P. S.W. 57.15 Shiner in P.P. S.E. Gone 43.46 N.E. Cor. H. H. S.E. 60.2 Shi. in Guard Rail Post No 23.92	
E 1/4 post of the S.E. 1/4 Sec. 35 Milton Twp. Stone Fd. R.R. Spike 3" Below Surface	#71		Stone W. 30.17 Shiner in T.P. S.W. 73.78 Shiner in T.P. S.E. 48.22 Shiner in P.P. W. Gone 23.30 Iron pin etc N.E. 37.15 Shi. T. Pole N.N.E. 140.75 T. Pole FENCE POST (1) 33.00	

PERSONNEL	TITLE	PERSONNEL	TITLE

COUNTY WoodDATE 12-13-57S. R. #69SR 235WEATHER 4-14-60

SEC. _____

TEMP. _____

DESCRIPTION

LEFT

CENTER LINE

JOB NO.

60' R/W

RIGHT		
Shi. in Anchor Post E.		47.35
Shi. in T. Pole N.W.		45.00
E. Shiner Brace Pole		47.35
N.E. Cor. N. Hdwl. N.W.		10.48
S.E. Cor. S. Hdwl. S.W.	20.91	30.72
Shiner in T.P.	S.E.	63.02
Shiner in 30' Elm S.W.		54.40
Wedge of pavement E.		10.80
W.N.W. Shiner T. Pole		45.04

S.W. Cor. sec. 1 Jackson
Twp. - Stone set R.P. spt.
Cygnat Rd.

#67

9/10/65
Morrisonck. 11-27-59
Jameson

11

E 1/4 past sec. 2 Jackson
Twp. Found Hub over
stone - set pipe

#68

12

N.E. Cor. sec. 2 Jackson
Twp. R.P. spt.
Jerry City Rd.

#69

9/10/65
Morrison

13

Conc. mon.	N.W.	32.52
Conc. mon.	S.W.	39.36
Shiner in 14" Apple N.E.		66.32
Shiner in T.P.	S.E.	60.0'
Shiner in P.P.	W.S.W.	35.85

Shi. in T. Pole	W.S.W.	74.53
N.W. Cor. Hdwl.	S.S.W.	14.5
E.P. Cor. of Hdwl.	E. of S.	32.58
Shiner in T.P.	W. of S.	40.50
Post to stone #70		33.18

Shi. in Guard Rail/Post	E.N.E.	27.52
N.W. Cor. Hdwl.	W.S.W.	60.0'
Shiner in P.P.	S.W.	57.15
Shiner in P.P.	E. of S.	Gone 42.96
N.E. Cor. stone Hdwl.	E.S.E.	60.0'
Shi. in Guard Rail Post	No	23.72

Stone	W.	30.17'
Shiner in T.P.	S.W.	98.78
Shiner in T.P.	S.E.	48.22
Shiner in P.P.	W.	Gone 33.60
Iron sign stk	N.E.	37.15'

E 1/4 past of the S.E. 1/4
Sec. 35 Milton Twp. - Stone

#71