


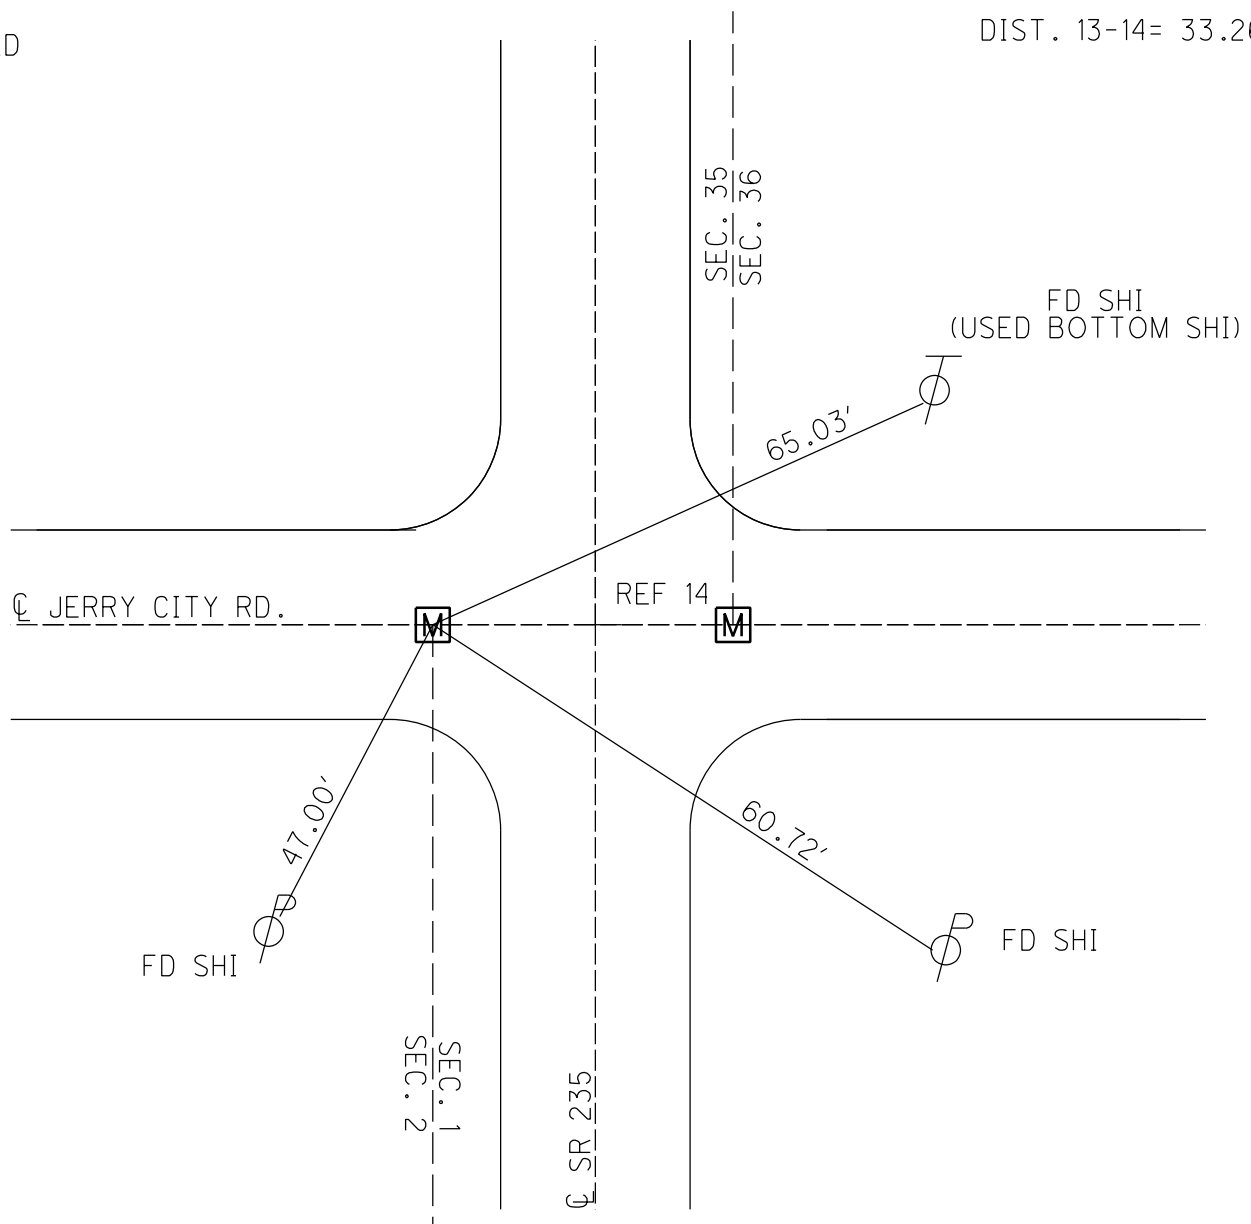

O.D.O.T. DISTRICT 2 SURVEY OFFICE (USE ONLY)

PERSONNEL

REFERENCE NO. 13

SHEET 11 OF 26

NOTES RHOADES

DATE 8-27-15

ROUTE SR 235

H.C. O'DONNELL

WEATHER SUNNY

COUNTY WOOD

R.C. RHOADES

TEMP. 62°F

TOWNSHIP JACKSON

SECTION 35

T 4 N R 9 E

TYPE MONUMENT R.R. SPIKE


~~ON SURFACE~~ - BELOW 1"

LEFT - Q PAV'T - ~~RIGHT~~ 24.4'

15.8' TO LT EDGE PAVEMENT

S.L.M. 318+86.44

Grid: Northing: 581443.2349 Easting: 1615063.4117

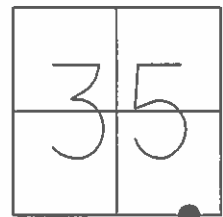


RECORD:
WAS NOT DISTURBED
11-3-03, DCH

FD RR. SPIKE
GPS, REF14
10-22-14

GPS, REF13
8-27-15

SET MAG/WASHER
GPS, NEWREF13
7-28-16, DCH

DIST. 13-14= 33.26'

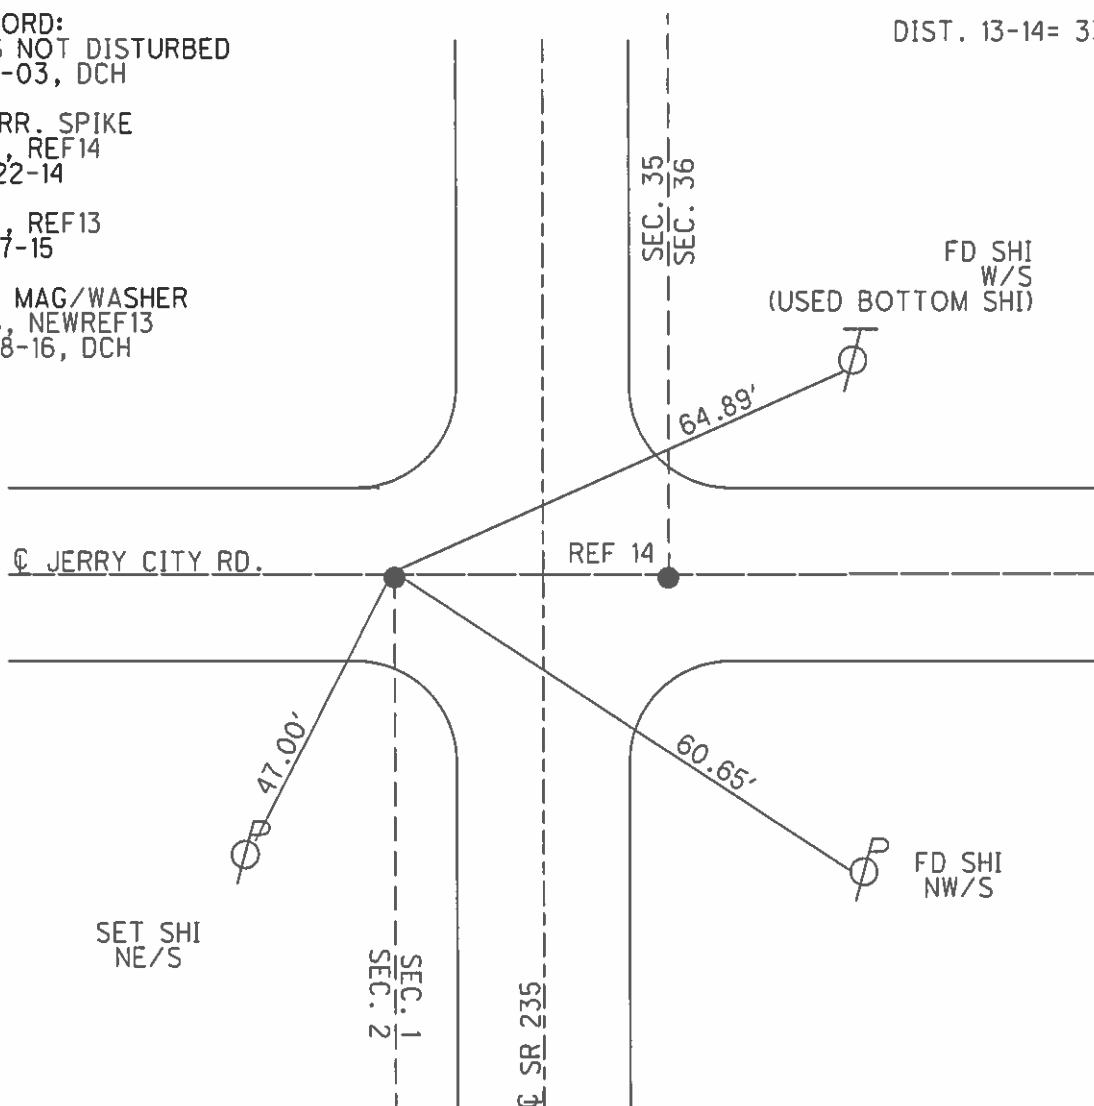

O.D.O.T. DISTRICT 2 SURVEY OFFICE

PERSONNEL

REFERENCE NO. 13+14

SHEET 10 OF 23

NOTES Homan

DATE 9-24-03

ROUTE 235

H.C. Nuhfer

WEATHER Cloudy

COUNTY WOOD

R.C. Ballmer

TEMP. 60°

TOWNSHIP MILTON & JACKSON

SECTION 35-36-1-2

T 3 N R 9 E

TYPE MONUMENT A; RR Spk-B; PK Nail


~~ON SURFACE~~ - BELOW 1"

LEFT - CL PAV'T - RIGHT A24.4'L-B9.1'R


A15.8 LT of LT

B9.1 TO RT EDGE PAVEMENT

S.L.M. 318+05 3.2" S of CL of JC Rd W

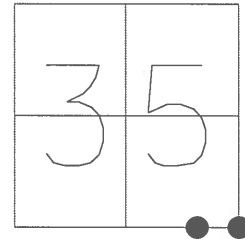

Point "A"
was not disturbed
Point "B"
set Mag & Washer
11-3-03
DCH

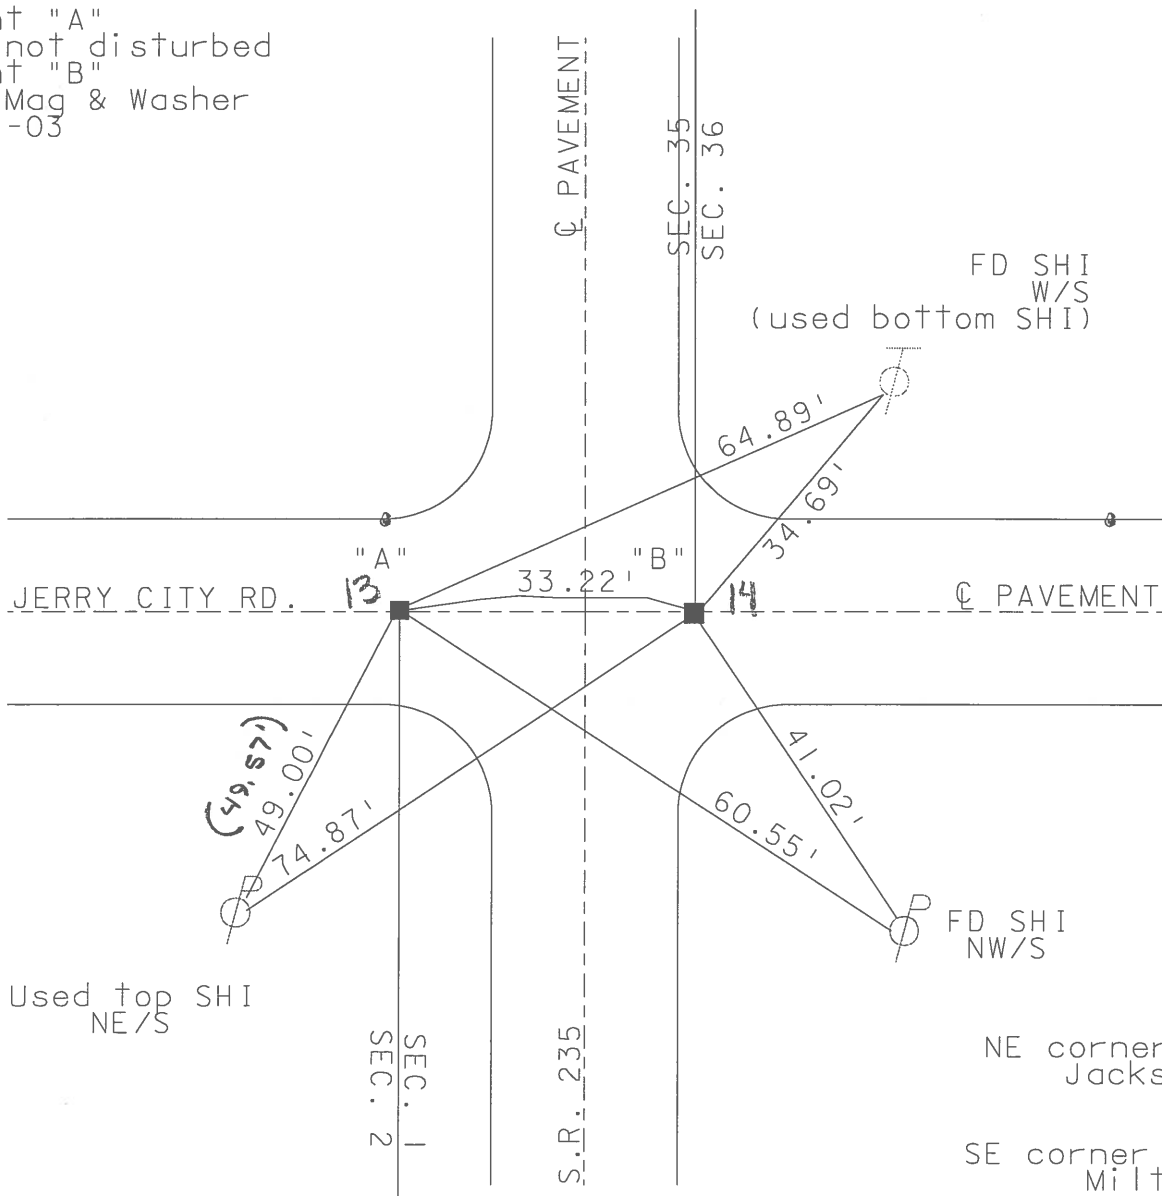

Used top SHI
NE/S

PT "A"
NE corner SEC 2
Jackson Twp

PT "B"
SE corner SEC 35
Milton Twp

O.D.O.T. DISTRICT 2 SURVEY OFFICE

PERSONNEL

REFERENCE NO. 1344

SHEET 9 OF 28

NOTES STEVE HUSS

H.C. KEVIN MOSER

R.C. STEVE HUSS

DATE 5-21-96

WEATHER Sunny

TEMP. * 74°F

ROUTE S.R. 235

COUNTY WOOD

TOWNSHIP MILTON / JACKSON

SECTION 35-36-1-2

T3NR9E



TYPE MONUMENT PT "A" + PT "B" - SM. R.R. SPIKE

~~ON SURFACE~~ - BELOW 1'

LEFT - & PAN'T. - RIGHT "A" - 24.4' LT. "B" - 9.1 RT

A-15.8 LT OF LT.
B-9.1' TO RT. EDGE PAVEMENT

S.L.M. 318+05 ~ 3.2' S. OF E OF J.C. Rd WEST

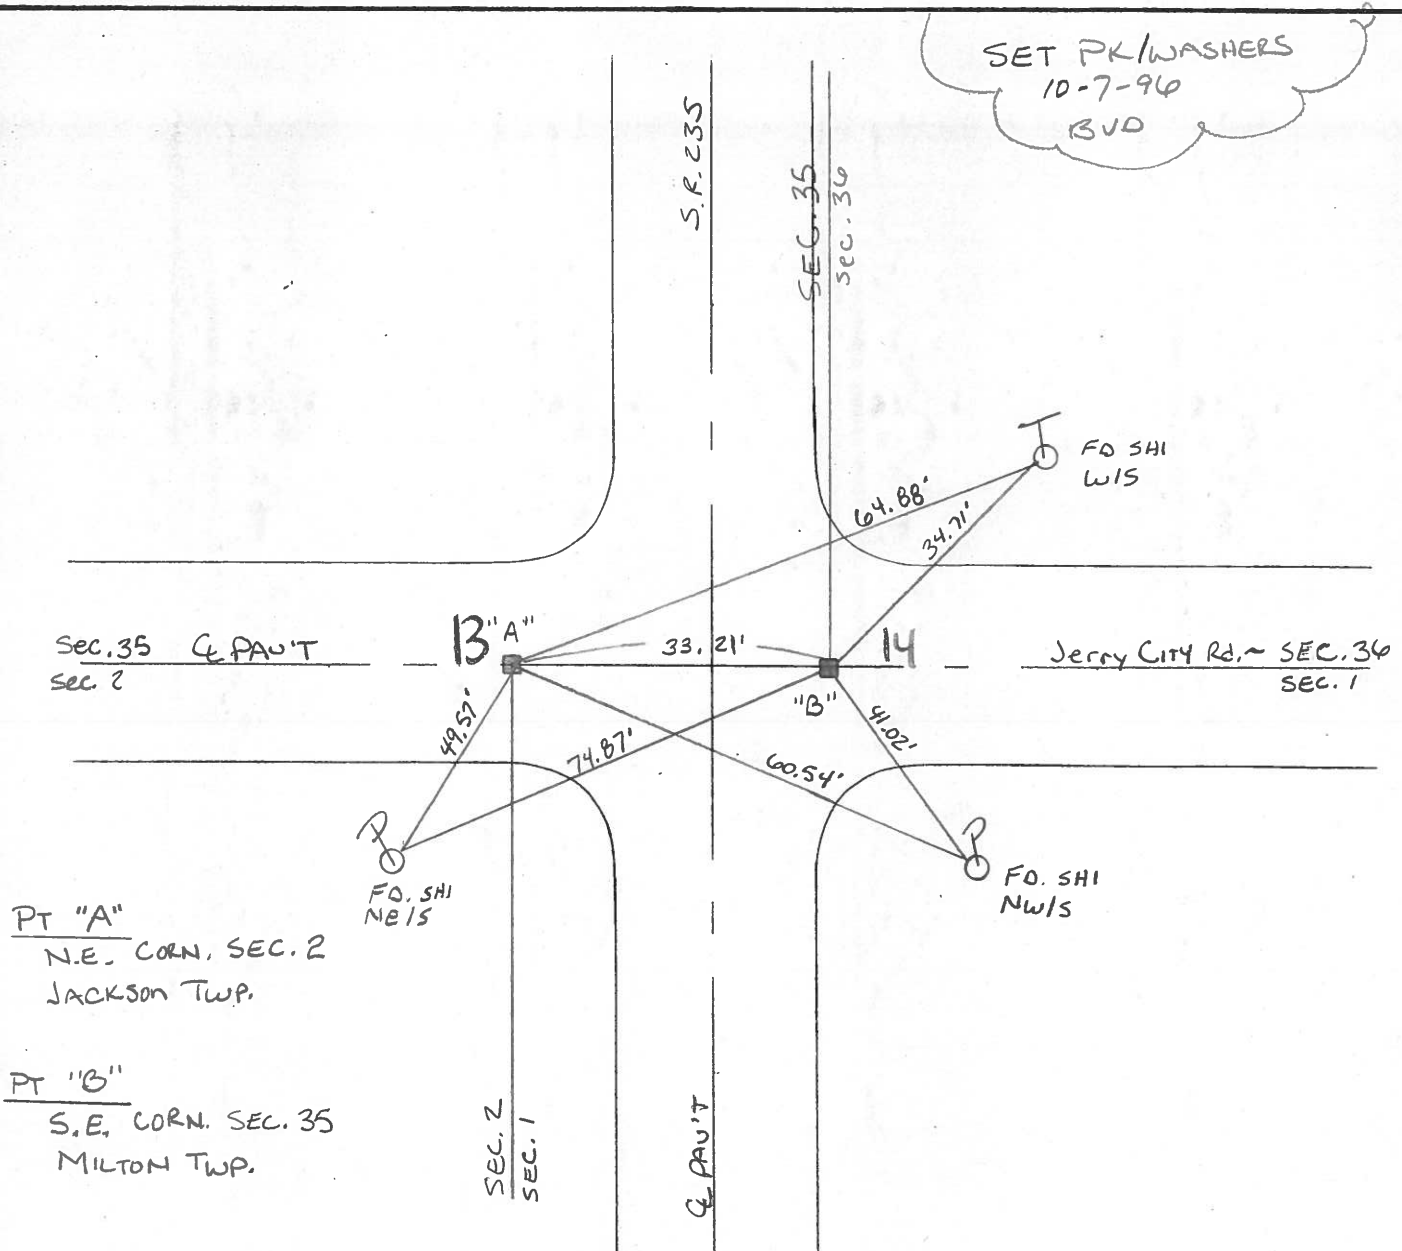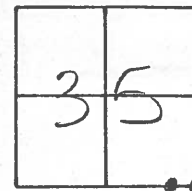

O.D.O.T. DISTRICT 2 SURVEY OFFICE

PERSONNEL

REFERENCE NO. 13+14

SHEET OF

NOTES BARNHISEL

H.C. Loehrke

R.C. Hoffman

DATE 6-3-86

WEATHER Sunny

TEMP. +65°

ROUTE 235

COUNTY WOOD

TOWNSHIP MILTON + JACKSON

SECTION 35

T 3 N R 9 E

TYPE MONUMENT Sm RR Spk

ON SURFACE - BELOW 1"



LEFT - CL PAV'T. - RIGHT 25'

- TO - EDGE PAVEMENT

S.L.M. 318 + 06


3.2 S. of E J.C. Rd West

Set Sm RR Spk
6-26-86
mab

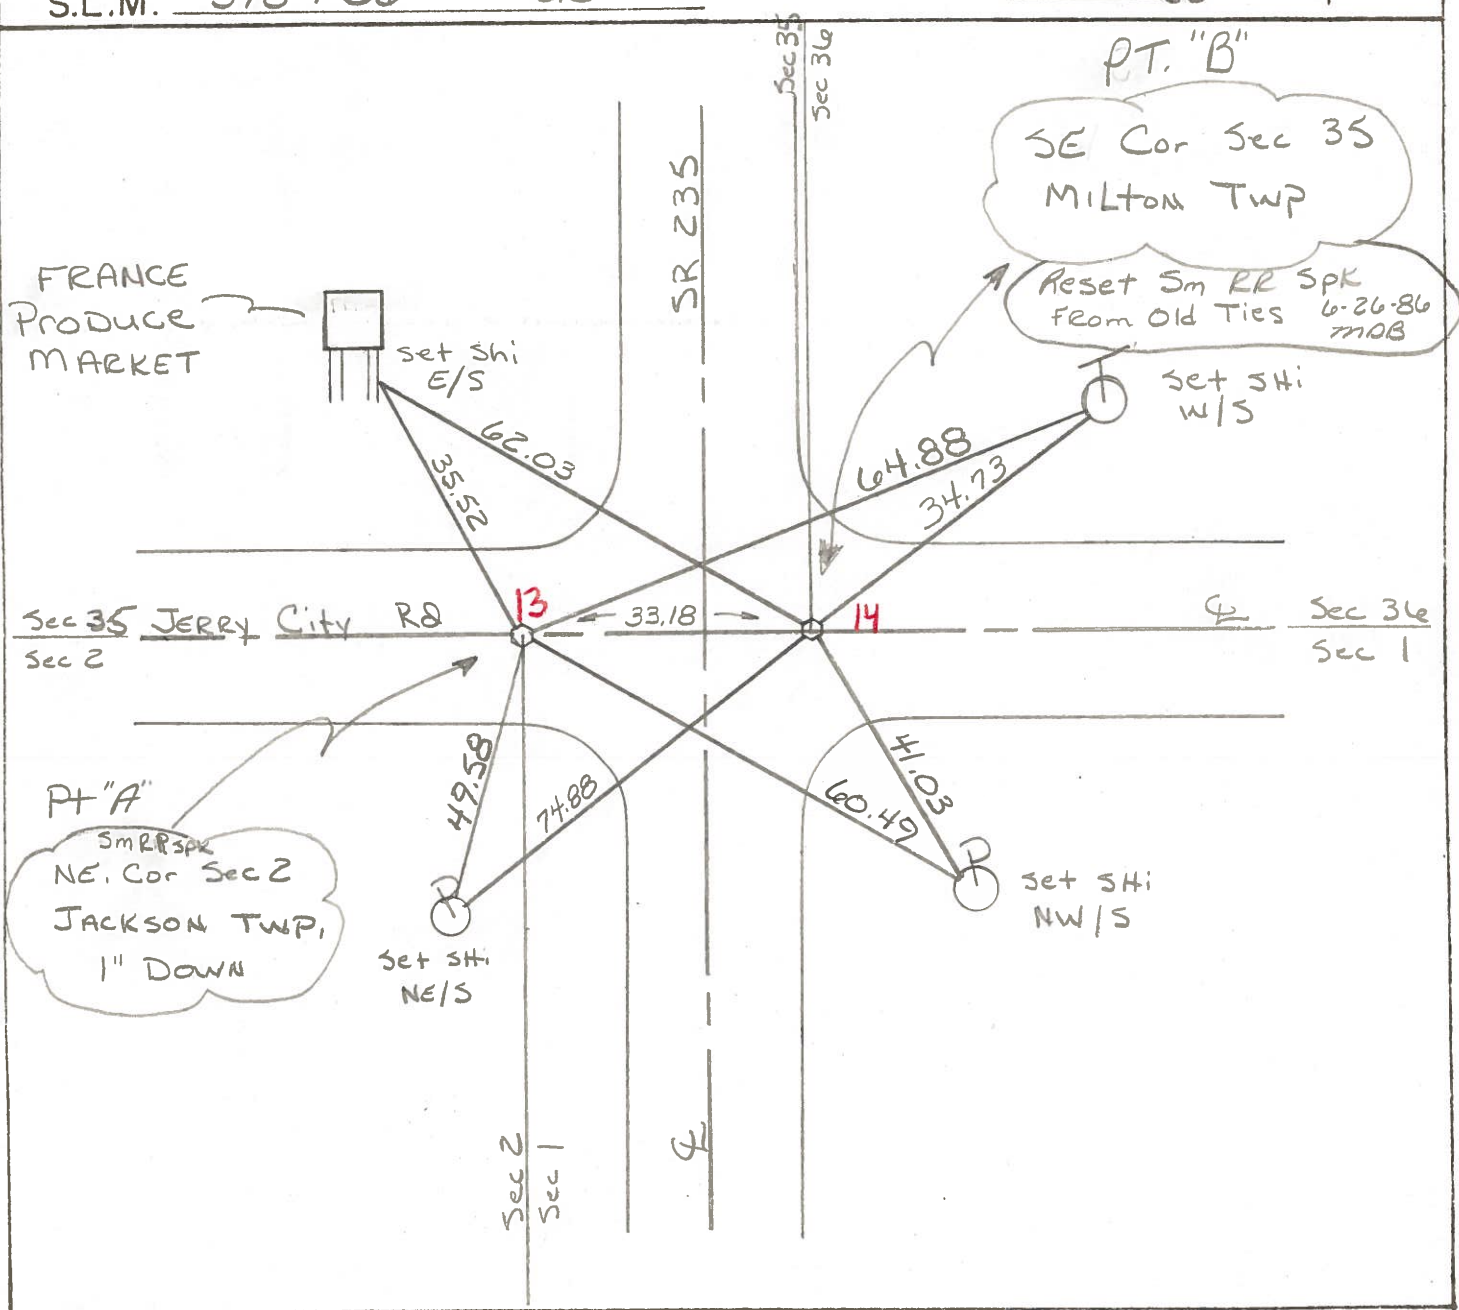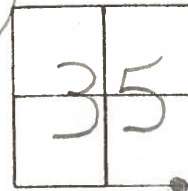

PERSONNEL	TITLE	PERSONNEL	TITLE	COUNTY	DATE	WEATHER	TEMP.
BURNSIDE				WOOD	12-23-75	P. Cloudy	+28°
SMITH				S. R. 235			
BOWERS				SEC. JERRY CITY ROAD			
MEAD							

DESCRIPTION CONTROL TIES LEFT CENTER LINE RIGHT JOB NO.

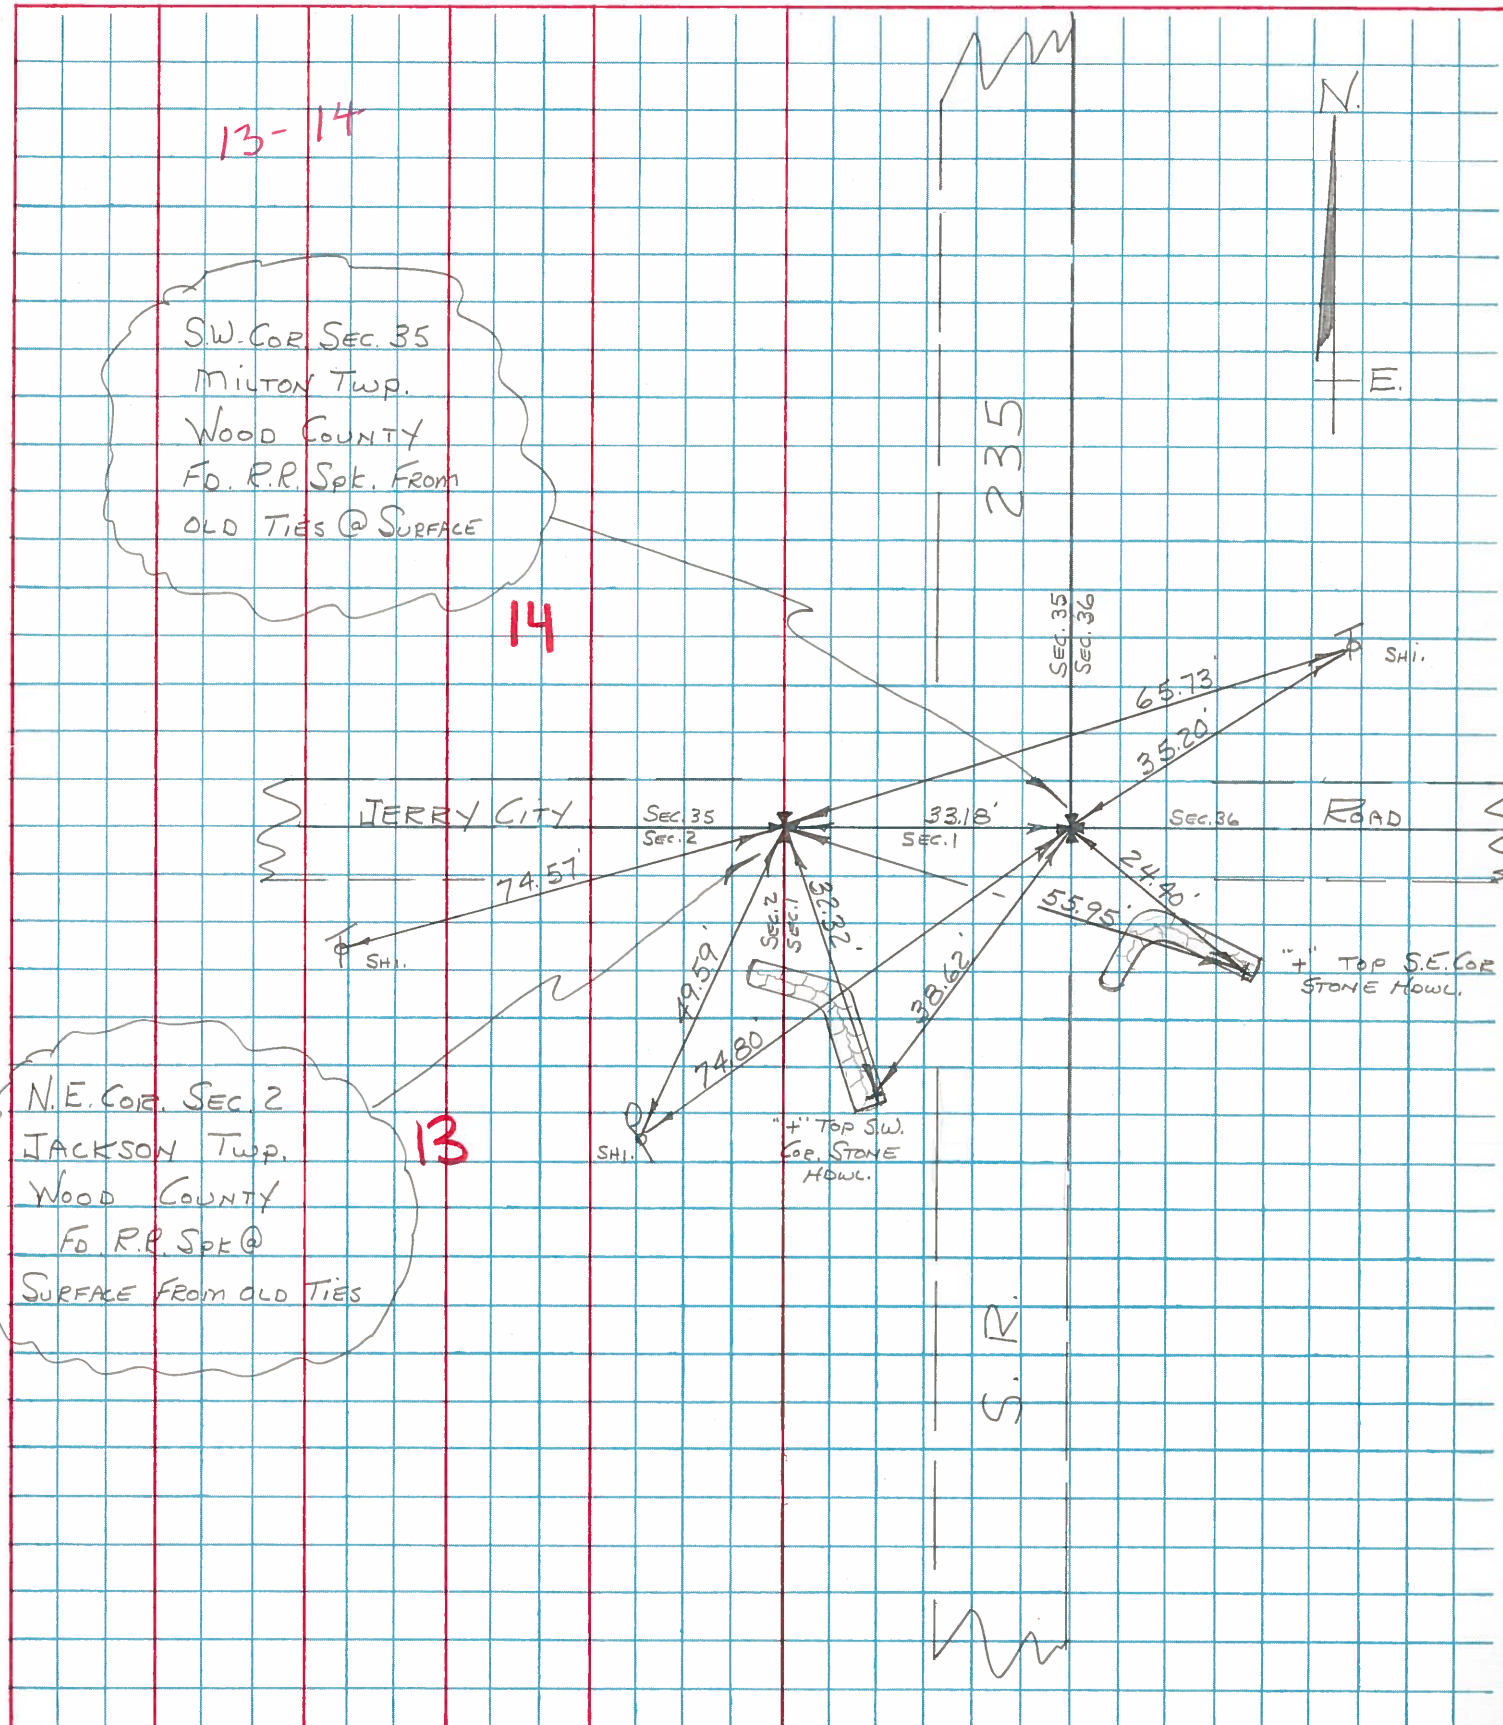

PERSONNEL TITLE PERSONNEL TITLE

SILVESTER

COUNTY Wood

DATE 7-69

S. R. #235

WEATHER

SEC.

TEMP.

DESCRIPTION

LEFT

CENTER LINE

RIGHT

JOB NO.

#12

#68

E 1/4 Post Sec 2 Jackson Twp
Found Stone Set Pipe over Stone

Conc. Mt. S.W. 39.10
Shiner in 28" Apple N.E. 66.43 ✓
" " T.Pole S.E. 60.10
" " P. " W.S.W. 36.77

#13

#69

Jerry City
N.E. Cor. Sec. 2 Jackson Twp. R.R. Spk.

Shiner in T. Pole W.S.W. 74.53
N.W. Cor. Hd. Wall S.S.W. 14.60
Sw. " " " E. of S. 32.58
Shiner in P. Pole S.W. 49.56
E. to Stone #70 33.18

#13A

#70

Sw. Cor. Sec 36 Milton Twp. Rd. Iron Pin
Jerry City Rd.

N.W. Cor Hd. Wall W.S.W. 43.43
Shiner in P. Pole S.W. 74.78
" " T. Pole N.E. 35.17
" " G. Rail Post S.S.E. 19.90
W. to Stone or R.R. Spk. 33.18

#14

#71

E 1/4 post of the SE 1/4 Sec 35 Milton Twp.
Stone. Rd R.R. Spk on Top 3' below surface

Stone W. 30.17
Shiner in T. Pole S.E. 48.22
iron fence post W. 33.00
Shiner in T. Pole N.N.E. 140.75

#15

#72

W. 1/4 Post Sec. 36 Milton Twp. Stone Rd.

Shiner in T. Pole E. 21.02
Stone E. 30.0
" W. 30.0
Shiner in P. Pole S.W. 43.30
" " W. Cherry E. 54.70

PERSONNEL TITLE PERSONNEL TITLE

COUNTY Wood.DATE March 26, 1968
March 25, 1968S. R. # 69WEATHER Clear.

SEC.

TEMP. +4DESCRIPTION Ties to Control points

LEFT

CENTER LINE

RIGHT

JOB NO.

SW. Cor Sec. #1 Jackson Twp.

T3N; R9E

Shiner T

45.05

47.35

T Shiner

66.20

63.05

P Shiner

T Shiner

C 16N - R 9E

E 1/4 Post Sec. #2

Jackson Twp.

T3N - R9E

12

1" Pipe 2" deep
over stone E.

Shiner P

36.77

39.10

Canc. Mt. Man.

66.43

60.10

Shiner in 30' Apple

NE Cor Sec. #2 Jackson Twp.

T3N R9E

13

Jerry City Road.

RES pk

33.18

Shiner T

Shiner P

49.55

14.60

30.58

Hdw.

Iron Pin

Sec. #36 Milton Twp.

T4 1-RJE.

PERSONNEL	TITLE	PERSONNEL	TITLE	COUNTY	DATE
				Wood	12-13-57
				#69	4-14-60
					WEATHER 1-10-60
				SEC.	TEMP.

DESCRIPTION	LEFT	CENTER LINE	RIGHT	JOB NO.
SW. cor. sec. 1 Jackson Twp. Stone set R.R. spkr Cygnus Rd. #67		60' SW	Shi. in Anchor Post E. 47.35 Shi. in T. Pole W.N.W. 45.04 Shi. in T. Pole E. 47.3 N.E. cor. N. Haul N.W. 10.51 S.E. cor. S. Haul S.W. 20.91 Shiner in T.P. S.E. 63.02 Shiner in 30' ch. S.W. 31.46 W. edge of pavement E. 8.90 W.N.W. Shiner T. Pole 45.02	
E 1/4 post sec. 2 Jackson Twp. Found Hub over stone set spkr #68			Shi. in T. Pole N.W. 20.12 Shi. in T. Pole S.E. 29.16 Shiner in 24" spkr N.E. 66.43 Shiner in T.P. S.E. 60.10 Shiner in P.P. W.S.W. 36.7	
N.E. cor. sec. 2 Jackson Twp. R.R. spkr Jerry City Rd. #69			Shi. in T. Pole W.S.W. 74.53 N.W. cor. Haul S.S.W. 14.60 W. cor. Haul S.E. 33.52 Shiner in P.P. S.W. 19.55 East to stone #70 33.10	
SW. cor. sec. 26 Milton Twp. Found Shiner Fd. Iron Pin Jerry City Rd. #70			Shi. in Guard Rail Post E.N.E. 27.0 N.W. cor. Haul W.S.W. 43.43 Shiner in P.P. S.W. 74.18 Shiner in P.P. E.S.E. same 42.73 N.E. corner Haul S.E. 33.52 Shi. in Guard Rail Post No 23.92 Shi. in T.P. N.E. 35.17 Shiner 17 G. Post S.S.E. 19.90	
E 1/4 post of the S.E. 1/4 Sec. 35 Milton Twp. Stone Fd. R.R. Spk. 3' below surface #71			Stone 30.17 Shiner in P.P. S.W. 74.18 Shiner in T.P. S.E. 48.22 Shiner in P.P. W. 60.01 Iron pin in N.E. 21.11 Shi. T. Pole N.N.E. 14.15	

PERSONNEL	TITLE	PERSONNEL	TITLE	COUNTY	DATE
				Wood	12-13-57
				#69	4-14-60
				S. R.	WEATHER 1-18-66
				SEC.	TEMP.

DESCRIPTION	LEFT	CENTER LINE	RIGHT	JOB NO.
S.W. Cor. sec. 1 Jackson Twp. Stone Set R.R. Spk. Cygnet Rd. #67		60-59 11-23-59 Jackson	Shi. in Anchor Post E. 47.35 Shi. in T. Pole W.N.W. 45.04 Shiner Stone Pole 47.3 N.E. Cor. N. Hdwl. N.W. 101.42 S.E. Cor. S. Hdwl. S.W. 20.91 20.72 Shiner in T.P. S.E. 63.02 53.02 Shiner in 34" Elm Stk. 51.40 Wedge of pavement S. 8.80 W.N.W. Shiner T. Pole 45.04	
E 1/4 post sec. 2 Jackson Twp. Found Hub over Stone - 33' pipe #68			Cons. man. N.W. 30.2 Cons. man. S.W. 37.1 Shiner in 14" Apple N.E. 66.4 Shiner in T.P. S.E. 60.10 Shiner in P.P. N.E.W. 35.7	
N.E. Cor. sec. 2 Jackson Twp. R.R. Spk. Jerry City Rd. #69			Shi. in T. Pole W.S.W. 74.53 N.W. Cor. Hdwl. S.W. 19.60 S.W. Cor. Hdwl. S.E. 32.51 Shiner in T.P. W.S. 40.60 East to Stone #70 33.12	
S.W. Cor. sec. 36 Milton Twp. Found Shiner Fd. Iron Pin Jerry City Rd. #70			Shi. in Guard Rail Post E.N.E. 27.6 N.W. Cor. Hdwl. W.S.W. 43.43 Shiner in P.P. S.W. 57.15 Shiner in P.P. S.E. Gone 40.76 N.E. Cor. Hdwl. S.E. 60.10 51.40 Shi. in Guard Rail Post No 23.92	
E 1/4 post of the S.E. 1/4 Sec. 35 Milton Twp. Stone Fd. R.R. Spk. 3' Below Surface #71			Stone W. 30.17 Shiner in T.P. S.W. 73.78 Shiner in T.P. S.E. 48.22 Shiner in P.P. W. Gone 27.33 Iron pin S.E. N.E. 27.15 Shi. T. Pole N.N.E. 140.75 T. Pole FENCE Post 33.00	

PERSONNEL TITLE PERSONNEL TITLE

COUNTY Wood

DATE 12-13-57

S. R. #69

4-14-60

WEATHER 1-18-66

SEC.

TEMP.

DESCRIPTION

LEFT

CENTER LINE

RIGHT

JOB NO.

60' R/W

Shi. in Anchor Post E. 47.35

Shi. in T. Pole W.N.W. 45.04

E. Shiner Brace Pole 47.36

N.E. Cor. N. Hdwl. N.W. 10.48

S.E. Cor. S. Hdwl. S.W. 20.91 20.72

Shiner in T.P. S.E. 63.02 63.02

Shiner in 30' Elm S.W. 54.40

W. edge of pavement E. 8.80

W.N.W. Shiner T. Pole 45.04

Conc. man. N.W. 32.2

Conc. man. S.W. 39.10

Shiner in 14" Apple N.E. 66.43

Shiner in T.P. S.E. 60.10

Shiner in P.P. W.S.W. 36.72

Shi. in T. Pole W.S.W. 74.53

N.W. Cor. Hdwl. S.S.W. 14.80

S.W. Cor. of Hdwl. E of S. 32.58

Shiner in T.P. W of S. 40.50

East to Stone #70 33.18

Shi. in Guard Rail Post E.N.E. 27.6

N.W. Cor. Hdwl. W.S.W. 43.43

Shiner in P.P. S.W. 57.15

Shiner in P.P. E of S. 42.96

N.E. Cor. Stone Hdwl. E.S.E. 24.61

Shi. in Guard Rail Post No 23.92

Stone W. 30.17

Shiner in T.P. S.W. 98.78

Shiner in T.P. S.E. 48.22

Shiner in F.P. W. 33.60

Iron sign stk N.E. 37.15

Shi. T. Pole N.N.E. 140.75

S.W. Cor. sec. 1 Jackson
Twp. - Stone set R.R. spk.
Cygnat Rd.

#67

11

ck. 11-27-59
JamesonE 1/4 post sec. 2 Jackson
Twp. Found Hub over
stone - set pipe

#68

12

N.E. Cor. sec. 2 Jackson
Twp. R.R. spk.
Jerry City Rd.

#69

13

S.W. Cor. sec. 36. Milton
Twp. Found Shiner Fd. Iron Pin
Jerry City Rd.

#70

14

E 1/4 post of the S.E. 1/4
Sec. 35 Milton twp. - Stone
Fd. R.R. Spk. 3" Below Surface

#71

PERSONNEL	TITLE	PERSONNEL	TITLE

COUNTY Wood DATE 12-13-57S. R. #69 SR235 WEATHER 4-14-60

SEC. _____ TEMP. _____

DESCRIPTION

LEFT

CENTER LINE

JOB NO.

60' R/W
 Shi. in Anchor Post E. 47.35
 Shi. in T. Pole N.W. 45.00
 E. Shiner Brace Pole 47.35
 N.E. Cor. N. Hdwl. N.W. 10.48
 S.E. Cor. S. Hdwl. S.W. 20.91 23.72
 Shiner in T.P. S.E. 63.02 63.02
 Shiner in 30' Elm S.W. 54.40
 W. edge of pavement E. 10.80
 W.N.W. Shiner T. Pole 45.04

S.W. Cor. sec. 1 Jackson ✓
 Twp. Stone set R.P. spt.
 Cygnet rd.
 #67

9/10/65
MorrisonOK 11-27-59
Jameson

11

E 1/4 post sec. 2 Jackson ✓
 Twp. Found Hub over
 Stone - set pipe
 9/10/65
 Morrison

#68

12

Conc. mon. N.W. 32.52
 Conc. mon. S.W. 39.36
 Shiner in 14" Apple N.E. 66.32
 Shiner in T.P. S.E. 60.0'
 Shiner in P.P. W.S.W. 36.86

N.E. Cor. sec. 2 Jackson
 Twp. R.P. spt.
 Jerry City Rd.
 #69

9/10/65
Morrison

13

Shi. in T. Pole W.S.W. 74.53
 W. Cor. Hdwl. S.S.W. 14.5
 S.W. Cor. of Hdwl. E. of S. 32.52
 Shiner in T.P. W. of S. 40.50
 East to Stone #70 33.16

S.W. Cor. sec. 3, Milton
 Twp. Found Shiner
 Jerry City Rd.
 #70

14

Shi. in Guard Rail Post E.N.E. 27.5:
~~N.W. Cor. Hdwl. W.S.W. No. 43.38~~
 Shiner in P.P. S.W. 57.15
~~Shiner in P.P. E. of S. Gone 42.96~~
~~N.E. Cor. Stone Hdwl. E.S.E. No. 24.61~~
 Shi. in Guard Rail Post No 23.72

E 1/4 post of the S.E. 1/4
 Sec. 35 Milton Twp. - Stone

#71

Stone W. 30.17'
 Shiner in T.P. S.W. 98.78
 Shiner in T.P. S.E. 48.22
~~Shiner in P.P. W. Gone 33.55~~
 Iron sign stk N.E. 37.15'