

O.D.O.T. DISTRICT 2 SURVEY OFFICE (USE ONLY)

PERSONNEL

REFERENCE NO. 14

SHEET 12 OF 26

NOTES ASTON

DATE 8-21-24

ROUTE SR 235

H.C. NIESE

WEATHER CLEAR

COUNTY WOOD

R.C. PRESTON-COLVIN

TEMP. 65°

TOWNSHIP JACKSON

DWG BY PRESTON-COLVIN PID CHIPSEAL

T 4 N R 9 F

TYPE MONUMENT 1" IPIN IN MONBOX

~~ON SURFACE~~ - BELOW _____

OFFSET @ PAVEMENT 9.1' ~~11.7'~~ : RT

9.1' TO RT EDGE PAVEMENT

STATION: 319+19.69


HORZ.DATUM: NAD83 (2011)

GEOID: 2018

GRID: NORTHING: 581443.1

EASTING: 1615097

LDP: NORTHING: 402793.8

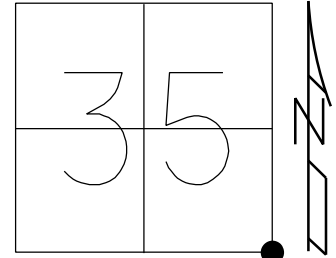EASTING: 126814.7

RECORD:
SET MAG & WASHER
11-3-03, DCH

FD MAG/WASHER
GPS, REF15
10-22-14


GPS, REF14
8-27-15

SET MAG/WASHER
GPS, NEWREF14
7-28-16, DCH

FD MONBOX
W/1" IPIN
REF14
8-21-24,TDN

FD MONBOX
9-18-24,TDN

DIST. 13-14= 33.26'

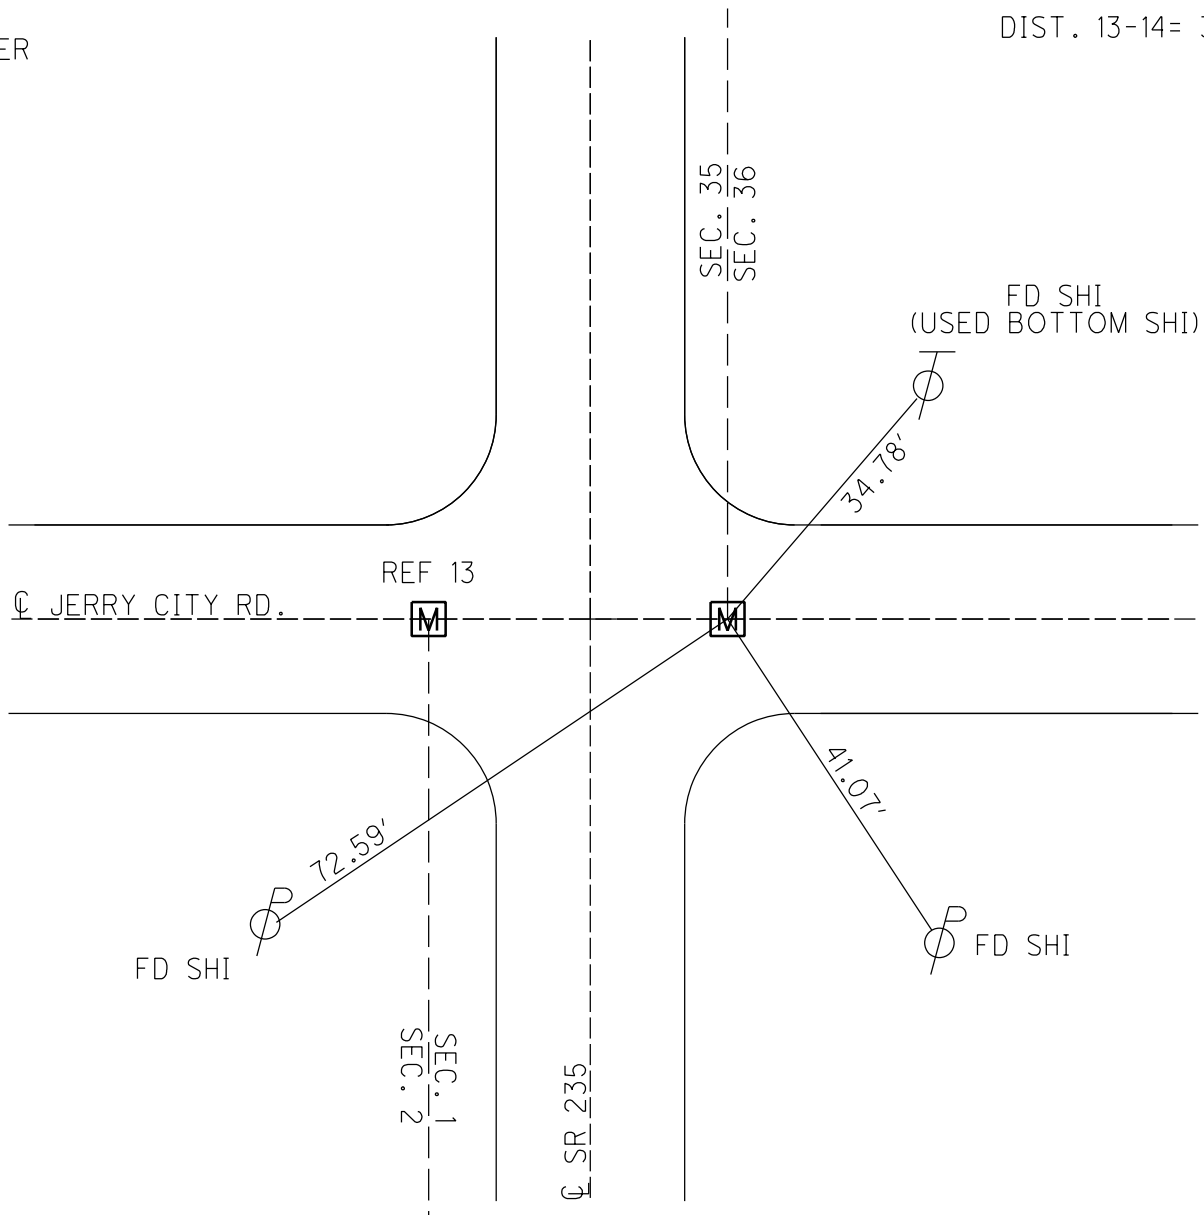

O.D.O.T. DISTRICT 2 SURVEY OFFICE (USE ONLY)

PERSONNEL

REFERENCE NO. 14

SHEET 12 OF 26

NOTES RHOADES

DATE 8-27-15

ROUTE SR 235

H.C. O'DONNELL

WEATHER SUNNY

COUNTY WOOD

R.C. RHOADES

TEMP. 62°F

TOWNSHIP JACKSON

SECTION 35

T 4 N R 9 E

TYPE MONUMENT PK NAIL


ON SURFACE - ~~BELOW~~ ON

~~LEFT~~ - Q PAV'T - RIGHT 9.1'

9.1' TO RT EDGE PAVEMENT

S.L.M. 319+19.69

Grid: Northing: 581443.1981 Easting: 1615096.6679

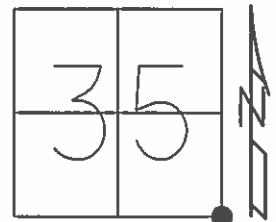


RECORD:
SET MAG & WASHER
11-3-03, DCH

FD MAG/WASHER
GPS, REF15
10-22-14

GPS, REF14
8-27-15

SET MAG/WASHER
GPS, NEWREF14
7-28-16, DCH

DIST. 13-14= 33.26'

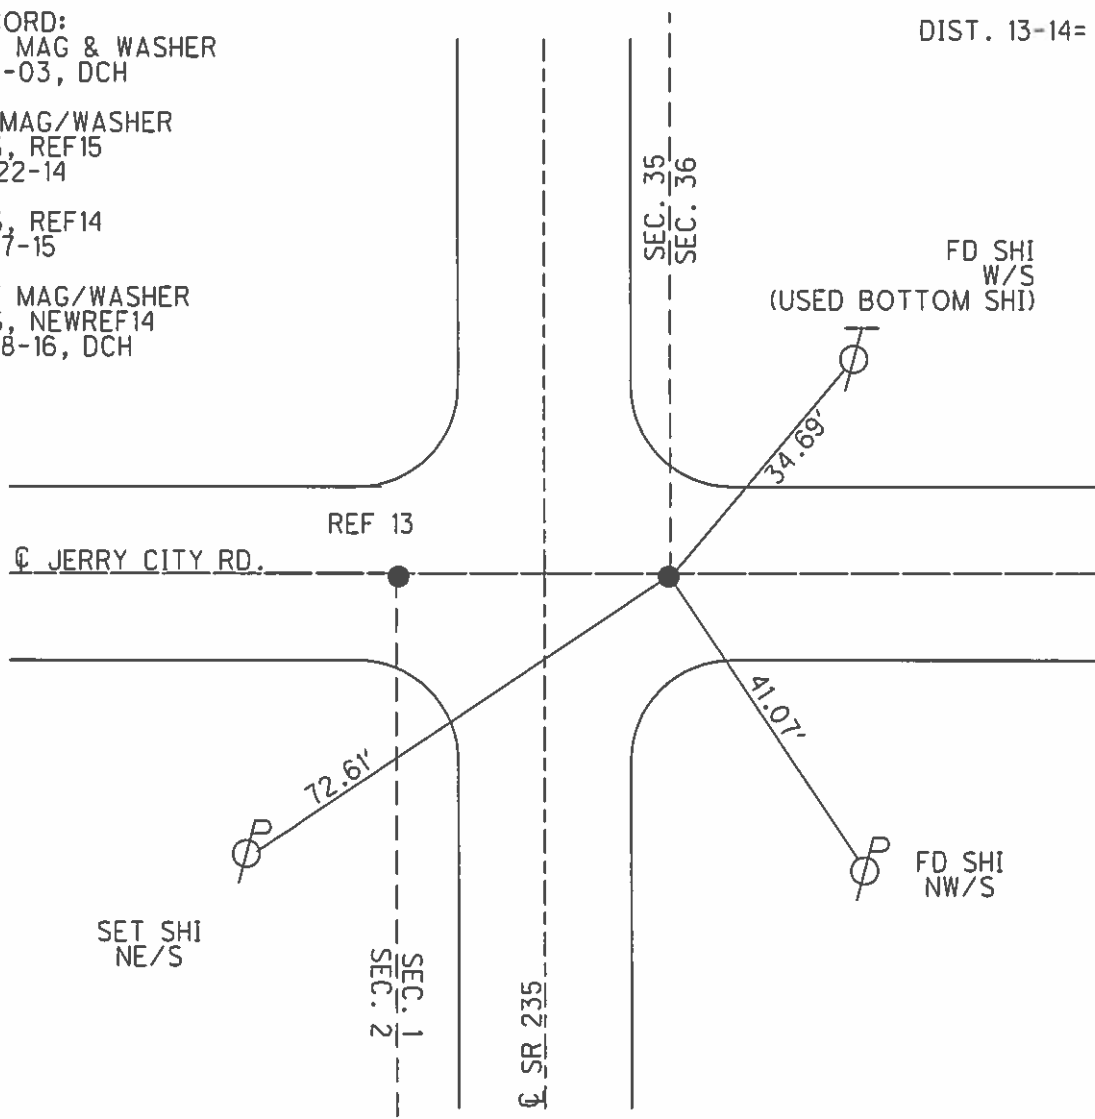

O.D.O.T. DISTRICT 2 SURVEY OFFICE

PERSONNEL

REFERENCE NO. 13+14

SHEET 10 OF 23

NOTES _____ Homan

DATE 9-24-03

ROUTE 235

H.C. Nuhfer

WEATHER Cloudy

COUNTY WOOD

R.C. Ballmer

TEMP. 60°

TOWNSHIP MILTON & JACKSON

SECTION 35-36-1-2

T 3 N R 9 E


TYPE MONUMENT A; RR Spk-B; PK Nail

~~ON SURFACE - BELOW~~ | "


LEFT - @ PAV'T - RIGHT A24.4'L-B9.1'R

A15.8 LT of LT
B9.1 TO RT EDGE PAVEMENT

S.L.M. 318+05 3.2" S of C of JC Rd W

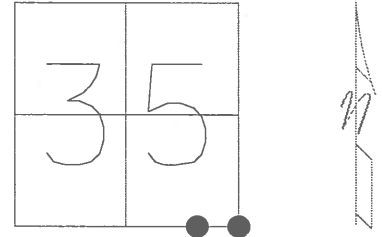

Point "A"
was not disturbed
Point "B"
set Mag & Washer
11-3-03
DCH

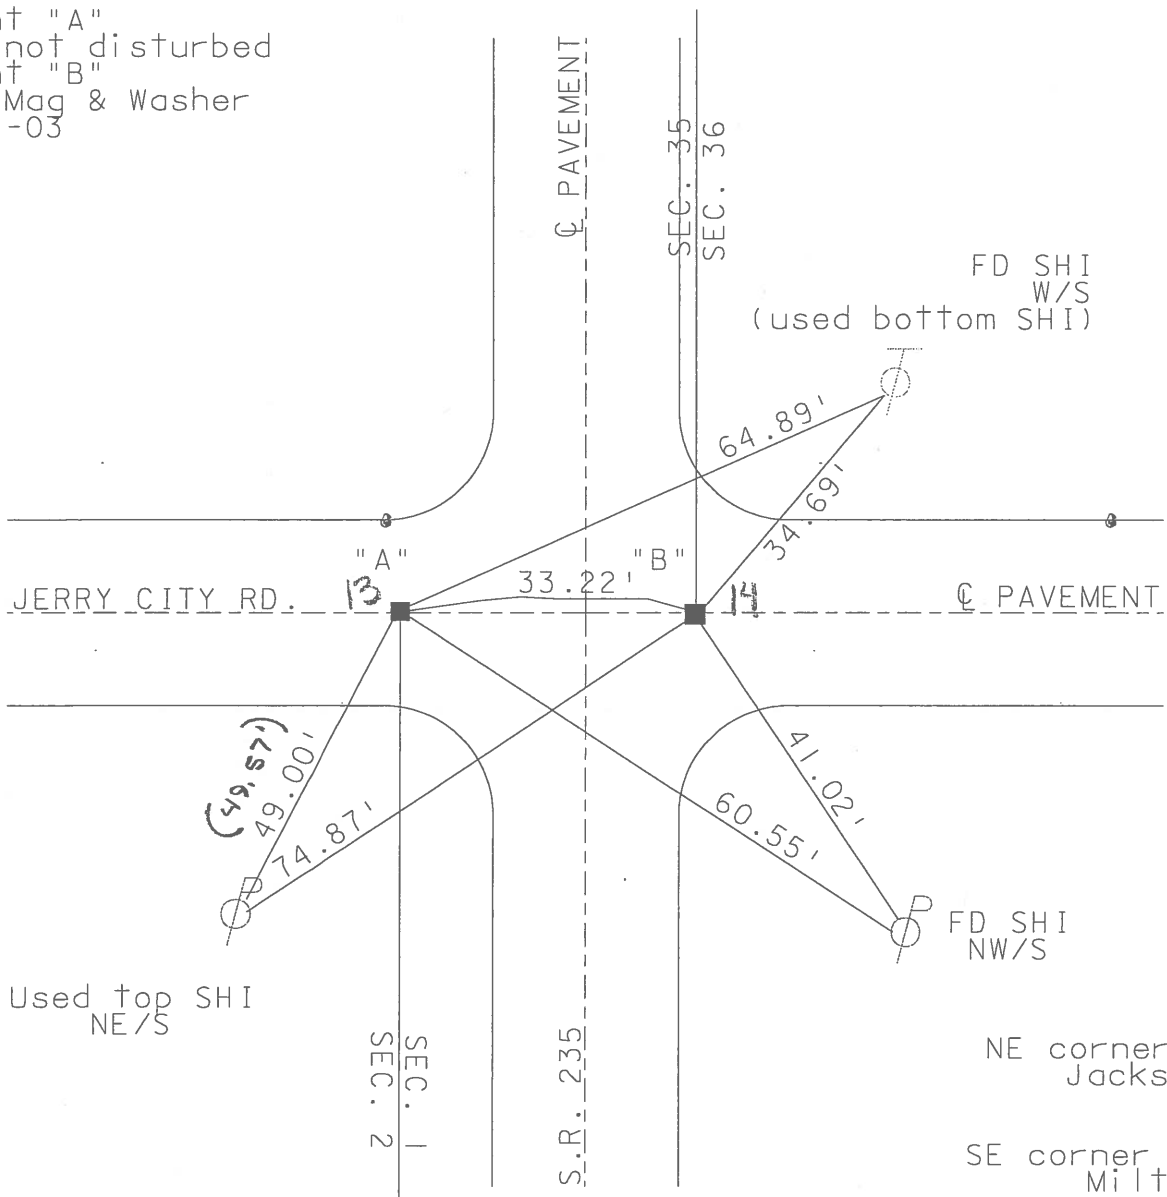

PT "A"
NE corner SEC 2
Jackson Twp

SE corner PT "B"
SEC 35
Milton Twp

O.D.O.T. DISTRICT 2 SURVEY OFFICE

PERSONNEL

REFERENCE NO. 1344

SHEET 9 OF 28

NOTES STEVE HUSS

H.C. KEVIN MOSER

R.C. STEVE HUSS

DATE 5-21-96

WEATHER Sunny

TEMP. + 74°F

ROUTE S.R. 235

COUNTY WOOD

TOWNSHIP MILTON/JACKSON

SECTION 35-36-1-2

T3 N R9 E


TYPE MONUMENT PT "A" + PT "B" - Sm. R.R SPIKE

~~ON SURFACE~~ - BELOW 1"


LEFT - C PAU'T. - RIGHT "A" - 24.4' LT, "B" - 9.1 RT

A-15.8 LT OF LT.
B-9.1' TO RT EDGE PAVEMENT

S.L.M. 318+05 ~ 3.2' S. OF E OF J.C. Rd WEST

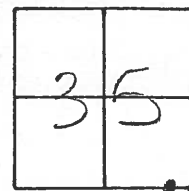

SET PK/WASHERS
10-7-96
BVD

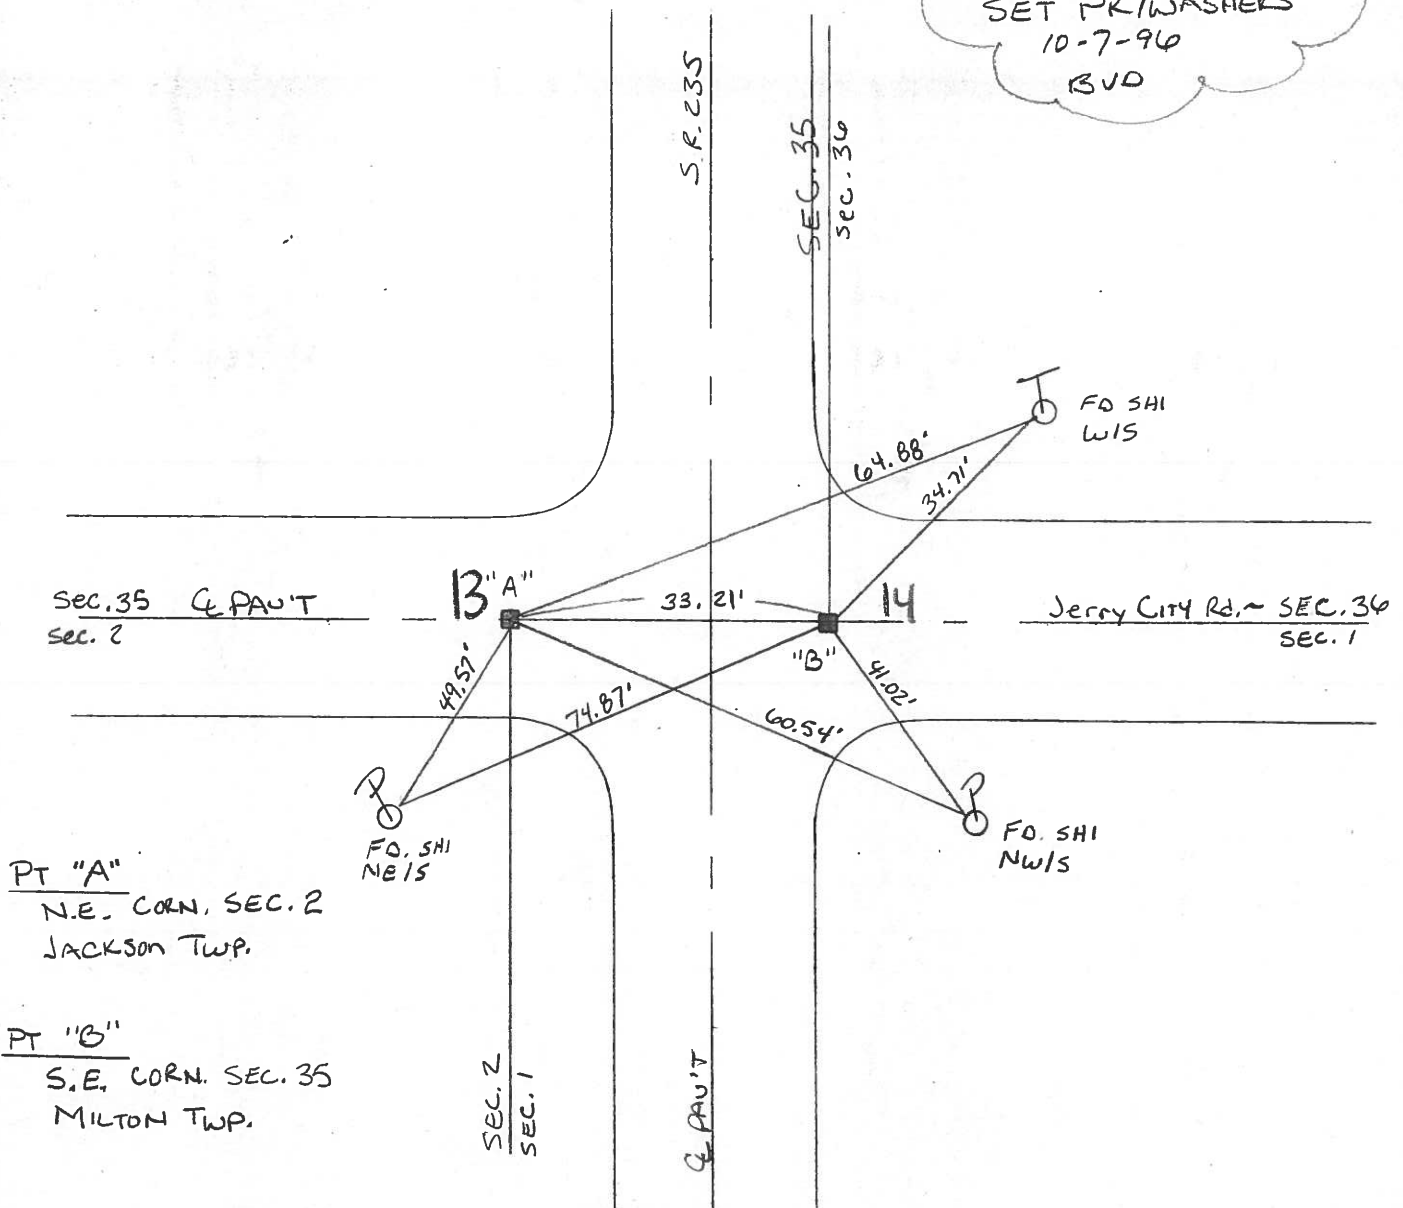

PT "A"
N.E. CORN. SEC. 2
JACKSON TWP.

PT "B"
S.E. CORN. SEC. 35
MILTON TWP.

O.D.O.T. DISTRICT 2 SURVEY OFFICE

PERSONNEL

REFERENCE NO. 13+14

SHEET OF

NOTES BARNHISEL

H.C. Loehrke

R.C. HOFFMAN

DATE 6-3-86

WEATHER SUNNY

TEMP. +65°

ROUTE 235

COUNTY WOOD

TOWNSHIP MILTON + JACKSON

SECTION 35

T 3 N R 9 E

TYPE MONUMENT Sm RR Spk

ON SURFACE - BELOW 1"



LEFT - C PAW'T. - RIGHT 25'

- TO - EDGE PAVEMENT

S.L.M. 3/8 + 06


3.2 S. of & J.C. Rd West

Set Sm RR Spk
6-26-86
mab

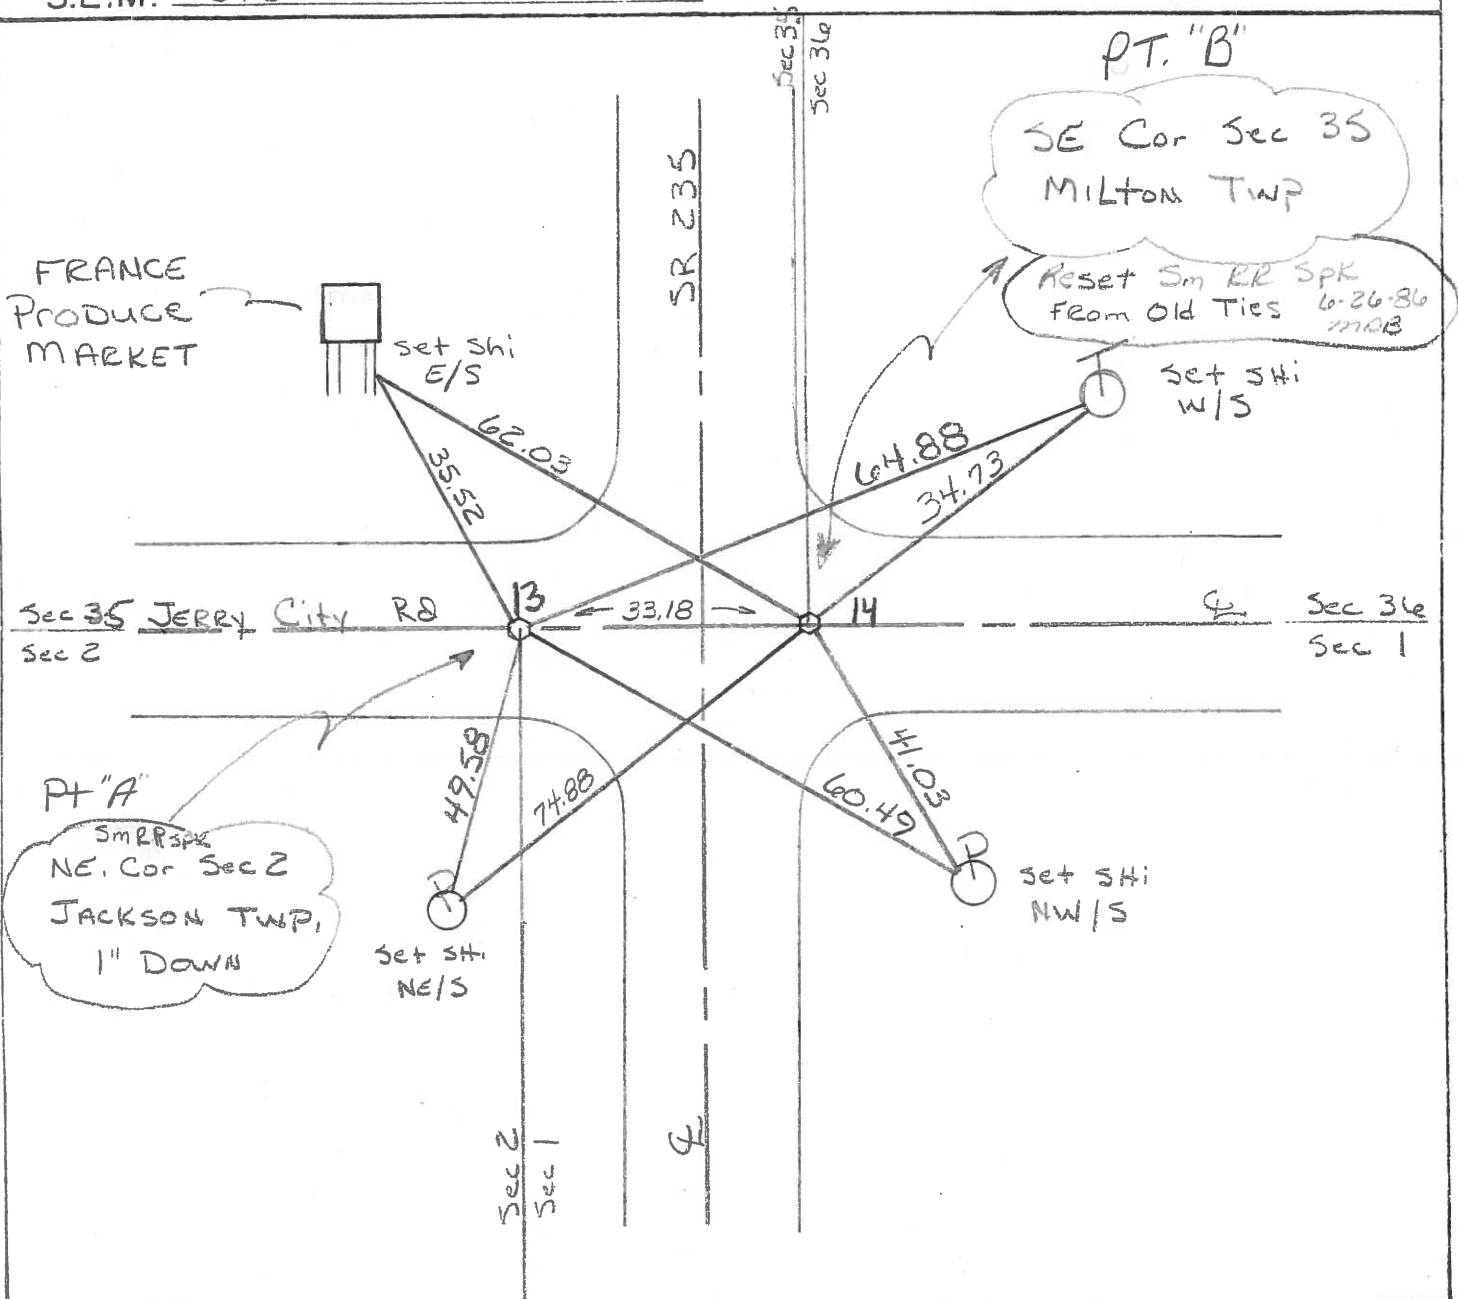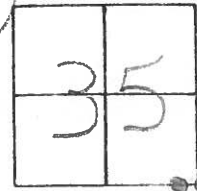

PERSONNEL	TITLE	PERSONNEL	TITLE	COUNTY	DATE	WEATHER	TEMP.
BURNSIDE				Wood	12-23-75	P. CLOUDY	+28°
SMITH				S. R. 235			
BOWERS				SEC. JERRY CITY ROAD			
MEAD							

DESCRIPTION CONTROL TIES JOB NO. _____

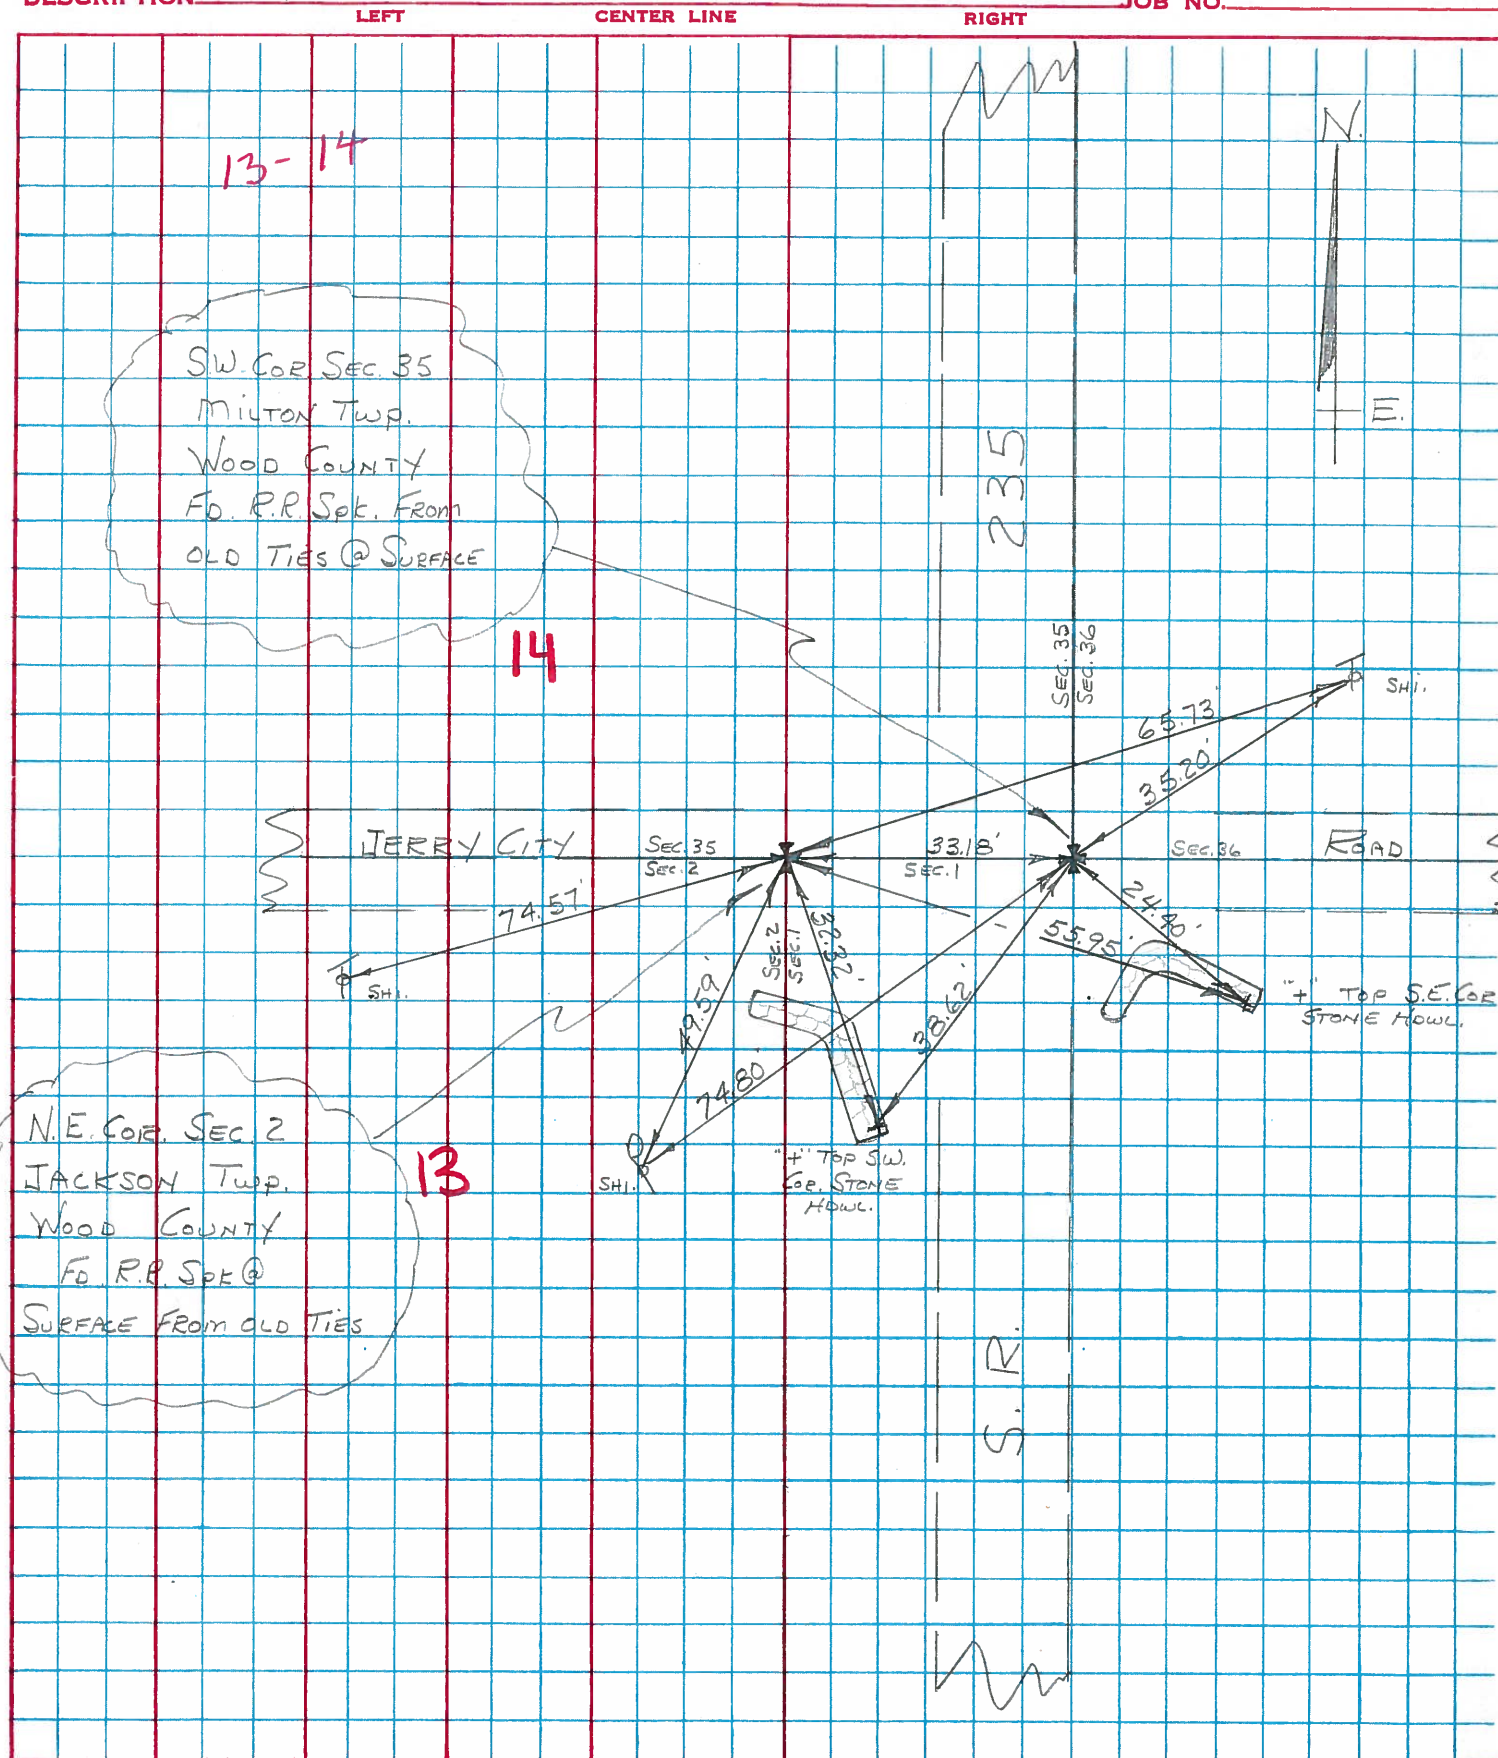

PERSONNEL TITLE PERSONNEL TITLE

SILVESTERCOUNTY WoodDATE 7-69S. R. # 235

WEATHER

SEC.

TEMP.

DESCRIPTION

LEFT

CENTER LINE

RIGHT

JOB NO.

#68 E 1/4 Post Sec 2 Jackson Twp Found Stone Set Pipe over Stone	#12				Cont. Mt. S.W. 39.10 Shiner in 28" Apple N.E. 66.43 ✓ " " T.Pole SE, 60.10 " " P. " W.S.W. 36.77 Shiner in T. Pole W.S.W. 74.53 N.W. Cor. Hd. Wall S.S.W. 14.69 Sw. " " " E. of S. 32.58 Shiner in P. Pole S.W. 49.55 E. to Stone #70 33.18 N.W. Cor. Hd. Wall W.S.W. 43.43 Shiner in P. Pole S.W. 74.76 " " T. Pole N.E. 35.17 " " G. Rail Post S.S.E. 19.90 W. to Stone or R.R. Spk. 33.18 Stone W. 30.17 Shiner in T. Pole SE. 48.22 Iron fence post W. 33.00 Shiner in T. Pole N.N.E. 140.75 Shiner in T. Pole E. 21.02 Stone E. 30.0 " W. 30.0 Shiner in P. Pole S.W. 43.30 " " W. Cherry E. 54.70
#69 N.E. Cor. Sec. 2 Jackson Twp. R.R. Spk.	#13 Jerry City				
#70 Sw. Cor. Sec 36 Milton Twp Rd from Pine Jerry City Rd.	#13A		(14)		
#71 E 1/4 post of the SE. 1/4 Sec 35 Milton Twp. Stone. Rd R.R. Spk. on Top 3' below surface	#14		(14A)		
#72 W. 1/4 Post Sec. 36 Milton Twp. Stone Rd.	#15				

PERSONNEL

TITLE

PERSONNEL

TITLE

COUNTY Wood.DATE March, 26, 1968S. R. #69WEATHER Cloudy, Showers.

SEC. _____

TEMP. + 40°

DESCRIPTION

Ties to Control Points.

JOB NO. _____


LEFT

CENTER LINE


RIGHT

Iron pin
SW. cor., Sec., #36
Milton Twp.
T. 4 N., - R. 9 E.


14

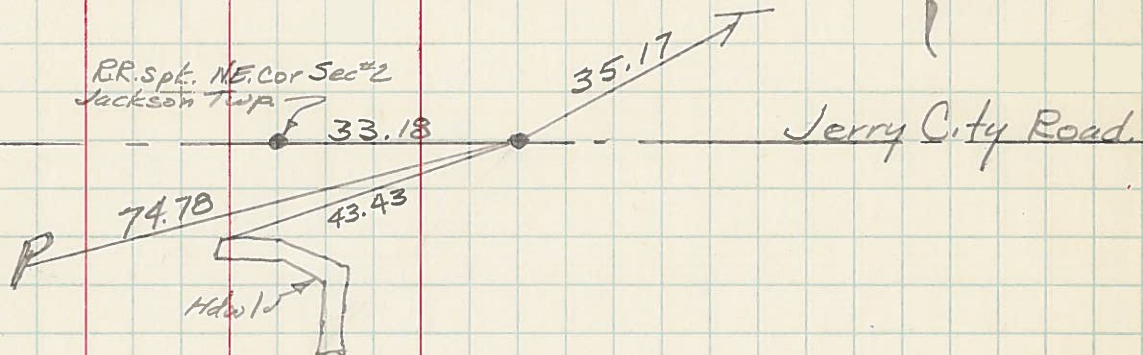


E 1/4 of S.E. 1/4
80 Rods N. of Spt. 1/4
Sec. #36 Milton Twp.
T. 4 N. - R. 9 E.

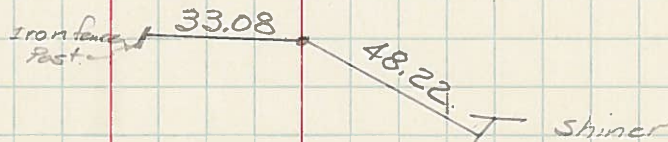

W 1/4 of Sec. #36
Milton Twp.
T. 4 N. - R. 9 E.

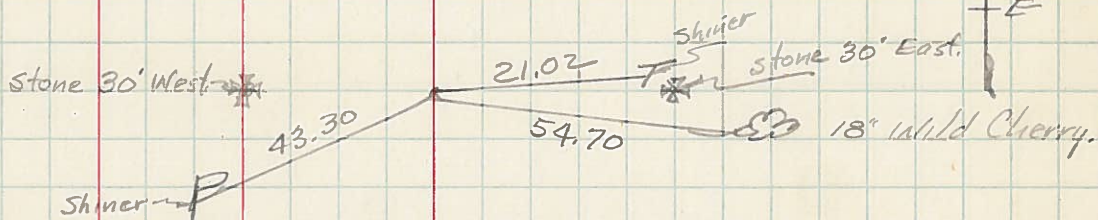

N.W. Cor Sec. #36
Milton Twp.
T. 4 N. - R. 9 E.

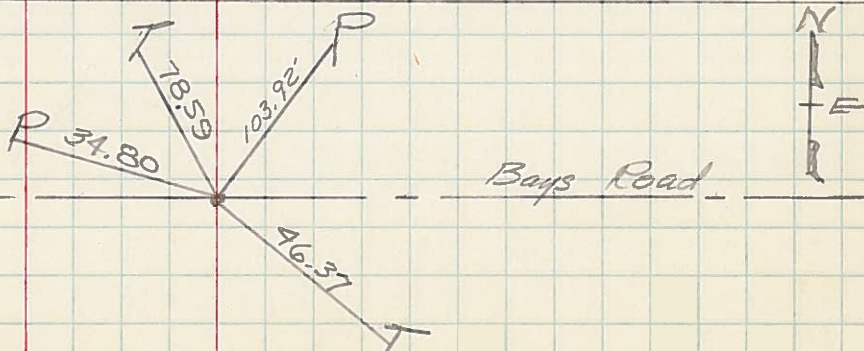

16

PERSONNEL	TITLE	PERSONNEL	TITLE	COUNTY	DATE
				Wood	12-13-57
				S. R. #69	4-14-60
				SEC.	WEATHER 1-10-66
					TEMP.

DESCRIPTION	LEFT	CENTER LINE	RIGHT	JOB NO.
SW. Cor. sec. 2 Jackson Twp. Stone set R.R. right Cygnus Rd. #67		60' SW	Shi. in Anchor Post E. 47.35 Shi. in T. Pole W.N.W. 45.04 Shi. in T. Pole S.E. 47.3 N.E. Cor. N. Haul. NW. 10.51 S.E. Cor. S. Haul. SW 20.91 Shiner in T.P. S.E. 63.02 Shiner in 30' E.P. SW. 20.40 W. edge of pavement E. 8.90 W.N.W. Shiner T. Pole 45.02	
E 1/4 post sec. 2 Jackson Twp. Found Hub over Stone set pipe #68			Conc. man. gene NW. 20.2 Conc. man. S.W. 29.10 Shiner in 28" Apple N.E. 66.42 Shiner in T.P. S.E. 60.10 Shiner in P.P. N.E.W. 36.71	
N.E. Cor. sec. 2 Jackson Twp. R.R. right Jerry City Rd. #69			Shi. in T. Pole W.N.W. 74.58 N.W. Cor. Haul. S.S.W. 19.60 S.W. Cor. Haul. S.E. 53.50 Shiner in P.P. S.W. 49.55 East to Stone #70 33.10	
S.W. Cor. sec. 36, Milton Twp. Found Shiner Fd. Iron Pin Jerry City Rd. #70			Shi. in Guard Rail Post E.N.E. 27.6 N.W. Cor. Haul. W.S.W. 43.43 Shiner in P.P. S.W. 74.15 Shiner in P.P. S.E. 43.76 N.E. Cor. Haul. S.E. 53.50 Shi. in Guard Rail Post No 22.92 Shi. in T.P. N.E. 35.17 Shiner in G. Post S.S.E. 19.90	
E 1/4 post of the S.E. 1/4 Sec. 36 Milton Twp. Stone Fd. R.R. Epk. 3' below surface #71			Stone 30.17 Shiner in T.P. S.E. 78.72 Shiner in T.P. S.E. 48.22 Shiner in P.P. W. 400.51 Iron Pin, S.E. N.E. 27.15 Shi. T. Pole N.N.E. 14.75	

PERSONNEL TITLE PERSONNEL TITLE

COUNTY Wood DATE 12-13-57

S. R. #69 WEATHER 4-14-60

SEC. TEMP. 1-18-66

DESCRIPTION

LEFT

CENTER LINE

RIGHT

JOB NO.

S.W. Cor. sec. 1 Jackson
Twp. - Stone set R.R. spk.
Cygnat Rd.

#67

11

60' R/W
Shi. in Anchor Post E. 47.35
Shi. in T. Pole W.N.W. 45.84
E. Shiner Brace Pole 47.35
N.E. Cor. N. Hdwl. N.W. 10.48
S.E. Cor. S. Hdwl. S.W. 20.91 20.72
Shiner in T.P. S.E. 63.02 63.02
Shiner in 30' Elm S.W. 54.40
W. edge of pavement E. 8.80
W.N.W. Shiner T. Pole 45.04

E 1/4 post sec. 2 Jackson
Twp. Found Hub over
stone - set pipe

#68

12

Conc. man. N.W. 32.2
Conc. man. S.W. 39.10
Shiner in 14" Apple N.E. 66.43
Shiner in T.P. S.E. 60.10
Shiner in P.P. W.S.W. 36.72

N.E. Cor. sec. 2 Jackson
Twp. R.R. spk.
Jerry City Rd.

#69

13

Shi. in T. Pole W.S.W. 74.53
N.W. Cor. Hdwl. S.S.W. 19.60
S.W. Cor. of Hdwl. E of S. 32.58
Shiner in T.P. W of S. 40.50
East to Stone #70 33.18

S.W. Cor. sec. 36, Milton
Twp. Found Shiner Fd. Iron Pin
Jerry City Rd.

#70

14

Shi. in Guard Rail Post E.N.E. 27.6
N.W. Cor. Hdwl. W.S.W. 43.43
Shiner in P.P. S.W. 57.15
Shiner in P.P. E of S. Gone 42.96
N.E. Cor. Stone Hdwl. E.S.E. 600' 24.61
Shi. in Guard Rail Post No 23.92

E 1/4 post of the S.E. 1/4
Sec. 35 Milton Twp. - Stone
Fd. R.R. Spk. 3' Below Surface

#71

Stone W. 30.17
Shiner in T.P. S.W. 98.78
Shiner in T.P. S.E. 48.22
Shiner in P.P. W. Gone 33.60
Iron sign st N.E. 37.15
Shi. T. Pole N.N.E. 140.75

PERSONNEL	TITLE	PERSONNEL	TITLE

COUNTY Wood DATE 12-13-57
4-14-60
 S. R. #69 SR 235 WEATHER
 SEC. TEMP.

DESCRIPTION	LEFT	CENTER LINE	RIGHT	JOB NO.
SW. Cor. sec. 1 Jackson Twp. - Stone set R.R. spk. Cygnat Rd. #67	9/10/65 Morrison	CK 11-27-59 Jenerson	Shi. in Anchor Post E. 47.35 Shi. in T. Pole N.W. 45.00 E. Shiner Brace Pole 47.35 N.E. Cor. N. Hdwl. N.W. 10.48 S.E. Cor. S. Hdwl. S.W. 20.91 20.72 Shiner in T.P. S.E. 63.02 63.02 Shiner in 30' Elm S.W. 54.40 W. edge of pavement E. 10.80 W.N.W. Shiner T. Pole 45.04	
E 1/4 post sec. 2 Jackson Twp. Found Hub over Stone - set pipe #68	9/10/65 Morrison		Conc. mon. N.W. 32.52 Conc. mon. S.W. 39.36 Shiner in 14" Apple N.E. 66.32 Shiner in T.P. S.E. 60.0' Shiner in P.P. W.S.W. 35.85	
N.E. Cor. sec. 2 Jackson Twp. R.R. spk. Jerry City Rd. #69	9/10/65 Morrison		Shi. in T. Pole W.S.W. 74.53 W. Cor. Hdwl. S.S.W. 14.5 S.E. Cor. of Hdwl. E of S. 32.58 Shiner in T.P. W of S. 40.50 Post to Stone #70 33.18	
S.W. Cor. sec. 3 Milton Twp. Found Shiner Jerry City Rd. #70			Shi. in Guard Rail Post E.N.E. 27.52 N.W. Cor. Hdwl. W.S.W. 60.04 43.28 Shiner in P.P. S.W. 57.15 Shiner in P.P. E of S. 60.04 42.96 N.E. Cor. Stone Hdwl. E.S.E. 60.04 24.61 Shi. in Guard Rail Post No 23.72	
E 1/4 post of the S.E. 1/4 Sec. 35 Milton Twp. - Stone #71			Stone W. 30.17 Shiner in T.P. S.W. 98.78 Shiner in T.P. S.E. 48.22 Shiner in P.P. W. 60.04 32.65 Iron Sign stk N.E. 37.15	