

O.D.O.T. DISTRICT 2 SURVEY OFFICE (USE ONLY)

PERSONNEL

REFERENCE NO. 14B

SHEET 14 OF 26

NOTES ASTON
H.C. NIESE
R.C. PRESTON-COLVIN

DATE 8-21-24
WEATHER CLEAR
TEMP. 65°

ROUTE SR 235
COUNTY WOOD
TOWNSHIP MILTON
SECTION 35
T 4 N R 9 E

DWG BY PRESTON-COLVIN PID CHIPSEAL

TYPE MONUMENT MAG/WASHER

ON SURFACE - ~~BELOW~~ ON

OFFSET Q PAVEMENT 0.5' LT : ~~RT~~

9.4' TO RT EDGE PAVEMENT

STATION: 332+44.34

HORZ.DATUM: NAD83 (2011)


GEOID: 2018

GRID: NORTHING: 582767.7

EASTING: 1615097

LDP: NORTHING: 404118.3

EASTING: 126798

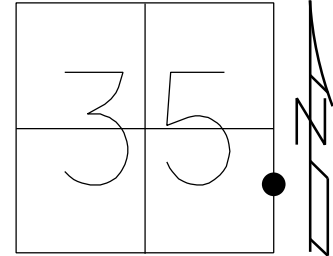

RECORD:
NOTE: NO PERMANET
REF TIES AVAILABLE
POINTS HELD- RESET
USING TEMPORAY HUBS 2003

FD MAG/WASHER
11-3-03, DCH


FD MAG NAIL
GPS, REF16
10-22-14

GPS, REFA14
8-27-15

ALL TIES DESTROYED
SET MAG/WASHER
W/COORDINATES
GPS, NEWREFA14
9-6-16, JFO

FD MAG/WASHER
REF14A
8-21-24,TDN

FD MAG/WASHER
9-18-24,TDN

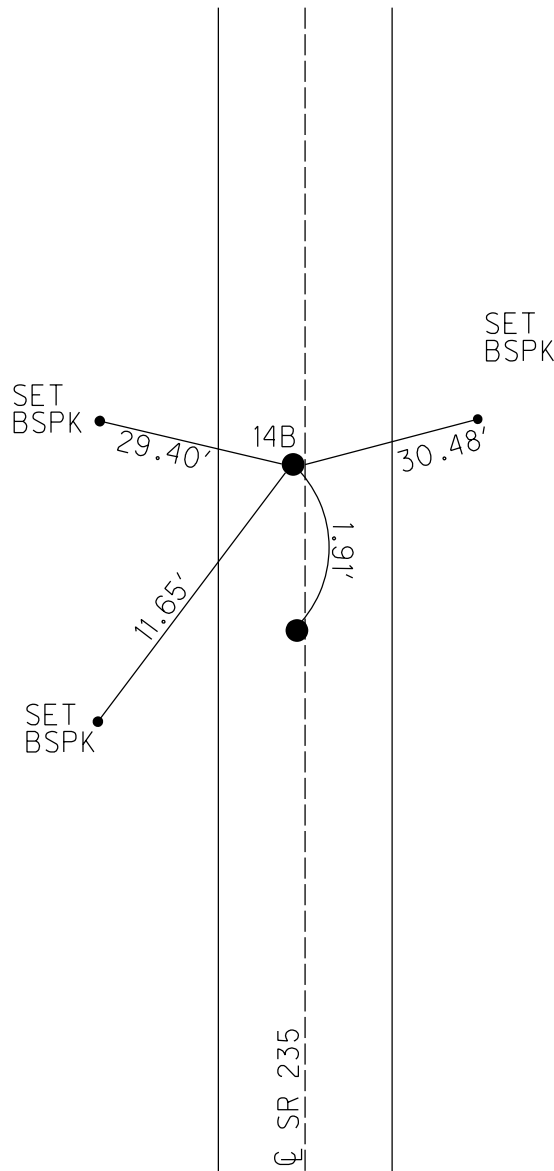

O.D.O.T. DISTRICT 2 SURVEY OFFICE (USE ONLY)

PERSONNEL

REFERENCE NO. 14 B

SHEET 14 OF 26

NOTES RHOADES

DATE 8-27-15

ROUTE SR 235

H.C. O'DONNELL

WEATHER SUNNY

COUNTY WOOD

R.C. RHOADES

TEMP. 62°F

TOWNSHIP MILTON

SECTION 35

T 4 N R 9 E

TYPE MONUMENT PK/WASHER


ON SURFACE - ~~BELOW~~ ON

LEFT - C PAV'T - ~~RIGHT~~ 0.5'

9.4' TO RT EDGE PAVEMENT

S.L.M. 332+44.34

Grid: Northing: 582767.6347 Easting: 1615097.4405

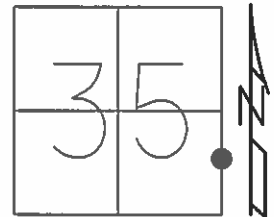

RECORD:


NOTE: NO PERMANET
REF TIES AVAILABLE
POINTS HELD- RESET
USING TEMPORAY HUBS 2003

FD PK/WASHER
11-3-03, DCH

FD MAG NAIL
GPS, REF17
10-22-14

GPS, REFB14
8-27-15

ALL TIES DESTROYED
SET MAG/WASHER
W/COORDINATES
GPS, NEWREFB14
9-6-16, JFO

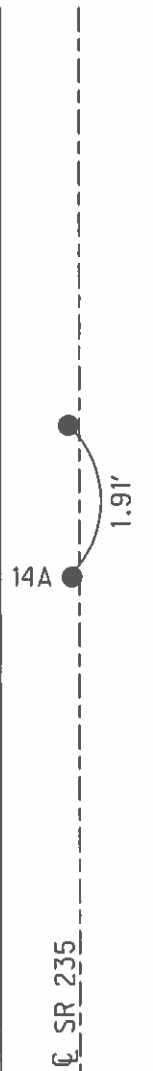

O.D.O.T. DISTRICT 2 SURVEY OFFICE

PERSONNEL

REFERENCE NO. 14-A

SHEET 11 OF 23

NOTES Homan

DATE 9-24-03

ROUTE 235

H.C. Nuhfer

WEATHER CLOUDY

COUNTY WOOD

R.C. Ballmer

TEMP. 60°

TOWNSHIP MILTON

SECTION 35

T 4 N R 9 E

TYPE MONUMENT PK & Washer


ON SURFACE - BELOW on surface

LEFT - Q PAV'T - RIGHT A; 1.3' - B: 0.5'


A 10.2' RT

B 9.4' TO RT EDGE PAVEMENT

S.L.M. 331+31 PT "B"

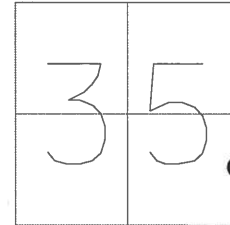

PT "A"
Mag. & Washer
PT "B"
PK & Washer
11-3-03
DCH

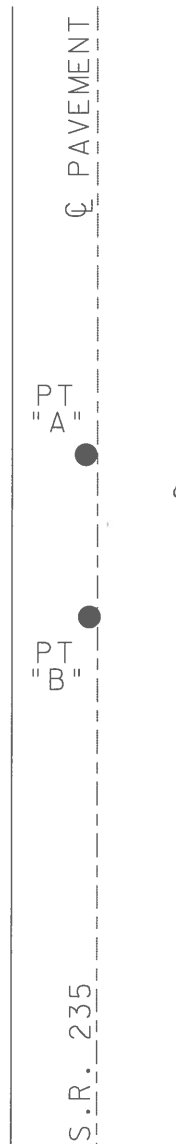

NOTE:

No permanent Ref. TIES
Available.

Points held - reset - using
Temporary Hubs. 2003

O.D.O.T. DISTRICT 2 SURVEY OFFICE

PERSONNEL

REFERENCE NO. 14-A

SHEET 10 OF 28

NOTES BOB VANDUSEN

H.C. KEVIN MOSER

R.C. BRAD STIFFLER

DATE 7-30-96

WEATHER CLOUDY

TEMP. +70°F

ROUTE S.R. 235

COUNTY WOOD

TOWNSHIP MILTON

SECTION 35

T 4 N R 9 E



TYPE MONUMENT PT "A" LG RR, SPIKE PT "B" Sm. R.R. SPIKE

ON SURFACE - ~~BELOW~~ SURFACE

LEFT - ~~C PAV'T~~ - RIGHT "A" - 1.3 "B" - 0.5'

^{A - 10.2}
^{9 - 9.4} TO ^{RT} ^{RT} EDGE PAVEMENT

S.L.M. 331 + 31 PT "B"

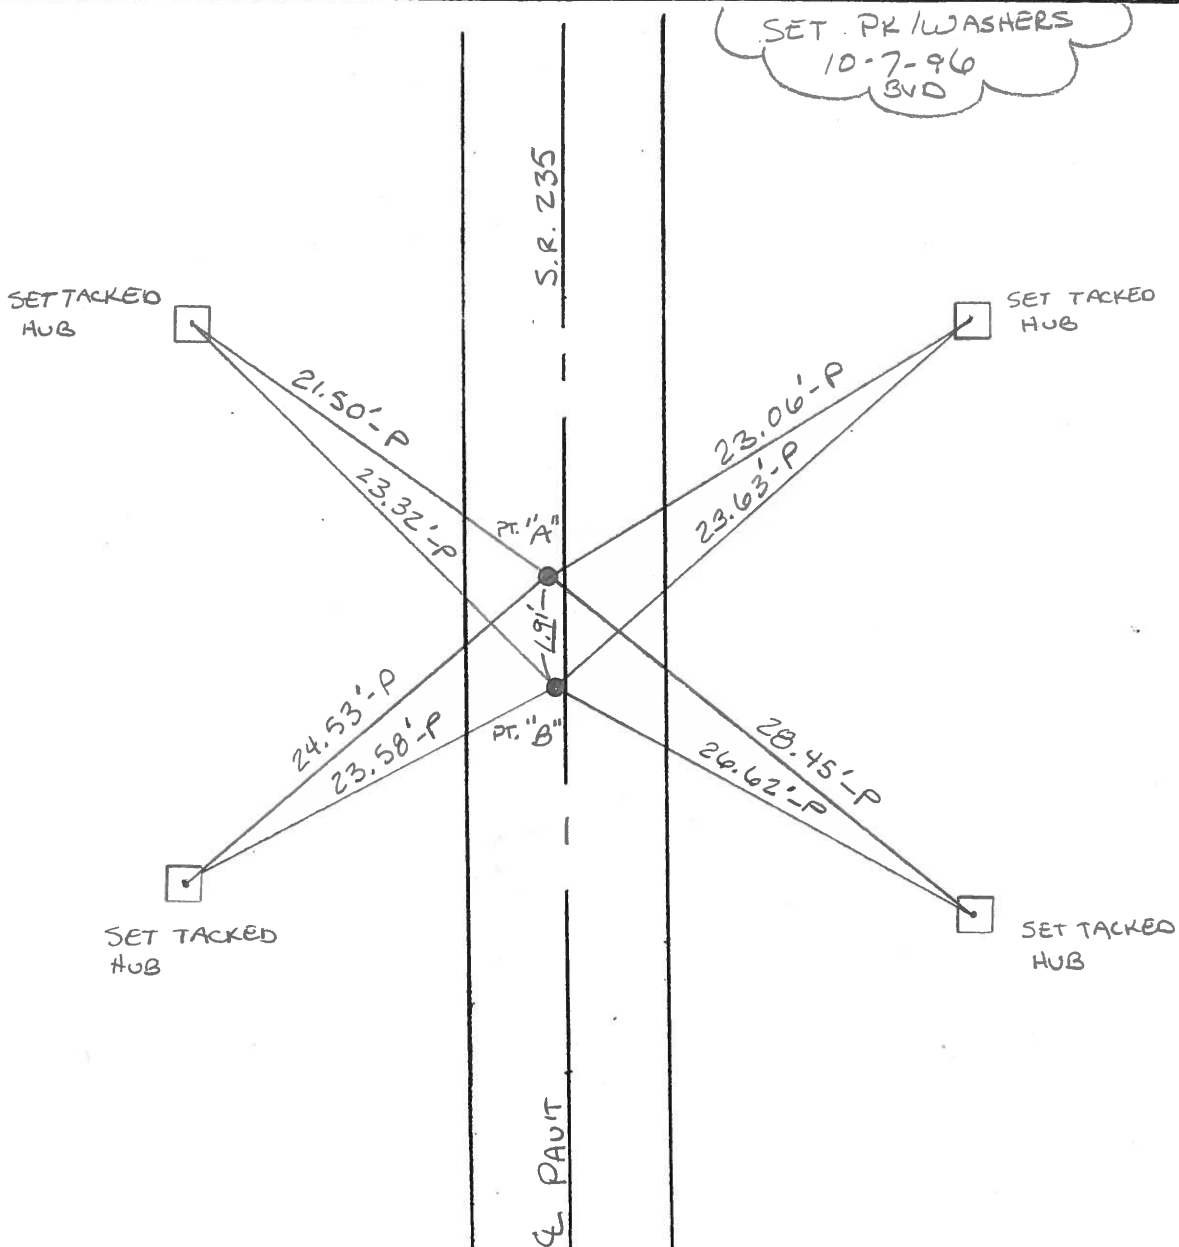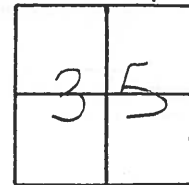

O.D.O.T. DISTRICT 2 SURVEY OFFICE

PERSONNEL

REFERENCE NO. 14-A

SHEET OF

NOTES BARNHISEL

H.C. Loehrke

R.C. HOFFMAN

DATE 6-3-86

WEATHER SUNNY

TEMP. + 65°

ROUTE 235

COUNTY WOOD

TOWNSHIP MILTON

SECTION 35

T 4 N R 9 E

TYPE MONUMENT Pt "A" Lg RR Spk Pt "B" Sm RR Spk


ON SURFACE - BELOW yes

LEFT- & PAV'T. - RIGHT Pt "A" 1.5' Pt "B" .7'


Pt "A" 7.70 to Lt EDGE PAVEMENT Pt "B" 8.5 to Lt Ed pav't

S.L.M. 331 + 32

1.91 Between Pts.

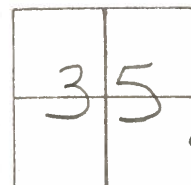

Set Sm RR Spks
6-26-86
MOB
Pulled Hubs

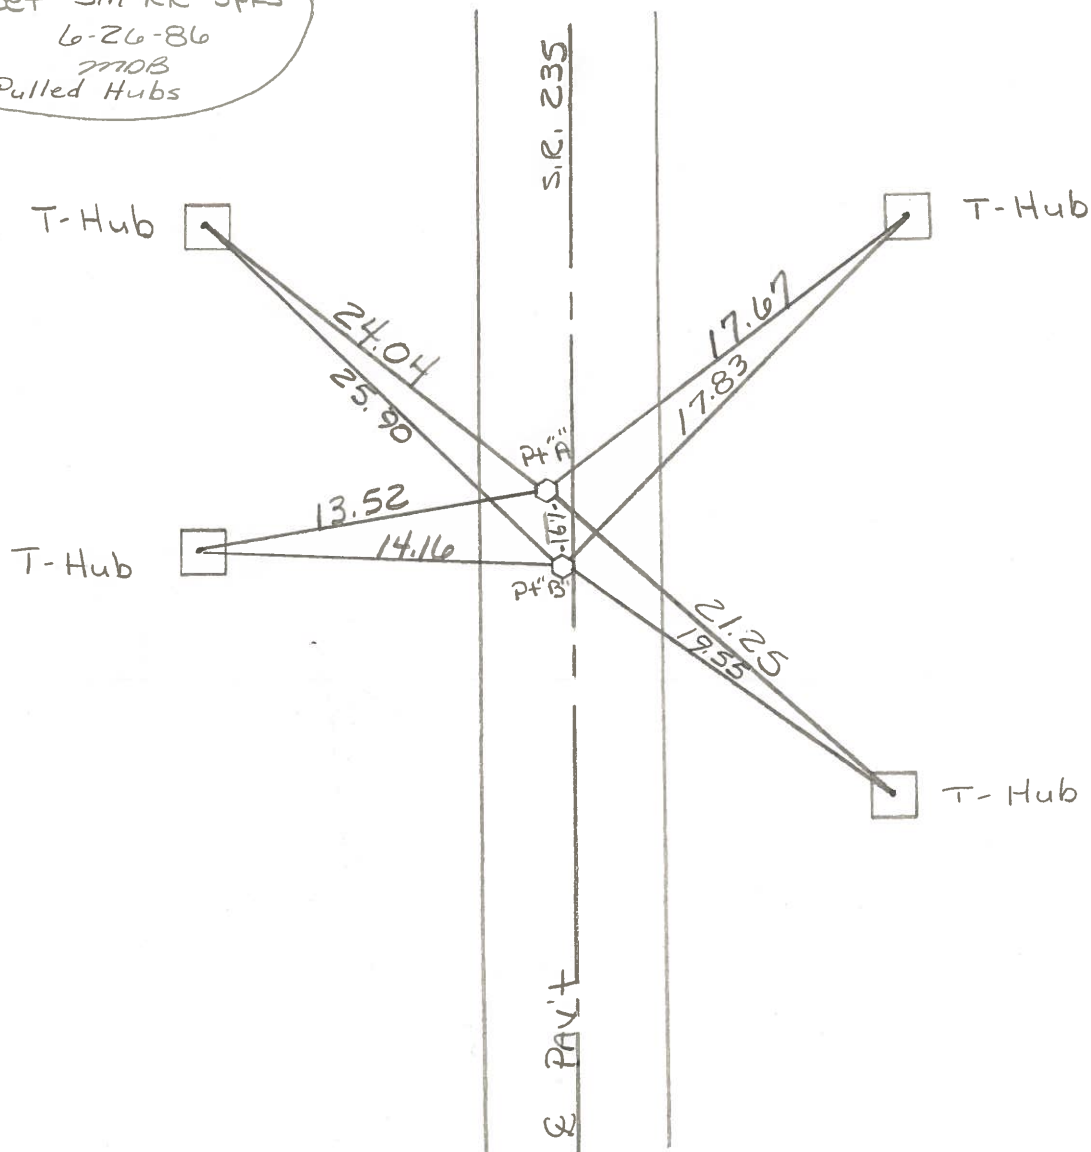

PERSONNEL TITLE PERSONNEL TITLE

BURNSIDE

COUNTY WOOD

DATE 12-24-75

SMITH

S. R. 235

WEATHER CLEAR

BOWERS

SEC. 35

TEMP. +18°

MEAD

DESCRIPTION


± CONTROL TIES

JOB NO.

LEFT

CENTER LINE

RIGHT

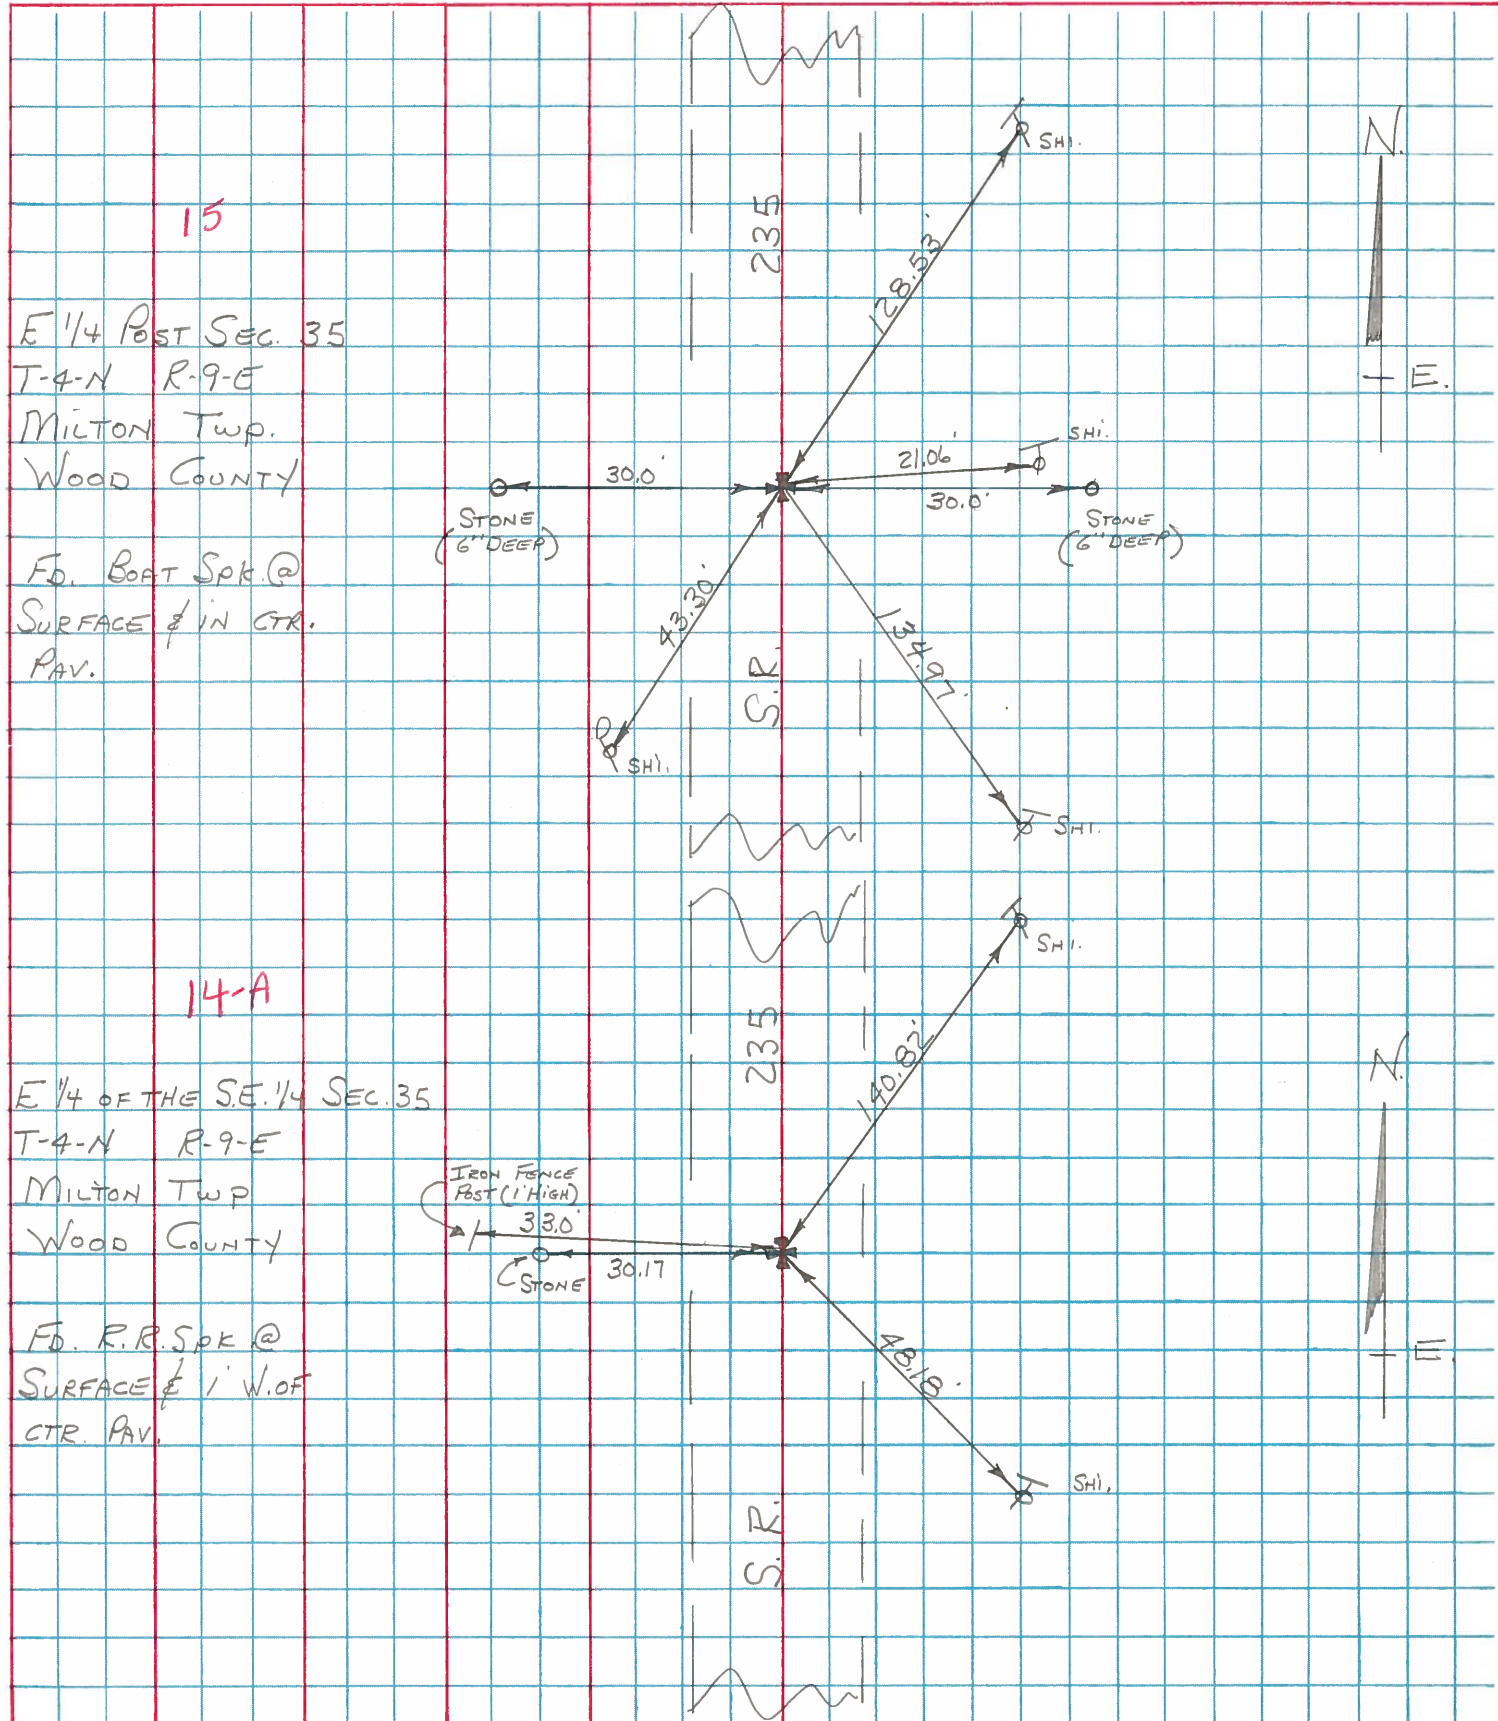

PERSONNEL TITLE PERSONNEL TITLE
SILVESTER _____

COUNTY WoodDATE 7-69S. R. # 235

WEATHER _____

SEC. _____

TEMP. _____

DESCRIPTION

LEFT

CENTER LINE

RIGHT

JOB NO. _____

#68 E 1/4 Post Sec 2 Jackson Twp Found Stone Set Pipe over Stone	#12		Cont. Mt. S.W. 39.10 Shiner in 28" Apple N.E. 66.43 ✓ " " T.Pole S.E. 60.10 " " P. " W.S.W. 36.77
#69 N.E. Cor. Sec. 2 Jackson Twp, R.R. Spk.	#13 Jerry City		Shiner in T. Pole W.S.W. 74.53 N.W. Cor. Hd. Wall S.S.W. 14.60 Sw. " " " E. of S. 32.58 Shiner in P. Pole S.W. 49.56 E. to Stone #70 33.18
#70 Sw. Cor. Sec. 36 Milton Twp Rd from Pk Jerry City Rd.	#13A	(14)	N.W. Cor. Hd. Wall W.S.W. 43.43 Shiner in P. Pole S.W. 74.76 " " T. Pole N.E. 35.17 " " G. Rail Post S.S.E. 19.90 W. to Stone or R.R. Spk. 33.18
#71 E 1/4 post of the S.E. 1/4 Sec 35 Milton Twp. Stone. Rd R.R. Spk on Top 3' below surface	#14	(14A)	Stone W. 30.17 Shiner in T. Pole S.E. 48.22 Iron fence post W. 33.00 Shiner in T. Pole N.N.E. 140.75
#72 W. 1/4 Post Sec. 36 Milton Twp. Stone Rd.	#15		Shiner in T. Pole E. 21.02 Stone E. 30.0 " W. 30.0 Shiner in P. Pole S.W. 43.30 " " W. Cherry E. 54.70