

O.D.O.T. DISTRICT 2 SURVEY OFFICE (USE ONLY)

PERSONNEL

REFERENCE NO. 15

SHEET 15 OF 26

NOTES ASTON
H.C. NIESE
R.C. PRESTON-COLVIN

DATE 8-21-24
WEATHER BREEZY
TEMP. 65°

ROUTE SR 235
COUNTY WOOD
TOWNSHIP MILTON
SECTION 35
T 4 N R 9 E

DWG BY PRESTON-COLVIN PID CHIPSEAL

TYPE MONUMENT MONBOX W/1" IPIN

ON SURFACE - ~~BELOW~~ ON

OFFSET Q PAVEMENT ON LT : RT
8.8' TO RT EDGE PAVEMENT

STATION: 345+69.12

HORIZ.DATUM: NAD83 (2011)


GEOID: 2018

GRID: NORTHING: 584092.4

EASTING: 1615098

LDP: NORTHING: 405443

EASTING: 126781.3

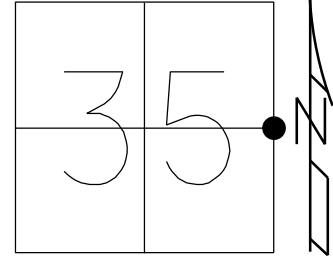

RECORD:
SET MAG & WASHER
11-3-03, DCH

GPS, REF15
8-27-15.

SET MAG/WASHER
GPS, NEWREF15
7-28-16, DCH

FD MONBOX
W/1" IPIN
REF15
8-21-24, TDN


FD MONBOX
9-18-24, TDN

FD "X" ON
COR. CBS

FD SHI
NE/S

FD BARN SPIKES
3" BELOW SURFACE


FIELD DRIVE

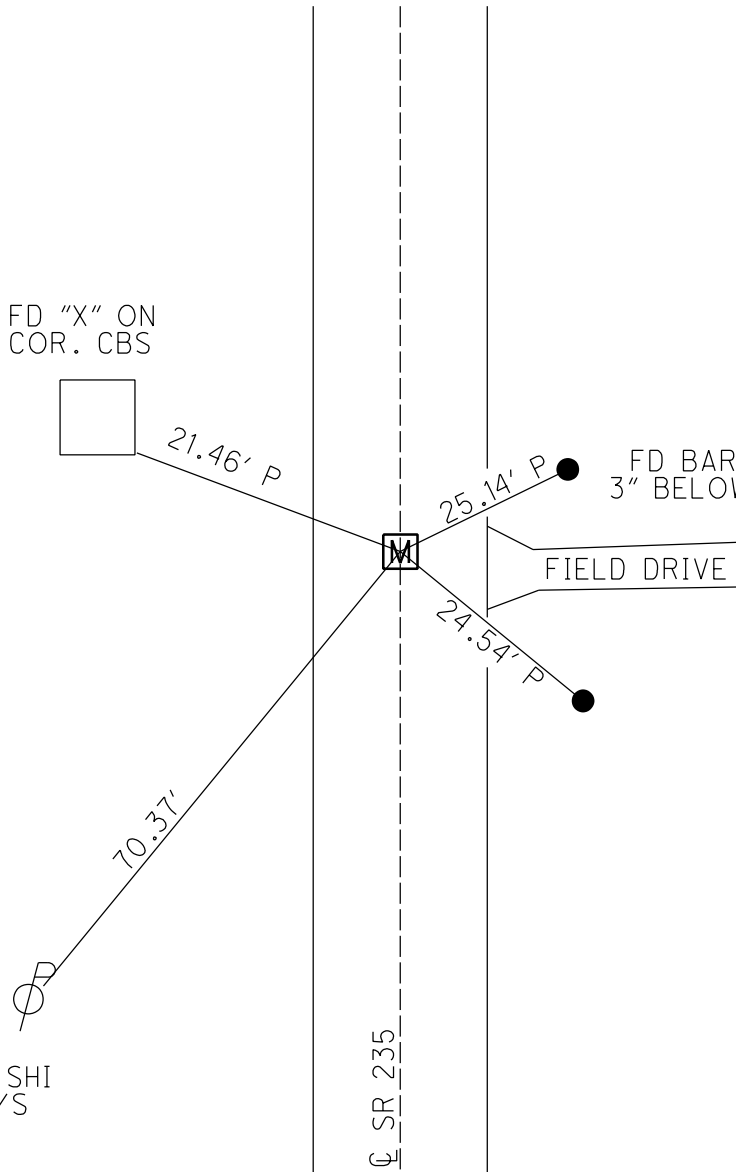

O.D.O.T. DISTRICT 2 SURVEY OFFICE (USE ONLY)

PERSONNEL	REFERENCE NO.	<u>15</u>	SHEET	<u>15</u>	OF	<u>26</u>
NOTES	<u>RHOADES</u>	DATE	<u>8-27-15</u>	ROUTE	<u>SR 235</u>	
H.C.	<u>O'DONNELL</u>	WEATHER	<u>SUNNY</u>	COUNTY	<u>WOOD</u>	
R.C.	<u>RHOADES</u>	TEMP.	<u>62°F</u>	TOWNSHIP	<u>MILTON</u>	
				SECTION	<u>35</u>	
				T	<u>4</u>	N
				R	<u>9</u>	E

TYPE MONUMENT PK/WASHER
 ON SURFACE - ~~BELOW~~ ON
 LEFT - Q PAV'T - RIGHT ON
8.8 TO RT EDGE PAVEMENT
 S.L.M. 345+69.12

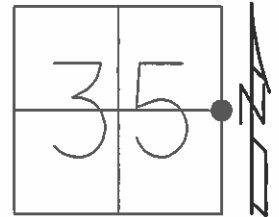


Grid: Northing: 584092.4603 Easting: 1615098.1076

RECORD:
 SET MAG & WASHER
 11-3-03, DCH

GPS, REF15
 8-27-15.

SET MAG/WASHER
 GPS, NEWREF15
 7-28-16, DCH

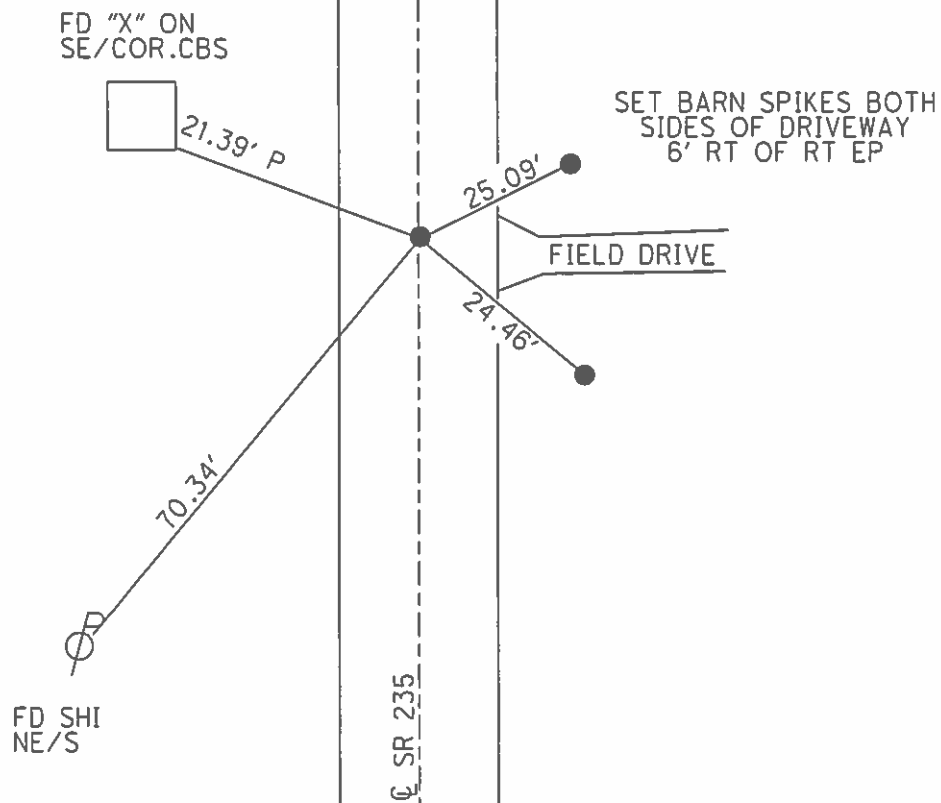

O.D.O.T. DISTRICT 2 SURVEY OFFICE

PERSONNEL

REFERENCE NO. 15

SHEET 12 OF 23

NOTES Homan

DATE 9-25-03

ROUTE 235

H.C. Nuhfer

WEATHER Sunny

COUNTY WOOD

R.C. Ballmer

TEMP. 50°

TOWNSHIP MILTON

SECTION 35

T 4 N R 9 E


TYPE MONUMENT PK & Washer

ON SURFACE - BELOW on surface

~~LEFT~~ - CL PAV'T - ~~RIGHT~~ CL

8.8 TO RT EDGE PAVEMENT

S.L.M. 344+58

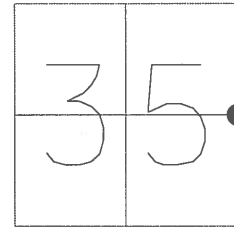

Set Mag & Washer
11-3-03
DCH

Reset "X"
on SE corner
5-22-03
John



21.35'

"X" on CB

70.40'

FD SHI
NE/S

CL PAVEMENT
CL
S.R. 235

O.D.O.T. DISTRICT 2 SURVEY OFFICE

PERSONNEL

REFERENCE NO. 15

SHEET 11 OF 28

NOTES BOB VANDUSEN

H.C. KEVIN MOSER

R.C. BRAO STIFFLER

DATE 7-17-95

WEATHER Sunny

TEMP. +80°F

ROUTE 235

COUNTY WOOD

TOWNSHIP MILTON

SECTION 35

T 4 N R 9 E



TYPE MONUMENT Sm. R.R. SPIKE

ON SURFACE - BELOW SURFACE

~~LEFT~~ & PAV'T. - RIGHT CL

8.8 TO RT EDGE PAVEMENT

S.L.M. 344+58

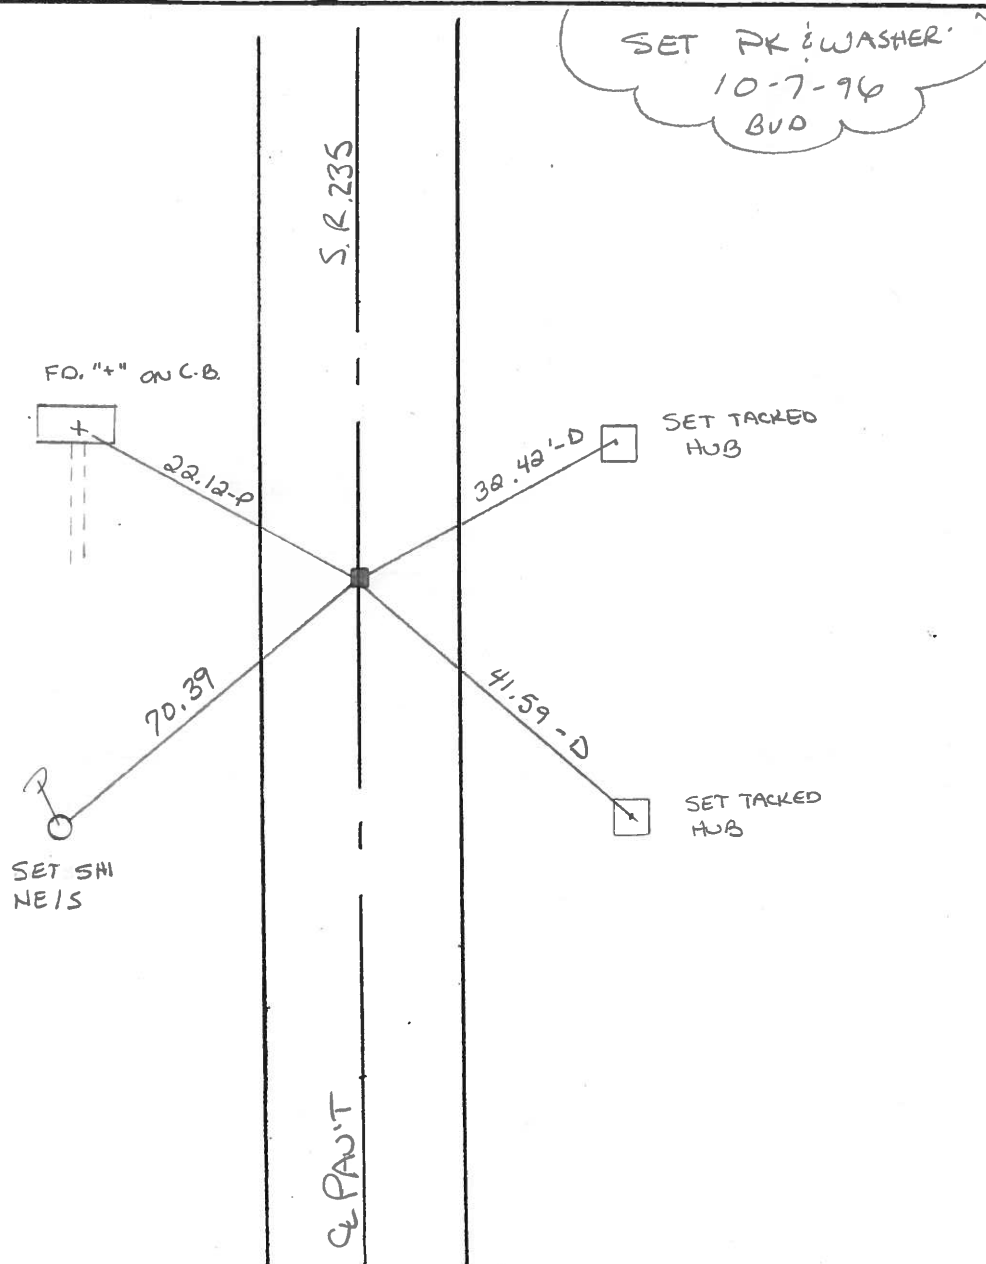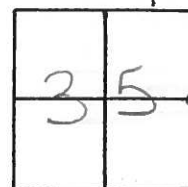

O.D.O.T. DISTRICT 2 SURVEY OFFICE

PERSONNEL

REFERENCE NO. 15

SHEET OF

NOTES BARNHISGL

H.C. Loehrke

R.C. HOFFMAN

DATE 6-3-86

WEATHER SUNNY

TEMP. +65°

ROUTE 235

COUNTY WOOD

TOWNSHIP MILTON

SECTION 35

T 4 N R 9 E

TYPE MONUMENT 5m RR Spk



ON SURFACE - ~~BELOW~~ yes

LEFT - ~~Q~~ PAV'T. - ~~RIGHT~~ yes

8.4 TO LT EDGE PAVEMENT

S.L.M. 344+60

Set 5m RR Spk
6-26-86
MJB

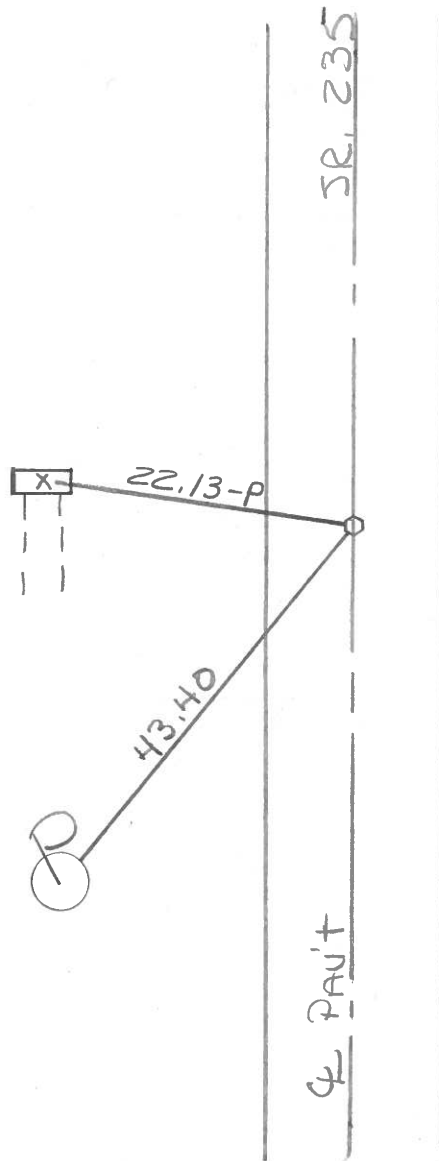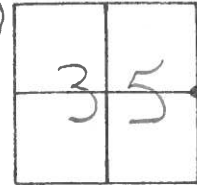

PERSONNEL TITLE PERSONNEL TITLE

BURNSIDE

COUNTY WOOD

DATE 12-24-75

SMITH

S. R. 235

WEATHER CLEAR

BOWERS

SEC. 35

TEMP. +18°

MEAD


DESCRIPTION ± CONTROL TIES

JOB NO.

LEFT

CENTER LINE

RIGHT

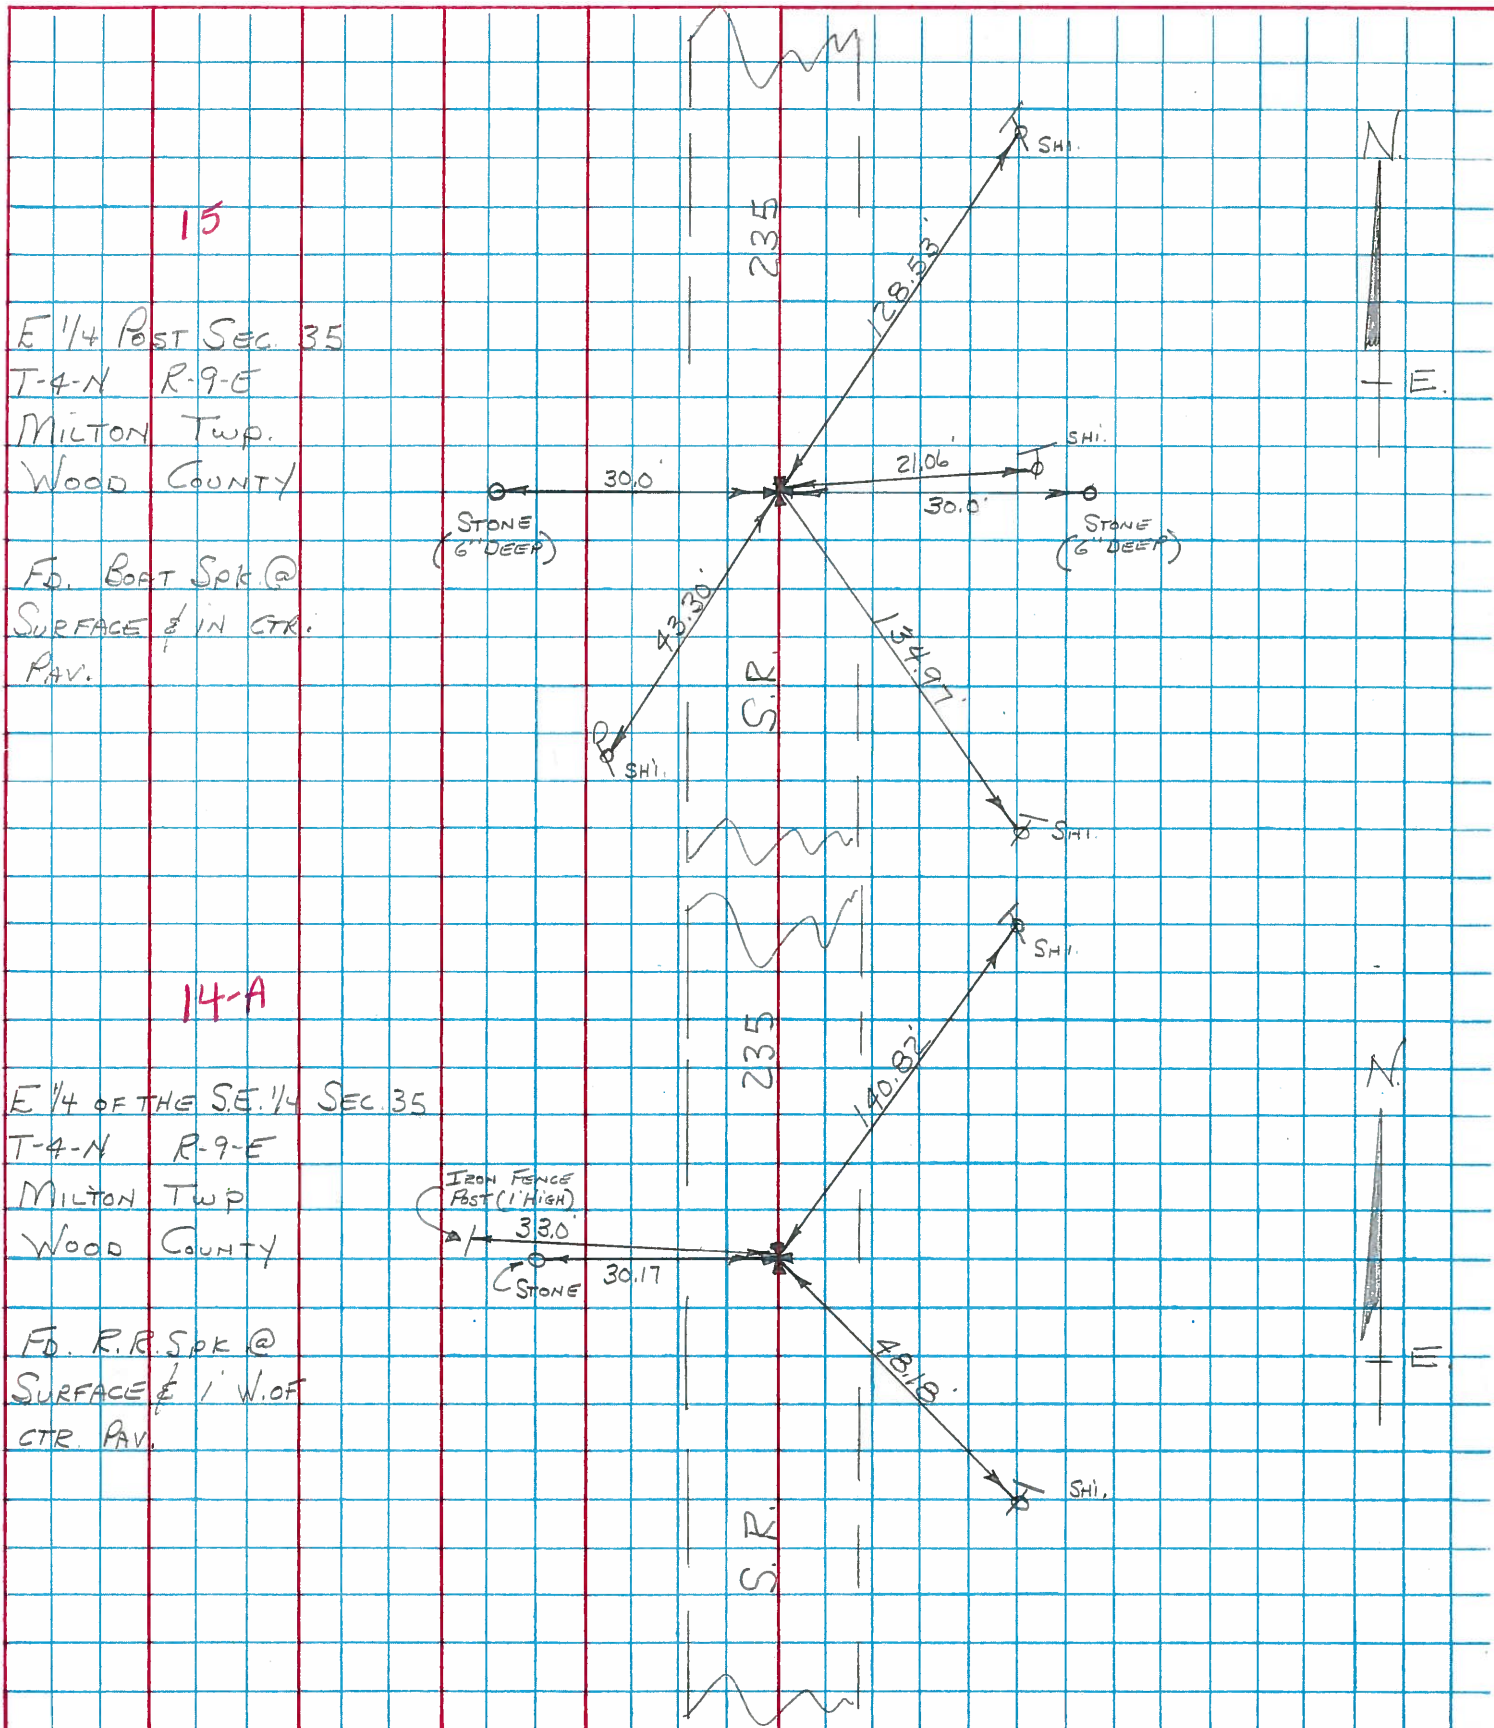

PERSONNEL TITLE PERSONNEL TITLE

SILVESTER

COUNTY WoodDATE 7-69S. R. # 235

WEATHER

SEC.

TEMP.

DESCRIPTION

LEFT

CENTER LINE

RIGHT

JOB NO.

#68 E 1/4 Post Sec 2 Jackson Twp Found Stone Set Pipe over Stone	#12	#69 Jerry City N.E. Cor. Sec. 2 Jackson Twp. R.R. Spk.	#13	#70 SW. Cor. Sec 36 Milton Twp Rd Iron Pin Jerry City Rd.	#13A (14)	#71 E 1/4 post of the SE. 1/4 Sec 35 Milton Twp. Stone. Rd R.R. Spk on Top 3' below surface	#14 (14A)	#72 W. 1/4 Post Sec. 36 Milton Twp. Stone Rd.	#15 Shiner in T. Pole S.W. 39.10 Shiner in 28" Apple N.E. 66.43 ✓ " " T. Pole S.E. 60.10 " " P. " W.S.W. 36.77 Shiner in T. Pole W.S.W. 74.53 N.W. Cor. Hd. wall S.S.W. 14.69 Shiner " " " E. of S. 32.58 Shiner in P. Pole S.W. 49.56 E. to Stone #70 33.18 N.W. Cor. Hd. wall W.S.W. 43.43 Shiner in P. Pole S.W. 74.76 " " T. Pole N.E. 35.17 " " S. Rail Post S.S.E. 19.90 W. to Stone or R.R. Spk. 33.18 Stone W. 30.17 Shiner in T. Pole S.E. 48.22 Iron fence post W. 33.00 Shiner in T. Pole N.N.E. 140.75 Shiner in T. Pole E. 21.02 Stone E. 30.0 " W. 30.0 Shiner in P. Pole S.W. 43.30 " " W. Cherry E. 54.70
---	------------	---	------------	--	-------------------------	--	-------------------------	---	---

PERSONNEL	TITLE	PERSONNEL	TITLE	COUNTY	DATE	WEATHER	TEMP.
				Wood	12-13-57	4-14-60	
				S. R. #69		1-13-66	
				SEC.			

DESCRIPTION	LEFT	CENTER LINE	RIGHT	JOB NO.
-------------	------	-------------	-------	---------

W. 1/4 post sec. 36 Milton Twp. Stone Did not find ✓ #72 15	SET SMALL SPK. 7-28-69	SHI. T. POLE E 21.02 Stone E. 30.0 Stone W. 30.0 SHI. P. POLE S.W. 43.30 SHI. WILD CHERRY E 54.70 ✓ Shi. in T. Pole S.E. 46.37 ✓ Ditch marker leaning S.E. 42.75 ✓ S.E. cor. E. abut. S.E. 40.50 ✓ W. cor. W. abut. S.W. 28.35 ✓ Shiner in P.P. N.W. 34.80 Iron pipe stake N.E. Gone ✓ Shi. P.P. N.N.W. 78.5 SHI. P. POLE N.N.E. 103.92		
N.W. cor. sec. 36 Milton Twp. Stone 10' below surface of pavement. Set R.R. spike Boys Rd. #73 16	SET R.R. SPK. 7-28-69	Fence Post E. 20.05 Anchor post E. 20.25 Busbar post W. S.W. Gone ✓ T. Pole S.W. 46.20 ✓ Conc. mon. N.E. 23.63 ✓ Conc. mon. Spt E. 13.66 ✓ Shi. P. Pole S.S.E. 109.30		
W. 1/4 post sec. 25. E.R. optional line N.W. 1/4 S.W. cor. posts 10' W. of E. edge of post. Fd. Iron pipe on E. edge of post. Fd. R.R. Spk. 5" below surface 1' W. of E. edge of post. #74 17	SET R.R. SPK. 7-28-69			
S.E. cor. sec. 23 Milton Twp. Stone S.R. #281 ✓ R.R. Spk. #75 18	TIES OK 7-28-69	✓ N.E. to shiner in P.P. 44.65 ✓ W.N.W. to shiner in P.P. 121.54 ✓ S.W. to shiner in T.P. 59.10 ✓ S.S.W. to shiner in T.P. 64.41 ✓ S.E. to shiner in T.P. 67.75		
W. 1/4 of S.W. 1/4 sec. 24 Fd. stone in W. bank of Deb. Fd. Stone ✓ #75-A 18-A		High Point ✓ Shiner in P.P. E. 33.80 ✓ Shiner in T.P. W. 55.25		

PERSONNEL	TITLE	PERSONNEL	TITLE

COUNTY WoodDATE Oct 12-19-57S. R. #69WEATHER 4-14-60

SEC. _____

TEMP. _____

DESCRIPTION

LEFT

CENTER LINE

RIGHT

JOB NO. _____

W. 1/4 post sec. 36 Milton
Twp. Stone

Did not find ✓ Found

#72

15

N.W. Cor. sec. 36 Milton
Twp. Stone 1.0' below
surface of pavement.
Set R.R. spike Boys Rd.

#73

16

W. 1/4 post sec. 25.
E.R. opt. on a line N.W. &
S.W. Cor. posts 10' W. of E.
edge of post. Fd. iron pipe
on E. edge of post.

Fd. R.R. Spk. 5" Below Surface 1' W. of E.
Edge post

#74

17

S.E. Cor. sec. 23 Milton
Twp. Stone. S.E. #281
✓ R.R. Spk.

#75

18

W. 1/4 of S.W. 1/4 sec. 24
Fd. stone in W. bank of Dch.
Fd. Stone ✓

#75-A

18-A

Shiner T Pole E

21.02

✓ Stone E.

30.0

✓ Stone W.

30.0

Shiner P Pole S.W.

43.30

Shiner w chemp E.

54.70

✓ Shi. in T. Pole

S.E.

44.37

✓ Ditch marker leaning

S.E. 42.75 42.75

✓ S.E. Cor. E. about,

S.E. 40.60 40.45

✓ W. Cor. W. about,

S.W. 20.40 21.20

✓ Shiner in P.P.

N.W. 34.50 35.40

Iron sign stake

N.E. 60.00 32.20

✓ Shi. P.P.

N.N.W.

78.5

" N.N.E.

103.32

~~Force Post~~~~E.~~~~20.05~~~~Anchor post~~~~E.~~~~30.55~~~~Busher post~~~~W. Sect.~~~~Gone 46.78~~

✓ T. Pole

S.W.

46.20

✓ Conc. mon.

N.E. 23.63

23.73

✓ Conc. mon. Set E.

15.66 48.73

✓ Shi. P. Pole

S.S.E.

109.30

✓ Shi. P. Pole

S.S.E.

109.30

✓ N.E. to shiner in P.P.

44.63

✓ W.N.W. to shiner in P.P.

121.54

✓ S.W. to shiner in T.P.

59.70 59.65

✓ S.S.W. to shiner in T.P.

64.41

✓ S.E. to shiner in T.P.

67.75

High
Point

✓ Shiner in P.P. E.

33.80 34.0

✓ Shiner in T.P. W.

35.85 36.0

PERSONNEL	TITLE	PERSONNEL	TITLE

COUNTY Wood DATE OK 12-13-57
4-14-60
 S. R. #69 WEATHER 1-18-66
 SEC. _____ TEMP. _____

DESCRIPTION	LEFT	CENTER LINE	RIGHT	JOB NO.
-------------	------	-------------	-------	---------

W. 1/4 post sec. 36 Milton
 Twp. Stone
 Did not find ✓

#72 15

N.W. Cor. sec. 36 Milton
 Twp. Stone 10' below
 surface of pavement.
 Set R.R. spike Bays Rd.

#73 16

Stone E. 30.0'
 Stone W. 30.0'

✓ Shi. in T. Pole S.E. 46.37

✓ Ditch marker leaning S.E. 42.75' 42.95'

✓ S.E. Cor. E. abut. S.E. 40.50 40.45'

✓ W. Cor. W. abut. S.W. 28.35 29.30'

✓ Shiner in P.P. N.W. 34.80' 36.16'

~~Iron sign stake N.E. Gone 32.80'~~

✓ Shi. P.P. N.N.W. 78.59'

W. 1/4 post sec. 25.
 E.R. spk. on a line N.W. &
 S.W. Cor. posts 10' W. of E.
 edge of part. Fd. Iron pipe
 on E. edge of part.

Fd. R.R. Spk. 5" Below Surface 1' W. of E.
 edge part.

#74 17

~~Fence Post E. 20.05'~~

~~Anchor post E. 20.05'~~

~~Anchor post W.S.W. Gone 36.78'~~

✓ T. Pole S.W. 46.20'

✓ Conc. man. N.E. 23.63 23.73'

✓ Conc. man. Spt E. 18.66 18.78'

✓ Shi. P. Pole S.S.E. 109.30'

S.E. Cor. sec. 23 Milton
 Twp. Stone S.R. #281
 ✓ R.R. spk.

#75 18

✓ N.E. to shiner in P.P. 44.65'

✓ W.N.W. to shiner in P.P. 121.54'

✓ S.W. to shiner in T.P. 59.65'

✓ S.S.W. to shiner in T.P. 64.41'

✓ S.E. to shiner in T.P. 67.75'

W. 1/4 of S.W. 1/4 sec. 24
 Fd. stone in W. bank of Dch.
 Fd. Stone ✓

#75-A 18-A

✓ Shiner in P.P. E. 33.80' 34.0'

✓ Shiner in T.P. W. 35.85' 36.0'