

O.D.O.T. DISTRICT 2 SURVEY OFFICE (USE ONLY)

PERSONNEL

REFERENCE NO. 16

SHEET 16 OF 26

NOTES ASTON
H.C. NIESE
R.C. PRESTON-COLVIN

DATE 8-21-24
WEATHER BREEZY
TEMP. 70°

ROUTE SR 235
COUNTY WOOD
TOWNSHIP MILTON
SECTION 35
T 4 N R 9 E

DWG BY PRESTON-COLVIN PID CHIPSEAL

TYPE MONUMENT MAG/WASHER

ON SURFACE - ~~BELOW~~ ON

OFFSET Q PAVEMENT 3' LT : RT

8.1' TO RT EDGE PAVEMENT

STATION: 372+43.52

HORIZ.DATUM: NAD83 (2011)


GEOID: 2018

GRID: NORTHING: 586766.8


EASTING: 1615086

LDP: NORTHING: 408117.3

EASTING: 126734.2

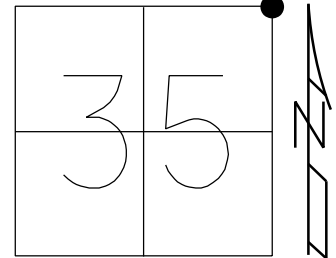

RECORD:
SET MAG/WASHER
10-10-03, DCH
FD MAG/SHANK
REF19
10-23-14
REF16
8-26-15
SET MAG/WASHER
NEWREF16
7-28-16, DCH
FD MAG/WASHER
REF16
4-29-22, DSA
FD MAG/WASHER
REF16
8-21-24, TDN
FD MAG/WASHER
9-18-21, TDN

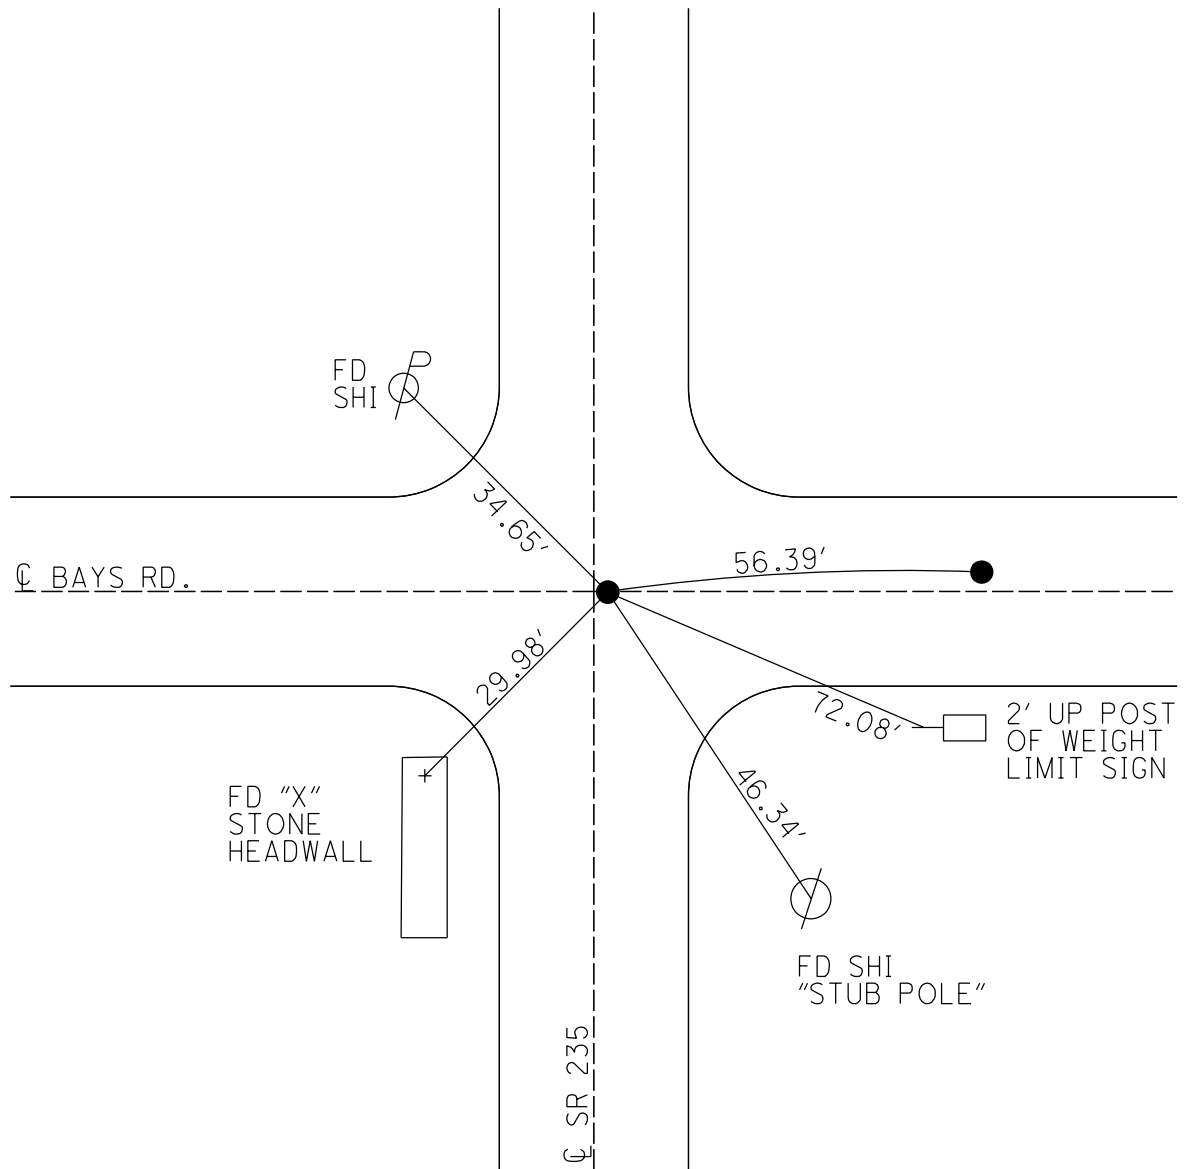

O.D.O.T. DISTRICT 2 SURVEY OFFICE (USE ONLY)

PERSONNEL

REFERENCE NO. 16

SHEET 16 OF 26

NOTES RHOADES

DATE 8-27-15

ROUTE SR 235

H.C. O'DONNELL

WEATHER SUNNY

COUNTY WOOD

R.C. RHOADES

TEMP. 52°F

TOWNSHIP MILTON

SECTION 35

DWG BY WHITAKER PID R/W STAKE

T 4 N R 9 E

TYPE MONUMENT P.K./WASHER

ON SURFACE - ~~BELOW~~ ON

OFFSET Q PAVEMENT 0.5' ~~LT~~ : RT

8.1' TO RT EDGE PAVEMENT


STATION: 372+43.52

HORIZ.DATUM: NAD83 2011


GEOID: NAVD88 2018

GRID: NORTHING: 586766.851

EASTING: 1615086.323

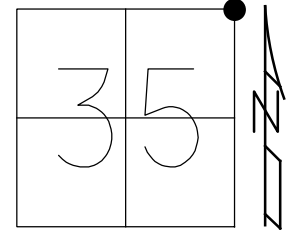

RECORD:
SET MAG/WASHER
10-10-03, DCH
FD MAG/SHANK
REF19
10-23-14
REF16
8-26-15
SET MAG/WASHER
NEWREF16
7-28-16, DCH
FD MAG/WASHER
REF16
4-29-22, DSA

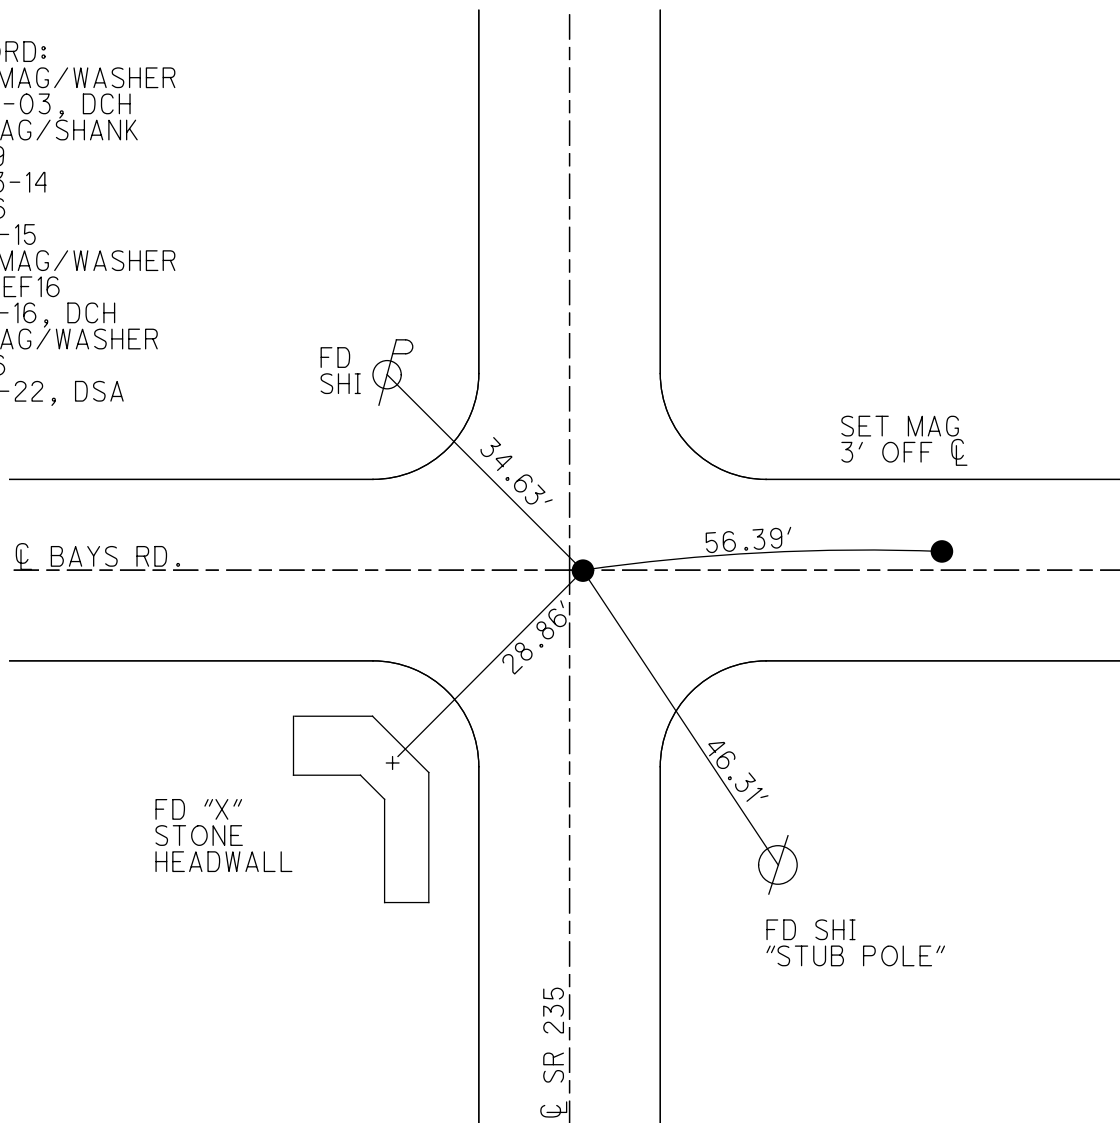

O.D.O.T. DISTRICT 2 SURVEY OFFICE (USE ONLY)

PERSONNEL

REFERENCE NO.

16

SHEET

16

OF 26

NOTES RHOADES

DATE

8-27-15

ROUTE SR 235

H.C. O'DONNELL

WEATHER

SUNNY

COUNTY WOOD

R.C. RHOADES

TEMP.

62°F

TOWNSHIP MILTON

SECTION 35

T 4 N R 9 E

TYPE MONUMENT PK/WASHER

ON SURFACE - ~~BELOW~~ ON

~~LEFT~~ - CL PAV'T - RIGHT 0.5'

8.1' TO RT EDGE PAVEMENT

S.L.M. 372+43.52

Grid: Northing: 586766.7989 Easting: 1615086.3623




RECORD:
SET MAG & WASHER
10-10-03, DCH

FD MAG/SHANK
GPS, REF19
10-23-14

GPS, REF16
8-26-15

SET MAG/WASHER
GPS, NEWREF16
7-28-16, DCH

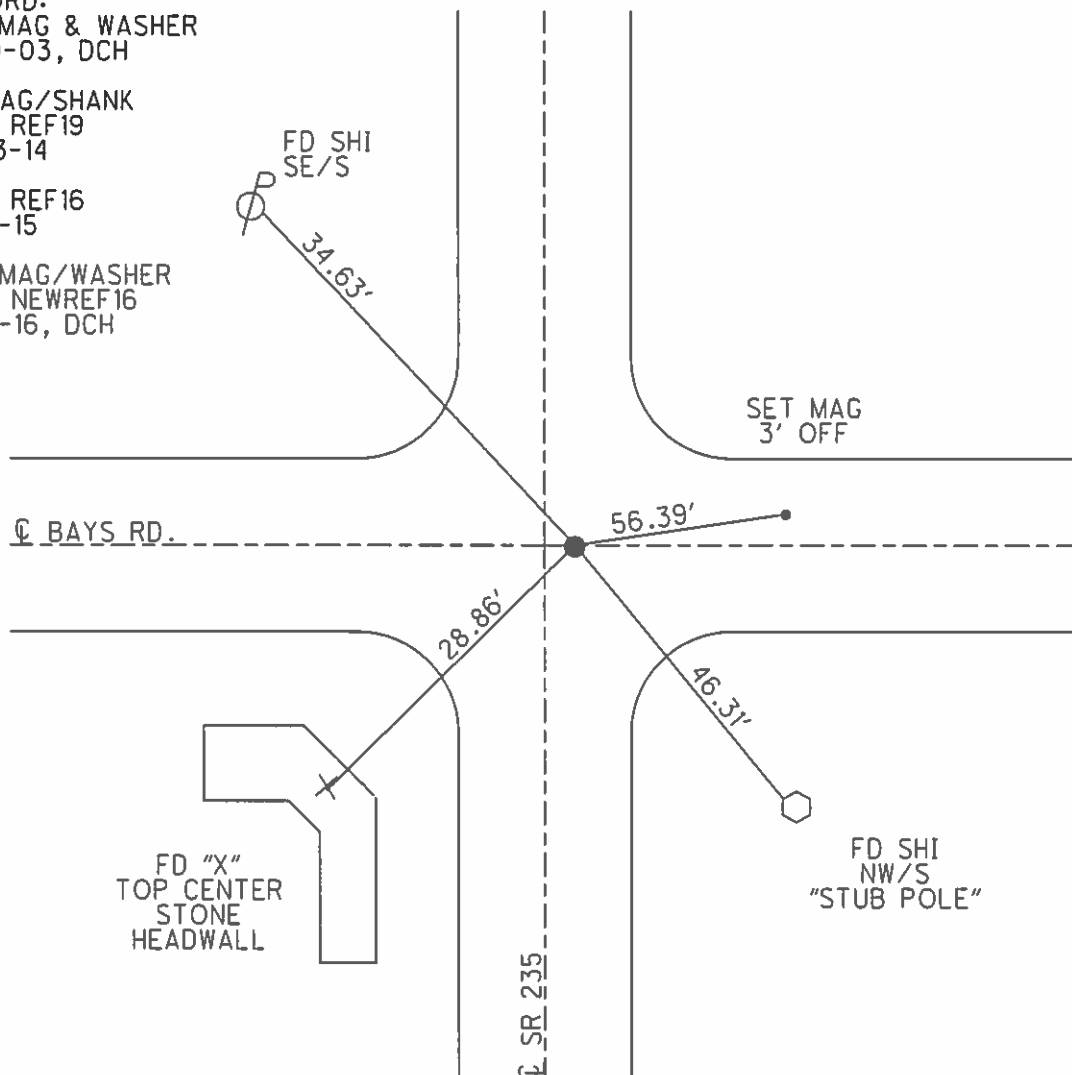

O.D.O.T. DISTRICT 2 SURVEY OFFICE

PERSONNEL

REFERENCE NO. 16

SHEET 13 OF 23

NOTES Homan

DATE 9-24-03

ROUTE 235

H.C. Nuhfer

WEATHER SUNNY

COUNTY WOOD

R.C. Ballmer

TEMP. 60°

TOWNSHIP MILTON

SECTION 35

T 4 N R 9 E


TYPE MONUMENT PK & Washer

ON SURFACE - BELOW on surface


~~LEFT - C PAVT~~ - RIGHT 0.5'

8.1 TO RT EDGE PAVEMENT

S.L.M. 371+35 on C Bays Rd

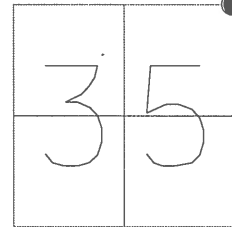

Set Mag & Washer
10-10-03
DCH

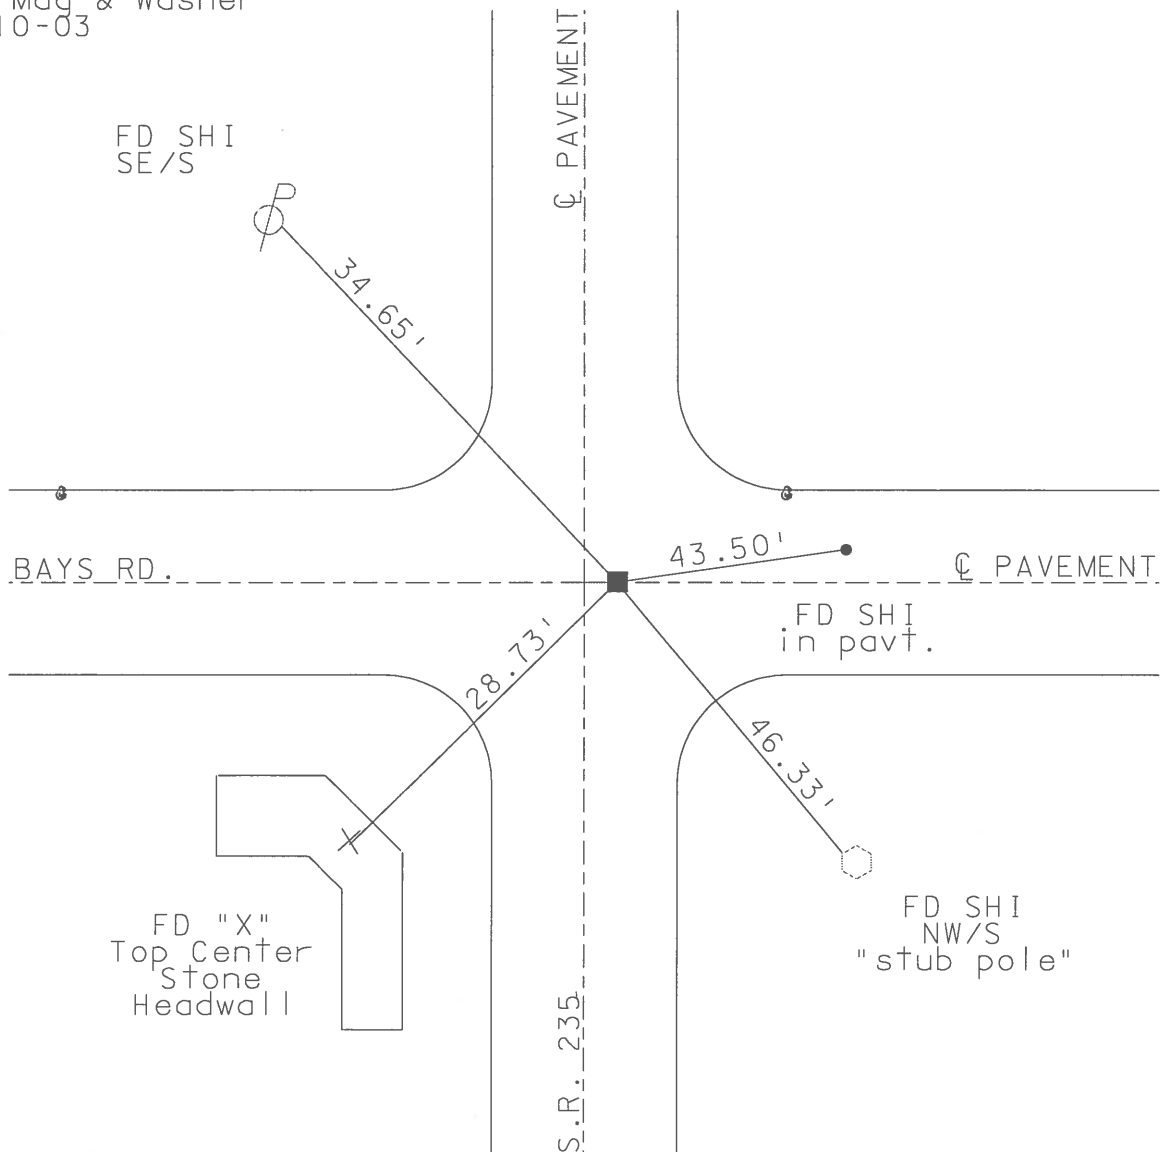

O.D.O.T. DISTRICT 2 SURVEY OFFICE

PERSONNEL

REFERENCE NO. 16

SHEET 12 OF 28

NOTES STEVE HUSS

H.C. KEVIN MOSER

R.C. STEVE HUSS

DATE 5-21-96

WEATHER Sunny

TEMP. +76°F

ROUTE S.R. 235

COUNTY WOOD

TOWNSHIP MILTON

SECTION 35

T4 N R 9 E


TYPE MONUMENT Sm. R.R. SPIKE

ON SURFACE - ~~BELOW~~ SURFACE


~~LEFT - & PAV'T.~~ - RIGHT 1'

B.I. TO RT EDGE PAVEMENT

S.L.M. 371+35 ON & BAYS Rd.

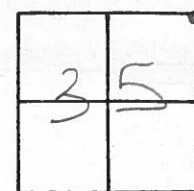

SET PK & WASHER
10-7-96
BVO

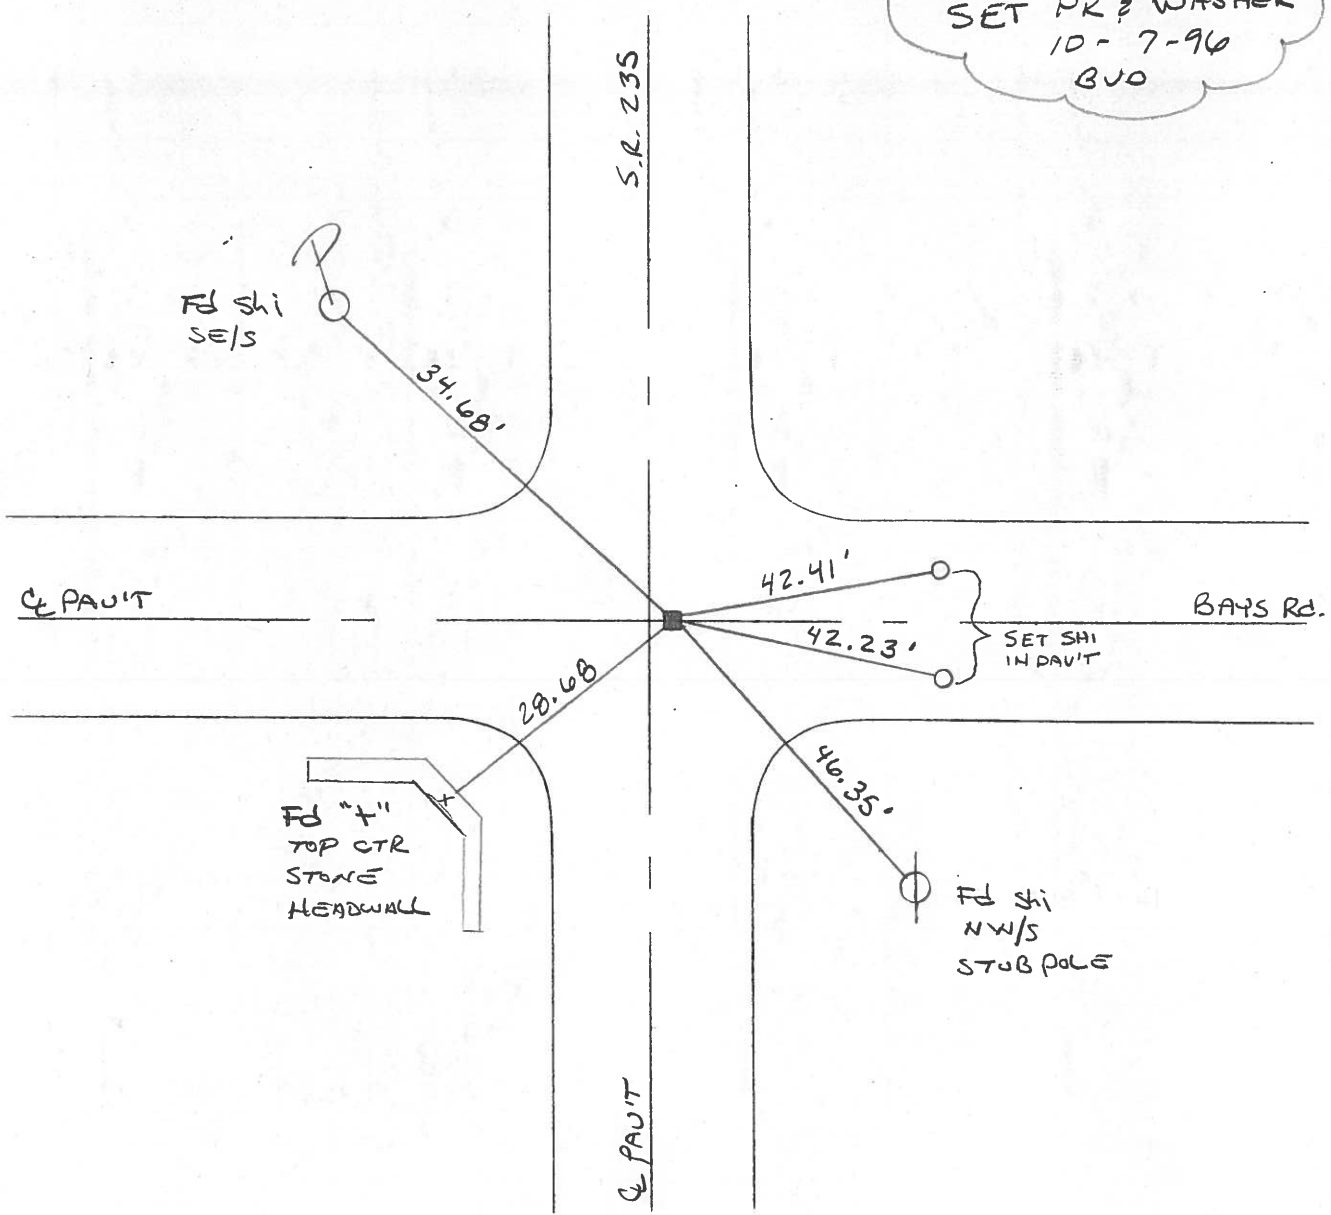

O.D.O.T. DISTRICT 2 SURVEY OFFICE

PERSONNEL

REFERENCE NO. 16

SHEET OF

NOTES BARNHISEL

H.C. Loehrke

R.C. HOFFMAN

DATE 6-3-86

WEATHER SUNNY

TEMP. +65°

ROUTE 235

COUNTY WOOD

TOWNSHIP MILTON

SECTION 35

T4 N R 9 E

TYPE MONUMENT Sm RR Spk

ON SURFACE - BELOW yes



LEFT - & PAV'T. - RIGHT .5'

- TO - EDGE PAVEMENT

S.L.M. 371 + 39

ON & BAYS Rd

Set Sm RR Spk
6-26-86
MAB

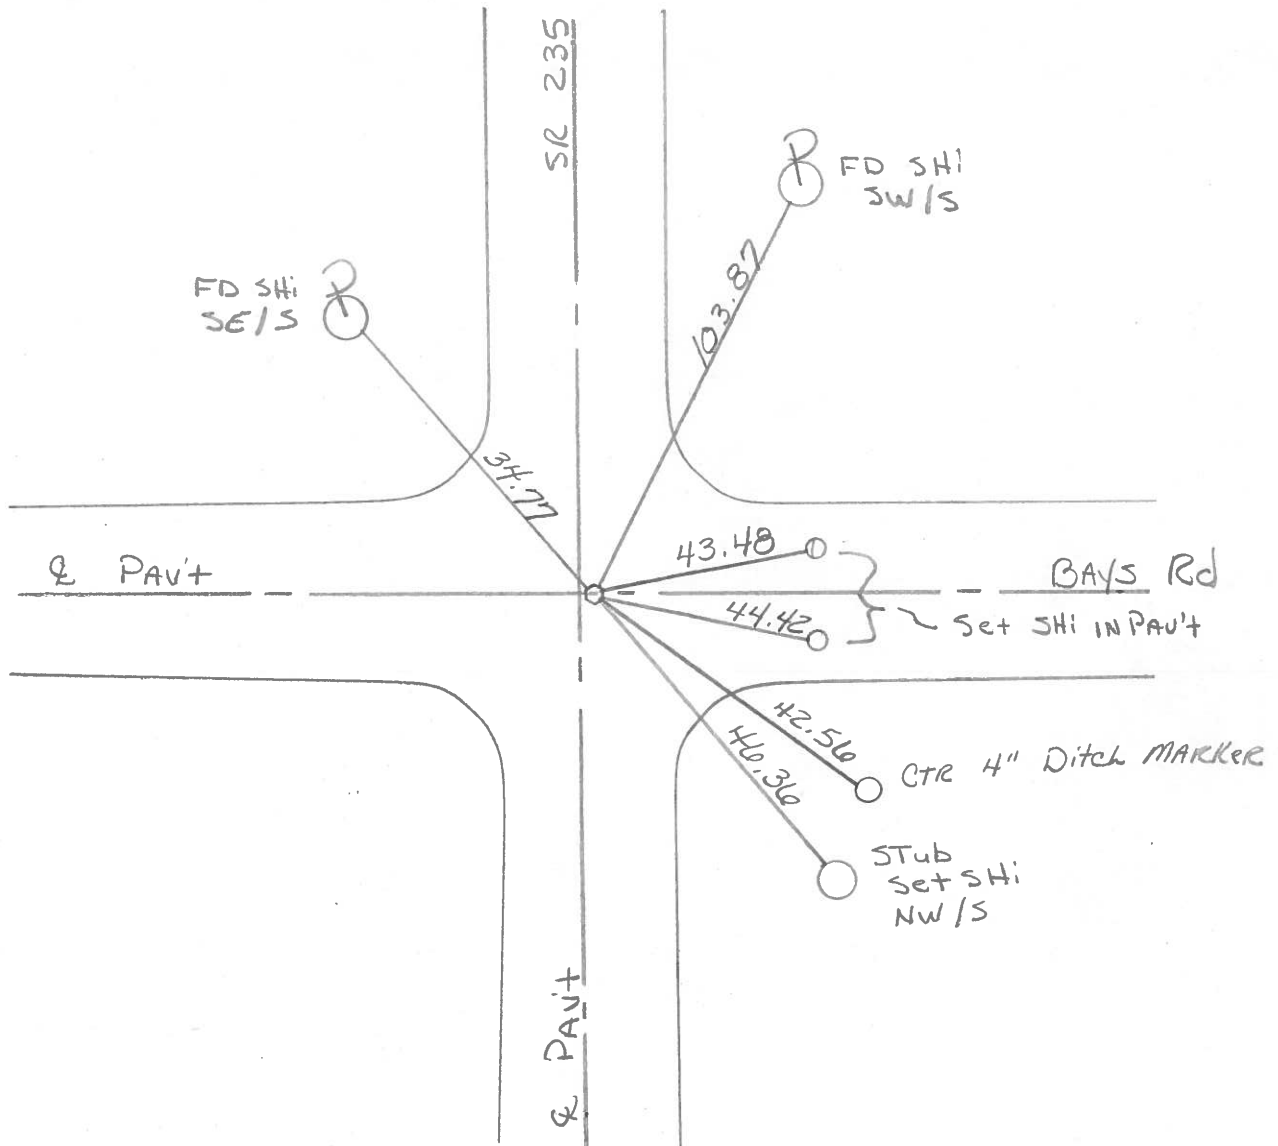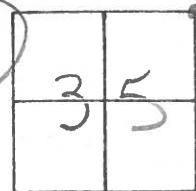


PERSONNEL	TITLE	PERSONNEL	TITLE
BURNSIDE			
SMITH			
BOWERS			
MEAD			

COUNTY Wood DATE 1-5-76

S. R. 235 WEATHER CLEAR

SEC. N.E. COR. SEC. 35 BAYS RD. TEMP. +16°

DESCRIPTION CONTROL TIES LEFT CENTER LINE RIGHT JOB NO.

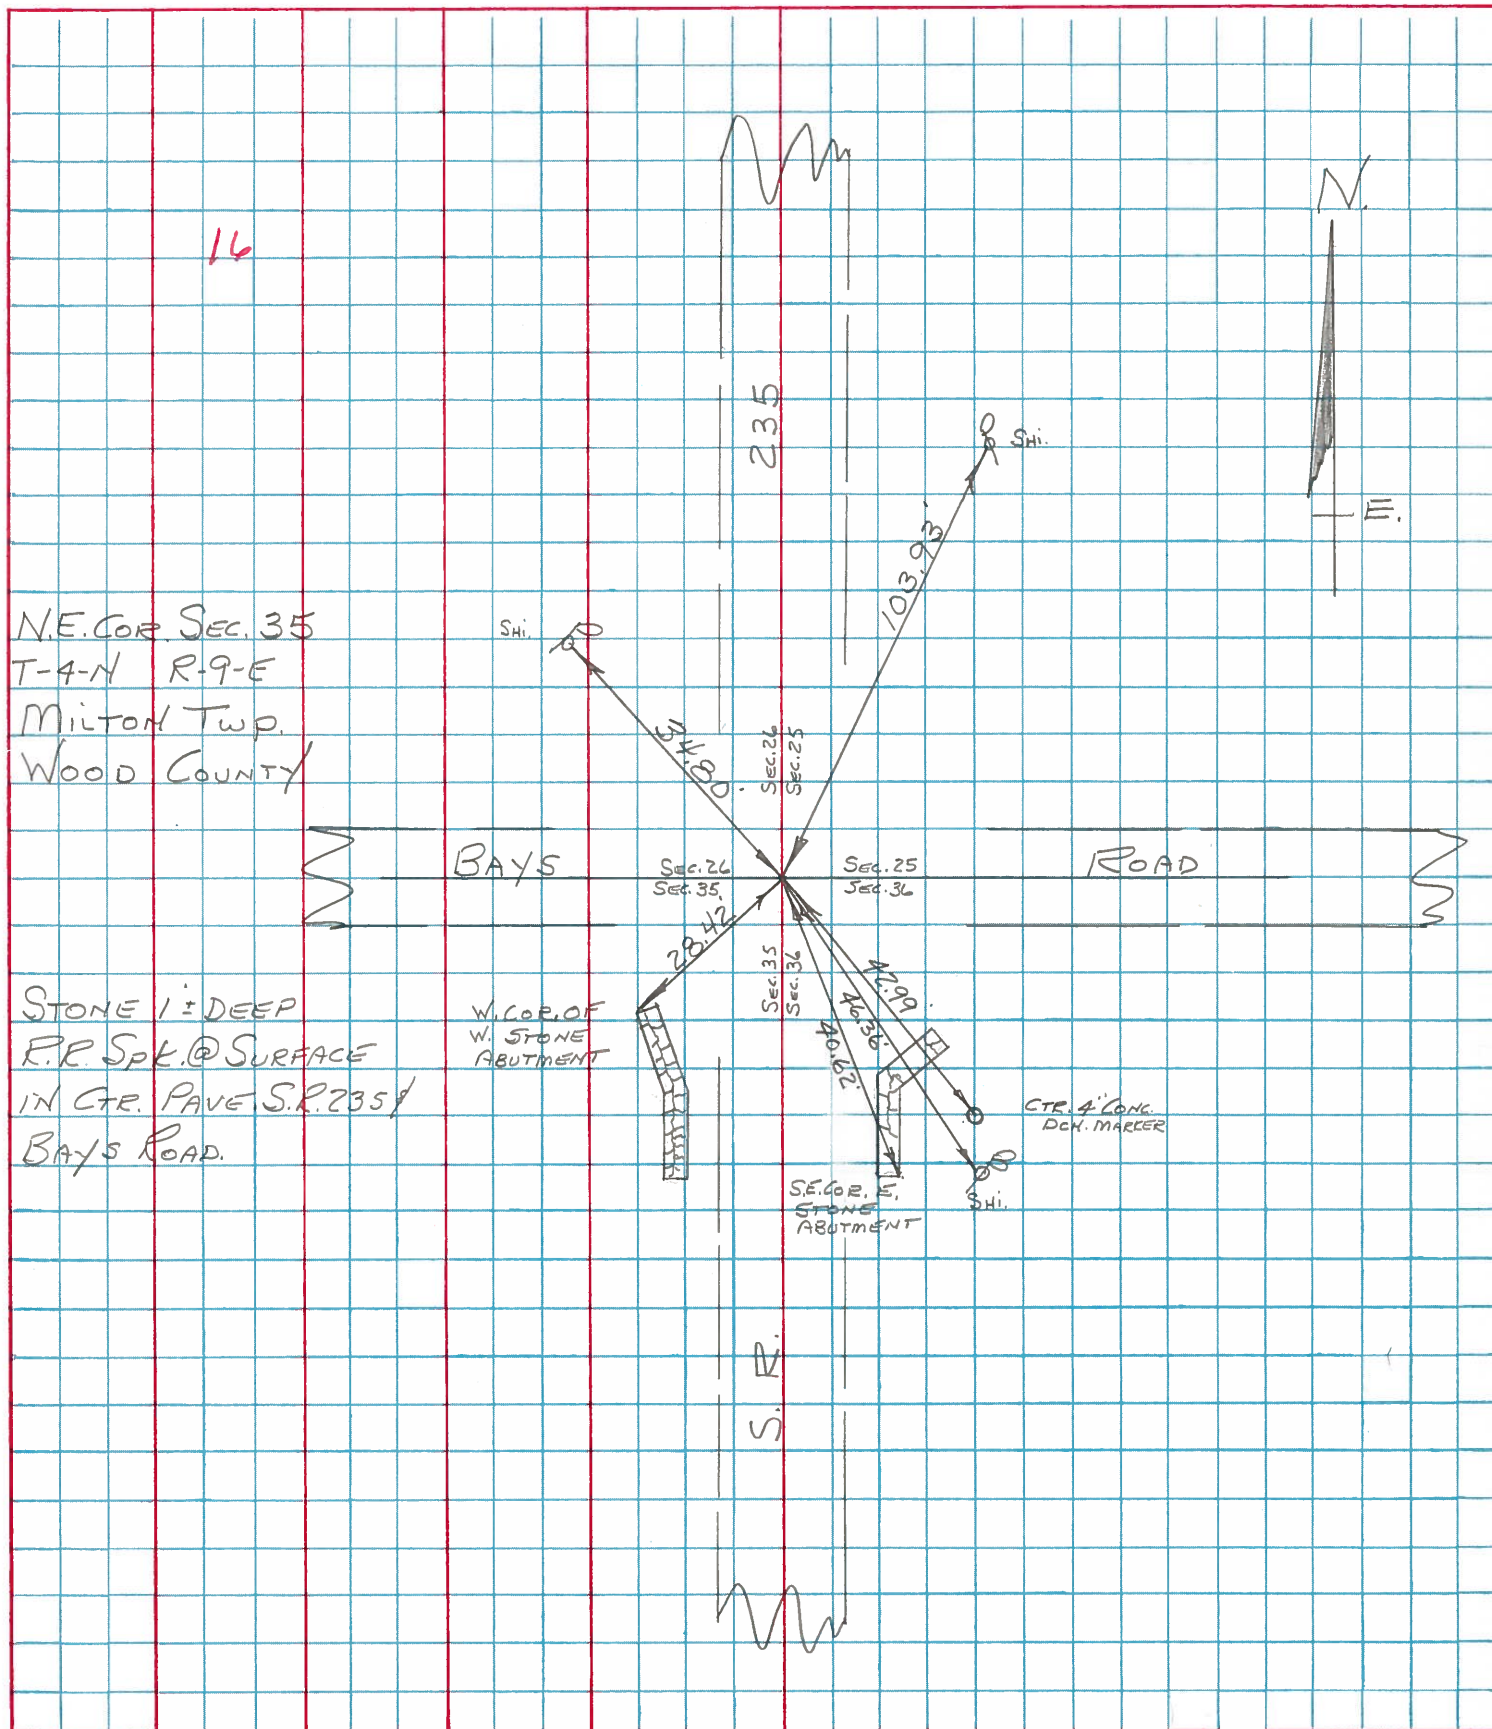

PERSONNEL TITLE PERSONNEL TITLE

SILVESTER

COUNTY Wood

DATE 7-69

S. R. #235

WEATHER

SEC.

TEMP.

DESCRIPTION

LEFT

CENTER LINE

RIGHT

JOB NO.

#73

#16

N.W. Cor. Sec 36 Milton Twp Stone 1' below Surface
Set R.R. SpK. Bays Rd.

Shiner in T. Pole S.E. 46.37
Ditch Marked (Leaning) S.E. 42.75
S.E. Cor. E. Abut. S.E. 40.60
W. Cor. W " S.W. 28.40
Shiner in P. Pole N.W. 34.80
" " " " N.N.W. 78.59
" " " " N.N.E. 103.92

#74

#17

W. 1/4 Post Sec 25 Milton Twp.
R.R. SpK on a line N.W. & S.W. Cor. Posts 10' W. of E.
edge of Pavmt. found Iron Pipe on E. Edge of Pavmt.
F/R.R. SpK. 5" below Surface 1' W. of E. Edge Pavmt.

T. Pole S.W. 46.20
Conc. Mon N.E. 23.63
" " S. of E. 18.66
Shiner in P. Pole S.S.E. 109.30

#18

#75

S.E. Cor Sec. 23 Milton Twp. Stone
R.R. SpK. S.P. 281.

N.E. to Shiner in P. Pole 44.65
S.W. " " " T. " 59.70
S.S.W. " " " " 64.41
S.E. " " " " 67.75

PERSONNEL

TITLE

PERSONNEL

TITLE

COUNTY Wood.DATE March, 26, 1968S. R. #69WEATHER Cloudy, Showers

SEC.

TEMP. + 40°

DESCRIPTION

Ties to Control Points.

JOB NO.

LEFT


CENTER LINE

RIGHT

Iron pin
SW. cor., Sec., #36
Milton Twp.
T.4N - R.9E.

14

RR. Spt. NE. Cor Sec #2
Jackson Twp.

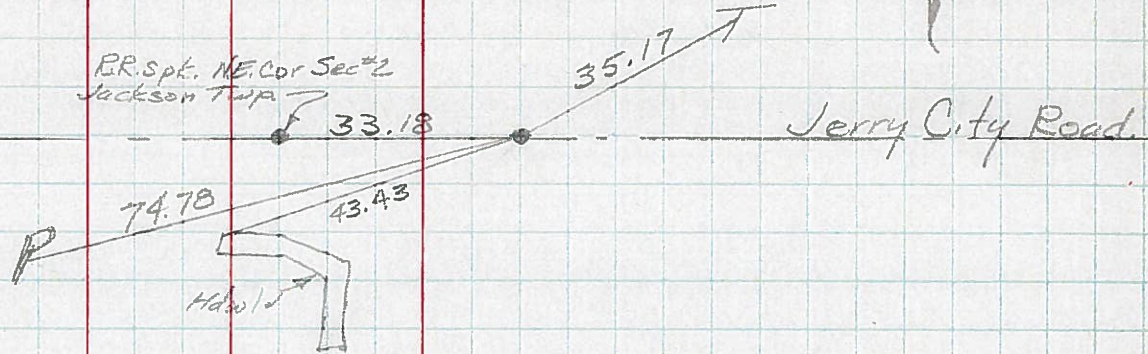

E/4 of S.E. 1/4
80 Rods N. of SW. 1/4
Sec. #36 Milton Twp.
T.4N - R.9E

Iron fence
Post

33.08

48.22

Shiner

W 1/4 of Sec. #36
Milton Twp.
T.4N - R.9E.

Stone 30' West

43.30

21.02

Shiner


Stone 30' East

54.70

18" Wild Cherry

Shiner

N.W. Cor Sec. #36
Milton Twp.
T.4N - R.9E.

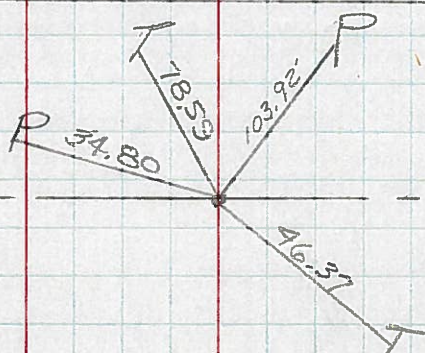

Bays Road

16

PERSONNEL	TITLE	PERSONNEL	TITLE	COUNTY	DATE
				Wood	12-13-57
				S. R. #69	4-14-60
					WEATHER 1-13-66
				SEC.	TEMP.

DESCRIPTION	LEFT	CENTER LINE	RIGHT	JOB NO.
-------------	------	-------------	-------	---------

W. 1/4 post sec. 36 Milton
Twp. Stone

Did not find ✓
#72

15

N.W. Cor. sec. 36 Milton
Twp. Stone 10' below
surface of present.
Set R.R. spike Bay Rd.

#73

16

W. 1/4 post sec. 25.
E. R. P. line N.W. 1/4
S.W. Cor. posts 10' W. of E.
edge of post. Fd. from pipe
on E. edge of post.

Fd. R.R. Spk. 5" below surface 1' W. of E.
edge of post.

#74

17

S.E. Cor. sec. 23 Milton
Twp. Stone S.R. #281
✓ R.R. spk.

#75

18

W. 1/4 of S.W. 1/4 sec. 24
Fd. stone in W. bank of Dch.
Fd. Stone ✓

#75-A

18-A

Shi. T. Pole E 21.02

Stone E. 30.0

Stone W. 30.0

Shi. P. Pole SW. 43.30

Shi. Wild Cherry E 54.70

✓ Shi. in T. Pole S.E. 46.31

✓ Ditch marker leaning S.E. 42.75' 42.75

✓ S.E. Cor. E. post, S.E. 40.50 40.45

✓ W. Cor. W. post, S.W. 28.35 28.30

✓ Shiner in P.P. N.W. 34.80 34.16

Iron sign stone N.E. gone 33.20

✓ Shi. P.P. N.N.W. 78.5

Shi. P. Pole N.N.E. 103.92

~~Force Post E 20.00~~

~~Anchor post E 20.25~~

~~Anchor post (S.E. Cor. gone) 31.70~~

✓ T. Pole S.W. 46.20

✓ Conc. mon. N.E. 23.43 23.75

✓ Conc. mon. Spt E. 15.26 13.78

✓ Shi. P. Pole S.S.E. 109.30

✓ N.E. to shiner in P.P. 44.60

✓ W.N.W. to shiner in P.P. 121.54

✓ S.W. to shiner in T.P. 59.10

✓ S.S.W. to shiner in T.P. 64.41

✓ S.E. to shiner in T.P. 67.70

High Point
✓ Shiner in P.P. E. 33.80' 34.0'

✓ Shiner in T.P. W. 55.25' 36.0'

PERSONNEL	TITLE	PERSONNEL	TITLE	COUNTY	DATE	WEATHER	TEMP
				Wood	12-18-57	4-14-60	
				S. R. #69		1-18-66	
				SEC.			

DESCRIPTION	LEFT	CENTER LINE	RIGHT	JOB NO.
W. 1/4 post sec. 36 Milton Twp. Stone Did not find ✓ Found #72 15			Shiner T Pole E 21.02 ✓ Stone E. 30.0 ✓ Stone W. 30.0 Shiner P Pole S.W. 43.30 Shiner w chert E. 54.70 ✓ Shi. in T. Pole S.E. 46.37 ✓ Ditch marker leaning S.E. 42.75 43.75 ✓ S.E. cor. E. abut. S.E. 40.60 40.45 ✓ W. Cor. W abut. S.W. 20.40 21.20 ✓ Shiner in P.P. N.W. 34.80 36.16 Iron sign stake N.E. 60.00 62.00 ✓ Shi. P.P. N.N.W. 78.5 " " N.N.E. 103.92	
N.W. Cor. sec. 36 Milton Twp. Stone 10' below surface of pavement. Set R.R. spike Bays Rd. #73 16			Force Post E. 20.55 Anchor post E. 30.55 Busher post (W. S.W. gone 46.72 ✓ T. Pole S.W. 46.20 ✓ Conc. men. N.E. 23.63 23.73 ✓ Conc. men. Spt E. 19.66 18.73 ✓ Shi. P. Pole S.S.E. 109.30	
W. 1/4 post sec. 25. E.R. optional line N.W. & S.W. Cor. posts 10' W. of E. edge of post. Fd. iron pipe on E. edge of post. Fd. R.R. Spk. 5' Below Surface 1' W. of E. Edge post. #74 17			✓ N.E. to shiner in P.P. 44.61 ✓ W.N.W. to shiner in P.P. 121.51 ✓ S.W. to shiner in T.P. 59.70 59.65 ✓ S.S.W. to shiner in T.P. 64.41 ✓ S.E. to shiner in T.P. 67.74	
S.E. Cor. sec. 23 Milton Twp. Stone. S.E. #281 ✓ R.R. Spk. #75 18			High Point ✓ Shiner in P.P. E. 33.80 34.01 ✓ Shiner in T.P. W. 35.85 36.01	
W. 1/4 of S.W. 1/4 sec. 24 Fd. Stone in W. bank of Del. Fd. Stone ✓ #75-A 18-A				

PERSONNEL	TITLE	PERSONNEL	TITLE

COUNTY Wood DATE Oct 12-13-57
 S. R. #69 WEATHER 4-14-60
 SEC. _____ TEMP. 1-13-66

DESCRIPTION LEFT CENTER LINE RIGHT JOB NO.

W. 1/4 post sec. 36 Milton
 Twp. Stone
 Did not find ✓

#72 15

Stone E. 30.0
 Stone W. 30.0

N.W. Cor. sec. 36 Milton
 Twp. Stone 10' below
 surface of pavement.
 Set R.R. spike Boys Rd.

#73 16

✓ Shi. in T. Pole S.E. 46.37
 ✓ Ditch marker leaning S.E. 42.75' 42.95
 ✓ S.E. Cor. E. abut. S.E. 40.50 40.45
 ✓ W. Cor. W. abut. S.W. 28.35 28.30
 ✓ Shiner in P.P. N.W. 34.80 36.16
 Iron sign stake N.E. Gone 32.80
 ✓ Shi. P.P. N.N.W. 78.5'

W. 1/4 post sec. 25.
 E.P. spk. on a line N.W. &
 S.W. Cor. posts 10' W. of E.
 edge of pavt. Fd. iron pipe
 on E. edge of pavt.
 Fd. R.R. Spk. 5" Below Surface 1' W. of E.
 edge pavt.

#74 17

~~Fence Post E. 20.05~~
~~Anchor post E. 20.05~~
~~Anchor post W. S.W. Gone 36.78~~
 ✓ T. Pole S.W. 46.20'
 ✓ Conc. mon. N.E. 23.63 23.73
 ✓ Conc. map. Spt E. 18.66 18.78
 ✓ Shi. P. Pole S.S.E. 109.30'

S.E. Cor. Sec. 23 Milton
 Twp. Stone. S.R. #281
 ✓ R.R. spk.

#75 18

✓ N.E. to shiner in P.P. 44.65
 ✓ W.N.W. to shiner in P.P. 121.54
 ✓ S.W. to shiner in T.P. 59.65'
 ✓ S.S.W. to shiner in T.P. 64.41'
 ✓ S.E. to shiner in T.P. 67.75

W. 1/4 of S.W. 1/4 sec. 24
 Fd. stone in W. bank of Dch.
 Fd. Stone ✓

#75-A 18-A

High Point
 ✓ Shiner in P.P. E. 33.80' 34.0'
 ✓ Shiner in T.P. W. 35.85' 36.0'