

O.D.O.T. DISTRICT 2 SURVEY OFFICE (USE ONLY)

PERSONNEL

REFERENCE NO. 17

SHEET 17 OF 26

NOTES ASTON
H.C. NIESE
R.C. PRESTON-COLVIN

DATE 8-21-24
WEATHER BREEZY
TEMP. 70°

ROUTE SR 235
COUNTY WOOD
TOWNSHIP MILTON
SECTION 26
T 4 N R 9 E

DWG BY PRESTON-COLVIN PID CHIPSEAL

TYPE MONUMENT MAG/WASHER

ON SURFACE - ~~BELOW~~ ON

OFFSET Q PAVEMENT 7.6' ~~LT~~ : RT

1.7' TO RT EDGE PAVEMENT

STATION: 398+95.74

HORIZ.DATUM: NAD83 (2011)


GEOID: 2018

GRID: NORTHING: 589419


EASTING: 1615083

LDP: NORTHING: 410769.4

EASTING: 126696.3

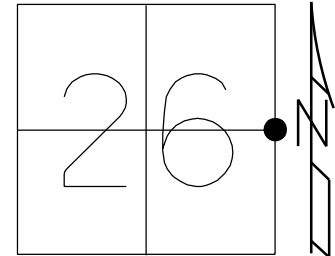

RECORD
SET MAG/WASHER
10-10-03, DCH
FD R.R.SPIKE
REF20
10-22-14
REF17
8-26-15
SET MAG/WASHER
NEWREF17
7-28-16, DCH
FD MAG/WASHER
REF17
4-29-22, DSA
FD MAG/WASHER
REF17
8-21-24, TDN
FD MAG/WASHER
9-18-24, TDN

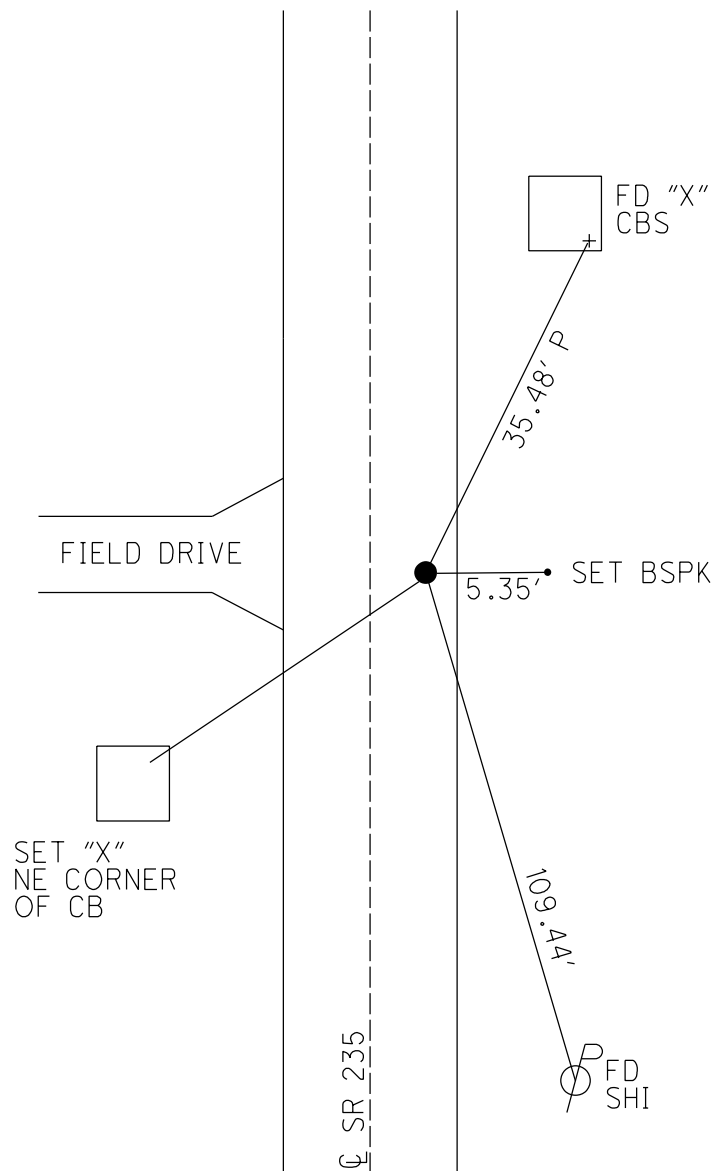

O.D.O.T. DISTRICT 2 SURVEY OFFICE (USE ONLY)

PERSONNEL

REFERENCE NO. 17

SHEET 17 OF 26

NOTES RHOADES

DATE 8-26-15

ROUTE SR 235

H.C. O'DONNELL

WEATHER CLOUDY

COUNTY WOOD

R.C. RHOADES

TEMP. 65°F

TOWNSHIP MILTON

SECTION 26

DWG BY WHITAKER PID R/W STAKE

T 4 N R 9 E

TYPE MONUMENT R.R.SPIKE

~~ON SURFACE~~ - BELOW 5"

OFFSET Q PAVEMENT 7.6' ~~LT~~ : RT
1.7' TO RT EDGE PAVEMENT


STATION: 398+95.74

HORIZ.DATUM: NAD83 2011


GEOID: NAVD88 2018

GRID: NORTHING: 589418.989

EASTING: 1615083.425

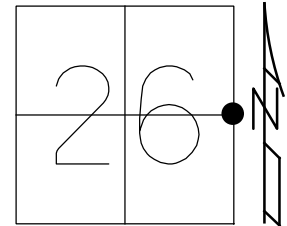

RECORD
SET MAG/WASHER
10-10-03, DCH
FD R.R.SPIKE
REF20
10-22-14
REF17
8-26-15
SET MAG/WASHER
NEWREF17
7-28-16, DCH
FD MAG/WASHER
REF17
4-29-22, DSA

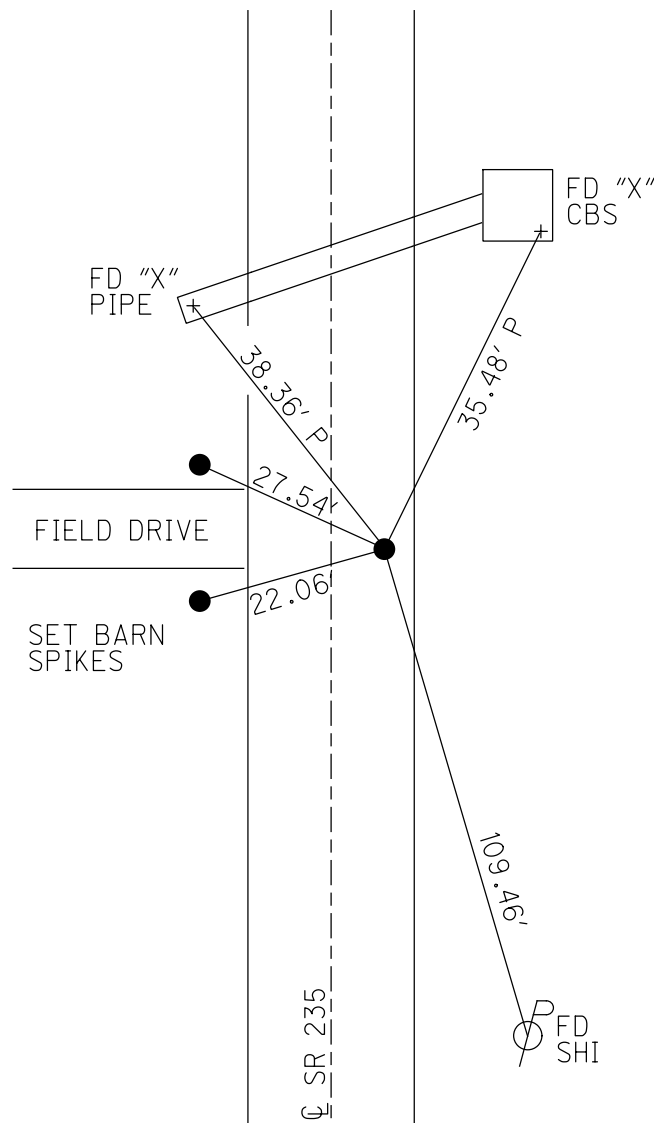

O.D.O.T. DISTRICT 2 SURVEY OFFICE (USE ONLY)

PERSONNEL	REFERENCE NO.	<u>17</u>	SHEET	<u>17</u>	OF	<u>26</u>
NOTES	<u>RHOADES</u>	DATE	<u>8-26-15</u>	ROUTE	<u>SR 235</u>	
H.C.	<u>O'DONNELL</u>	WEATHER	<u>CLOUDY</u>	COUNTY	<u>WOOD</u>	
R.C.	<u>RHOADES</u>	TEMP.	<u>65°F</u>	TOWNSHIP	<u>MILTON</u>	
				SECTION	<u>26</u>	
				T	<u>4</u>	R
					<u>N</u>	
						<u>R</u>
						<u>9</u>
						<u>E</u>

TYPE MONUMENT R.R.SPIKE


~~ON SURFACE~~ - BELOW 5"

~~LEFT~~ - Q PAV'T - RIGHT 7.6'

1.7' TO RT EDGE PAVEMENT

S.L.M. 398+95.74

Grid: Northing: 589418.99 Easting: 1615083.4433

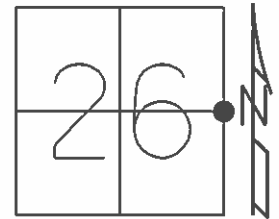


RECORD
SET MAG & WASHER
10-10-03, DCH

FD RR. SPIKE
GPS, REF20
10-22-14

GPS, REF17
8-26-15

SET MAG/WASHER
GPS, NEWREF17
7-28-16, DCH

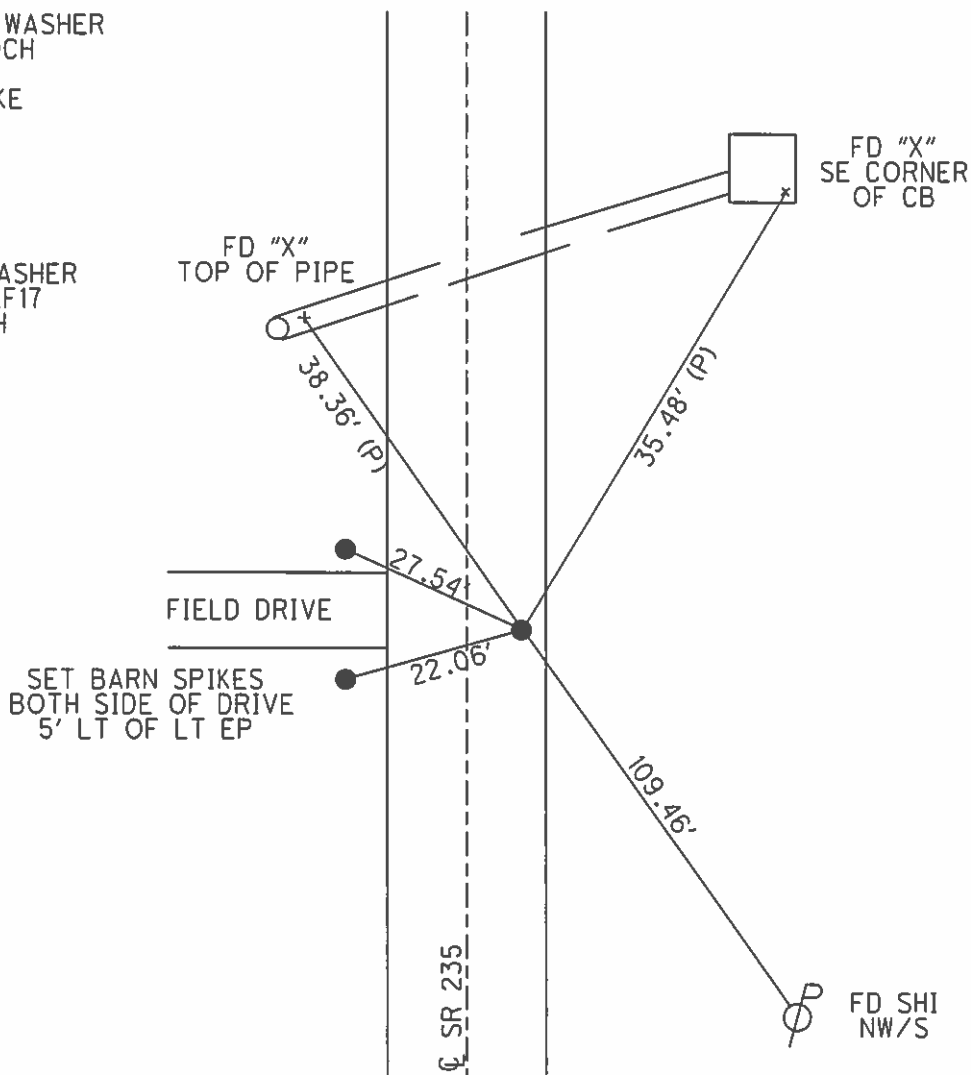

O.D.O.T. DISTRICT 2 SURVEY OFFICE

PERSONNEL

REFERENCE NO. 17

SHEET 14 OF 23

NOTES Homan

DATE 9-25-03

ROUTE 235

H.C. Nuhfer

WEATHER Sunny

COUNTY WOOD

R.C. BAllmer

TEMP. 50°

TOWNSHIP MILTON

SECTION 26

T 4 N R 9 E


TYPE MONUMENT PK& Washer

ON SURFACE - BELOW on surface


~~LEFT~~ - CL PAV'T - RIGHT 7.6

1.7 TO RT EDGE PAVEMENT

S.L.M. 397+92

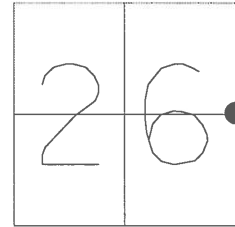

Set Mag & Washer
10-10-03
DCH

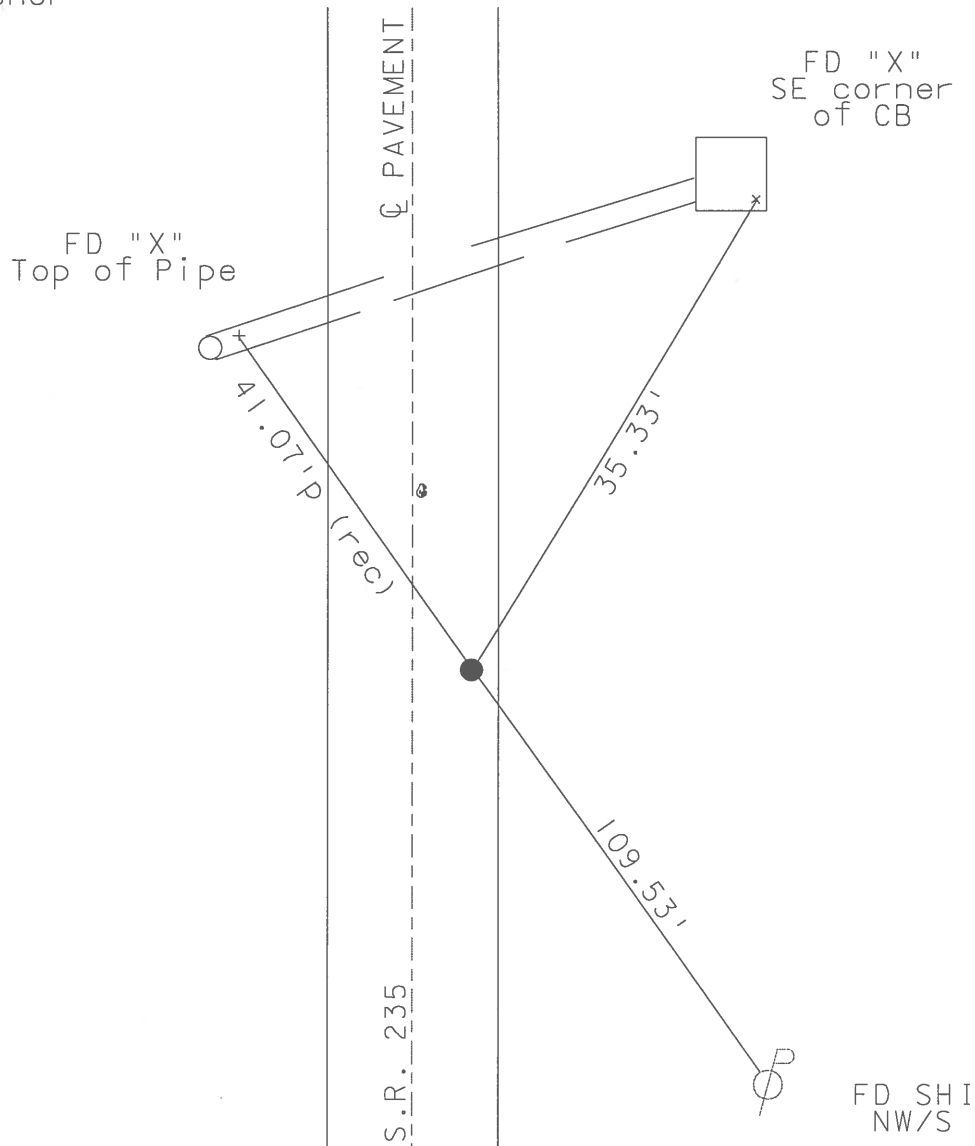

O.D.O.T. DISTRICT 2 SURVEY OFFICE

PERSONNEL

REFERENCE NO. 17

SHEET 13 OF 28

NOTES VAN DUSEN

H.C. MOSEY

DATE 7-30-96

ROUTE 235

R.C. STIEFLER

WEATHER CLOUDY

COUNTY WOOD

TEMP. +70° F

TOWNSHIP MILTON

SECTION 26

T4 N R 9 E


TYPE MONUMENT SM. R.R. SPK.

ON SURFACE - BELOW YES


LEFT - & PAV'T. - RIGHT 7.6

1.2 TO RT. EDGE PAVEMENT

S.L.M. 397+92

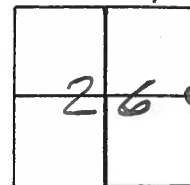

SET PK& WASHER
 10-7-96
 BVD

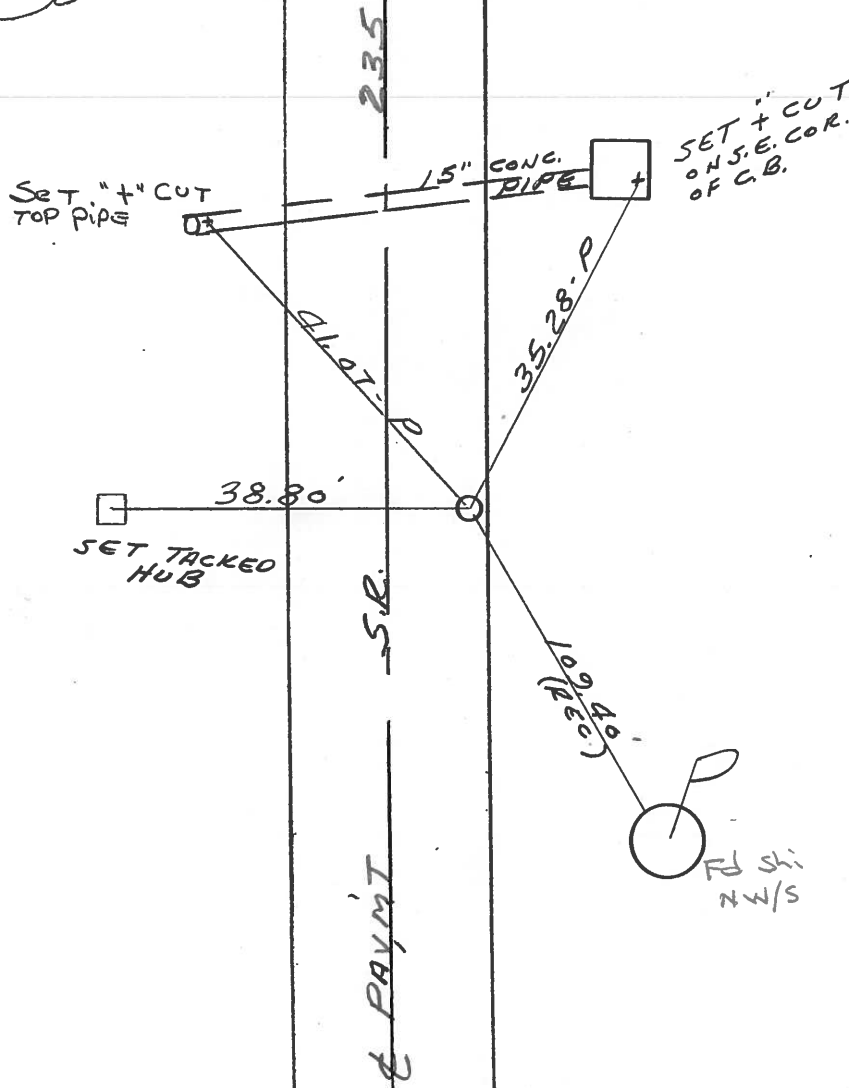

O.D.O.T. DISTRICT 2 SURVEY OFFICE

PERSONNEL

REFERENCE NO. 17

SHEET _____ OF _____

NOTES BARNHISEL

H.C. Loehrke

R.C. HOFFMAN

DATE 6-3-86

WEATHER Sunny

TEMP. +65°

ROUTE 235

COUNTY WOOD

TOWNSHIP MILTON

SECTION 26

T4 N R 9 E

TYPE MONUMENT Sm RR Spk



ON SURFACE - BELOW 1"

LEFT - & PAV'T. - RIGHT 7.7


1.54 TO RT EDGE PAVEMENT

S.L.M. 397+97

Set Sm RR Spk
6-27-86
MDB

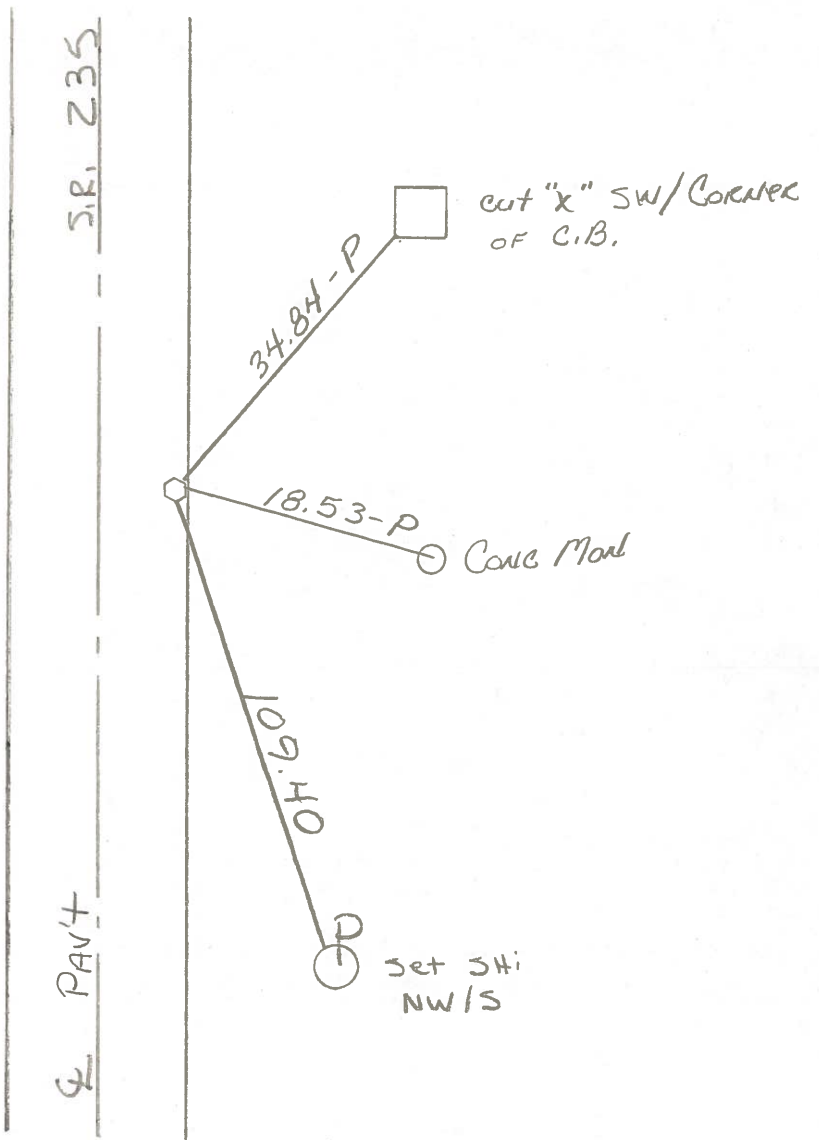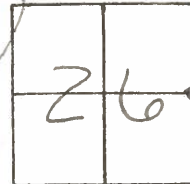

PERSONNEL	TITLE	PERSONNEL	TITLE
BURNSIDE			
SMITH			
BOWERS			
MEAD			

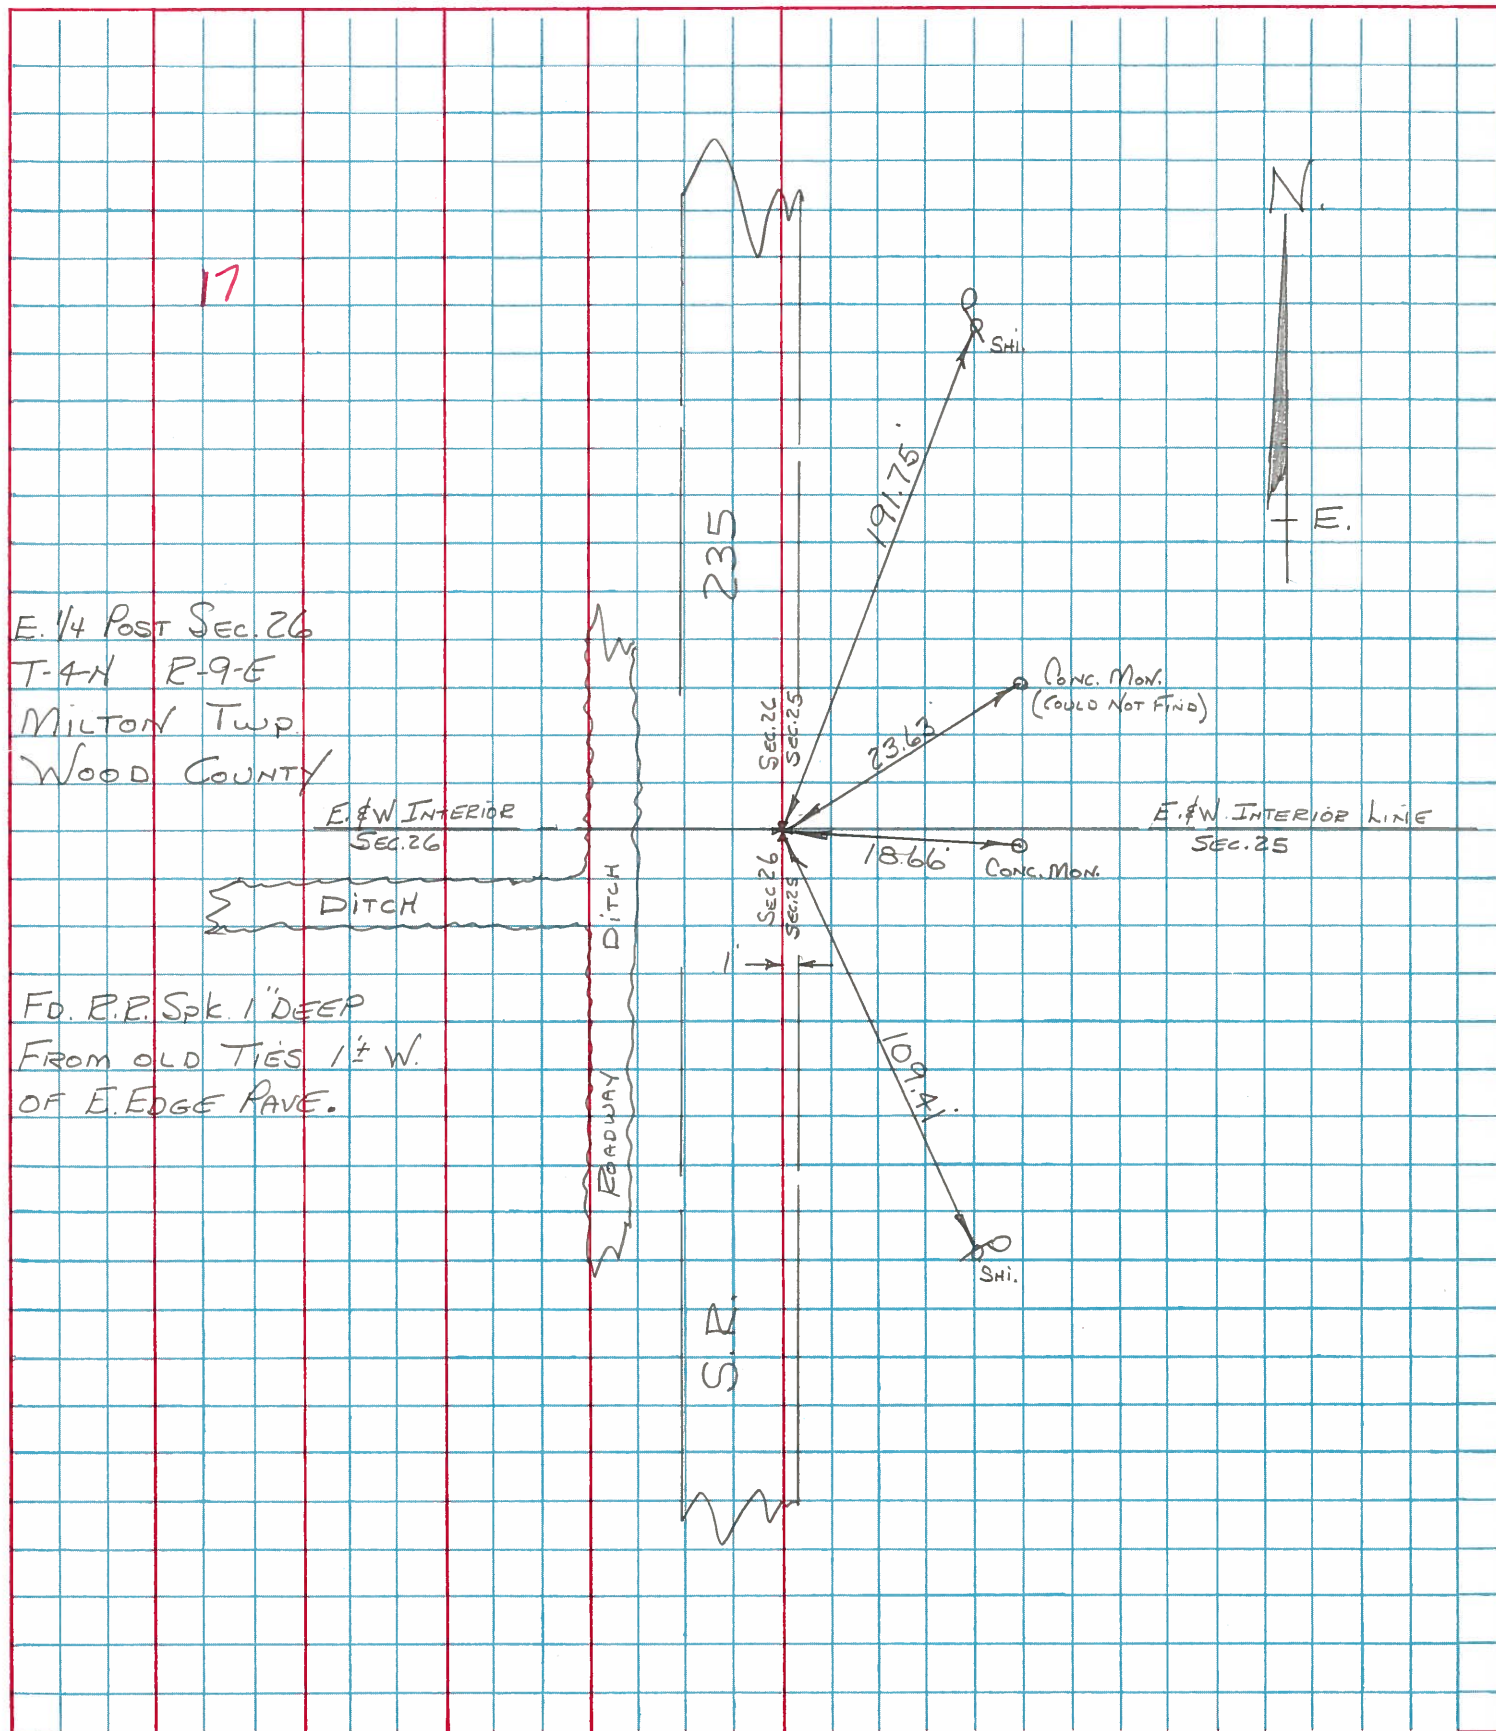COUNTY WOOD DATE 1-5-76S. R. 235 WEATHER CLEARSEC. E 1/4 Post SEC. 26 TEMP. +16°DESCRIPTION 4 CONTROL TIES (SEC. CORNERS) JOB NO. _____

PERSONNEL TITLE PERSONNEL TITLE

SILVESTER

COUNTY Wood

DATE 7-69

S. R. 235

WEATHER

SEC.

TEMP.

DESCRIPTION

LEFT

CENTER LINE

RIGHT

JOB NO.

#73

#16

N.W. Cor. Sec. 36 Milton Twp. Stone 1' below Surface
Set R.R. Spk. Bays Rd.

Shiner in T. Pole S.E. 46.37
Ditch Marker (bearing) S.E. 42.75
SE. Cor. E. Abut. SE. 40.60
W. Cor. W " SW. 28.40
Shiner in P. Pole N.W. 34.80
" " " " N.N.W. 78.59
" " " " N.N.E. 103.92

#74

#17

W. 1/4 Past Sec 25 Milton Twp.
RR Spk on a line N.W. & S.W. Cor. Posts 10' W. of E.
edge of Pavmt. Found Iron Pipe on E. Edge of Pavmt.
F&R Spk. 5" below Surface 1' W. of E. Edge Pavmt.

T. Pole S.W. 46.20
Conc. Mer NE. 23.63
" " S. of E. 18.66
Shiner in P. Pole S.S.E. 109.30

#18

#75

S.E. Cor. Sec. 23 Milton Twp. Stone
R.R. Spk. S.R. 281.

N.E. to Shiner in P. Pole 44.65
S.W. " " " T. " 59.70
S.S.W. " " " " 64.41
S.E. " " " " 67.75

PERSONNEL

TITLE

PERSONNEL

TITLE

COUNTY Wood.DATE MARCH 26 1968S. R. # 69WEATHER Cloudy Showers.

SEC.

TEMP. +45°

DESCRIPTION

Ties to Control Points

JOB NO.


LEFT

CENTER LINE

RIGHT


W 1/4 Post. Sec. #25
Milton Twp.
T4N-R9E.

17

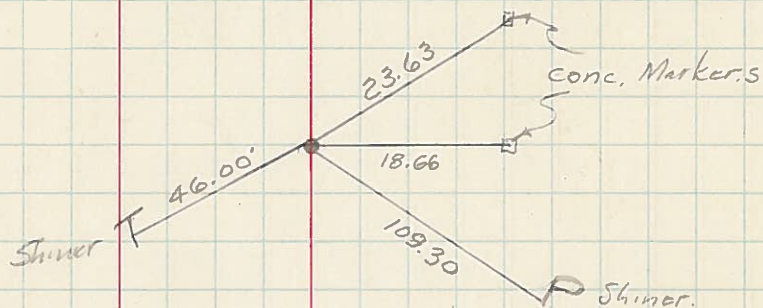

N.W. Cor Sec. #25
Milton Twp.
T4N-R9E.

18

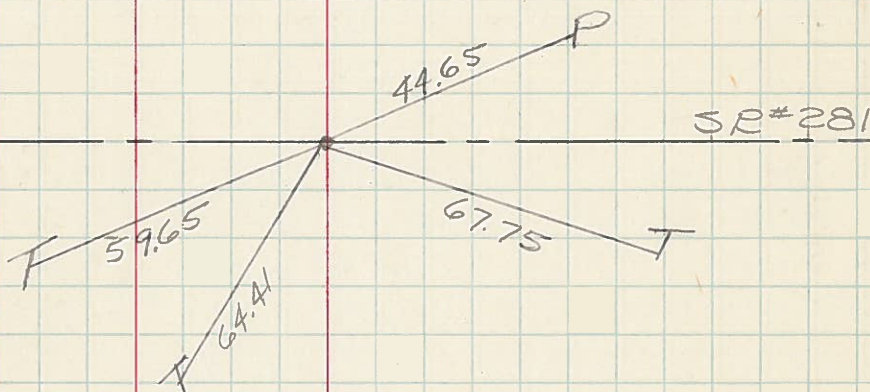

PERSONNEL	TITLE	PERSONNEL	TITLE	COUNTY	DATE	S. R.	WEATHER	SEC.	TEMP.
				Wood	12-13-57	69	4-14-60		
							1-18-66		

DESCRIPTION	LEFT	CENTER LINE	RIGHT	JOB NO.
W. 1/4 part sec. 36 Milton Twp. Stone Did not find ✓ #72	15	SET SMALL SPK. 7-28-69	SHI. T. Pole E 21.02 Stone E. 30.0 Stone W. 30.0 SHI. P. Pole SW. 43.30 SHI. WILD CHERRY E 54.70 ✓ Shi. in T. Pole S.E. 46.37 ✓ Ditch marker leaning S.E. 42.75 ✓ S.E. Cor. E. abut. S.E. 40.50 ✓ W. Cor. W. abut. S.W. 28.35 ✓ Shiner in P.P. N.W. 34.80 Iron sign stake N.E. gone 32.21 ✓ Shi. P.P. N.N.W. 78.5 SHI. P. Pole N.N.E. 103.92	
W. 1/4 part sec. 25. E.R. optional line N.W. 1/4 S.W. Cor. posts 10' W. of E. edge of post. Fd. iron pipe on E. edge of post. Fd. R.R. Spk. 5" Below Surface 1' W. of E. edge of post. #74	16	SET R.R. SPK. 7-23-69	Force Post E. 20.09 Anchor post E. 20.25 Anchor post W. Sect. gone 21.75 ✓ T. Pole S.W. 46.20 ✓ Conc. mon. N.E. 23.43 ✓ Conc. mon. Spt E. 15.66 ✓ Shi. P. Pole S.S.E. 109.30	
S.E. Cor. sec. 23 Milton Twp. Stone. S.R. #281 ✓ R.R. Spk. #75	17	TIES OK 7-28-69	✓ N.E. to shiner in P.P. 44.61 ✓ W.N.W. to shiner in P.P. 121.51 ✓ S.W. to shiner in T.P. 57.10 ✓ S.S.W. to shiner in T.P. 64.41 ✓ S.E. to shiner in T.P. 67.71	
W. 1/4 of S.W. 1/4 sec. 24 Fd. stone in W. bank of Dch. Fd. Stone ✓ #75-A	18-A		High, Fast ✓ Shiner in P.P. E. 33.80 ✓ Shiner in T.P. W. 35.25	

PERSONNEL	TITLE	PERSONNEL	TITLE	COUNTY	DATE	WEATHER	TEMP.
				Wood	12-17-1957	4-14-60	
				S. R. #69		1-18-66	
				SEC.			

DESCRIPTION	LEFT	CENTER LINE	RIGHT	JOB NO.
W. 1/4 post sec. 36 Milton Twp. Stone Did not find ✓ Found #72 15			Shiner T Pole E 21.02 ✓ Stone E. 30.0 ✓ Stone W. 30.0 Shiner P.P. S.W. 43.30 Shiner W. chert E. 54.70 ✓ Shi. in T. Pole S.E. 46.37 ✓ Ditch marker leaning S.E. 42.75 13.75 ✓ S.E. cor. E. about, S.E. 40.60 40.45 ✓ W. Cor. W. about, S.W. 20.40 21.80 ✓ Shiner in P.P. N.W. 34.50 36.16 Iron sign stake N.E. 60.0 32.00 ✓ Shi. P.P. N.N.W. 78.5 " " N.N.E. 103.92	
N.W. Cor. sec. 36 Milton Twp. Stone 10' below surface of pavement. Set R.R. spike Boys Rd. #73 16			Grass Post E. 20.55 Anchor post E. 30.55 Busbar post (W. Cor. E. 36.72) ✓ T. Pole S.W. 46.20 ✓ Conc. men. N.E. 23.63 23.75 ✓ Conc. men. Spt E. 19.66 18.73 ✓ Shi. P. Pole S.S.E. 109.30	
W. 1/4 post sec. 25. E.R. optional line N.W. & S.W. Cor. posts 10' W. of E. edge of post. Fd. iron pipe on E. edge of post. Fd. R.R. Spk. 5' Below Surface 1' W. of E. Edge post #74 17			✓ N.E. to shiner in P.P. 44.61 ✓ W.N.W. to shiner in P.P. 121.51 ✓ S.W. to shiner in T.P. 59.70 59.65 ✓ S.S.W. to shiner in T.P. 64.41 ✓ S.E. to shiner in T.P. 67.70	
S.E. Cor. sec. 23 Milton Twp. Stone. S.E. #281 ✓ R.E. spk. #75 18				
W. 1/4 of S.W. 1/4 sec. 24 Fd. stone in W. bank of Dch. Fd. Stone ✓ #75A 18-A			High Point ✓ Shiner in P.P. E. 33.80 34.01 ✓ Shiner in T.P. W. 35.85 36.41	

PERSONNEL	TITLE	PERSONNEL	TITLE

COUNTY Wood DATE 06-12-13-57S. R. #69 WEATHER 4-14-60

SEC. _____ TEMP. _____

DESCRIPTION _____ LEFT _____ CENTER LINE _____ RIGHT _____ JOB NO. _____

W. 1/4 post sec. 36 Milton
Twp. Stone
Did not find ✓

#72 15

Stone E. 30.0
Stone W. 30.0

N.W. Cor. sec. 36 Milton
Twp. Stone 1.0' below
surface of pavement.
Set R.R. spike Bays Rd.

#73 16

✓ Shi. in T. Pole S.E. 46.37
✓ Ditch marker leaning S.E. 42.75 48.95
✓ S.E. Cor. E. abut. S.E. 40.50 40.45
✓ W. Cor. W. abut. S.W. 28.35 28.30
✓ Shiner in P.P. N.W. 34.80 36.16
~~Iron sign stake N.E. Gone 32.80~~
✓ Shi. P.P. N.N.W. 78.5'

W. 1/4 post sec. 25.
E.E. optional line N.W. &
S.W. Cor. posts 10' W. of E.
edge of pavt. Fd. iron pipe
on E. edge of pavt.
Fd. R.R. Spk. 5" Below Surface 1' W. of E.
Edge pavt.

#74 17

~~Fence Post E. 20.05~~
~~Anchor post E. 20.05~~
~~Anchor post W.S.W. Gone 36.78~~
✓ T. Pole S.W. 46.20'
✓ Conc. mon. N.E. 23.63 23.73
✓ Conc. mon. Spt E. 18.66 18.78
✓ Shi. P. Pole S.S.E. 109.30'

S.E. Cor. sec. 23 Milton
Twp. Stone. S.R. #281
✓ R.R. spk.

#75 18

✓ N.E. to shiner in P.P. 44.65
✓ W.N.W. to shiner in P.P. 121.54
✓ S.W. to shiner in T.P. 59.65'
✓ S.S.W. to shiner in T.P. 64.41'
✓ S.E. to shiner in T.P. 67.75

W. 1/4 of S.W. 1/4 sec. 24
Fd. Stone in W. bank of Del.
Fd. Stone ✓

#75-A 18-A

High Point
✓ Shiner in P.P. E. 33.80' 34.0'
✓ Shiner in T.P. W. 35.85' 36.0'