

O.D.O.T. DISTRICT 2 SURVEY OFFICE (USE ONLY)

PERSONNEL

REFERENCE NO. 18

SHEET 18 OF 26

NOTES ASTON
H.C. NIESE
R.C. PRESTON-COLVIN

DATE 8-21-24
WEATHER BREEZY
TEMP. 70°

ROUTE SR 235
COUNTY WOOD
TOWNSHIP MILTON
SECTION 26
T 4 N R 9 E

DWG BY PRESTON-COLVIN PID CHIPSEAL

TYPE MONUMENT MAG/WASHER

ON SURFACE - ~~BELOW~~ ON

OFFSET Q PAVEMENT 11.4' ~~LT~~ : RT

2.2' TO RT EDGE PAVEMENT

STATION: 425+47.72

HORIZ.DATUM: NAD83 (2011)


GEOID: 2018

GRID: NORTHING: 592070.9


EASTING: 1615081

LDP: NORTHING: 413421.3

EASTING: 126658.9

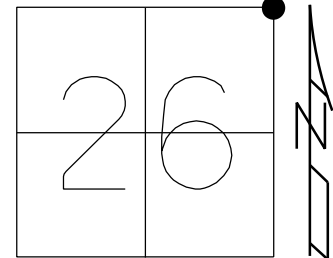

RECORD: P.O.T.
FD R.R.SPIKE
1 1/2" DOWN
5/1/79
8/24/81
SET P.K./WASHER
10-7-96, BVD
FD NAIL/SHINER
5/6/04, RGN
SET P.K./WASHER
5/6/04, RGN
FD R.R.SPIKE
7/2/12, DCH
FD MINE SPIKE
10-23-14
8-26-15
SET MAG/WASHER
7-28-16, DCH
FD MAG/WASHER
5/14/18, JLL
FD MAG/WASHER
6/24/19
10/4/21, DSA
FD MAG/WASHER
4-29-22, DSA
FD MAG/WASHER
REF18
8-21-24, TDN
FD MAG/WASHER
9-18-24, TDN

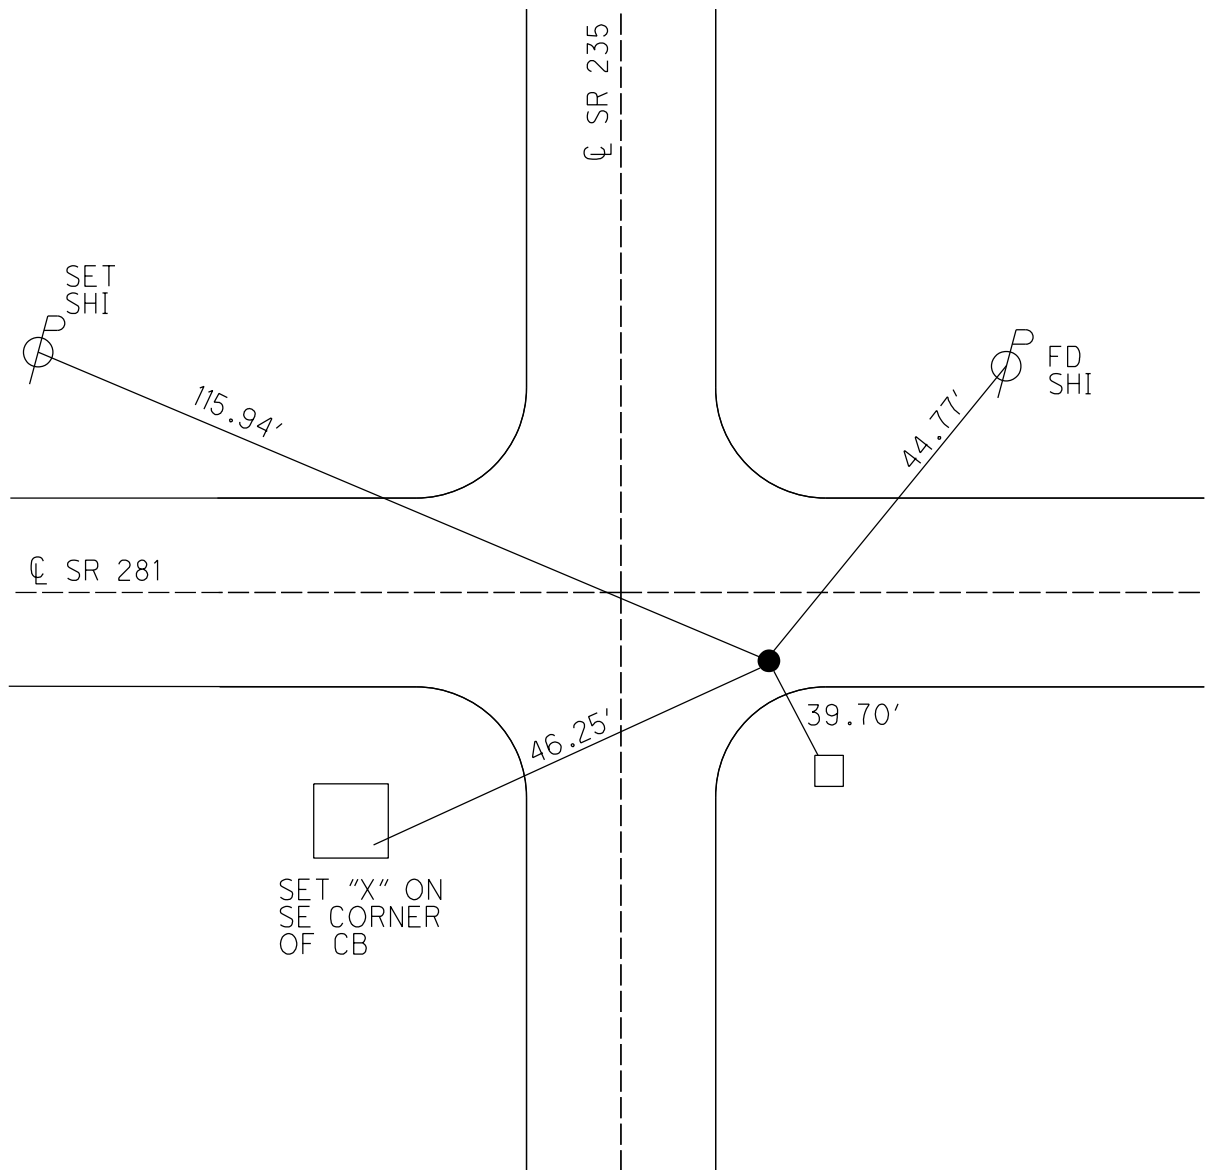

O.D.O.T. DISTRICT 2 SURVEY OFFICE (USE ONLY)

PERSONNEL

REFERENCE NO. 18

SHEET 18 OF 26

NOTES RHOADES

DATE 8-26-15

ROUTE SR 235

H.C. O'DONNELL

WEATHER CLOUDY

COUNTY WOOD

R.C. RHOADES

TEMP. 65°F

TOWNSHIP MILTON

SECTION 26

DWG BY WHITAKER

PID R/W STAKE

T 4 N R 9 E

TYPE MONUMENT MINE SPIKE

~~ON SURFACE~~ - BELOW 0.3'

OFFSET Q PAVEMENT 11.4' ~~LT~~ : RT

2.2' TO RT EDGE PAVEMENT


STATION: 425+47.72

HORZ.DATUM: NAD83 2011

GEOID: NAVD88 2018

GRID: NORTHING: 592070.940

EASTING: 1615080.957

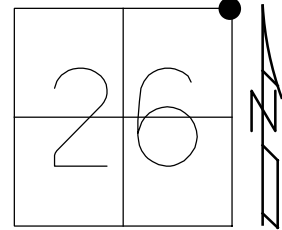

FD SHI P
121.56' REC

Q SR 281

RECORD:
SET P.K./WASHER
10-7-96, BVD
FD P.K./WASHER
5-6-04, RGN
FD MINE SPIKE
REF21
10-23-14
REF18
8-26-15
SET MAG/WASHER
NEWREF18
7-28-16, DCH
FD MAG/WASHER
REF18
5/14/18, JLL
FD MAG/WASHER
REF 18
4-29-22, DSA

Q SR 235

44.77' FD SHI P

30.23' FD SHI
5' EP

42.99'

2' UP
STOP SIGN
POST

O.D.O.T. DISTRICT 2 SURVEY OFFICE (USE ONLY)

PERSONNEL

REFERENCE NO.

18

SHEET

18

OF

26

NOTES

RHOADES

DATE

8-26-15

ROUTE

SR 235

H.C.

O'DONNELL

WEATHER

CLOUDY

COUNTY

WOOD

R.C.

RHOADES

TEMP.

65°F

TOWNSHIP

MILTON

SECTION

26

T 4 N

R 9 E

TYPE MONUMENT

MINE SPIKE

~~ON SURFACE~~ - BELOW

0.3'

~~LEFT~~ - Q PAV'T - RIGHT

11.4'


2.2' TO RT EDGE PAVEMENT

S.L.M.

425+47.72

Grid: Northing: 592070.950

Easting: 1615080.970

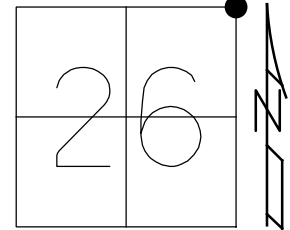

RECORD:

SET P.K./WASHER

10-7-96, BVD

FD P.K./WASHER

5-6-04, RGN

FD MINE SPIKE

REF21

10-23-14

REF18

8-26-15

SET MAG/WASHER


NEWREF18

7-28-16, DCH

FD MAG/WASHER

REF18

5/14/18, JLL

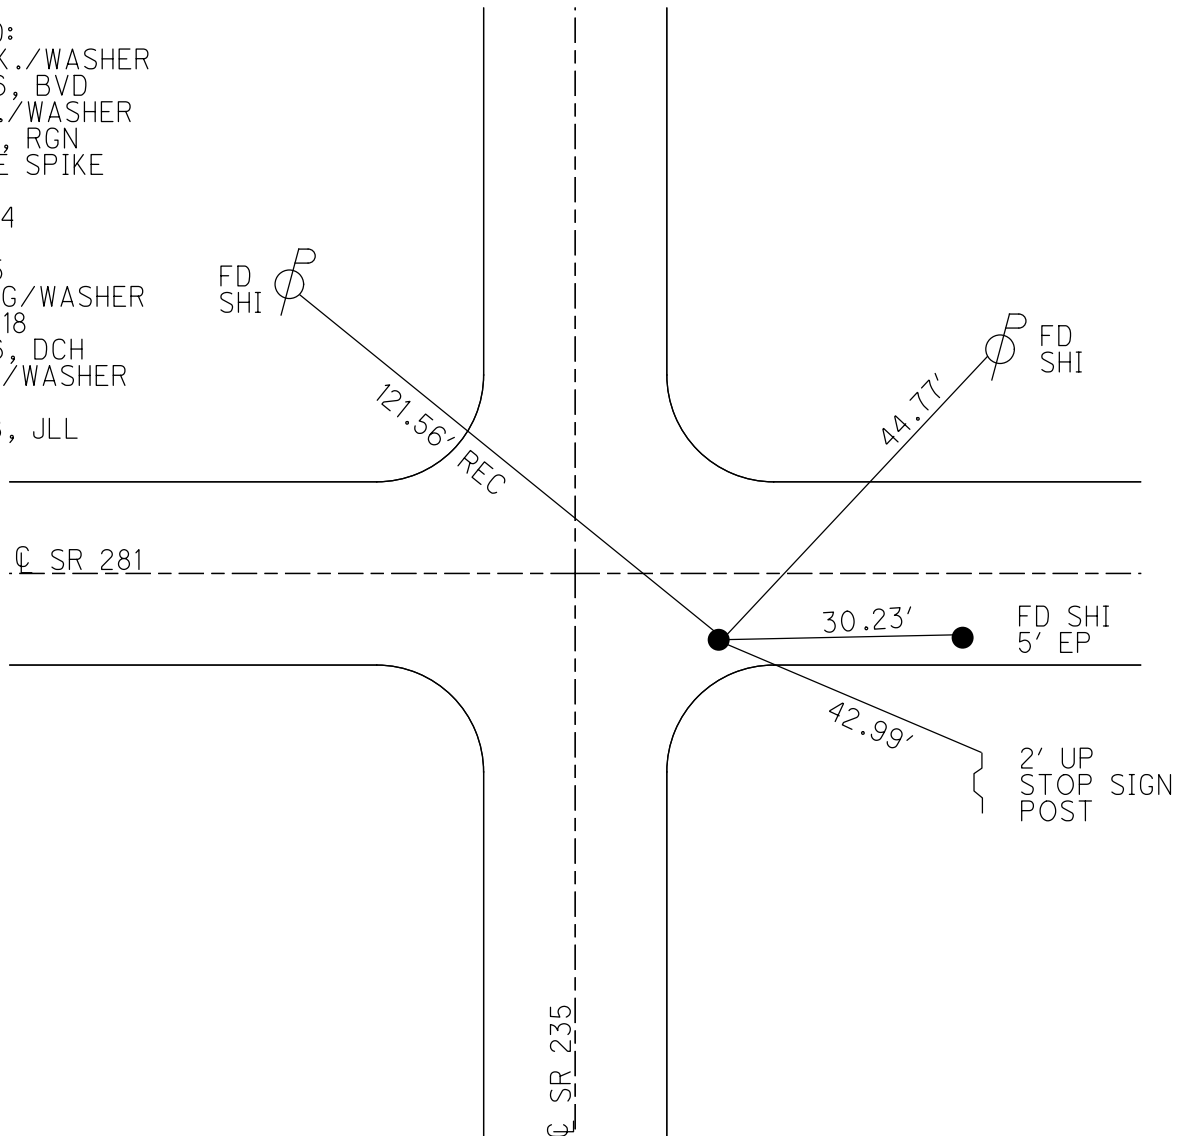

O.D.O.T. DISTRICT 2 SURVEY OFFICE (USE ONLY)

PERSONNEL

REFERENCE NO. 18

SHEET 18 OF 26

NOTES RHOADES

DATE 8-26-15

ROUTE SR 235

H.C. O'DONNELL

WEATHER CLOUDY

COUNTY WOOD

R.C. RHOADES

TEMP. 65°F

TOWNSHIP MILTON

SECTION 26

T 4 N R 9 E

TYPE MONUMENT MINE SPIKE


~~ON SURFACE~~ - BELOW 0.3'

~~LEFT~~ - CL PAV'T - RIGHT 11.4'

2.2' TO RT EDGE PAVEMENT

S.L.M. 425+47.72

Grid: Northing: 592070.9327 Easting: 1615081.0406

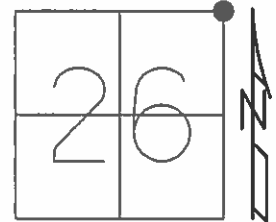


RECORD:
SET PK/WASHER
10-7-96, BVD

FD PK/WASHER
5-6-04, RGN

FD MINE SPIKE
GPS, REF21
10-23-14

GPS, REF18
8-26-15

SET MAG/WASHER
GPS, NEWREF18
7-28-16, DCH

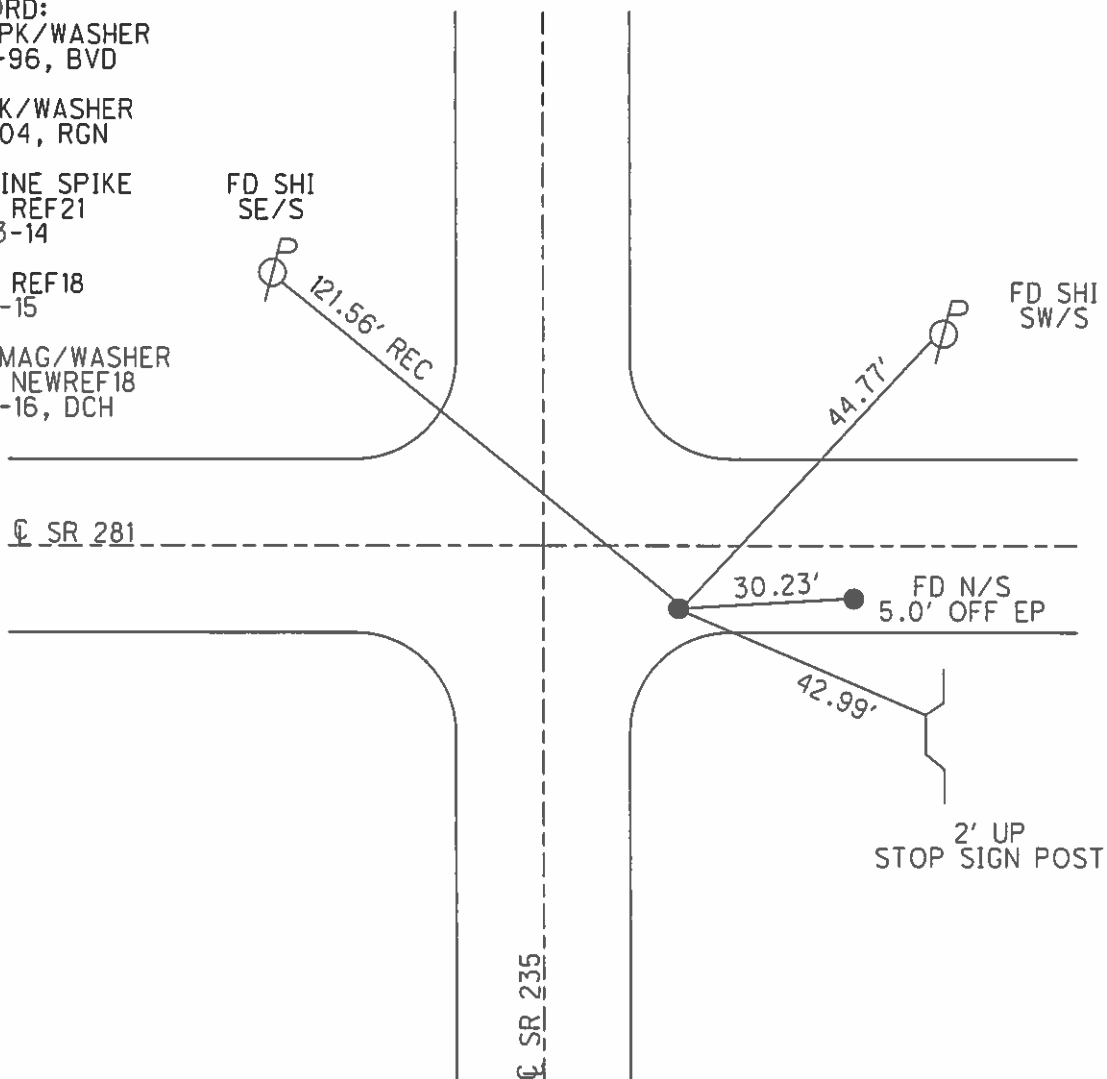

O.D.O.T. DISTRICT 2 SURVEY OFFICE (USE ONLY)

PERSONNEL

REFERENCE NO. 18

SHEET 1 OF 25

NOTES NUHFER

DATE 5-6-04 S.R. 281=#12

ROUTE S.R. 235

H.C. CANTERBURY

WEATHER SUNNY

COUNTY WOOD

R.C. ARMS

TEMP. +78°

TOWNSHIP MILTON

SECTION 26

T 4 N R 9 E

TYPE MONUMENT NAIL/SHINER


ON SURFACE - ~~BELOW~~ YES

~~|||||~~ - CL PAV'T - RIGHT 11.4'


2.2' TO RT. EDGE PAVEMENT

S.L.M. S.R. 235=424+47 (8' RT. OF CL S.R. 281)

Grid: Northing: _____ Easting: _____

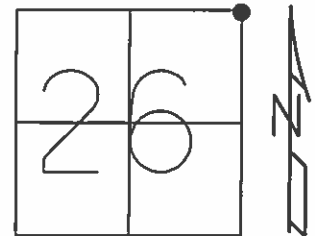

SET P.K. & WASHER
5-6-04
R.G.N.

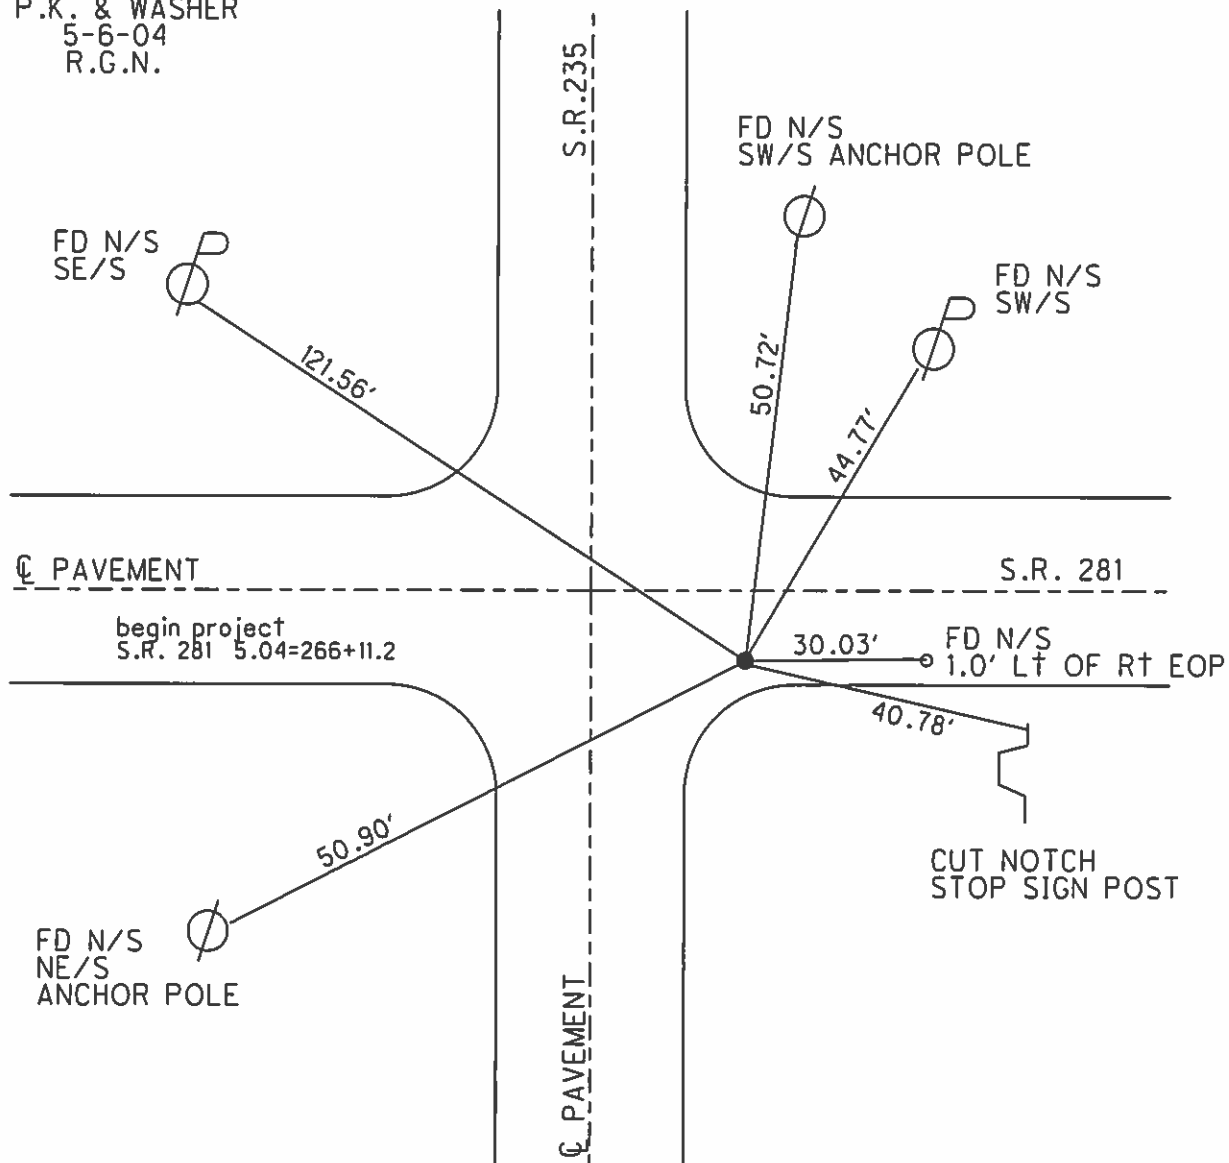

O.D.O.T. DISTRICT 2 SURVEY OFFICE

PERSONNEL

REFERENCE NO. 18

SHEET 1 OF 25

NOTES NUHFER

DATE 5-6-04

ROUTE S.R. 235

H.C. CANTERBURY

WEATHER SUNNY

COUNTY WOOD

R.C. ARMS

TEMP. +78°

TOWNSHIP MILTON

SECTION 26

T 4 N R 9 E


TYPE MONUMENT NAIL / SHI

ON SURFACE - BELOW YES

℄ PAV'T - RIGHT 11.4'

2.2 TO RT. EDGE PAVEMENT


S.L.M. S.R. 235 = 424+47 (8' RT OF SR 281 ℄)

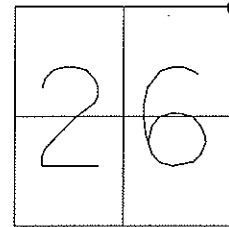

FD. P.K. & WASHER

5-6-04

R.G.N.

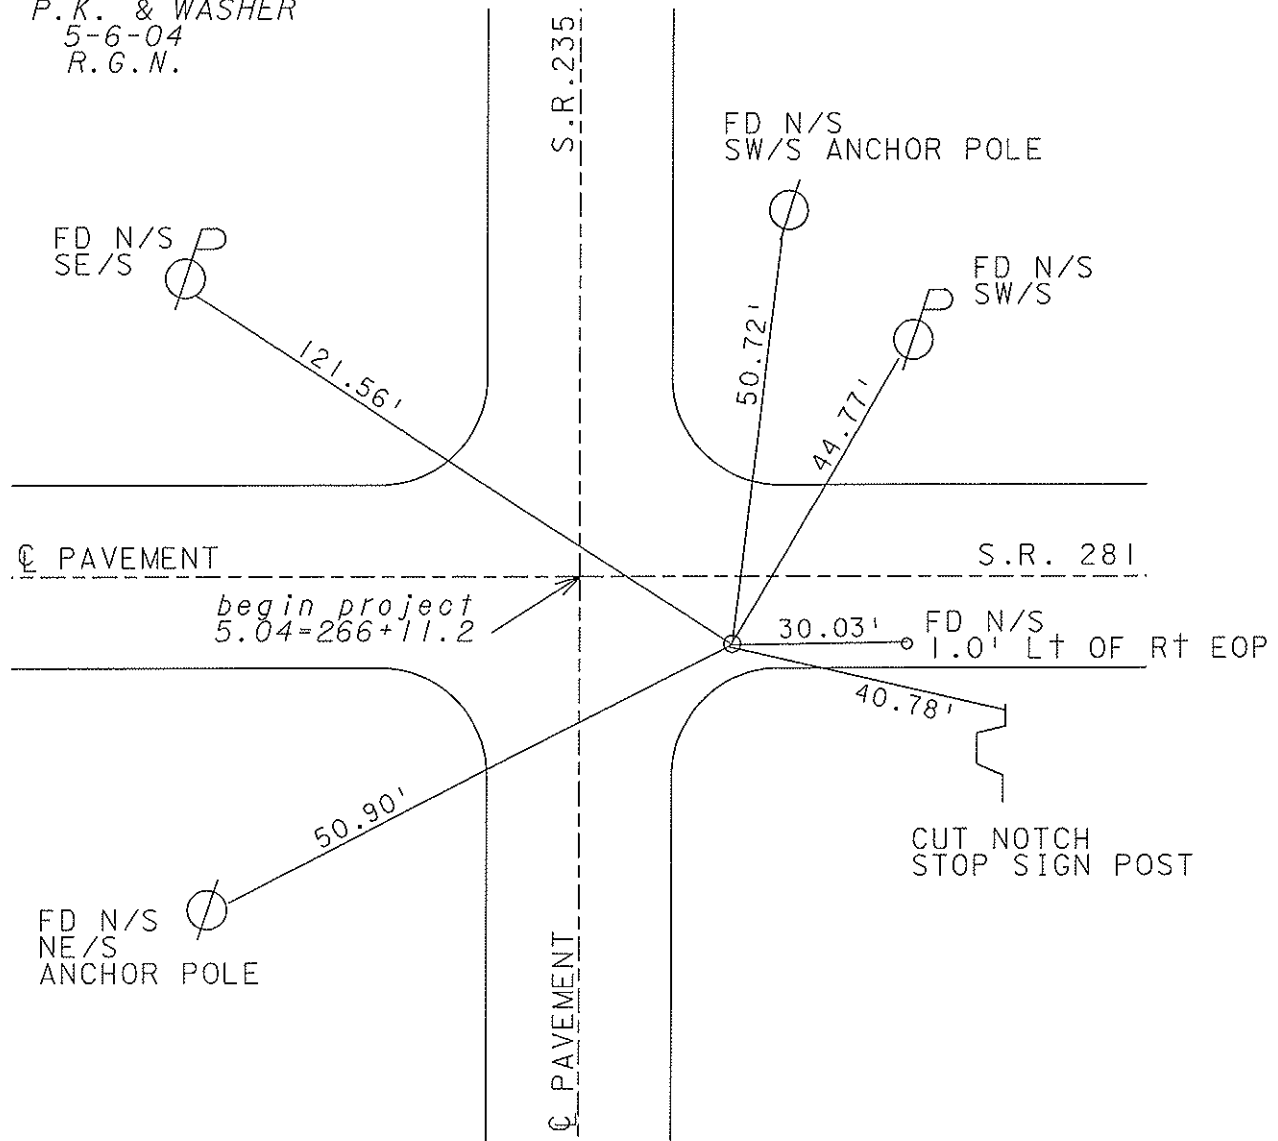

O.D.O.T. DISTRICT 2 SURVEY OFFICE

PERSONNEL

REFERENCE NO. 18

SHEET 15 OF 23

NOTES Homan

DATE 9-25-03

ROUTE 235

H.C. Nuhfer

WEATHER Sunny

COUNTY WOOD

R.C. Ballmer

TEMP. 50°

TOWNSHIP MILTON

SECTION 26

T 4 N R 9 E


TYPE MONUMENT PK & Washer

ON SURFACE - BELOW on surface

~~LEFT~~ - Q PAV'T - RIGHT 11.4


2.2 TO RT EDGE PAVEMENT

S.L.M. 424+47

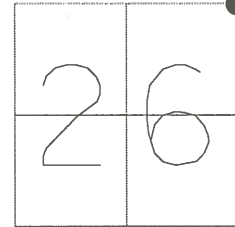

Set PK & Washer
10-7-96
BVD

POINT NOT
DISTURBED 2003

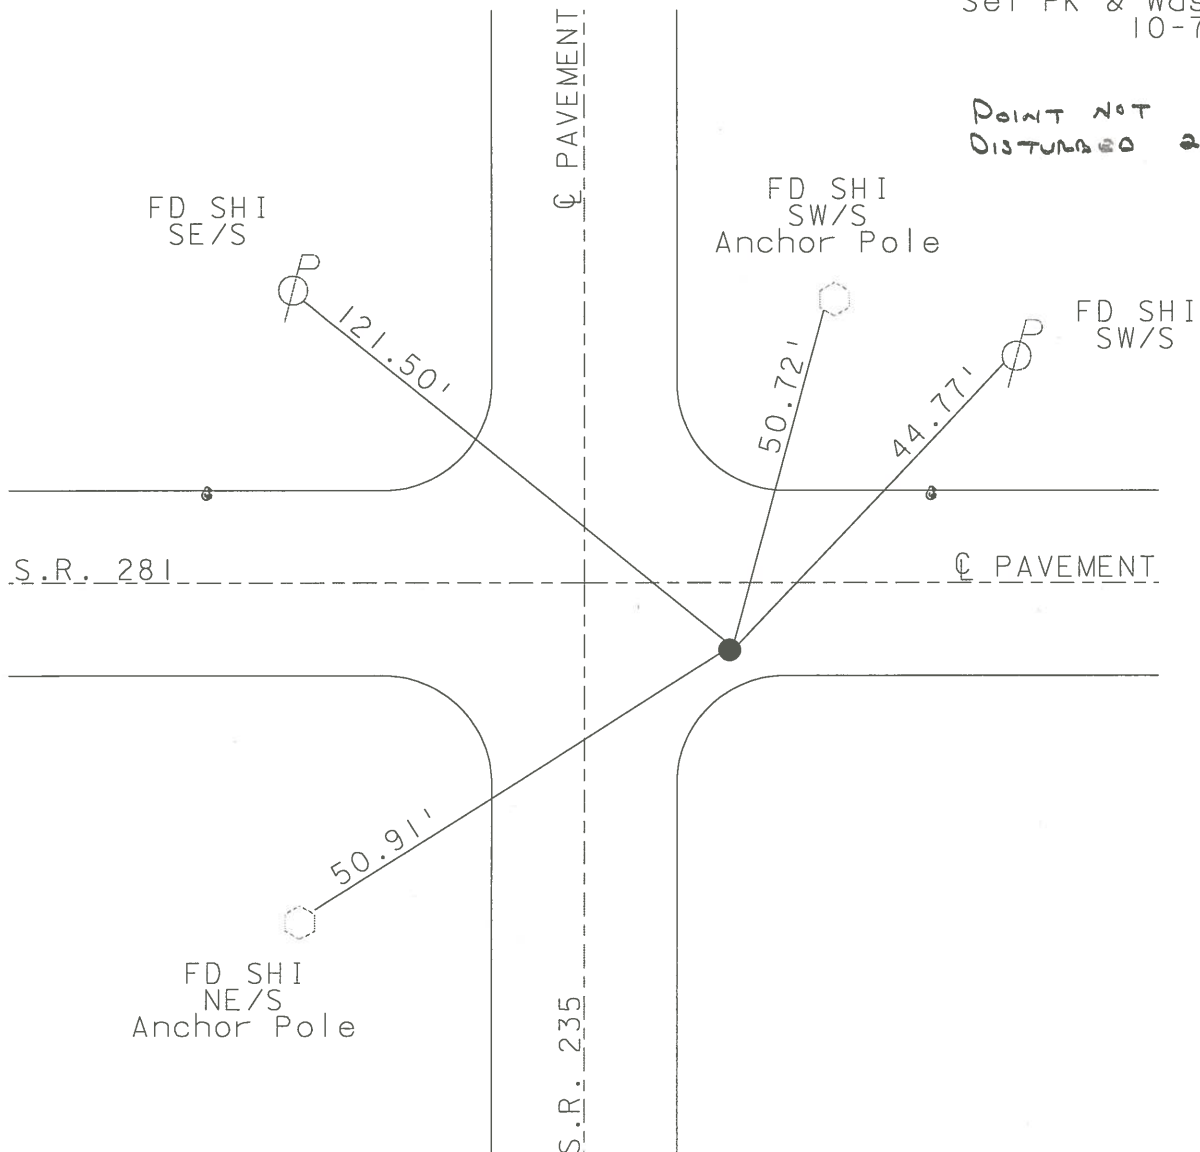

O.D.O.T. DISTRICT 2 SURVEY OFFICE

PERSONNEL

REFERENCE NO. 18

SHEET 14 OF 28

NOTES VAN DUSEN

DATE 2-30-96

ROUTE 235

H.C. M0552

WEATHER cloudy

COUNTY WOOD

R.C. H055

TEMP. + 70° F

TOWNSHIP MILTON

SECTION 26

T4 N R2 E

TYPE MONUMENT LG. RR. SPK.



ON SURFACE - ~~BELOW~~ YES

~~LEFT~~ - C PAV'T - RIGHT 11.4

2.2 TOT RT EDGE PAVEMENT

S.L.M. 424 + 47

S.L.K. _____

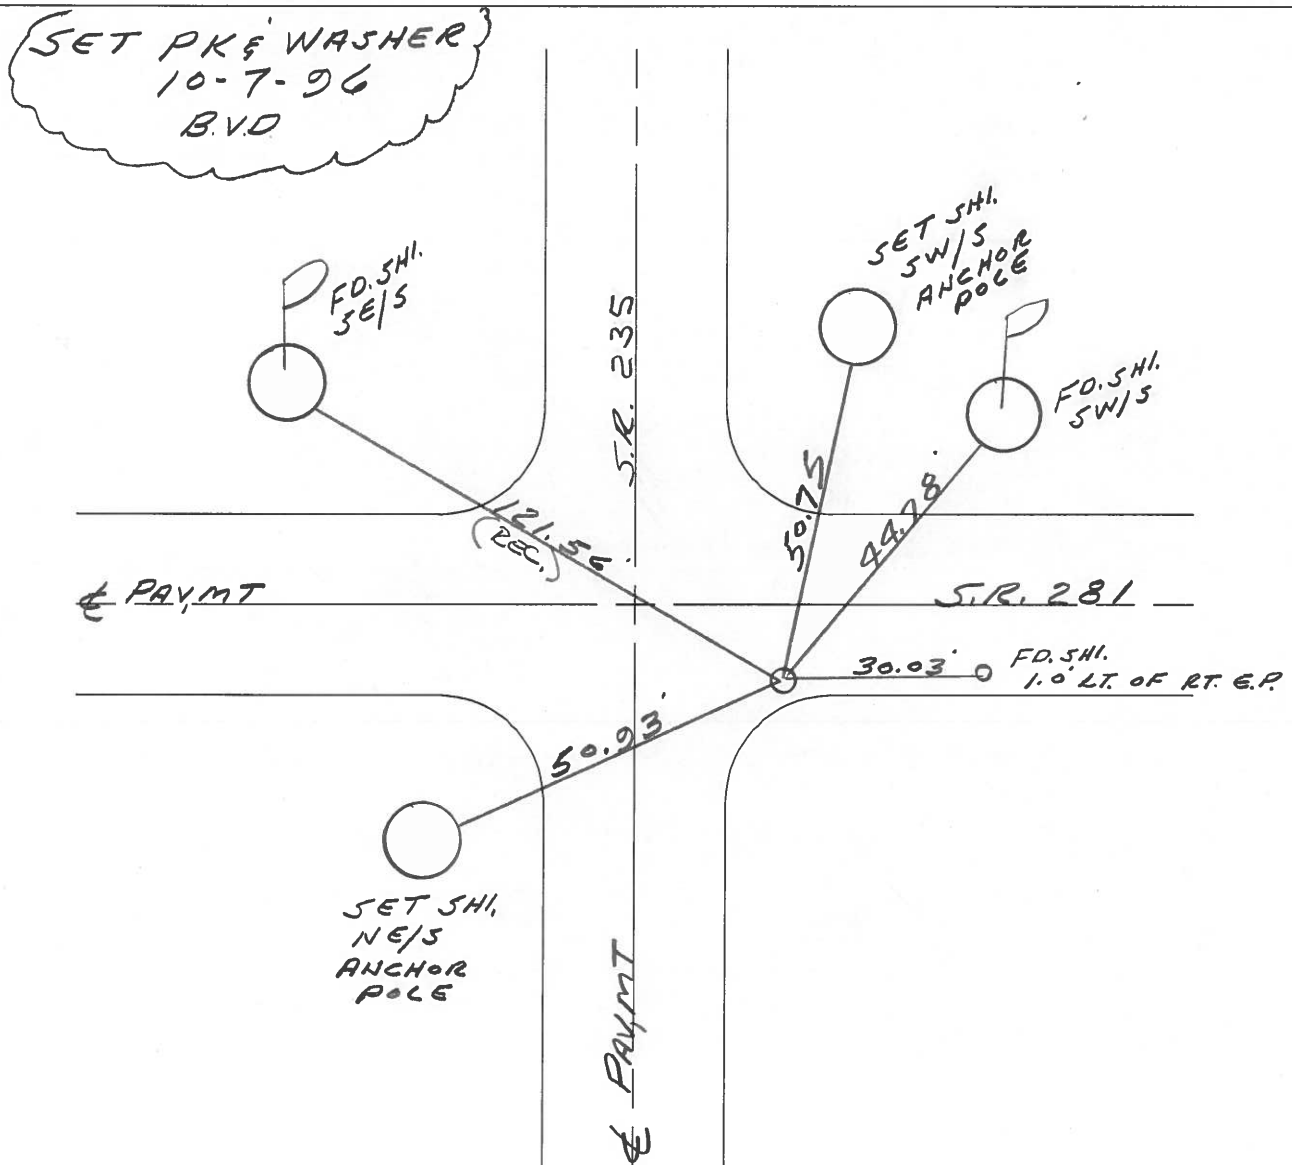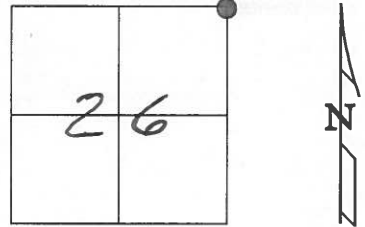

O.D.O.T. DISTRICT 2 SURVEY OFFICE

PERSONNEL

REFERENCE NO. 18

SHEET OF

NOTES BARNHISEL

H.C. Loehrke

R.C. HOFFMAN

DATE 6-6-86

WEATHER CLOUDY - RAIN

TEMP. +60°

ROUTE 235

COUNTY WOOD

TOWNSHIP MILTON

SECTION 26

T. 4 N R. 9 E

TYPE MONUMENT Lg RR Spk



ON SURFACE - BELOW 1"

LEFT - Q PAV'T. - RIGHT 11.0


2.0 R+TO Rt EDGE PAVEMENT

S.L.M. 424+53

Set Sm RR Spk
6-27-86
MOB

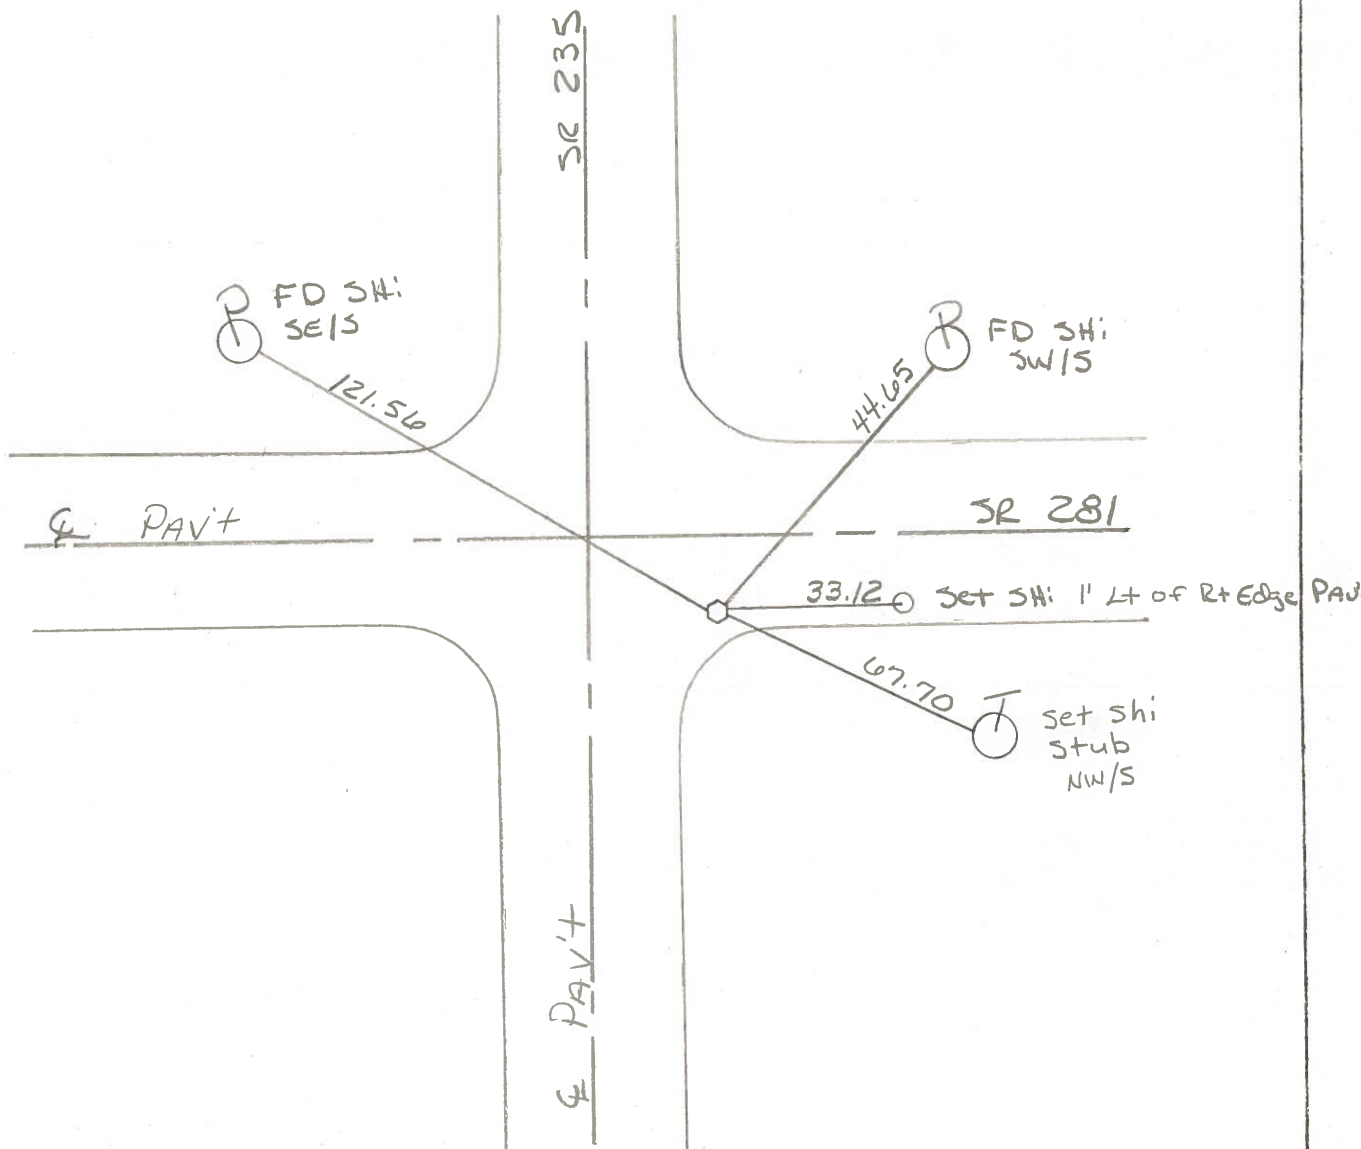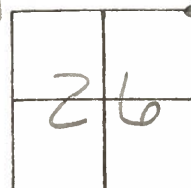

PERSONNEL	TITLE	PERSONNEL	TITLE	COUNTY	DATE	WEATHER	TEMP.
BURNSIDE				WOOD	1-5-76	CLEAR	+15°
SMITH				S. R. 235 & S.R. 281			
BOWERS				SEC. N.E. COR. SEC. 26			
MEAD				(SECTION CORNERS)			
DESCRIPTION: $\neq$ CONTROL TIES				JOB NO.			
LEFT		CENTER LINE		RIGHT			

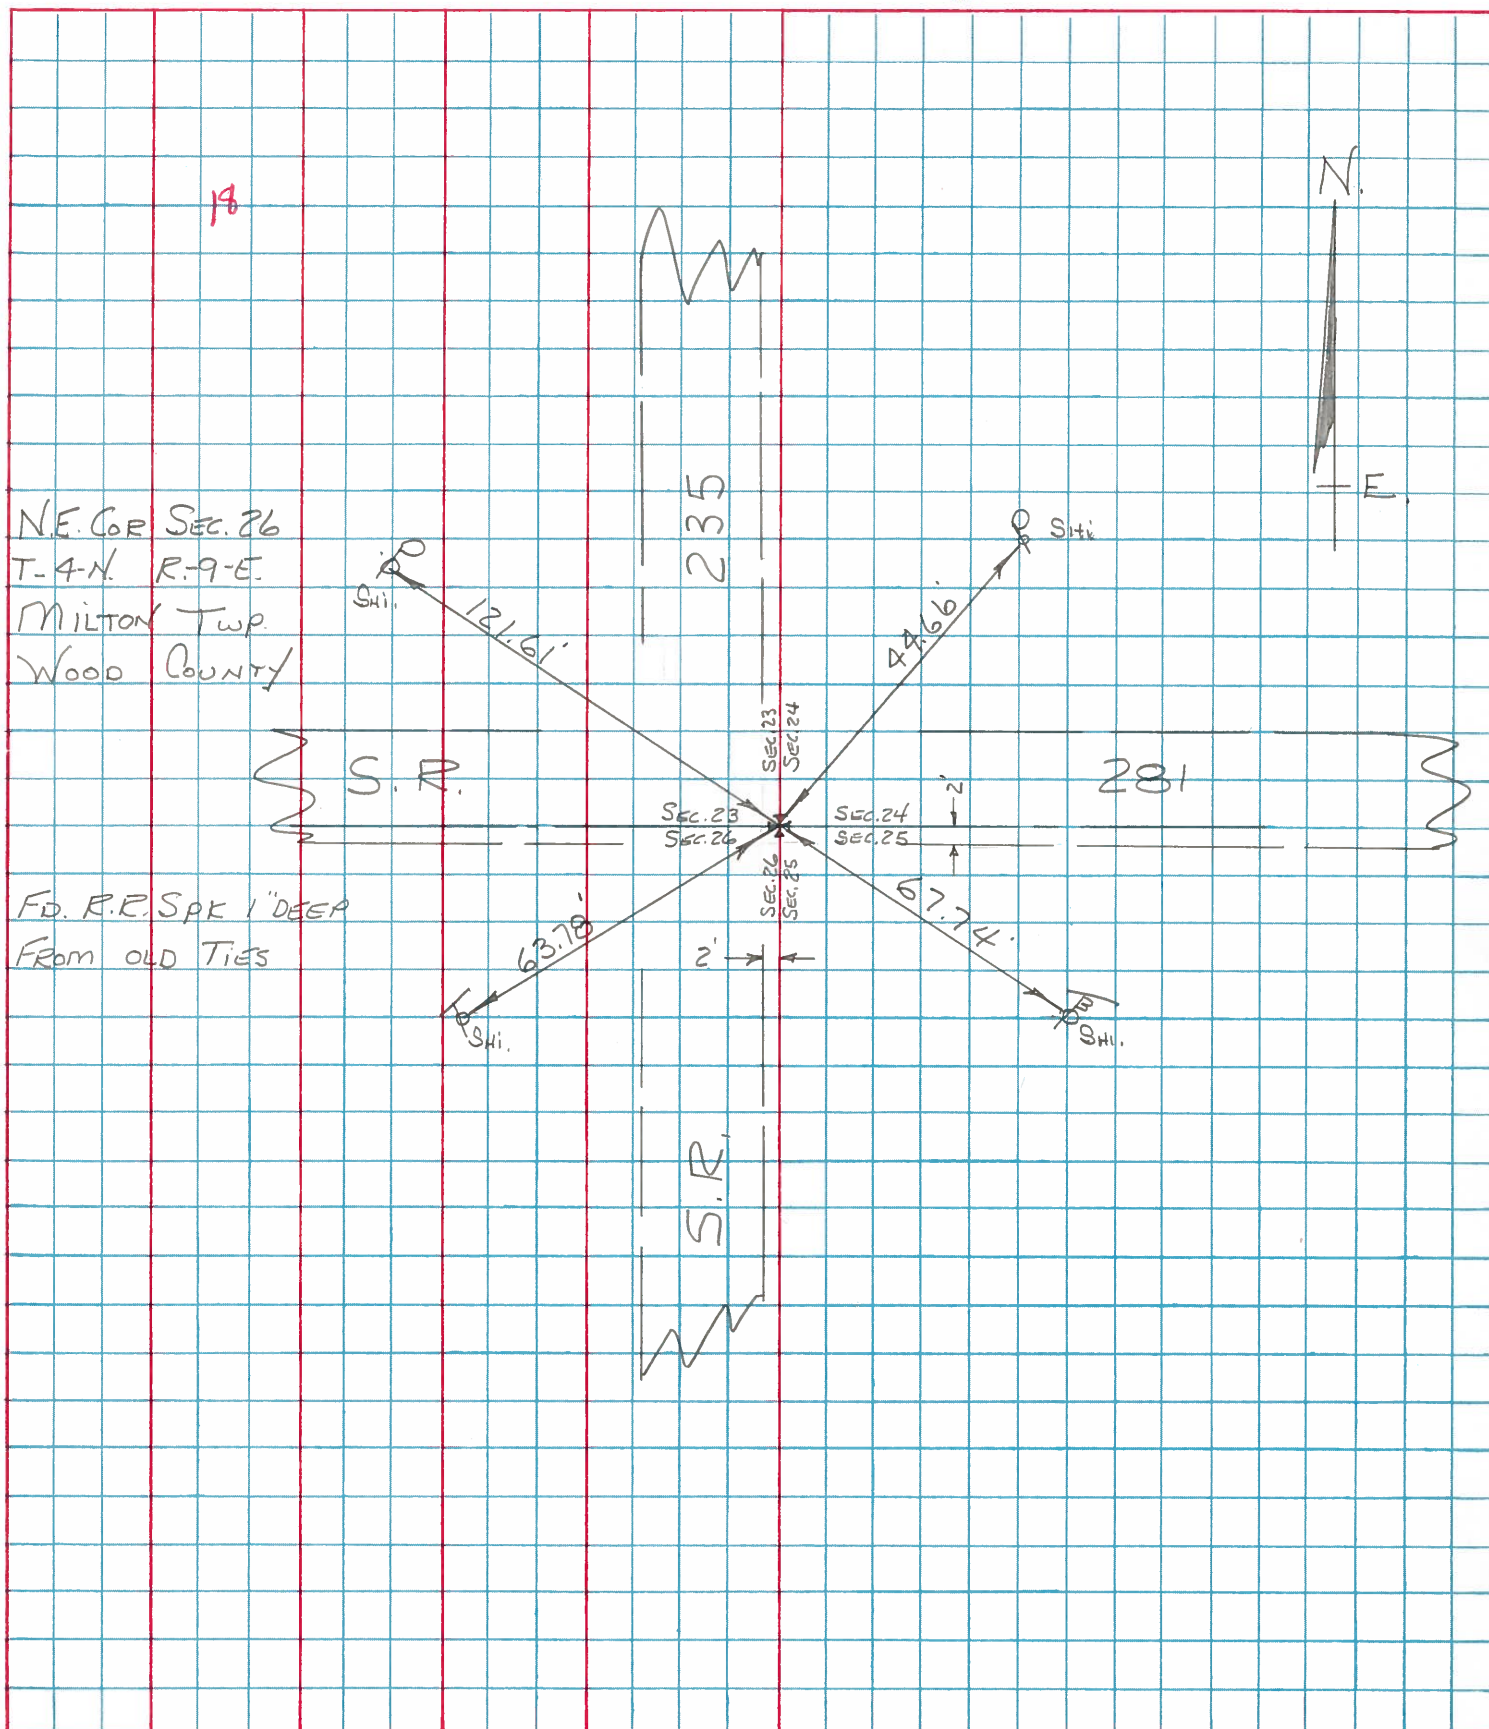

PERSONNEL TITLE PERSONNEL TITLE
 SILVESTER COUNTY Wood DATE 7-69
 S. R. 235 WEATHER
 SEC. TEMP.

DESCRIPTION LEFT CENTER LINE RIGHT JOB NO.

#73 N.W. Cor. Sec 36 Milton Twp Stone 1' below Surface Set P.P. Spk. Days Rd.	#16			Shiner in T. Pole SE, 46.37 Ditch Marked (beaming) S.E. 42.75 SE. Cor. E. Abut. SE, 40.60 W. Cor. W " SW, 28.40 Shiner in P. Pole NW, 34.80 " " " " NNW, 78.59 " " " " N, NE, 103.92	#74 W. 1/4 Post Sec 25 Milton Twp P.P. Spk on a line N.W. & S.W. Cor. Posts 10' W. of E. edge of Pavmt. found Iron Pipe on E. Edge of Pavmt. Set P.P. Spk. 5' below Surface 1' W. of E. Edge Pavmt. #17 T. Pole S.W. 46.20 Conc. Mon NE, 23.63 " " S. of E. 18.66 Shiner in P. Pole S.S.E. 109.30 #18 N.E. to Shiner in P. Pole 44.65 S.W. " " " T. " 59.70 S.S.W. " " " " 64.41 SE, " " " " 67.75
#75 S.E. Cor Sec. 23 Milton Twp Stone P.P. Spk. S.R. 281.	#18				

PERSONNEL TITLE PERSONNEL TITLE

COUNTY Wood.DATE MARCH 26 1968S. R. # 69WEATHER Cloudy Showers.

SEC. _____

TEMP. +45°

DESCRIPTION

Ties to Control Points

JOB NO. _____


LEFT

CENTER LINE

RIGHT


W 1/4 Post. Sec. #25
 Milton Twp.
 T4N-R9E.

17

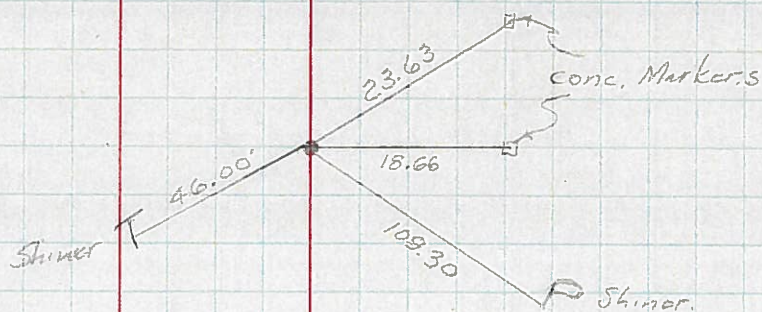

N.W. Cor. Sec. #25
 Milton Twp.
 T4N-R9E.

18

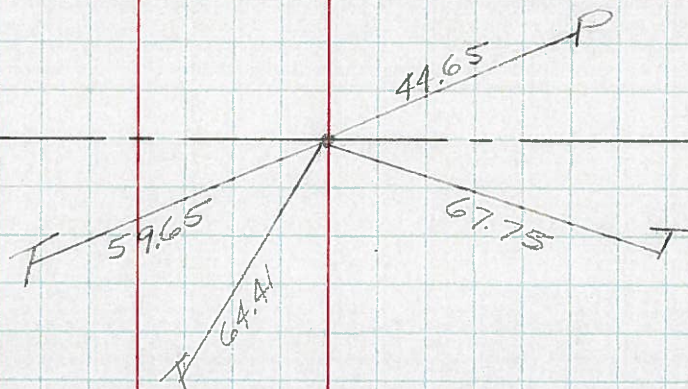

SR#281

PERSONNEL	TITLE	PERSONNEL	TITLE

COUNTY Wood DATE OK 12-13-57
 S. R. #69 WEATHER 4-14-60
 SEC. _____ TEMP. 1-13-66

DESCRIPTION _____ LEFT _____ CENTER LINE _____ RIGHT _____ JOB NO. _____

W. 1/4 part sec. 36 Milton
 Twp. Stone
 Did not find ✓
 #72 15

SET SMALL SPK.
 7-28-69

SHI. T. Pole E 21.02
 Stone E. 30.0
 Stone W. 30.0
 SHI. P. Pole SW. 43.30
 SHI. WILD CHERRY E 54.70

N.W. Cor. sec. 36 Milton
 Twp. Stone 10' below
 surface of pavement.
 Set R.R. spike Boys Rd.

SET R.R. SPK.
 7-28-69

✓ Shi. in T. Pole S.E. 46.37
 ✓ Ditch marker leaning S.E. 42.75
 ✓ S.E. Cor. E. about, S.E. 40.50
 ✓ W. Cor. W. about, S.W. 28.35
 ✓ Shiner in P.P. N.W. 34.80
~~Iron pipe stake N.E. 60.00~~
 ✓ Shi. P.P. N.N.W. 78.5
 SHI. P. Pole N.N.E. 103.92

#73 16

W. 1/4 part sec. 25.
 E. R. spike on line N.W. 1/4
 S.W. Cor. part 10' W. of E.
 edge of part. Fd. Iron pipe
 on E. edge of part.
 Fd. R.R. Spk. 5" below surface 1' W. of E.
 edge of part.

SET R.R. SPK.
 7-28-69

~~Fence post E. 20.09~~
~~Structure post E. 20.25~~
~~Shiner post W. S. 60.00~~
 ✓ T. Pole S.W. 46.20
 ✓ Conc. mon. N.E. 23.43
 ✓ Conc. mon. Spt E. 13.66
 ✓ Shi. P. Pole S.S.E. 109.30

#74 17

S.E. Cor. sec. 23 Milton
 Twp. Stone S.R. #281
 ✓ R.R. Spk.

TIES OK
 7-28-69

✓ N.E. to shiner in P.P. 44.62
 ✓ W.N.W. to shiner in P.P. 121.54
 ✓ S.W. to shiner in T.P. 59.10
 ✓ S.S.W. to shiner in T.P. 64.41
 ✓ S.E. to shiner in T.P. 67.72

#75 18

W. 1/4 of S.W. 1/4 sec. 24
 Fd. Stone in W. bank of Deb.
 Fd. Stone ✓

ties
 7-28-69

✓ Shiner in P.P. E. 33.80
 ✓ Shiner in T.P. W. 55.75

#75-A 18-A

PERSONNEL	TITLE	PERSONNEL	TITLE	COUNTY	DATE	WEATHER	TEMP.
				Wood	4-17-60	4-14-60	
				S. R. #69		1-18-56	
				SEC.			
DESCRIPTION	LEFT	CENTER LINE	RIGHT	JOB NO.			

W. 1/4 post sec. 36 Milton
Twp. Stone

Did not find ✓ Found
#72 15

N.W. Cor. sec. 36 Milton
Twp. Stone 10' below
surface of pavement.
Set R.R. spike Boys Rd.

#73 16

W. 1/4 post sec. 25.
R.R. option line N.W. 1/4
S.W. Cor. posts 10' W. of E.
edge of post. Fd. iron pipe
on E. edge of post.
Fd. R.R. Spk. 5" below surface 1' W. of E.
edge post.

#74 17

S.E. Cor. sec. 23 Milton
Twp. Stone. S.E. #281
✓ R.R. spk.

#75 18

W. 1/4 of S.W. 1/4 sec. 24
Fd. stone in W. bank of Dec.
Fd. Stone ✓

#75-A 18-A

Shiner T Pole E 21.02
✓ Stone E. 30.0
✓ Stone W. 30.0

Shiner P Pole S.W. 43.30
Shiner W. chert E. 54.70

✓ Shi. in T. Pole S.E. 46.37
✓ Ditch marker leaning S.E. 42.75 42.75
✓ S.E. Cor. E. abut. S.E. 40.60 40.45
✓ W. Cor. W. abut. S.W. 20.40 21.20
✓ Shiner in P.P. N.W. 34.80 36.76
Iron sign stake N.E. 60.0 32.82
✓ Shi. P.P. N.N.W. 78.5
" " N.N.E. 103.32

~~Fence Post E. 20.65~~

~~Anchor post E. 30.55~~

~~Brusher post W. Sec. 20.72~~

✓ T. Pole S.W. 46.20

✓ Conc. mon. N.E. 23.63 23.75

✓ Conc. mon. Spt E. 18.66 18.73

✓ Shi. P. Pole S.S.E. 109.30

✓ N.E. to shiner in P.P. 44.6

✓ W.N.W. to shiner in P.P. 121.54

✓ S.W. to shiner in T.P. 59.70 59.65

✓ S.S.W. to shiner in T.P. 64.41

✓ S.E. to shiner in T.P. 67.72

High
Point

✓ Shiner in P.P. E. 33.80 34.0

✓ Shiner in T.P. W. 35.85 36.0