

O.D.O.T. DISTRICT 2 SURVEY OFFICE (USE ONLY)

PERSONNEL

REFERENCE NO. 20

SHEET 23 OF 26

NOTES NIESE
H.C. PRESTON-COLVIN
R.C. BLUNAUGH
BARRIERE

DATE 8-23-24
WEATHER CLEAR
TEMP. 60°F

ROUTE SR 235
COUNTY WOOD
TOWNSHIP MILTON
SECTION 23
T 4 N R 9 E

DWG BY PRESTON-COLVIN PID CHIPSEAL

TYPE MONUMENT MAG SPIKE

ON SURFACE - ~~BELOW~~ ON

OFFSET CL PAVEMENT 11.9' ~~LT~~ : RT

3.0' TO RT EDGE PAVEMENT

STATION: 478+63.62

HORIZ.DATUM: NAD83 (2011)


GEOID: 2018

GRID: NORTHING: 597385.9


EASTING: 1615179

LDP: NORTHING: 418737.5

EASTING: 126678.3

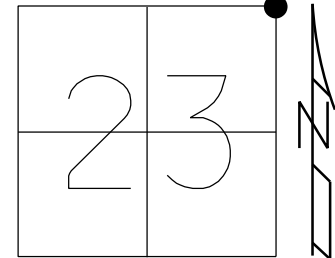

RECORD:
SET SM.R.R.SPIKE
6-27-86, MDB
SET P.K./WASHER
10-7-96, BVD
FD P.K./WASHER
2003
FD R.R.SPIKE
1" DOWN
REF24
10-23-14, EBW
FD P.K./WASHER
REF20
8-26-15, JFO
SET MAG/WASHER
NEWREF20
7-28-16, DCH
REF20
9/21/17, JFO
5/11/18, JFO
FR MAG SPIKE
REF20
8-23-24, TDN
FD MAG SPIKE
9-18-24, TDN

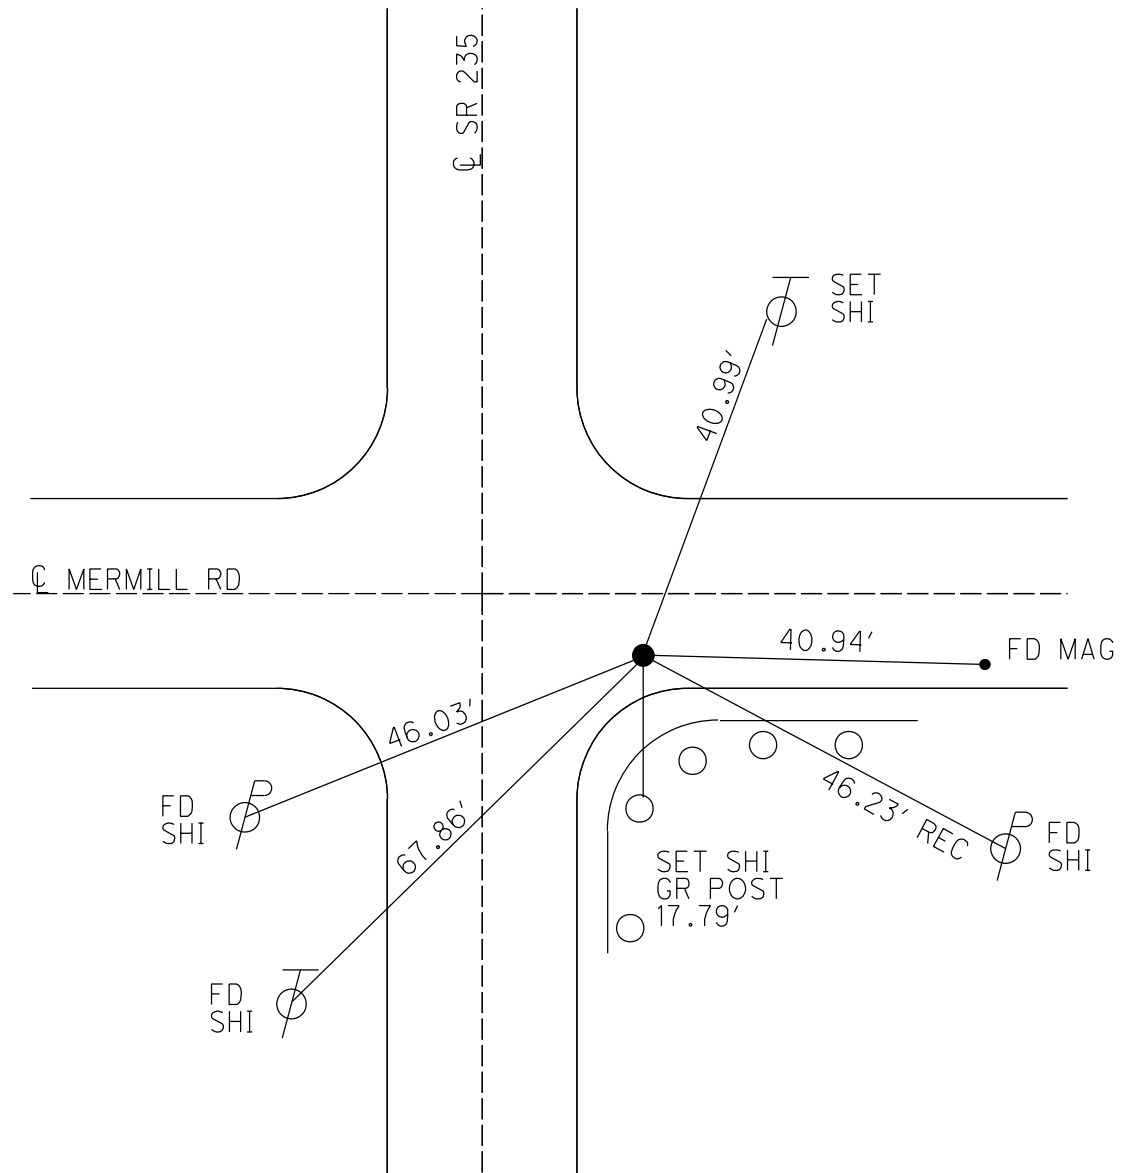

O.D.O.T. DISTRICT 2 SURVEY OFFICE (USE ONLY)

PERSONNEL

REFERENCE NO.

20

SHEET

23

OF 26

NOTES RHOADES

DATE 8-26-15

ROUTE SR 235

H.C. O'DONNELL

WEATHER CLOUDY

COUNTY WOOD

R.C. RHOADES

TEMP. 65°F

TOWNSHIP MILTON

SECTION 23

T 4 N R 9 E

TYPE MONUMENT P.K./WASHER


ON SURFACE - ~~BELOW~~ ON

~~LEFT -~~ Q PAV'T - RIGHT 11.9'


3.0' TO RT EDGE PAVEMENT

S.L.M. 478+63.62

Grid: Northing: 597385.990 Easting: 1615179.270

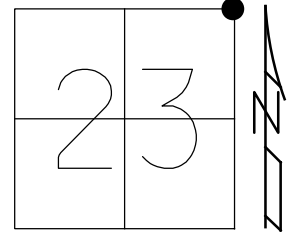

RECORD:
SET SM.R.R.SPIKE
6-27-86, MDB
SET P.K./WASHER
10-7-96, BVD
FD P.K./WASHER
2003
FD R.R.SPIKE
1" DOWN
REF24
10-23-14, EBW
FD P.K./WASHER
REF20
8-26-15, JFO
SET MAG/WASHER
NEWREF20
7-28-16, DCH
REF20
9/21/17, JFO
5/11/18, JFO

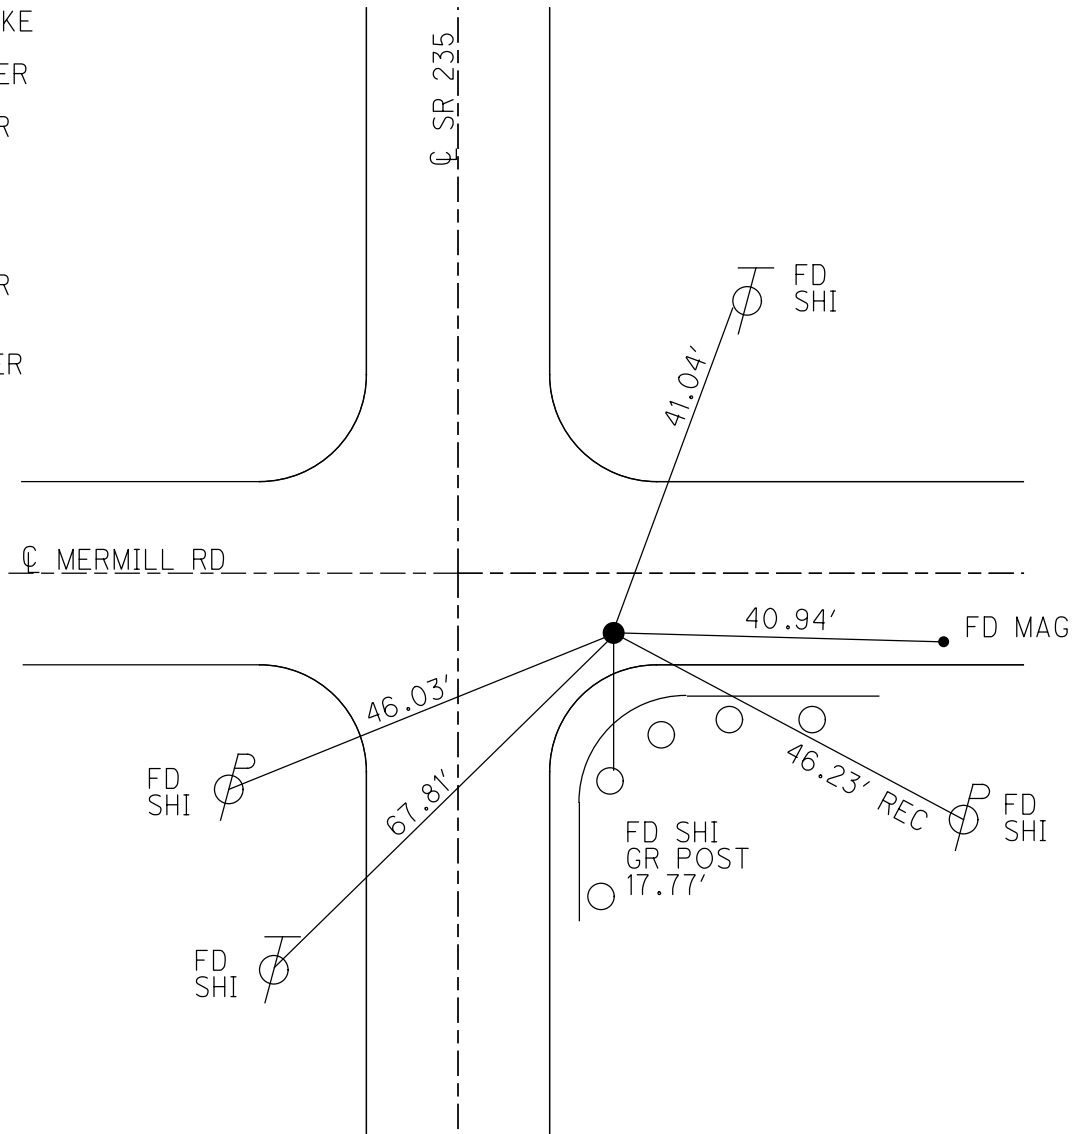

O.D.O.T. DISTRICT 2 SURVEY OFFICE (USE ONLY)

PERSONNEL

REFERENCE NO. 20

SHEET 23 OF 26

NOTES RHOADES

DATE 8-26-15

ROUTE SR 235

H.C. O'DONNELL

WEATHER CLOUDY

COUNTY WOOD

R.C. RHOADES

TEMP. 65°F

TOWNSHIP MILTON

SECTION 23

T 4 N R 9 E

TYPE MONUMENT PK/WASHER


ON SURFACE - ~~BELOW~~ ON

~~LEFT~~ - CL PAV'T - RIGHT 11.9'

3.0' TO RT EDGE PAVEMENT

S.L.M. 478+63.62

Grid: Northing: 597386.0377 Easting: 1615179.3157

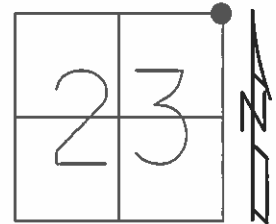

RECORD:
SET SM RR SPK
6-27-86, MDB


SET PK/WASHER
10-7-96, BVD

POINT NOT
DISTURBED 2003

FD RSPK
1" DOWN
GPS, REF24
10-23-14

GPS, REF20
8-26-15

SET MAG/WASHER
GPS, NEWREF20
7-28-16, DCH

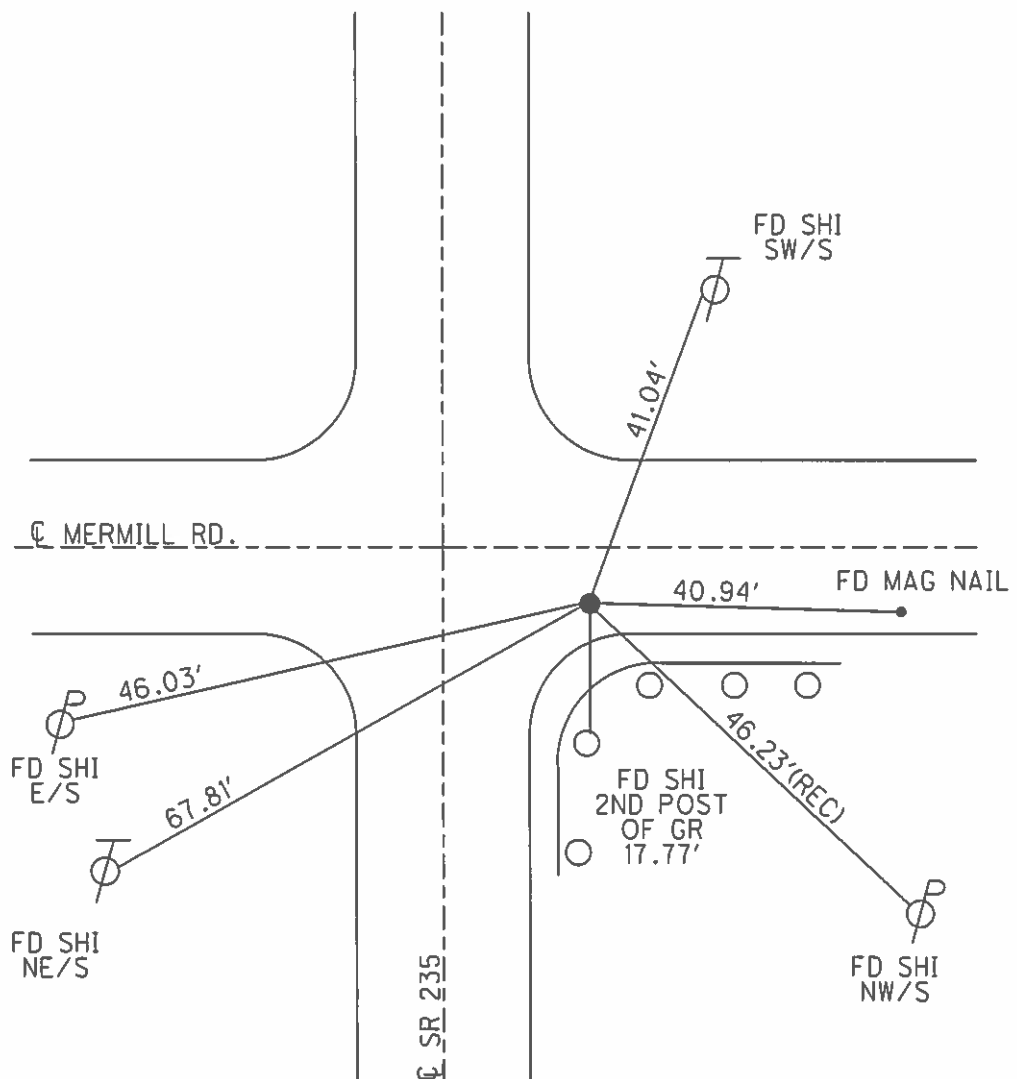

O.D.O.T. DISTRICT 2 SURVEY OFFICE

PERSONNEL

REFERENCE NO. 20


SHEET 20 OF 23

NOTES _____
 H.C. _____
 R.C. _____

DATE 9-25-03
 WEATHER Sunny
 TEMP. 60°

ROUTE 235
 COUNTY WOOD
 TOWNSHIP MILTON
 SECTION 23
T 4 N R 9 E


TYPE MONUMENT PK & Washer
 ON SURFACE - BELOW on surface
~~LEFT~~ - CL PAV'T - RIGHT 11.9'
3.0 TO RT EDGE PAVEMENT
 S.L.M. 477+69 (6.0" S of CL Mermill Rd)

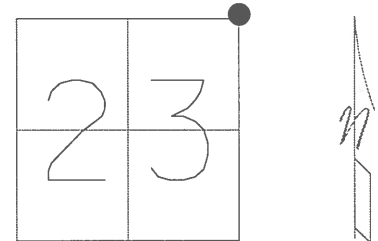

Set Sm RR Spk
 6-27-86
 MDB

Set PK & Washer
 10-7-96
BVD

Point not
 Disturbed 2003

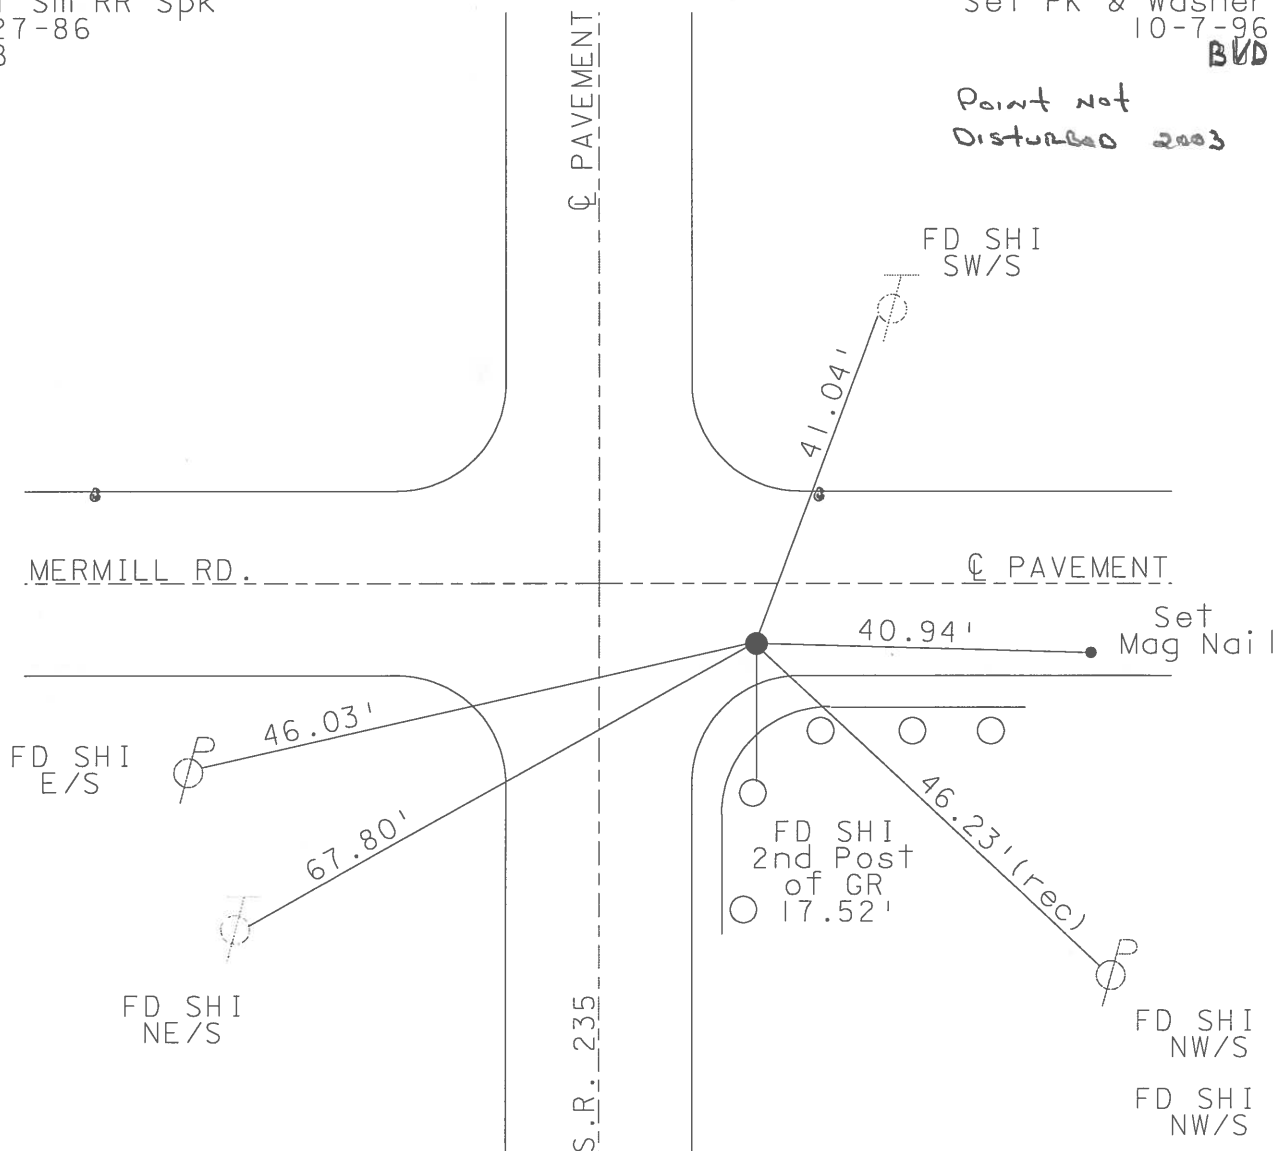

O.D.O.T. DISTRICT 2 SURVEY OFFICE

PERSONNEL

REFERENCE NO. 20

SHEET 19 OF 28

NOTES Van Dusen

H.C. Moser

R.C. Stiffler

DATE 7-30-96

WEATHER Cloudy

TEMP. +70°F

ROUTE 235

COUNTY Wood

TOWNSHIP Milton

SECTION 23

T 4 N R 9 E


TYPE MONUMENT Sm. RR Spk

ON SURFACE - ~~BELOW~~ on surface

~~LEFT~~ - E PAV'T. - RIGHT 11.9'

3.0 TO Rt. EDGE PAVEMENT

S.L.M. 2177 + 69 (6.0' S of E Mermill Rd.)

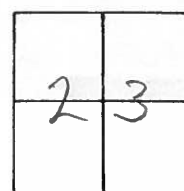

Set Sm. RR, Spk
6-27-86
M.D.B.

Set PK/Washen
10-7-96
B.D.D.

E Paut.
Mermill Rd.

Set Shi
E/S

Fd Shi
NE/S


Fd Shi
SW/S

2nd Post
G.R.

Set Shi
N/S

Fd Shi
NW/S

Rec. did
not check - High
Water

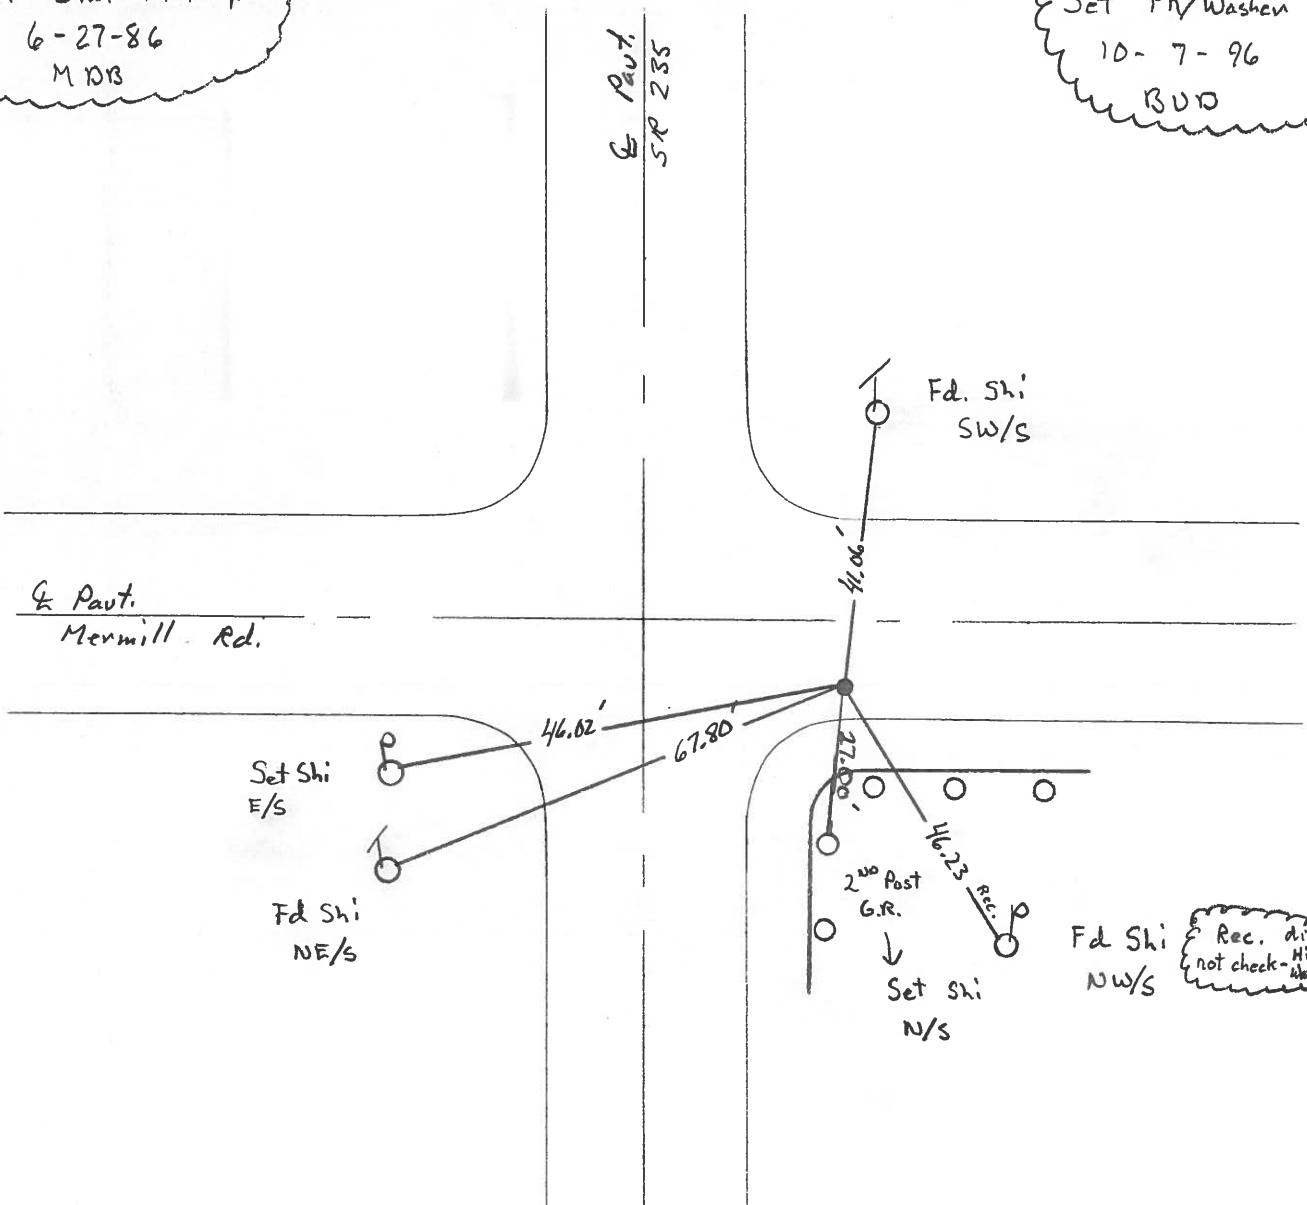

O.D.O.T. DISTRICT 2 SURVEY OFFICE

PERSONNEL

REFERENCE NO. 20

SHEET OF

NOTES BARNHSEW

H.C. Loehrke

R.C. HOFFMAN

DATE 6-9-86

WEATHER SUNNY

TEMP. + 65°

ROUTE 235

COUNTY WOOD

TOWNSHIP MILTON

SECTION 23

T 4 N R 9 E

TYPE MONUMENT Sm RR Spk


ON SURFACE - BELOW yes

LEFT - 0 PAV'T. - RIGHT 11.8


3.0 R+0 R+0 EDGE PAVEMENT

S.L.M. 477+75


Set Sm RR Spk
6-27-86
MOB

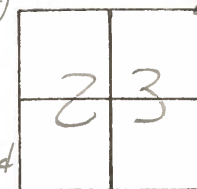

6.0' S of E. Mermill Rd

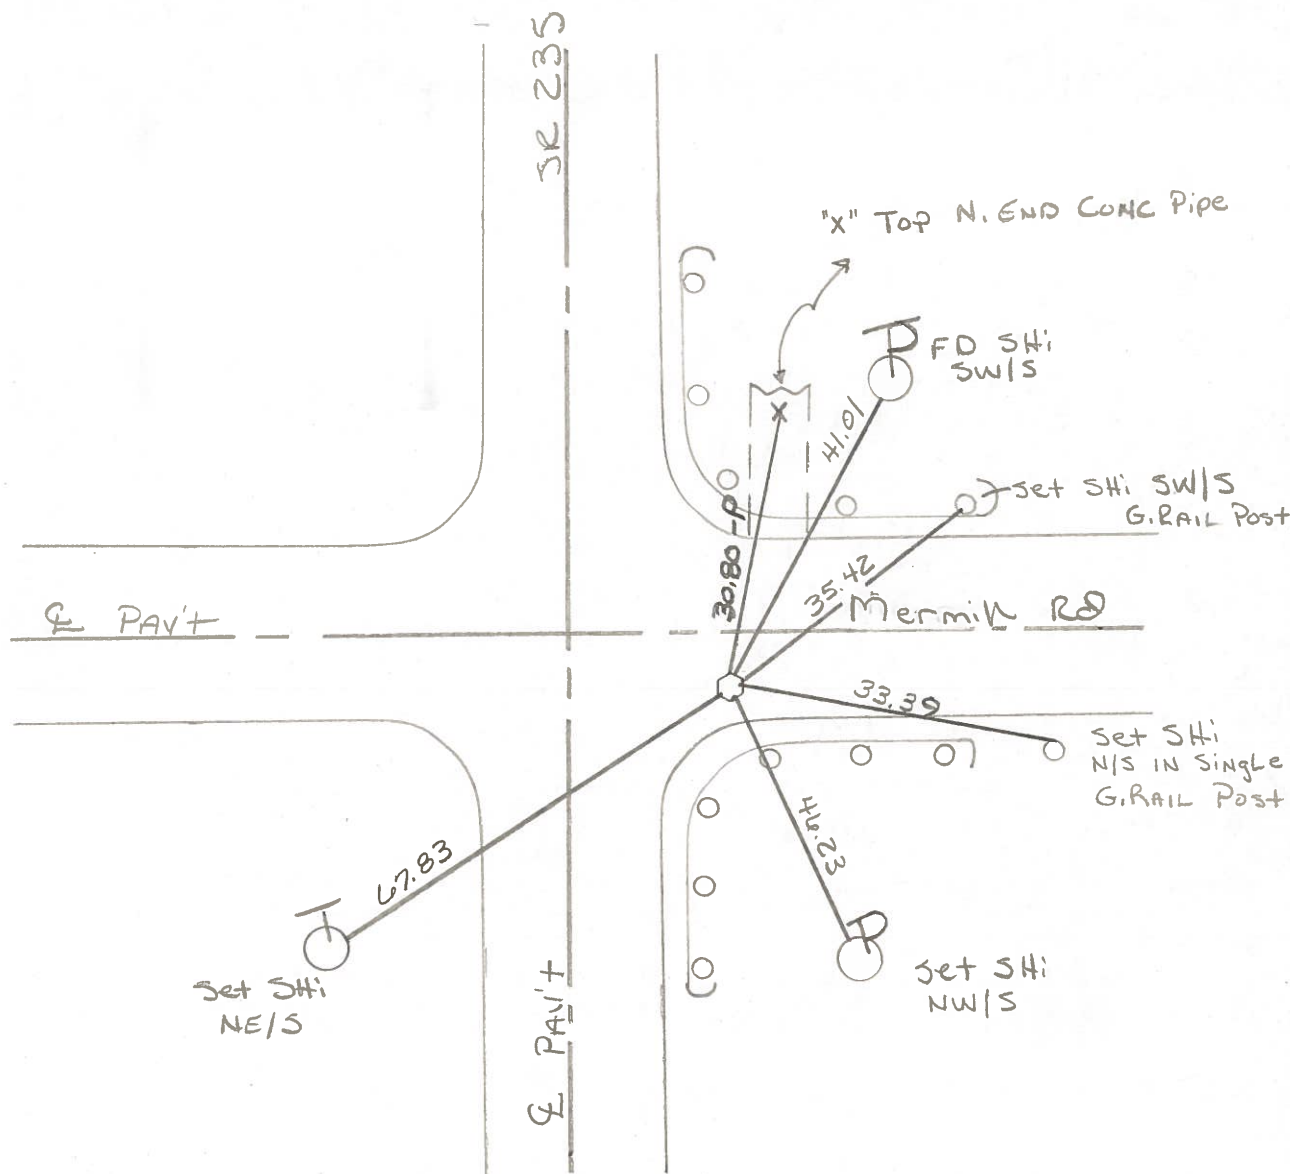

PERSONNEL	TITLE	PERSONNEL	TITLE	COUNTY	DATE
BURNSIDE				Wood	4-20-76
SMITH				S. R. 235	WEATHER Pt. Cloudy
BOWERS				SEC. MERMILL ROAD	TEMP. +60°
MEAD					
DESCRIPTION	REF. TO SECTION CORNERS			JOB NO.	
	LEFT	CENTER LINE	RIGHT		

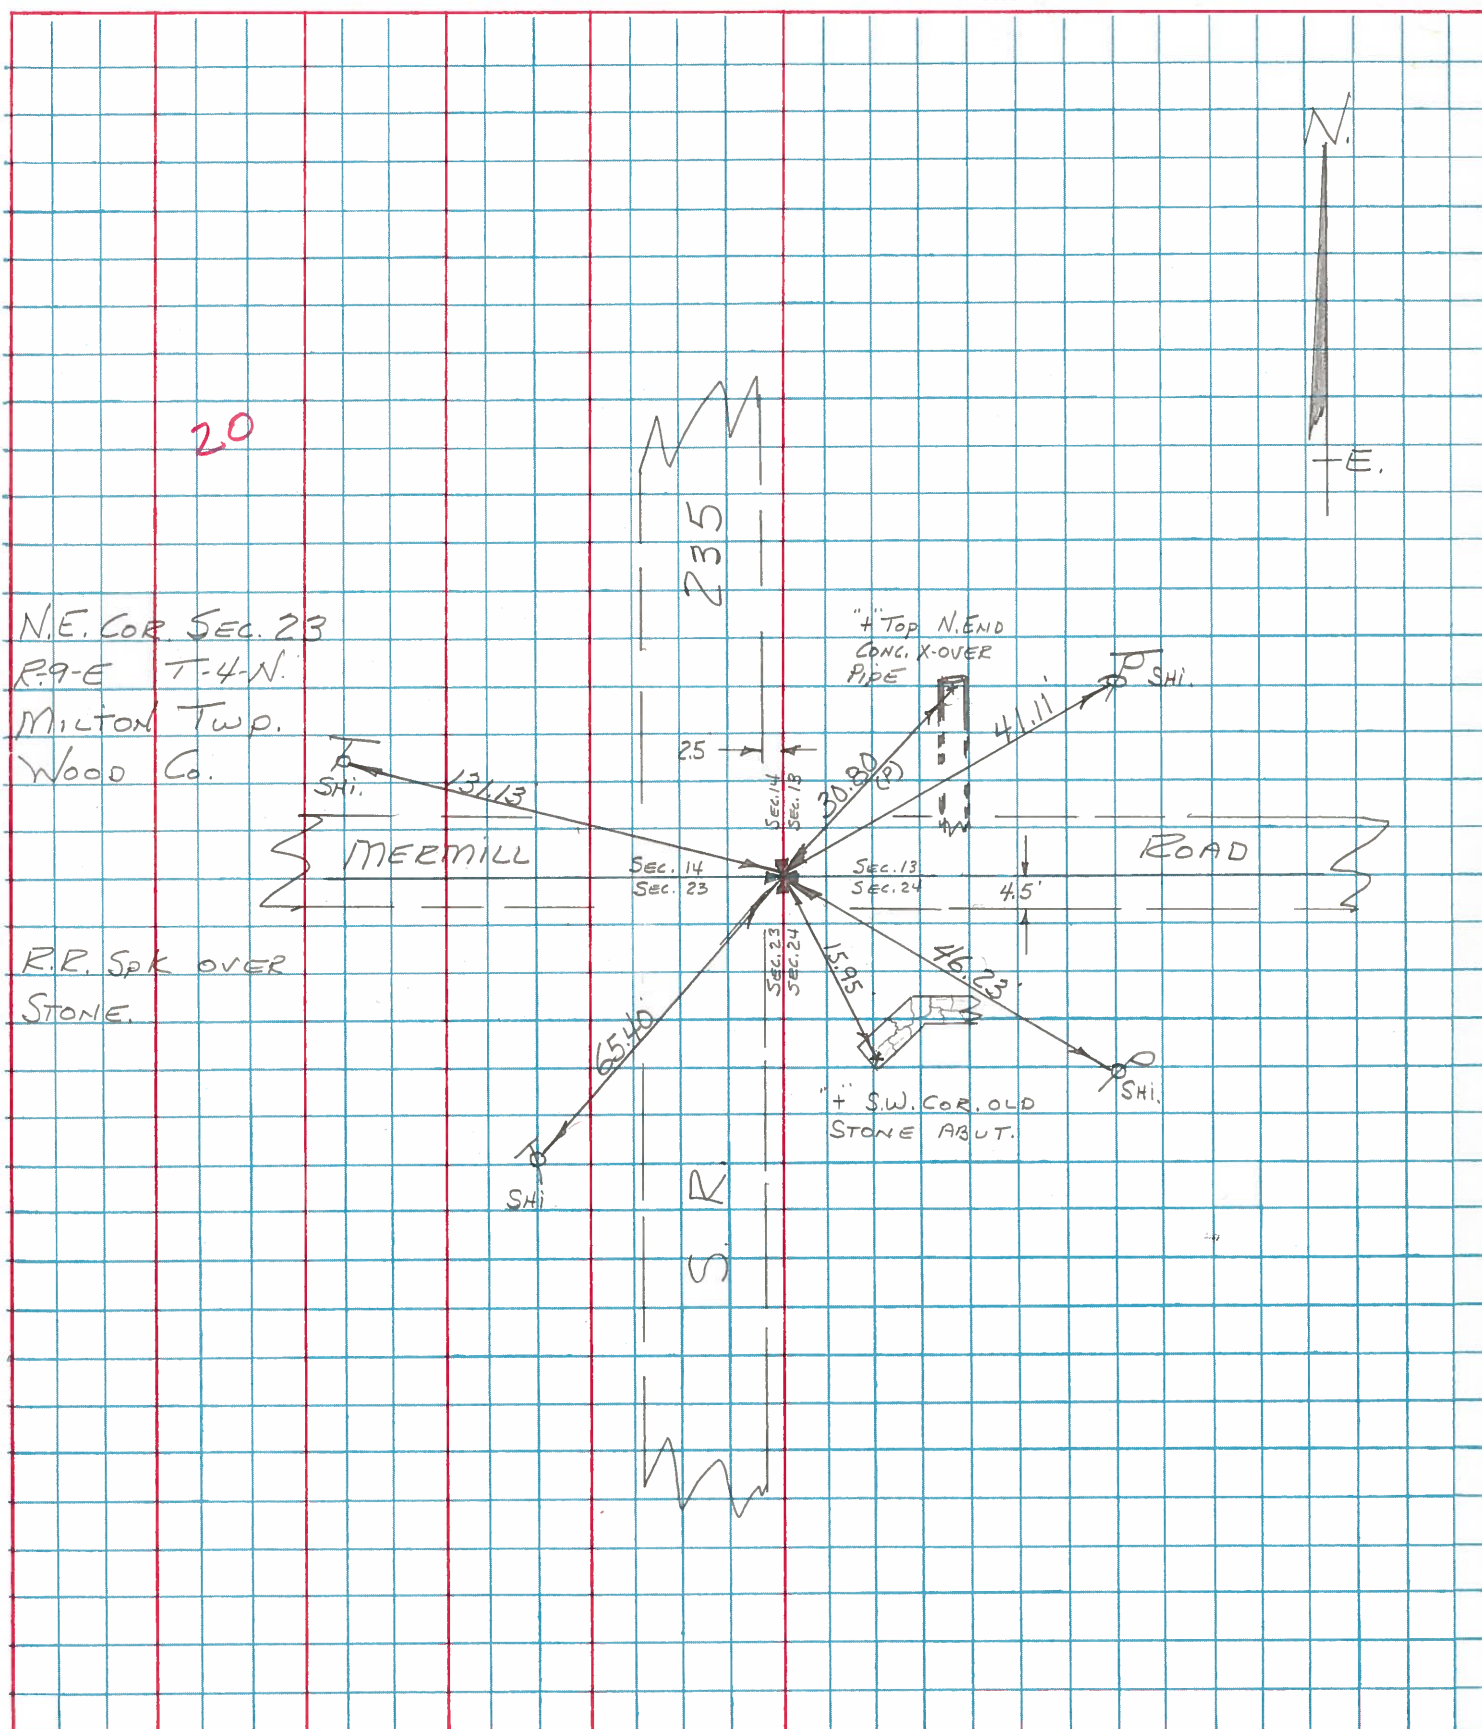

RE-COPIED
7-29-71

SHEET NO. _____

PERSONNEL

TITLE

PERSONNEL

TITLE

COUNTY WOOD

DATE _____

S. R. 235 (OLD S.R. 69) WEATHER _____

SEC. _____ TEMP. _____

DESCRIPTION

LEFT

CENTER LINE

RIGHT

JOB NO. _____

#76 #19

N.W. 1/4 SEC. 24. STONE 10.9' E
OF EDGE PAVE. & W. BANK DCH.

#76-A

SHINER IN END POST OF FENCE 37.13'
IRON PIPE W. 30.30'
T.P. N. of W. 69.35'

#20

N.W. COR. SEC. 24 MILTON
Twp.
MERMILL ROAD

#77

SHINER IN 24" MAPLE N.W. 57.00'
SHINER IN T. POLE S.W. 51.25'
SHINER IN T. POLE N.E. 35.80'
X' IN S.W. COR. S. ABUT. SE. (OLD) 15.93'

#78

#79

#21

E. 1/4 POST SEC. 14 MILTON
Twp. STONE 8' BELOW
SURFACE & 6' W. & E. EDGE PAVE.

#80

IRON ROD W. 30.25'
SHINER IN T. POLE N.N.E. 40.09'
SHINER IN T. POLE S.E. 35.66'

#22

N.E. COR. SEC. 14 MILTON
Twp.
STONE 0.6' DEEP R.R. SPK.
MAPLEWOOD ROAD

#81

N. COR. N.W. Wing of W. ABUT. S of W. 13.90'
N. COR. N.W. Wing of E. ABUT. S of E. 14.13'
SHINER IN T. POLE S.W. 35.03'
SHINER IN T. POLE S.E. 34.17'
SHINER IN T. POLE E. 61.34'

PERSONNEL	TITLE	PERSONNEL	TITLE

COUNTY Wood DATE Oct 12-13-57
 S. R. #69 WEATHER 4-15-60
 SEC. _____ TEMP. 1-20-66

DESCRIPTION _____ LEFT _____ CENTER LINE _____ RIGHT _____ JOB NO. _____

#76

N.W. 1/4 Sec. 24 Stone 10.9'E
 of edge, past. & W. bank dch. ✓

✓ Shiner in End Post of fence 37.13
 ✓ Iron pipe W. 30.30
 ✓ T.P. N of W. 69.35' 67.66'

#76-A

N.W. Cor. Sec. 24 Milton
 Twp. Merrill Ed.
 R.R. Spk. ✓

57.00
 ✓ Shiner in 24" maple NW. E.H.
 ✓ Shiner in T.P. S.W. 51.25
 ✓ Shiner in T.P. N.E. 35.80 35.75
 ✓ X in S.W. Cor of old S. about S.E. 15.95

#77 20

#78

#79

E 1/4 past Sec. 14 Milton
 Twp. Stone 8" below surface
 of past. 6' W. of E. Edge past.
 of pavement. R.R. Spk. ✓

25
 ✓ Shiner in T. Pole N.N.E. 113.52
 ✓ Shiner in P.P. N.W. 40.57 40.52
~~Shiner in Cor. past S. 27.93 27.44~~
~~Stone on E. bank of dch. E. gone 35.00~~
 ✓ Shiner in T.P. S.E. 35.66' 35.22
 67'

#80 21

N.E. Cor. Sec. 14 Milton Twp.
 Stone 0.6 deep R.R. Spk.
 Maple wood 23. ✓

13.95
 ✓ No. Cor. N. wing of W. about S of W. 15.5'
 ✓ No. Cor. N. wing of E. about S of E. 14.16'
~~Shiner in F.R. NW. Gone 45.45~~
 ✓ Shiner in P.P. S.W. 35.06' 33.40
 ✓ Shiner in T.P. S.E. Plum 34.17 34.22
 ✓ Shiner in T. Pole East 61.34'

#81

PERSONNEL	TITLE	PERSONNEL	TITLE

COUNTY Wood DATE OK 12-13-67
 S. R. #69 WEATHER 4-15-60
 SEC. _____ TEMP. _____

DESCRIPTION _____ LEFT _____ CENTER LINE _____ RIGHT _____ JOB NO. _____

#76

N.W. 1/4 Sec. 24, Stone 10.9'E
 of edge part. 4 W. bank dch. ✓

✓ Shiner in End Post of fence 57.13
 ✓ Iron pipe W. 33.30
 ✓ T.P. N.W. 69.35' 49.50

#76-A

N.W. Cor. Sec. 24 Milton
 Twp. Mermill Rd.
 R.R. Spk. ✓

#77

20

57.00
 ✓ Shiner in 24" maple NW. 57.00
 ✓ Shiner in T.P. SW. 54.25
 ✓ Shiner in T.P. NE 35.80 35.75
 ✓ X in S.W. cor of old S. abut. SE. 15.95

#78

#79

E 1/4 part Sec. 14 Milton
 Twp. Stone 8' below surface
 of part. 6' W. of E. Edge part.
 of pavement. R.R. Spk. ✓

#80

21

Iron Rod W. 30.25
 ✓ Shiner in T.Pole N.W. 113.05
 ✓ Shiner in P.P. N.W. 40.74 40.12
~~Shiner in Cor. part. 21.93 27.44~~
~~Stone on E. bank of dch. 5.60 25.05~~
 ✓ Shiner in T.P. S.E. 35.66' 35.72

N.E. cor. Sec. 14 Milton Twp. 13.90
 Stone 0.6 deep R.R. Spk. 14.13
 Maplewood Rd. ✓

#81

22

13.95
 ✓ N. cor. N.W. wing of Walnut Spk. 13.95
 ✓ N. cor. N.W. wing of E. abut. S.E. 14.13
~~Shiner in P.P. NW. 35.63~~
 35.63 ✓ Shiner in P.P. SW. 35.66' 35.72
 34.17 ✓ Shiner in T.P. S.E. 34.17 34.17
 61.34 ✓ Shiner in T.Pole East 61.34'

PERSONNEL	TITLE	PERSONNEL	TITLE

COUNTY Wood DATE OK 12-13-57
 S. R. #69 WEATHER 4-15-60
 SEC. _____ TEMP. 1-20-66

DESCRIPTION _____ LEFT _____ CENTER LINE _____ RIGHT _____ JOB NO. _____

#76

N.W. 1/4 sec. 24. Stone 10.9'E.
 of edge part. & W. bank dch. ✓

✓ Shiner in End Post of fence 37.13'
 ✓ Iron pipe W. 30.30'
 ✓ T.P. N of W. 69.35' 69.50'

#76-A

N.W. Cor. sec. 24 Milton
 Twp. Merrill Rd.
 R.R. Spk. ✓

57.00
 ✓ Shiner in 24" maple N.W. 57.16
 ✓ Shiner in T.P. S.W. 51.25
 ✓ Shiner in T.P. N.E. 35.80 35.75
 ✓ X in S.W. cor of old S. abut. S.E. 15.93

#77

20

#78

#79

E 1/4 past sec. 14 Milton
 Twp. Stone 8" below surface
 of part. 6' W. of E. Edge part.
 of pavement. R.R. Spk. ✓

✓ Shiner in T. Pole N.W.E. 113.05
 ✓ Shiner in P.P. N.W. 40.07 40.02
~~Shiner in Cor. past W. 27.93 27.84~~
~~Stone on E. bank of dch. E. gone 25.53~~
 ✓ Shiner in T.P. S.E. 35.66' 35.82

#80

21

N.E. cor. Sec. 14 Milton Twp.
 Stone 0.6' deep R.R. Spk.
 Maplewood Rd. ✓

13.95'
 ✓ N. cor. N. wing of W. abut Spt W. 15.0'
 ✓ N. cor. N. wing of E. abut S of E. 14.16' 15.1'
~~Shiner in P.P. N.W. Gone 42.55~~
 ✓ Shiner in P.P. S.W. 35.06' 32.40
 ✓ Shiner in T.P. S.E. Plumb 34.17 34.39
 ✓ Shiner in T. Pole East 61.34'

22

#81