

O.D.O.T. DISTRICT 2 SURVEY OFFICE (USE ONLY)

PERSONNEL

REFERENCE NO. 22

SHEET 25 OF 26

NOTES NIESE
H.C. PRESTON-COLVIN
R.C. BLUNAUGH
BARRIERE

DATE 8-23-24
WEATHER CLEAR
TEMP. 60°F

ROUTE SR 235
COUNTY WOOD
TOWNSHIP MILTON
SECTION 14
T 4 N R 9 E

DWG BY PRESTON-COLVIN PID CHIPSEAL

TYPE MONUMENT MONBOX

ON SURFACE - ~~BELOW~~ ON

OFFSET Q PAVEMENT 0.5" ~~LT~~ : RT

8.1' TO RT EDGE PAVEMENT

STATION: 531+78.20

HORIZ.DATUM: NAD83 (2011)


GEOID: 2018

GRID: NORTHING: 602699.9

EASTING: 1615258

LDP: NORTHING: 424052.6

EASTING: 126696.2

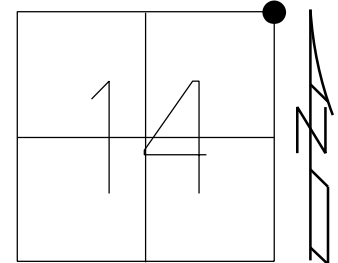

RECORD:
SET SM RR SPK
6-27-86, MDB

SET MAG/WASHER
10-10-03, DCH


NOT COVERED
08-05-04, MCB

FD MON BOX
IPIN INSIDE
10-23-14

GPS, REF22
8-26-15

FD MONBOX
W/ 5/8" IPIN
8-23-27.TDN

FD MONBOX
9-18-24,TDN

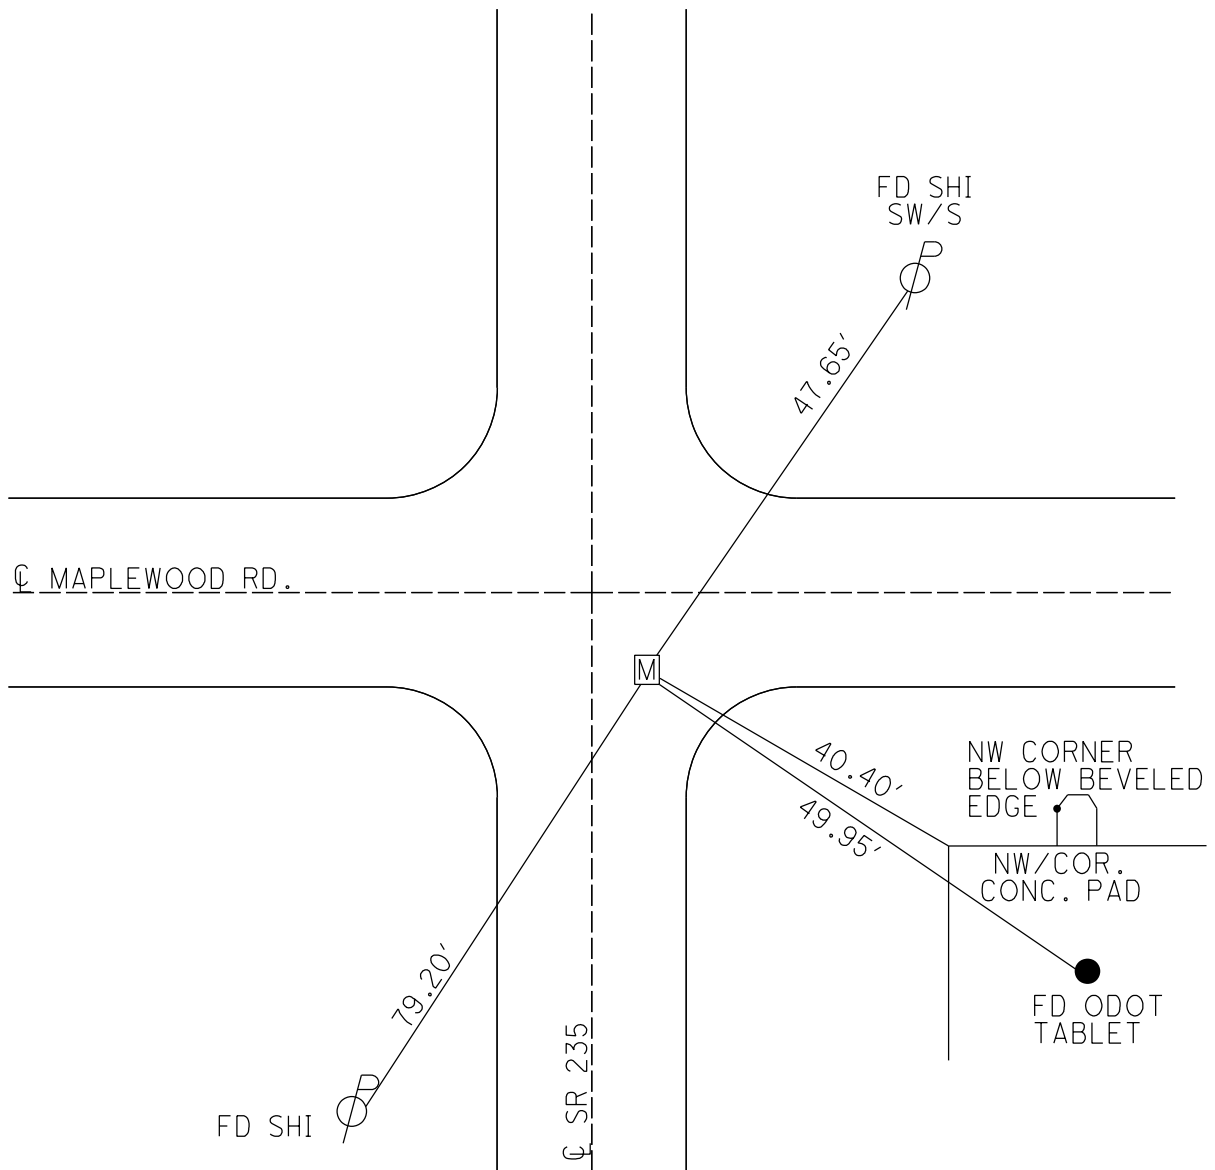

O.D.O.T. DISTRICT 2 SURVEY OFFICE (USE ONLY)

PERSONNEL

REFERENCE NO. 22

SHEET 25 OF 26

NOTES RHOADES

DATE 8-26-15

ROUTE SR 235

H.C. O'DONNELL

WEATHER CLOUDY

COUNTY WOOD

R.C. RHOADES

TEMP. 65°F

TOWNSHIP MILTON

SECTION 14

T 4 N R 9 E

TYPE MONUMENT MONBOX W/5/8" IPIN


ON SURFACE - ~~BELOW~~ ON

~~LEFT~~ - CL PAV'T - RIGHT 0.5'

8.1' TO RT EDGE PAVEMENT

S.L.M. 531+78.20

Grid: Northing: 602699.9519 Easting: 1615258.2721

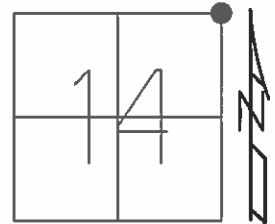


RECORD:
SET SM RR SPK
6-27-86, MDB

SET MAG/WASHER
10-10-03, DCH

NOT COVERED
08-05-04, MCB

FD MON BOX
IPIN INSIDE
10-23-14

GPS, REF22
8-26-15

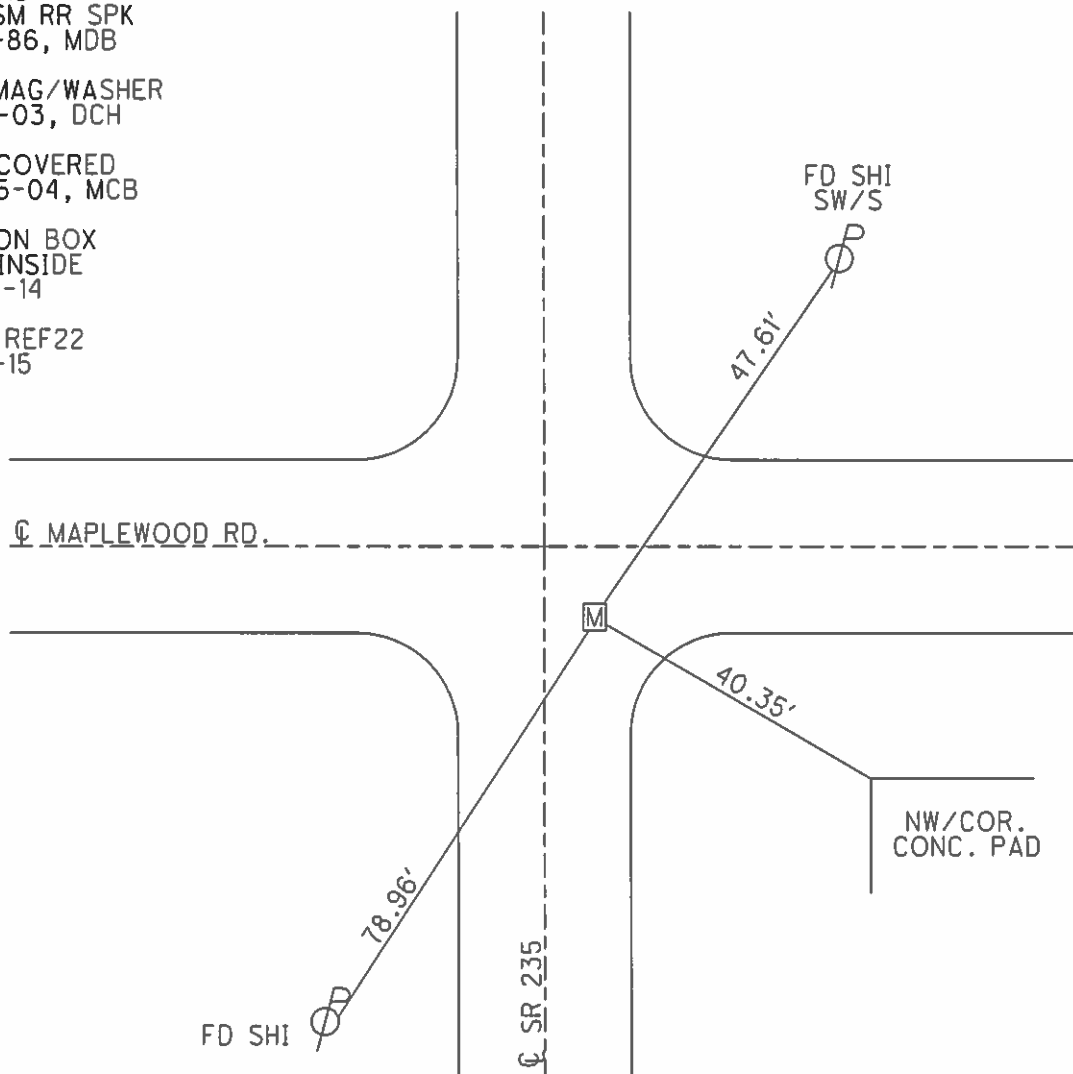

O.D.O.T. DISTRICT 2 SURVEY OFFICE

PERSONNEL

REFERENCE NO. 22

SHEET 1 OF 8

NOTES Homan

DATE 5-24-04

ROUTE 235

H.C. Nuhfer

WEATHER SUNNY/WINDY

COUNTY WOOD

R.C. ADKINS

TEMP. 60°

TOWNSHIP MILTON

SECTION 14

T 4 N R 9 E


TYPE MONUMENT PK & Washer

ON SURFACE - BELOW on surface

~~LEFT - C PAVT - RIGHT~~ 1'

8.1 TO RT EDGE PAVEMENT


S.L.M. 530+91 (12' S of Maplewood Rd E)

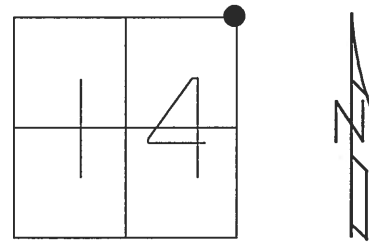

Record:
Set Sm RR Spk
6-27-86
MDB

Set Mag & Washer
10-10-03
DCH

NOT COVERED
08-05-04 MCB

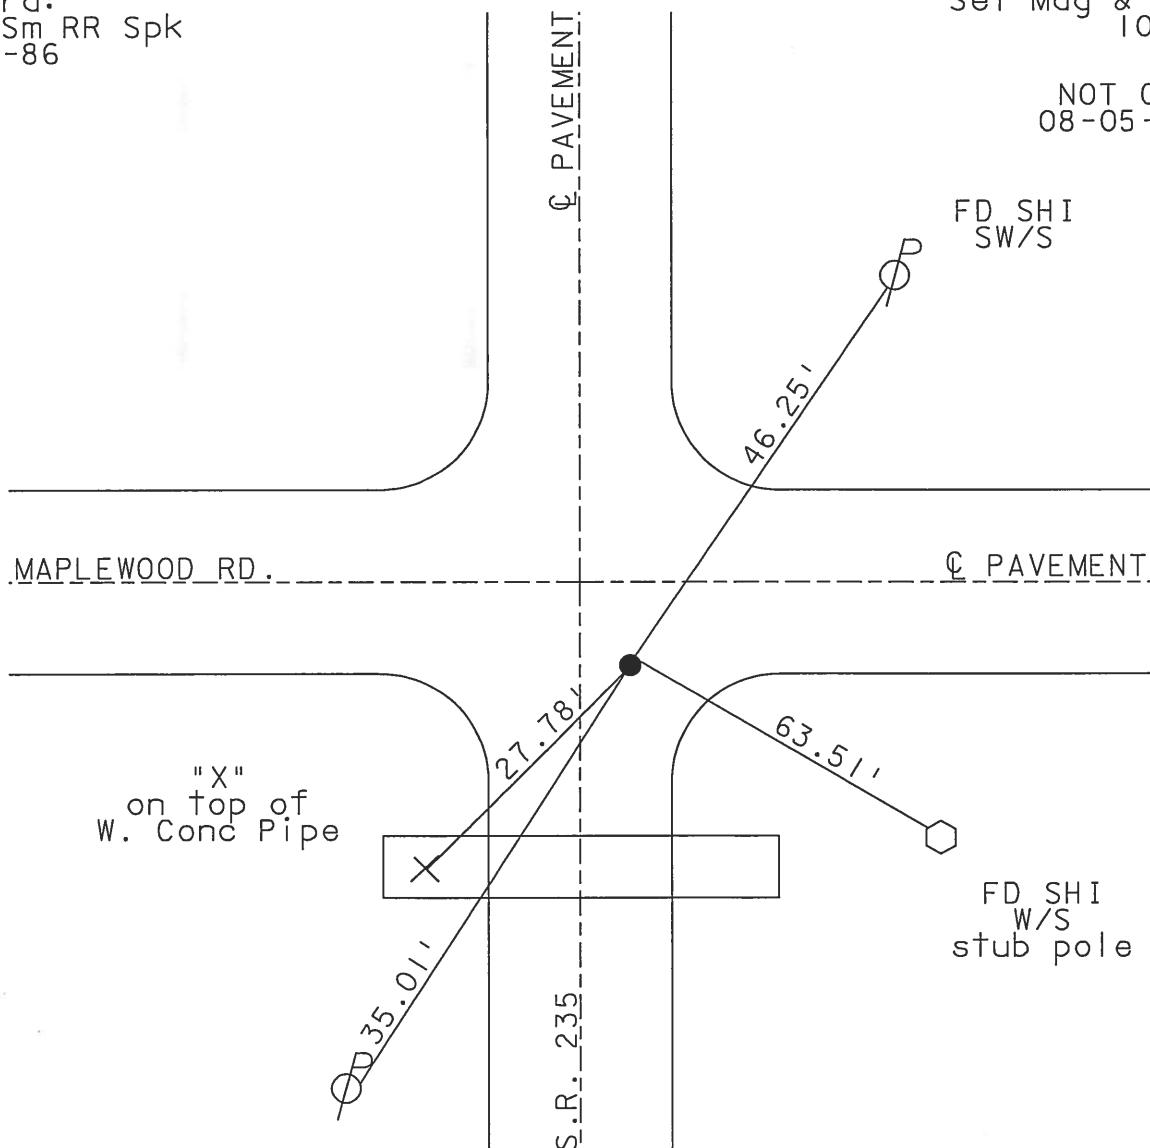

O.D.O.T. DISTRICT 2 SURVEY OFFICE

PERSONNEL

REFERENCE NO. 22

SHEET 22 OF 23

NOTES Homan

DATE 9-25-03

ROUTE 235

H.C. Nuhfer

WEATHER SUNNY

COUNTY WOOD

R.C. Ballmer

TEMP. 60°

TOWNSHIP MILTON

SECTION 14

T 4 N R 9 E


TYPE MONUMENT PK & Washer

ON SURFACE - BELOW on surface

~~LEFT - C PAVT - RIGHT~~ 1'


8.1 TO RT EDGE PAVEMENT

S.L.M. 530+91 (12' S of Maplewood Rd E)

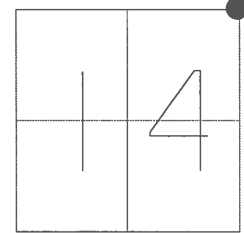

Set Sm RR Spk
6-27-86
MDB

Set Mag & Washer
10-10-03
DCH

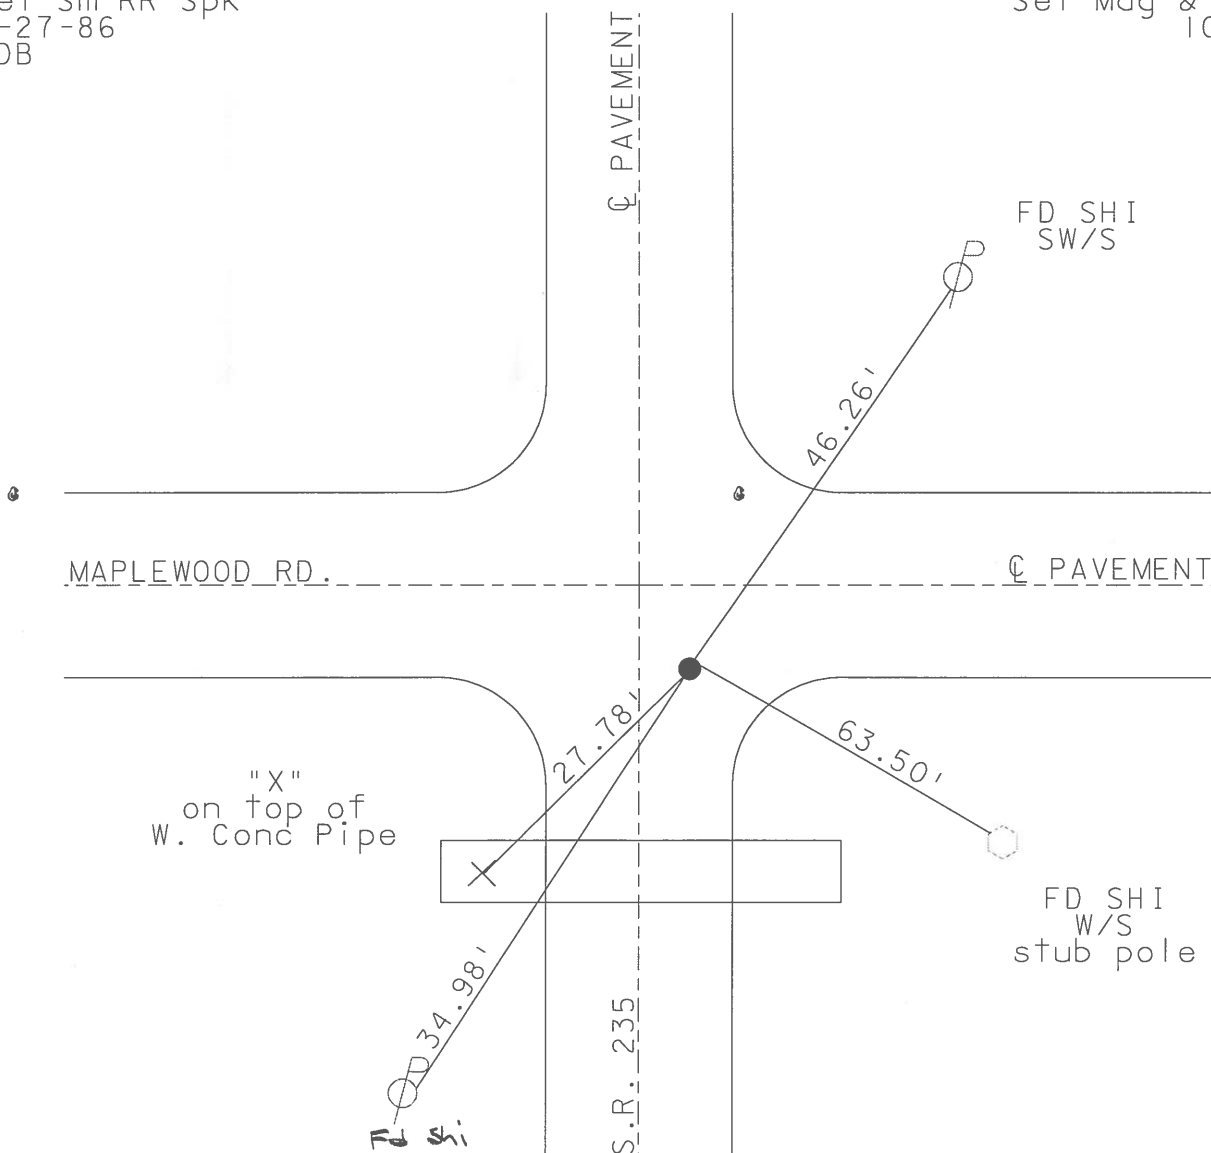

O.D.O.T. DISTRICT 2 SURVEY OFFICE

PERSONNEL

REFERENCE NO. 22

SHEET 21 OF 28

NOTES Van Dusen

H.C. Moser

R.C. Stiffler

DATE 7-30-96

WEATHER Sunny

TEMP. +65°

ROUTE 235

COUNTY Wood

TOWNSHIP Milton

SECTION 14

T 4 N R 9 E


TYPE MONUMENT Sm. RR Spk

ON SURFACE - ~~BELOW~~ on surface


LEFT- & PAW'T. - RIGHT

8.1 TO Rt EDGE PAVEMENT

S.L.M. 530+91 (12' S. of Maplewood Rd E.)

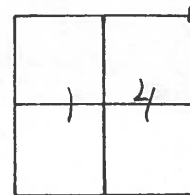

Set Sm. RR Spk
6-27-86
MVB

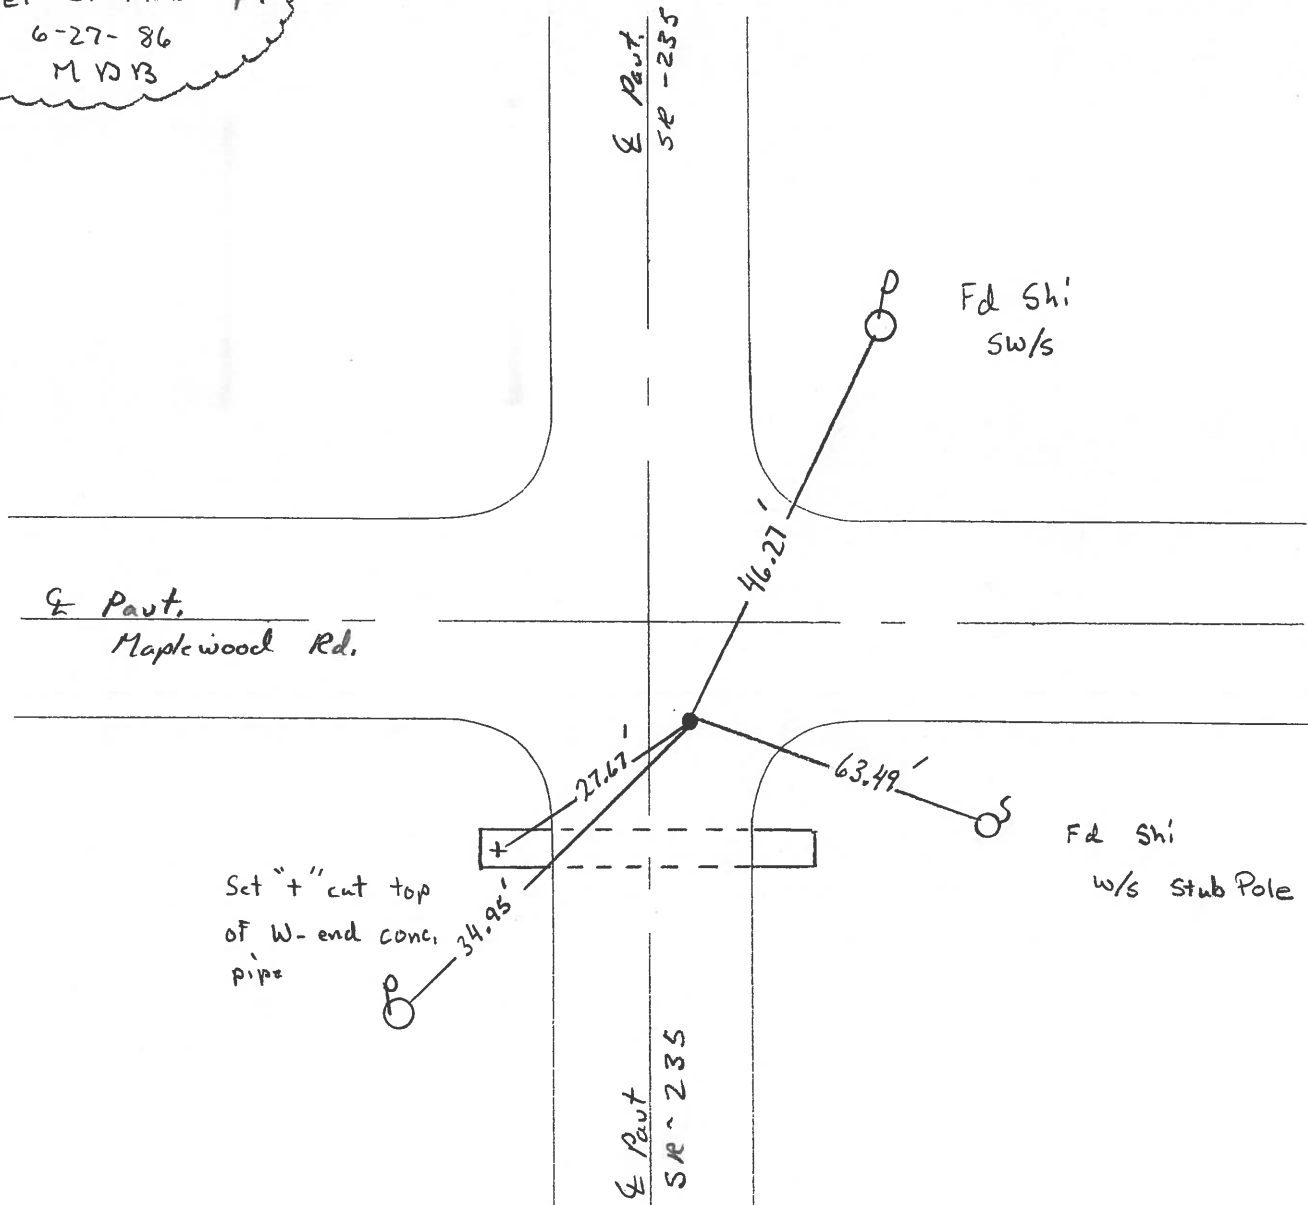

O.D.O.T. DISTRICT 2 SURVEY OFFICE

PERSONNEL

REFERENCE NO. 22

SHEET OF

NOTES BARNHISEL

H.C. Loehrke

R.C. HOFFMAN

DATE 6-9-86

WEATHER SUNNY

TEMP. +65°

ROUTE 235

COUNTY WOOD

TOWNSHIP MILTON

SECTION 14

T4 NR 9 E

TYPE MONUMENT Sm RR Spk

ON SURFACE - BELOW yes



LEFT - & PAV'T. - RIGHT 1.4

7.0 TO RT EDGE PAVEMENT

S.L.M. 531+00


12' S of Maplewood Rd E.

Set Sm RR Spk
6-27-86
MDOB

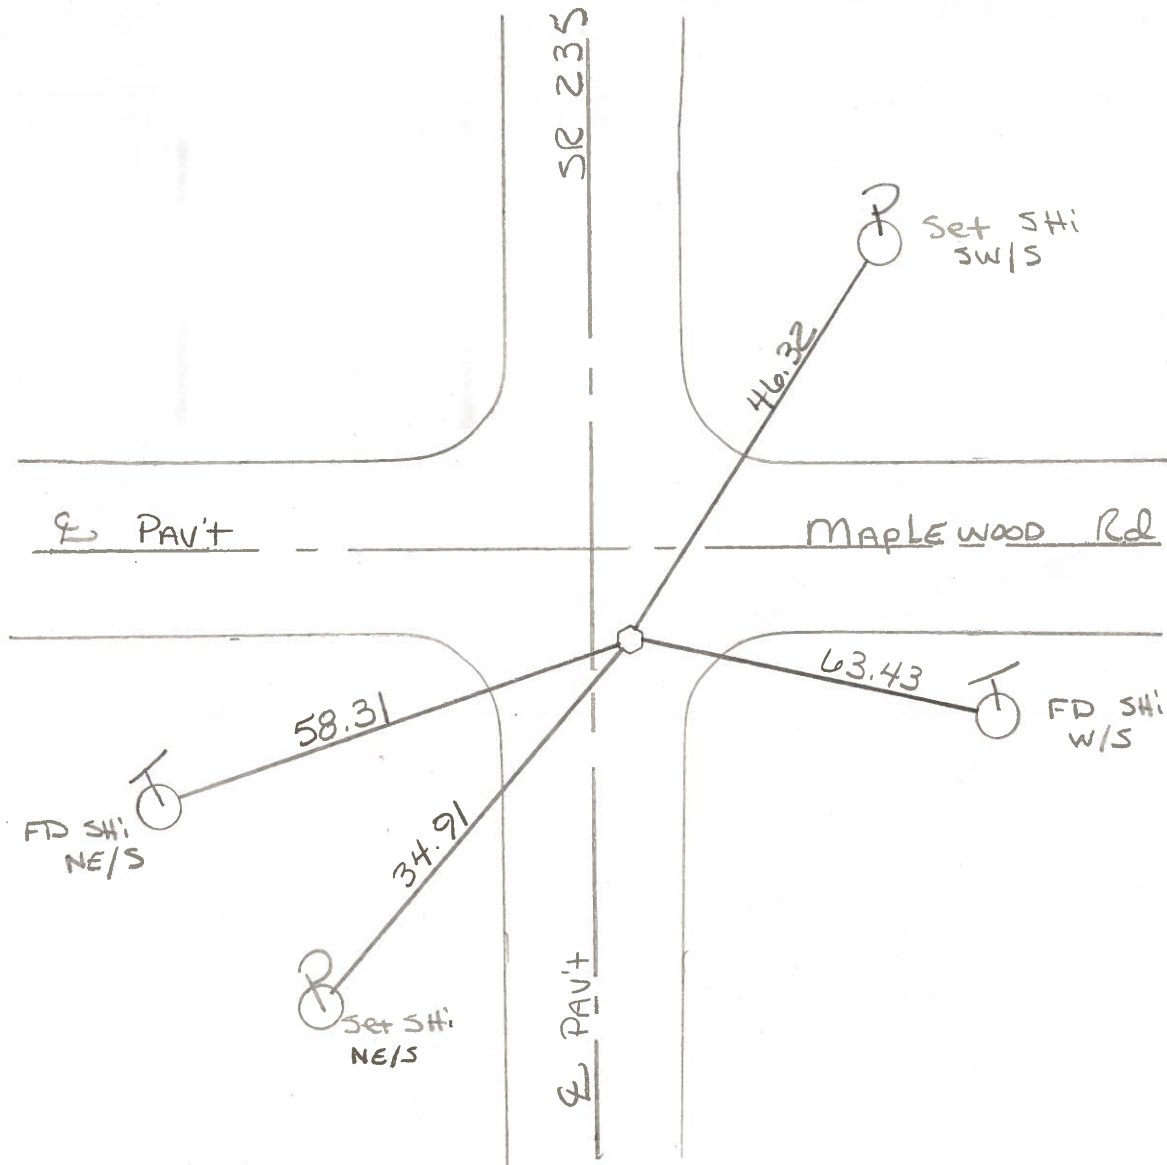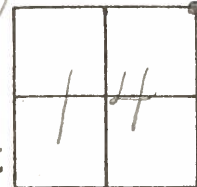

PERSONNEL	TITLE	PERSONNEL	TITLE	COUNTY	Wood	DATE	4-20-76
BURNSIDE				S. R.	235	WEATHER	P. Cloudy
SMITH				SEC.		TEMP.	+60°
BOWERS							
MEAD							

DESCRIPTION	REF. TO SECTION CORNERS	JOB NO.
	LEFT CENTER LINE RIGHT	

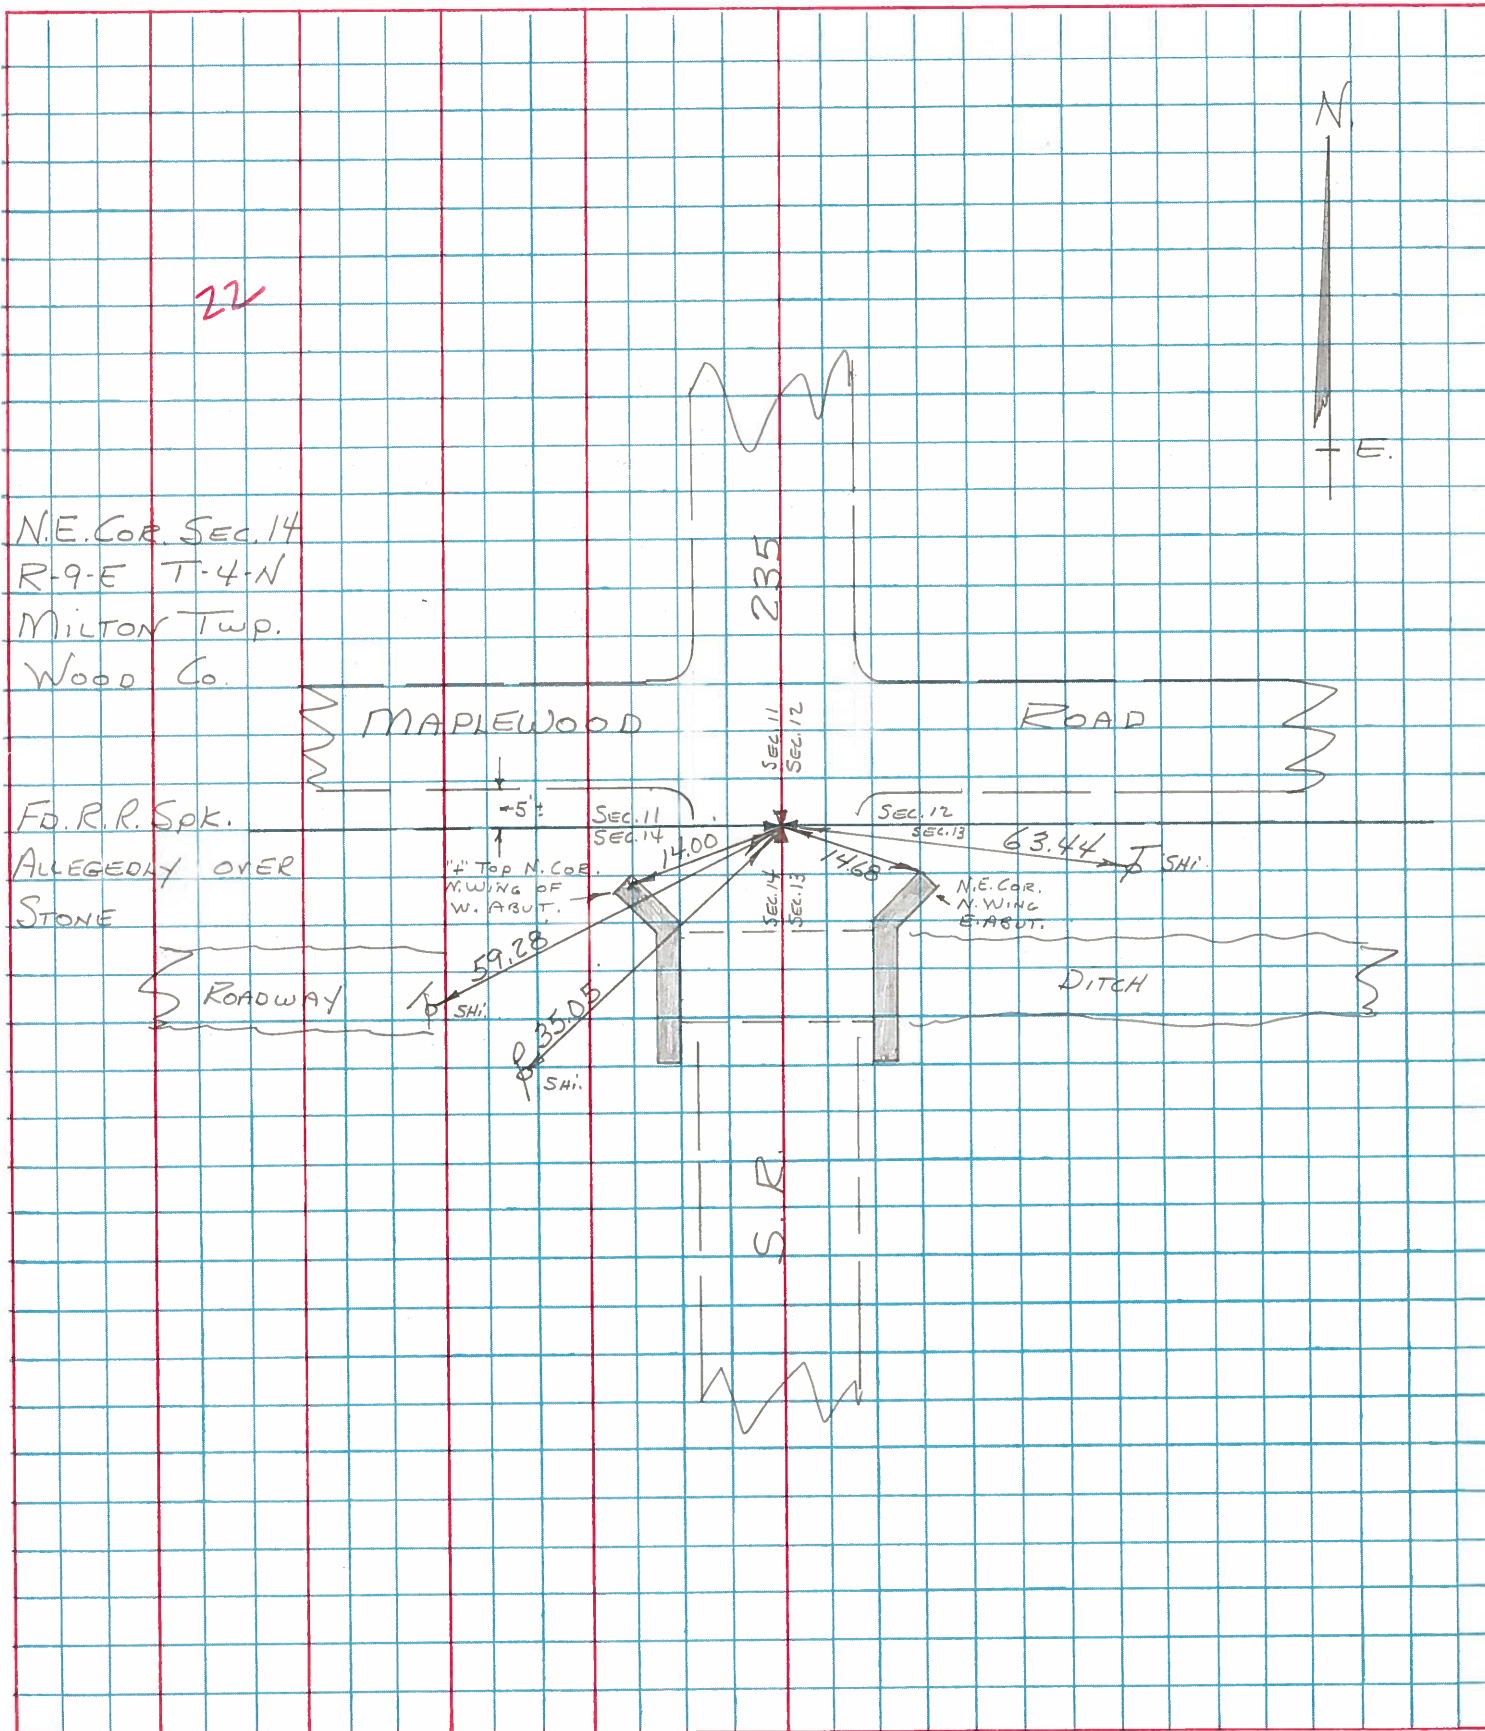

RE-COPIED
7-29-71

SHEET NO. _____

PERSONNEL

TITLE

PERSONNEL

TITLE

COUNTY WOOD

DATE _____

S. R. 235 (OLD S.R. 69) WEATHER _____

SEC. _____

TEMP. _____

DESCRIPTION

LEFT

CENTER LINE

RIGHT

JOB NO. _____

#76 #19

N.W. 1/4 SEC. 24. STONE 10.9'E
OF EDGE PAVE. & W. BANK D.H.

#76-A

SHINER IN END POST OF FENCE 37.13'
IRON PIPE W. 30.30'
T.P. N. of W. 69.35'

#20

N.W. COR. SEC. 24 MILTON
Twp.
MERMILL ROAD

#77

SHINER IN 24" MAPLE N.W. 57.00'
SHINER IN T. POLE S.W. 51.25'
SHINER IN T. POLE N.E. 35.80'
X' IN S.W. COR. S. ABUT. SE. (OLD) 15.93'

#78

#79

#21

E. 1/4 POST SEC. 14 MILTON
Twp. STONE 8' BELOW
SURFACE & 6' W. of E. EDGE PAVE.

#80

IRON ROD W. 30.25'
SHINER IN T. POLE N.N.E. 40.09'
SHINER IN T. POLE S.E. 35.66'

#22

N.E. COR. SEC. 14 MILTON
Twp.
STONE 0.6' DEEP R.R. SPK.
MAPLEWOOD ROAD

#81

N. COR. N.W. Wing of W. ABUT. S. of W. 13.90'
N. COR. N.W. Wing of E. ABUT. S. of E. 14.13'
SHINER IN T. POLE S.W. 35.03'
SHINER IN T. POLE S.E. 34.17'
SHINER IN T. POLE E. 61.34'

PERSONNEL

TITLE

PERSONNEL

TITLE

COUNTY

Wood

DATE

7-69

S. R.

#235

WEATHER

SEC.

TEMP.

DESCRIPTION

Ties to Control Points.

JOB NO.


LEFT

CENTER LINE

RIGHT

RE-SET R.R. S.P.K.
7-2869#
22

#81

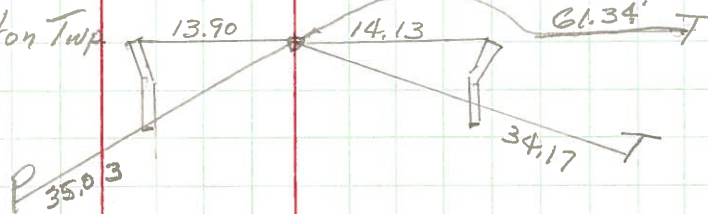RR. S.P.K. NE. Cor Sec #14 Milton Twp
Maplewood Road.

PERSONNEL	TITLE	PERSONNEL	TITLE

COUNTY Wood

DATE 08/12-18-81

S. R. #69

WEATHER 15-60

SEC.

TEMP.

DESCRIPTION

LEFT

CENTER LINE

RIGHT

JOB NO.

#76

N.W. 1/4 Sec. 24. Stone 10.9' E
of edge part. 4 W. bank del.

✓ Shiner in End Post of fence 37.13
✓ Iron pipe W. 30.30
✓ T.P. N of W. 69.35' 37.56

#76-A

N.W. Cor. Sec. 24 Milton
Twp. Merrill Rd.
R.R. Spk. ✓

✓ Shiner in 24" maple NW. 57.0
✓ Shiner in T.P. SW. 51.25
✓ Shiner in T.P. NE. 35.80 35.72
✓ X-in S.W. cor of old S. about SE. 15.90

#77

20

#78

#79

E 1/4 part Sec. 14 Milton
Twp. Stone 8' below surface
of part. 6' W. of E. Edge part.
of pavement. R.R. Spk. ✓

✓ Shiner in T. Pole N.W.E. 113.52
✓ Shiner in P.P. N.W. 40.57 40.22
~~Shiner in Cor. part of 26.93 37.46~~
~~Stone on E. bank of ditch E. 60.00 35.00~~
✓ Shiner in T.P. S.E. 35.66' 35.22
67

#80

21

N.E. cor. Sec. 14 Milton Twp.
Stone 0.6' deep R.R. Spk.
Main road E. ✓

✓ N. cor. N.W. wing of W. about S of W. 13.95
✓ N. cor. N.W. wing of E. about S of E. 14.10
~~Shiner in E. P. NW. Gone 42.00~~
✓ Shiner in P.P. S.W. 35.06' 33.41
✓ Shiner in T.P. S.E. Plumb 34.17 34.17
✓ Shiner in T. Pole East 61.34

22

#81

PERSONNEL	TITLE	PERSONNEL	TITLE

COUNTY WoodDATE OK 12-15-60S. R. #69WEATHER 4-15-60

SEC. _____

TEMP. _____

DESCRIPTION

LEFT

CENTER LINE

RIGHT

JOB NO. _____

#76

N.W. 1/4 Sec. 24, Stone 10.9'E
of edge part of W. bank ch.

✓ Shiner in End Post of fence 57.13
✓ Iron pipe W. 53.30
✓ T.P. Note. 69.95' 47.50

#76-R.

N.W. Cor. Sec. 24 Milton
Twp. Mermill Rd.
R.R. Spk. ✓

#77

20

✓ Shiner in 24" maple Wul. 57.0
✓ Shiner in T.P. S.W. 54.25
✓ Shiner in T.P. N.E. 35.35 35.7
✓ X in S.W. Cor of old S. abut. 55.15.9

#78

#79

E 1/4 part Sec. 14 Milton
Twp. Stone 8' below surface
of part. 6' W. of E. Edge part.
of pavement. R.R. Spk. ✓

#80

21

Iron Rod W. 30.25
✓ Shiner in T.P. N.E. 113.35
✓ Shiner in P.P. N.W. 40.74 40.72
~~Shiner in T.P. S.W. 27.93 27.14~~
~~Stone on E. bank of ditch Stone 25.5~~
✓ Shiner in T.P. S.E. 35.35 35.72

N.E. Cor. Sec. 14 Milton Twp. 13.90
Stone 0.6 deep R.R. Spk. 14.13
Maplewood Rd. ✓

22

✓ N. Cor. N.W. of W. R. Spk. 13.95
✓ N. Cor. N.W. of E. R. Spk. 14.13
✓ Shiner in P.P. S.W. 35.06 35.72
✓ Shiner in T.P. S.E. 35.35 35.72
✓ Shiner in T.P. East 61.34

#81

61.34

PERSONNEL	TITLE	PERSONNEL	TITLE

COUNTY Wood

DATE OK 12-13-57

S. R. #69

WEATHER 4-15-60
1-20-66

SEC.

TEMP.

DESCRIPTION

LEFT

CENTER LINE

RIGHT

JOB NO.

#76

N.W. 1/4 Sec. 24. Stone 10.9'E.
of edge part. & W. bank dch. ✓

✓ Shiner in End Post of fence 37.13
 ✓ Iron pipe W. 30.30
 ✓ T.P. N. of W. 69.35' 69.50

#76-A

N.W. Cor. Sec. 24 Milton
Twp. Merrill Rd.
R.R. Spk. ✓

57.00
 ✓ Shiner in 24" maple N.W. 57.1
 ✓ Shiner in T.P. S.W. 51.25
 ✓ Shiner in T.P. N.E. 35.80 35.75
 ✓ X in S.W. Cor of old S. abut. S.E. 15.93

#77

20

#78

#79

E 1/4 past Sec. 14 Milton
Twp. Stone 8" below surface
of part. 6' W. of E. Edge part.
of pavement. R.R. Spk. ✓

✓ Shiner in T. Pole N.N.E. 113.05
 ✓ Shiner in P.P. N.W. 40.07 40.02
~~Shiner in Cor. past W. 27.93 27.84~~
~~Stone on E. bank of dch. E. gone 25.53~~
 ✓ Shiner in T.P. S.E. 35.66' 35.82

#80

21

N.E. Cor. Sec. 14 Milton Twp.
Stone 0.6' deep R.R. Spk.
Maplewood Rd. ✓

13.95'
 ✓ No. Cor. N. wing of W. abut. Spk. W. 15.0
 ✓ No. Cor. N. wing of E. abut. S of E. 14.16' 15.1
~~Shiner in P.P. N.W. Gone 42.55~~
 ✓ Shiner in P.P. S.W. 35.06' 32.40
 ✓ Shiner in T.P. S.E. Plumb 34.17 34.39
 ✓ Shiner in T. Pole East 61.34'

22

#81