

O.D.O.T. DISTRICT 2 SURVEY OFFICE (USE ONLY)

PERSONNEL

REFERENCE NO. 3

SHEET 3 OF 15

NOTES NIESE

DATE 2/10/23

ROUTE SR 281

H.C. AUBLE

WEATHER CLOUDY

COUNTY WOOD

R.C. MILLER

TEMP. 39°

TOWNSHIP MILTON

SECTION 19

DWG BY RHOADES

PID CHIP SEAL

T 4 N R 9 E

TYPE MONUMENT MAG SHANK

ON SURFACE - ~~BELOW~~ ON

OFFSET Q PAVEMENT 4.5' LT : ~~RT~~

5.2' TO LT EDGE PAVEMENT


STATION: 26+03

HORIZ.DATUM: NAD83 2011


GEOID: NAVD88 2018

GRID: NORTHING: 592419.531

EASTING: 1591108.961

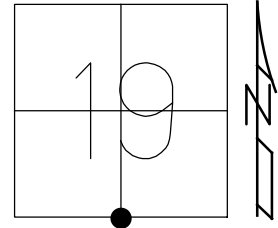


RECORD:
FD SM.R.R.SPIKE
5/22/90, CL
SET SM.R.R.SPIKE
7/2/90, MB
FD SM.R.R.SPIKE
7/2/12, DCH
SET MAG/WASHER
NEWREF3
9/25/12, DCH
FD MAG SHANK
REF3
7/15/22, DSA
2/10/23, TDN

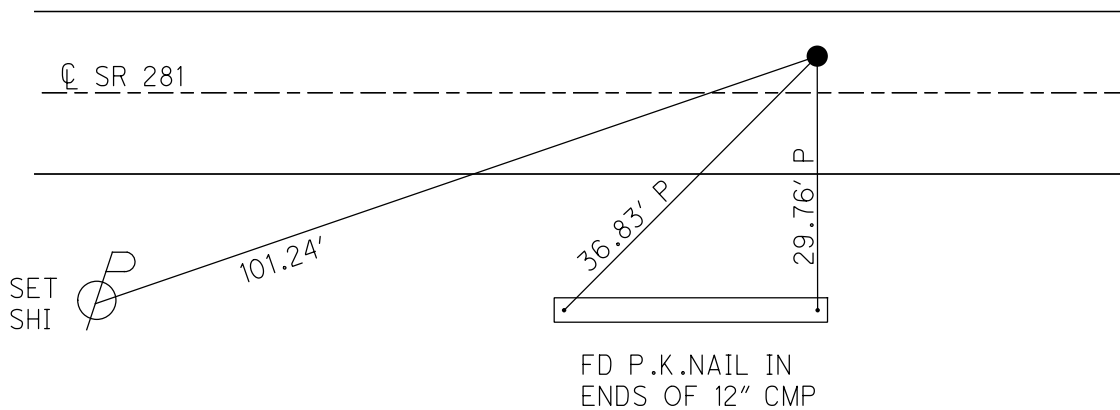

O.D.O.T. DISTRICT 2 SURVEY OFFICE (USE ONLY)

PERSONNEL _____ REFERENCE NO. 3 SHEET 3 OF 15
 NOTES _____ DATE 7/2/12 ROUTE SR 281
 H.C. ROUSOS WEATHER SUNNY COUNTY WOOD
 R.C. HOMAN TEMP. 75° TOWNSHIP MILTON
 _____ SECTION 19
 _____ T 4 N R 9 E

TYPE MONUMENT SM.R.R.SPIKE
 ON SURFACE - ~~BELOW~~ ON
 LEFT - CL PAV'T - ~~RIGHT~~ 4.5'
5.2' TO LT EDGE PAVEMENT
 S.L.M. 26+03

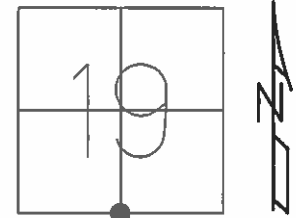


GRID: NORTHING: 592419.604 EASTING: 1591108.879

RECORD:
 FD SM.R.R.SPIKE
 5/22/90, CL

SET SM.R.R.SPIKE
 7/2/90, MB

FD SM.R.R.SPIKE
 7/2/12, DCH

SET MAG/WASHER
 GPS, NEWREF3
 9/25/12, DCH

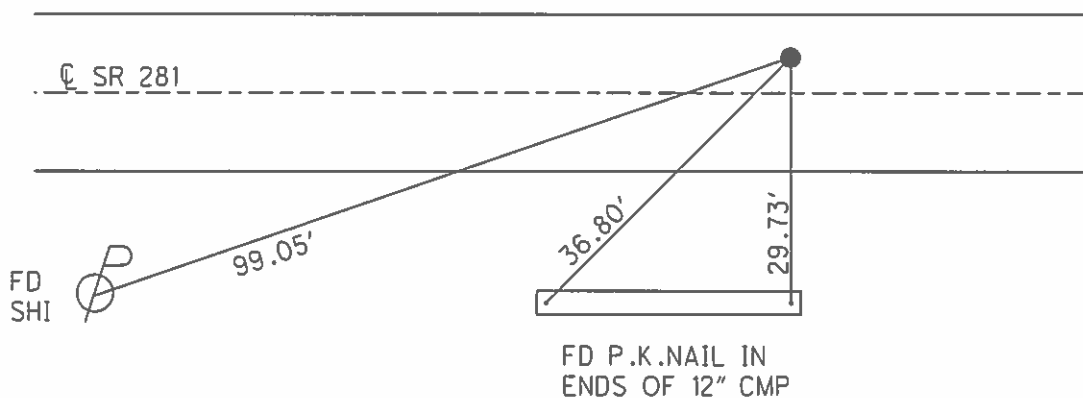

O.D.O.T. DISTRICT 2 SURVEY OFFICE

PERSONNEL

REFERENCE NO. 3

SHEET OF

NOTES BARNHISEL

H.C. Loehake

R.C. HOFFMAN

DATE 5-22-90

WEATHER WINDY

TEMP. +62°

ROUTE 281

COUNTY WOOD

TOWNSHIP MILTON

SECTION 19

T 4 N R 9 E


TYPE MONUMENT Sm RR Spk

ON SURFACE - BELOW yes


LEFT - CL PAV'T. - RIGHT 4.5

5.2 TO LT EDGE PAVEMENT

S.L.M. 26+03

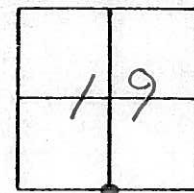

Set Sm RR Spk
7-2-90
mB

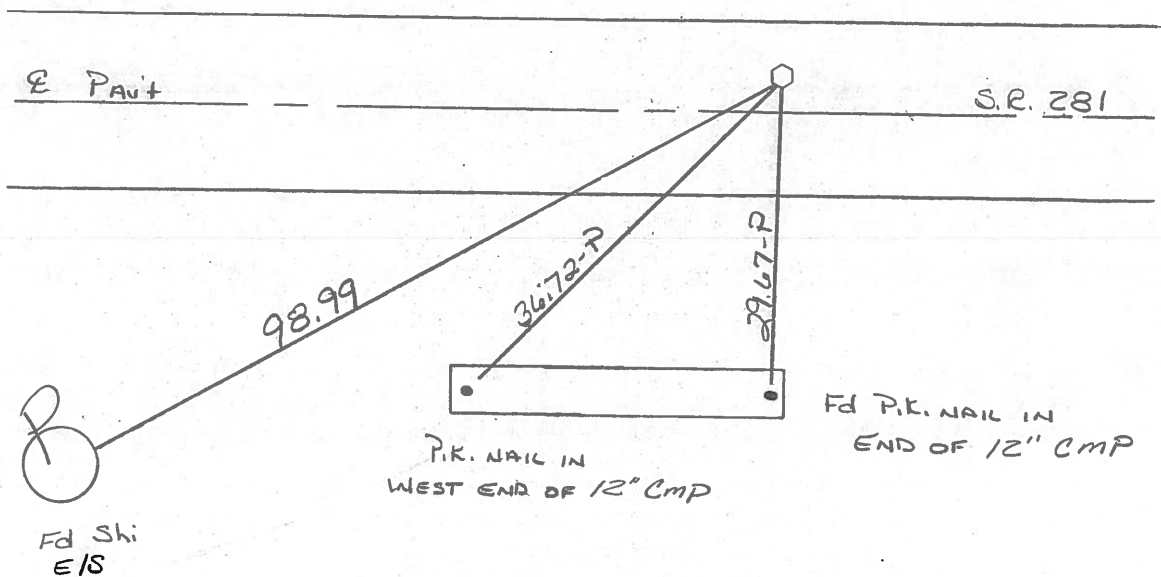

Sht. ____ of ____

Date 7-14-81 8-20-81

Weather clear ✓

Temp. $+68^{\circ}$ $+80^{\circ}$

1	9

N
4



Loehrke

#3

PROJECT STA ± 26 + 00.8

~~5.2~~ to N.E. Part. of 281

4.0' Hof E

16.2 to S.E. Part

Set small
K.R SPK.

Temporary
Tacked 2 x 2 HUBS

41.06-D

40.18-2

$$N. \in P.$$

L Paut.

52 281

98.98-D

~~36.75 - P~~
~~36.69~~ ✓

$$\begin{array}{r} 6.13 \\ 36.69 \end{array}$$

Farm Drive

D	P
29.72-	29.68- 68

29.60

5/ 12" C.M.P. 15

P.K.'S SET TOP
OF PIPE @ W-E ENDS

Shiner
NELS

(Note: Point was set on MEH. Dist & angle. Did not dig for stone ~ REC.)

Q.D.O.T. DISTRICT 2 SURVEY OFFICE

Sht. ___ of ___

County Wood S.R. 281

Date 7-14-81 8-20-81

Township Milton


Weather clear

Section 19

Temp. +68°

T4N, R9E

Personnel Hoffman

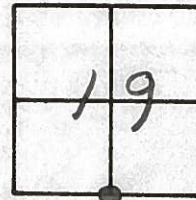

Householder

Loehrke


#3

Fd. Small Nail 2" Below Surface
5.2' to N.E. Part. of 281

Project STA ± 26+00.8

SET SMALL
R.R. SPK.

Temporary
Tacked 2 x 2 Hubs

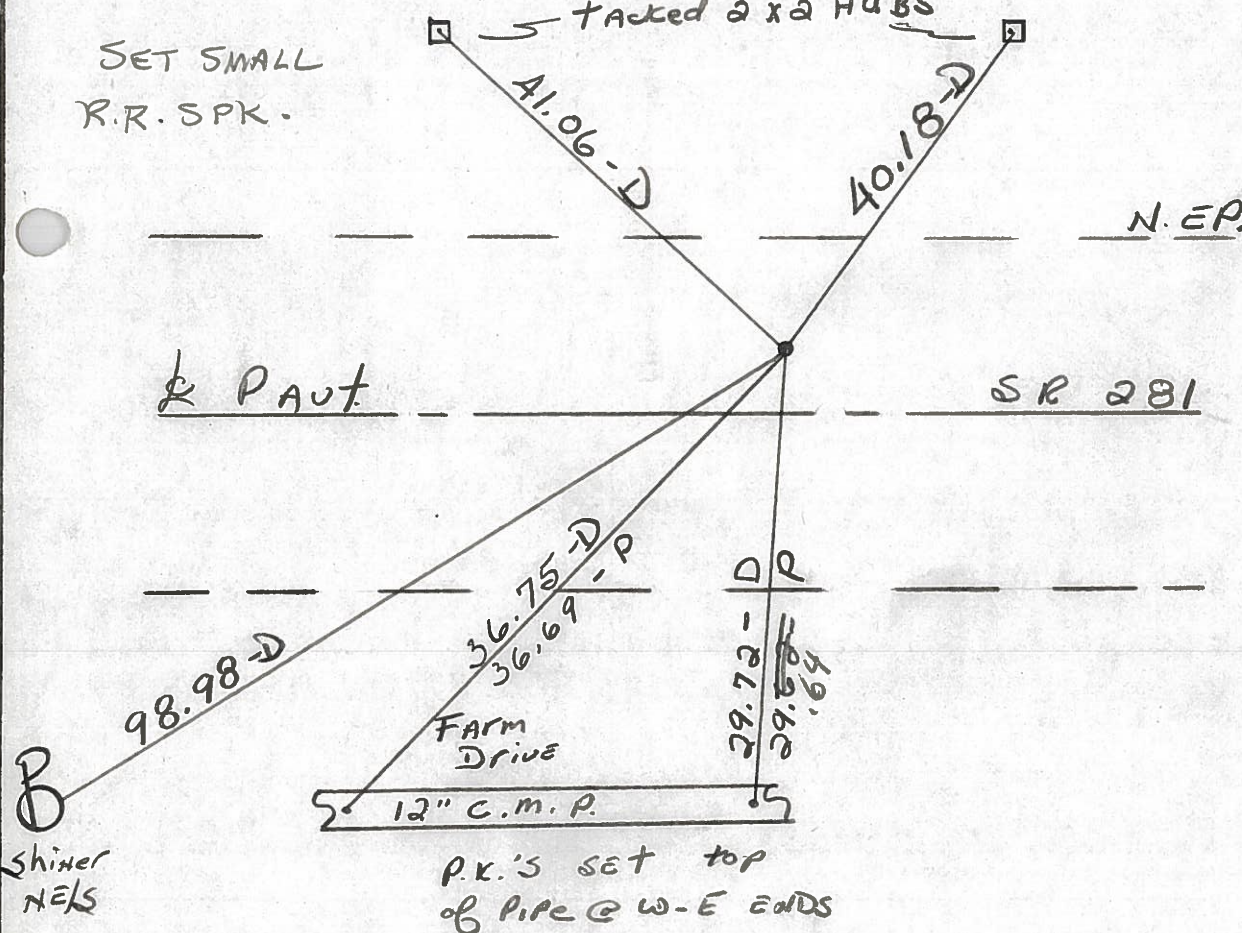

(Note: Point WAS SET ON MEAN DIST. ANGLE. DID NOT DIG FOR STONE - REC.)

Q.D.O.T. DISTRICT 2 SURVEY OFFICE

Sht. ___ of ___

County Wood S.R. 281

Date 7-14-81 8-20-81

Township Milton


Weather clear

Section 19

Temp. +68°

TAN, R9E

Personnel Hoffman

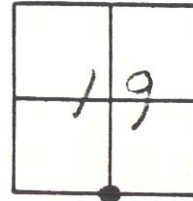

Householder

Loehrke

#3

Fd. Small Nail 2" Below Surface

PROJECT STA ± 26+00.8

5.2' to N.E. Part. of 281


4.5 LT of R
26+03

SET SMALL
R.R. SPK.

SET NEW
Hub

Temporary
Tacked 2 x 2 HUBS

SET NEW
Hub

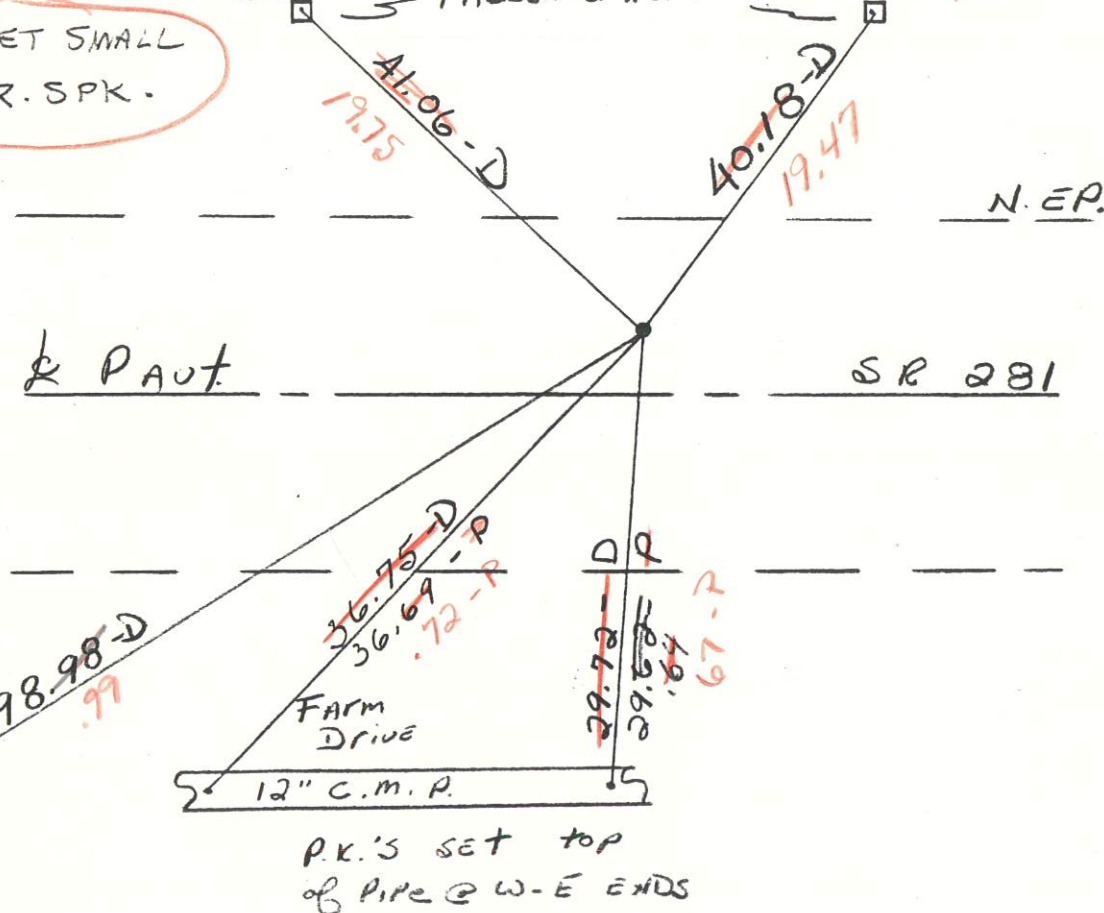

Shiner
NELS

P.K.'S SET TOP
of PIPE @ W-E ENDS

(Note: Point WAS SET ON MEAN DIST FANGLE. DID NOT DIE FOR STORE ~ REC.)

O.D.O.T. DISTRICT 2 SURVEY OFFICE

SHEET

OF

County Wood S.R. 281

Township Milton

Section 19

T4N, R9E

Personnel S. Hoffman


C. Loehrke

L. Householder

Date 5-19-81

Weather cloudy - windy

Temp. 55°

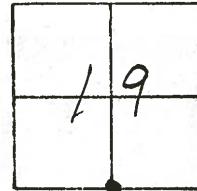

NOTE: POINT WAS SET ON MEAN DIST. & ANGLE. DID NOT DIG FOR STONE

STA 26+00.8 ±


#3 SET SMALL

SMALL NAIL FOUND 2" Below SURFACE, 5.2' S. of N. EDGE PUT.

N. Edge PUT

281

S. EDGE PUT

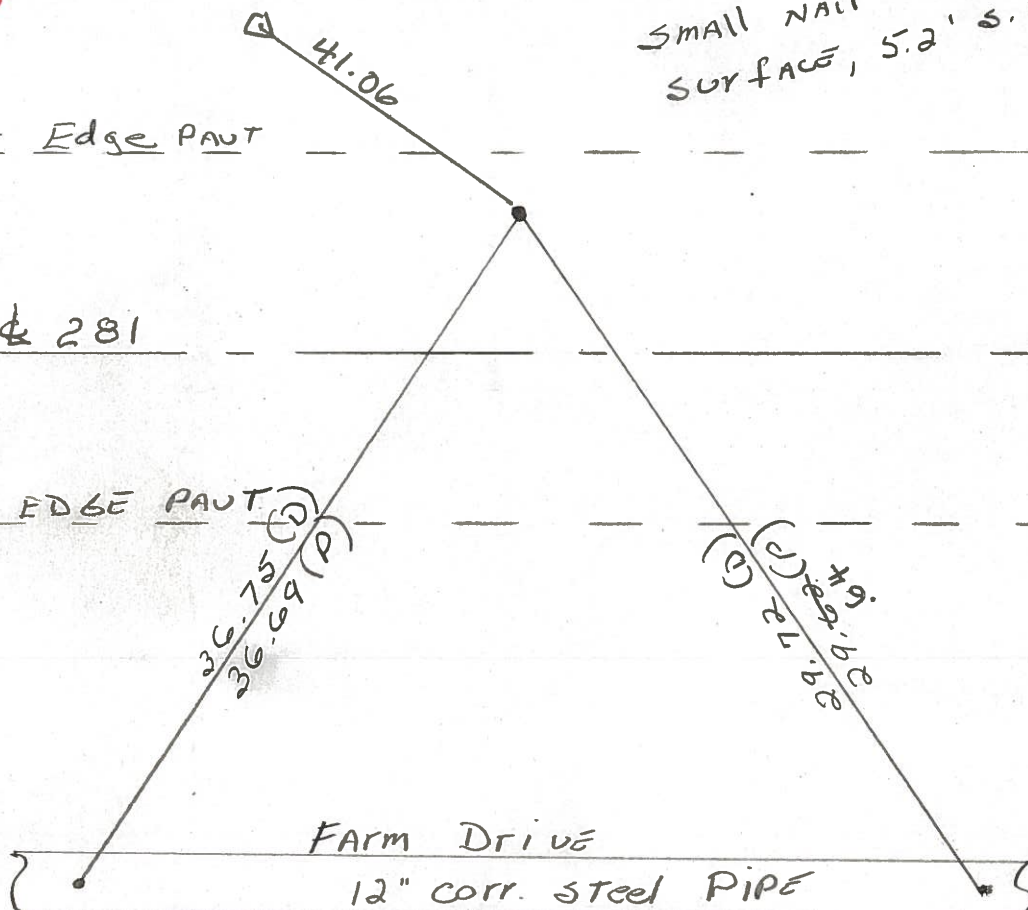

P.K. NAIL
SET TOP of PIPE
± 0.5' FROM W. END

P.K. NAIL SET
TOP of PIPE
± 0.6' FROM EAST
END

PERSONNEL TITLE PERSONNEL TITLE

COUNTY Wood

DATE OK 12-2-57

281

WEATHER 11-3-60 Knappe

SEC. D, E, F & G.

TEMP. 2-28-64

DESCRIPTION From Henry-Wood Co. Line East.

JOB NO.

LEFT

CENTER LINE

RIGHT

Sta. 0+00

S.W. cor. sec. 19 Milton
Twp. Wood & Henry Co.
Lines. Stone

X on N. end W. Hdwl. S.W. 76.1

S. belt of pump N.W. 61.4

Bottom brick N.E. Cor. brick sch


W. 50.2

Bottom brick S.E. Cor. brick sch

W. 43.1

①

#144

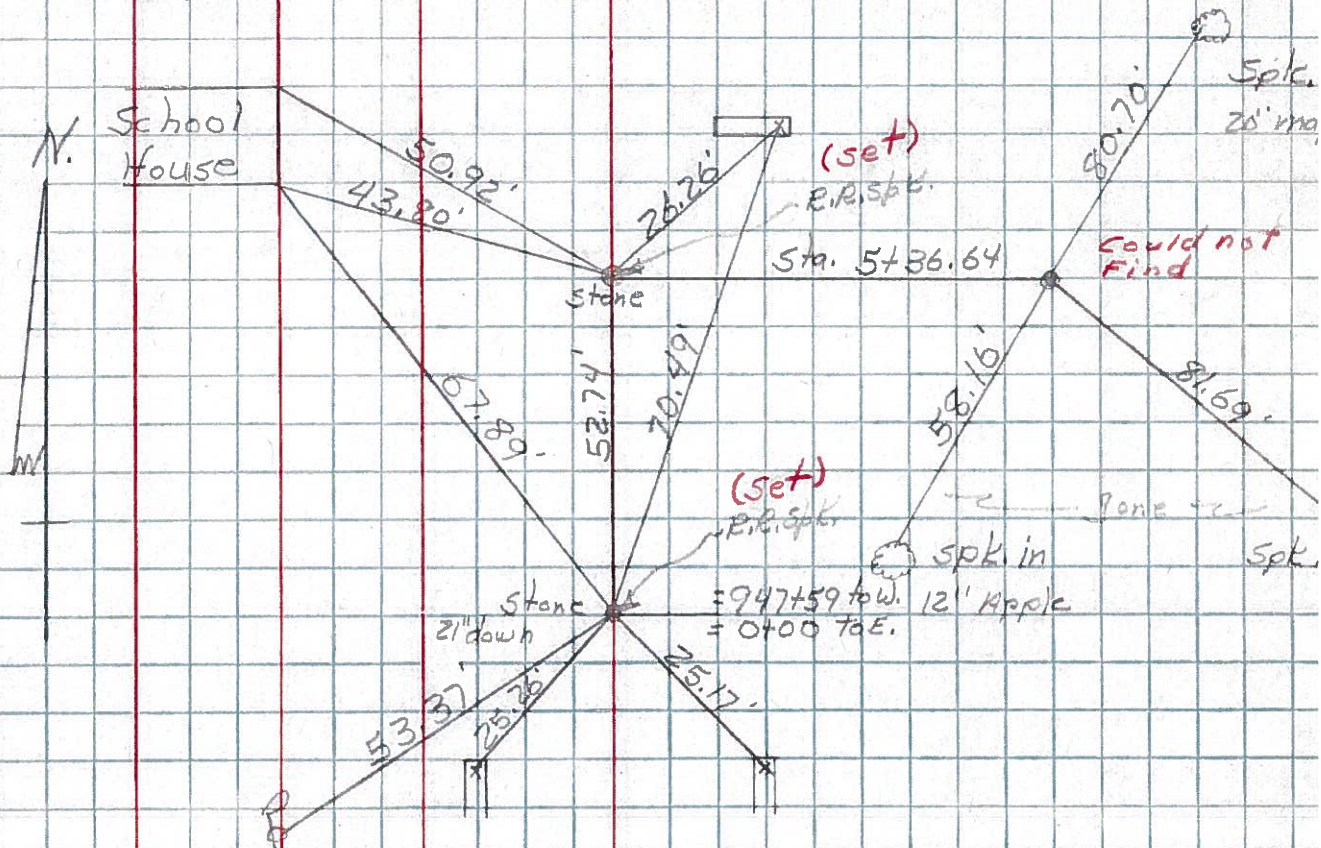Sta. 26+00.8 (old)
Did not find (12-2-57)

Shiner in T.P. 28.1

Spike in L.P. 92.4

Shiner in Cor. P. 28.6

③

#145

Set shiner on A 26+00.8 from West
" " " " " " East

Note - overlap of 7.35'