


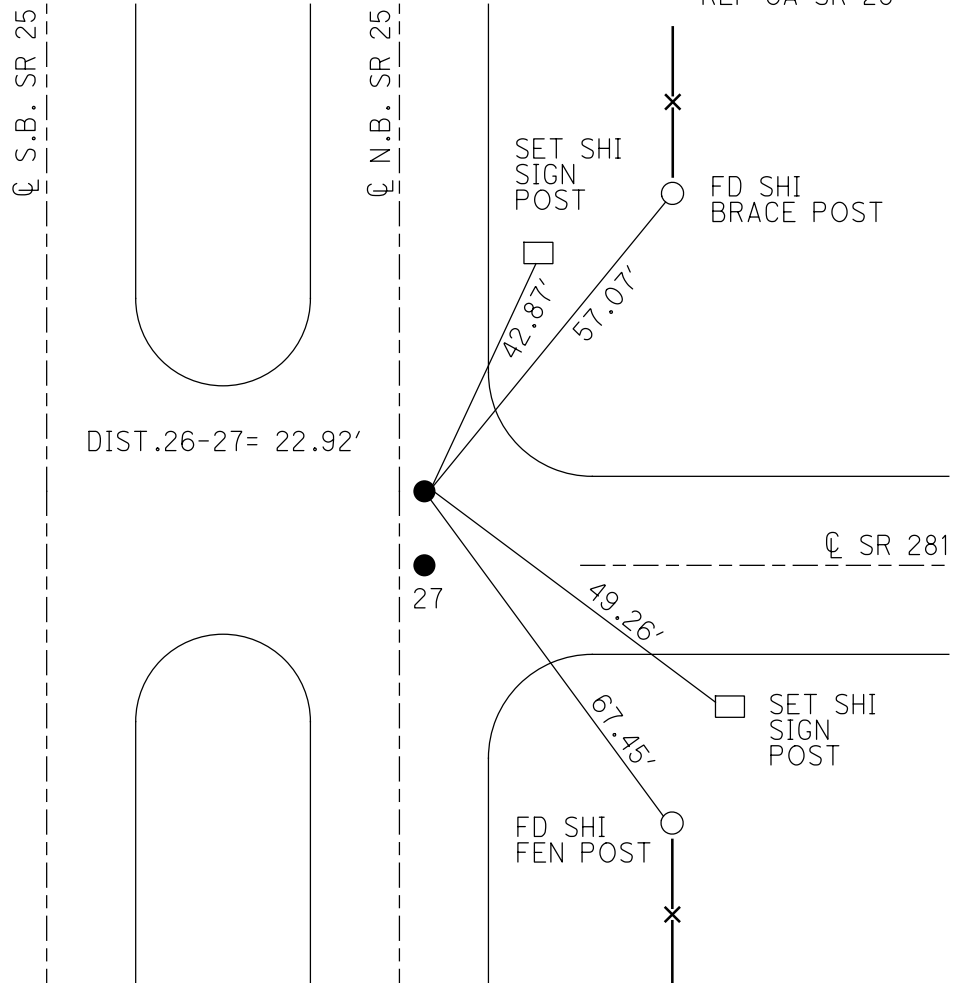

O.D.O.T. DISTRICT 2 SURVEY OFFICE (USE ONLY)

PERSONNEL

REFERENCE NO. 26

SHEET 15 OF 36

NOTES RHOADES

DATE 5/30/18

ROUTE SR 281

H.C. O'DONNELL

WEATHER CLOUDY

COUNTY WOOD

R.C. TRENKA

TEMP. 77°

TOWNSHIP LIBERTY

SECTION 24

DWG BY MILLER PID NO PID

T 4 N R 10 E

TYPE MONUMENT CNPT

ON SURFACE - ~~BELOW~~ ON

OFFSET CL PAVEMENT 2.2' LT : RT

- TO - EDGE PAVEMENT


STATION: 639+50

HORZ.DATUM: NAD83(2011)

GEOID: NAVD88 2012A

GRID: NORTHING: 590943.665


EASTING: 1652388.927

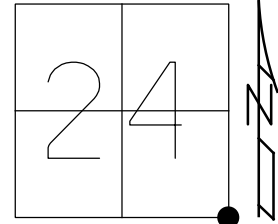

RECORD:

FD BRASS MON
FD P.K./WASHER
6/5/90, CL
4/12/01, TMR
SET P.K./WASHER
10-31-01, SAH
FD P.K./WASHER
5/25/04
D.N.F
SHOT CNTR TIES
REFA6
5-30-18
10-1-18, JFO

NOTE: LIBERTY TWP
S.E. COR SEC 24
REF 6A SR 25

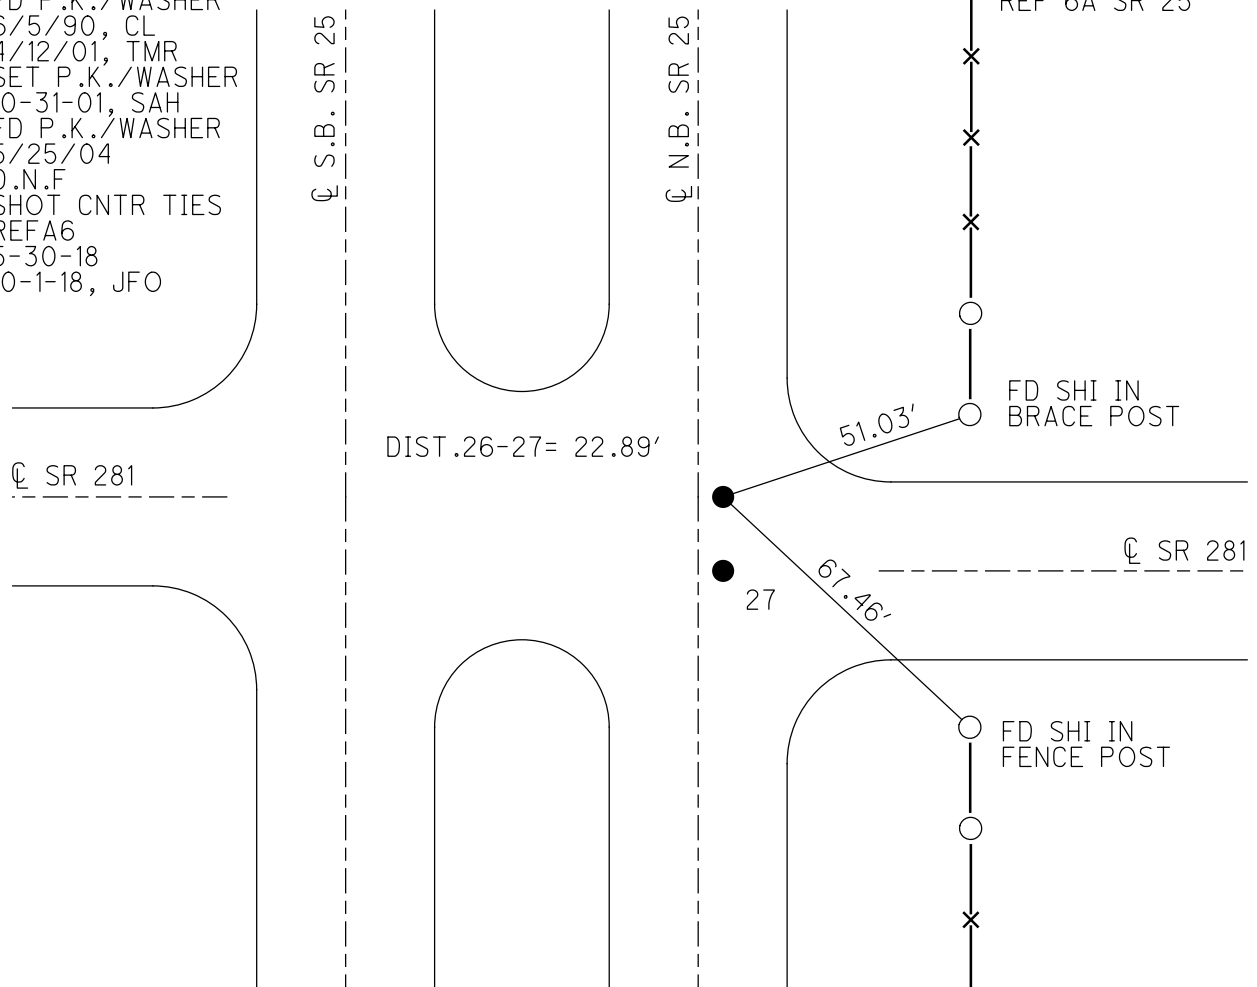

O.D.O.T. DISTRICT 2 SURVEY OFFICE (USE ONLY)

PERSONNEL

REFERENCE NO. 26 & 27

SHEET 15 OF 25

NOTES HOFFMAN

DATE 6-5-90

ROUTE S.R. 25 at S.R. 281

H.C. LOEHRKE

WEATHER CLEAR

COUNTY WOOD

R.C. BARNHISEL

TEMP. +68°

TOWNSHIP LIBERTY/PORTAGE

SECTION 19, 24, 25, 30

T 4 N R 10/11 E

TYPE MONUMENT P.K.'s/WASHER

ON SURFACE - ~~BELLOW~~ YES

~~|||||~~ - CL PAV'T - RIGHT 2.2' (S.R. 25)

- TO - EDGE PAVEMENT


S.L.M. S.R. 281 = 639+50

Grid: Northing: Easting:

24	19
LIBERTY TWP	PORTAGE TWP
25	30



FOUND 5-25-04

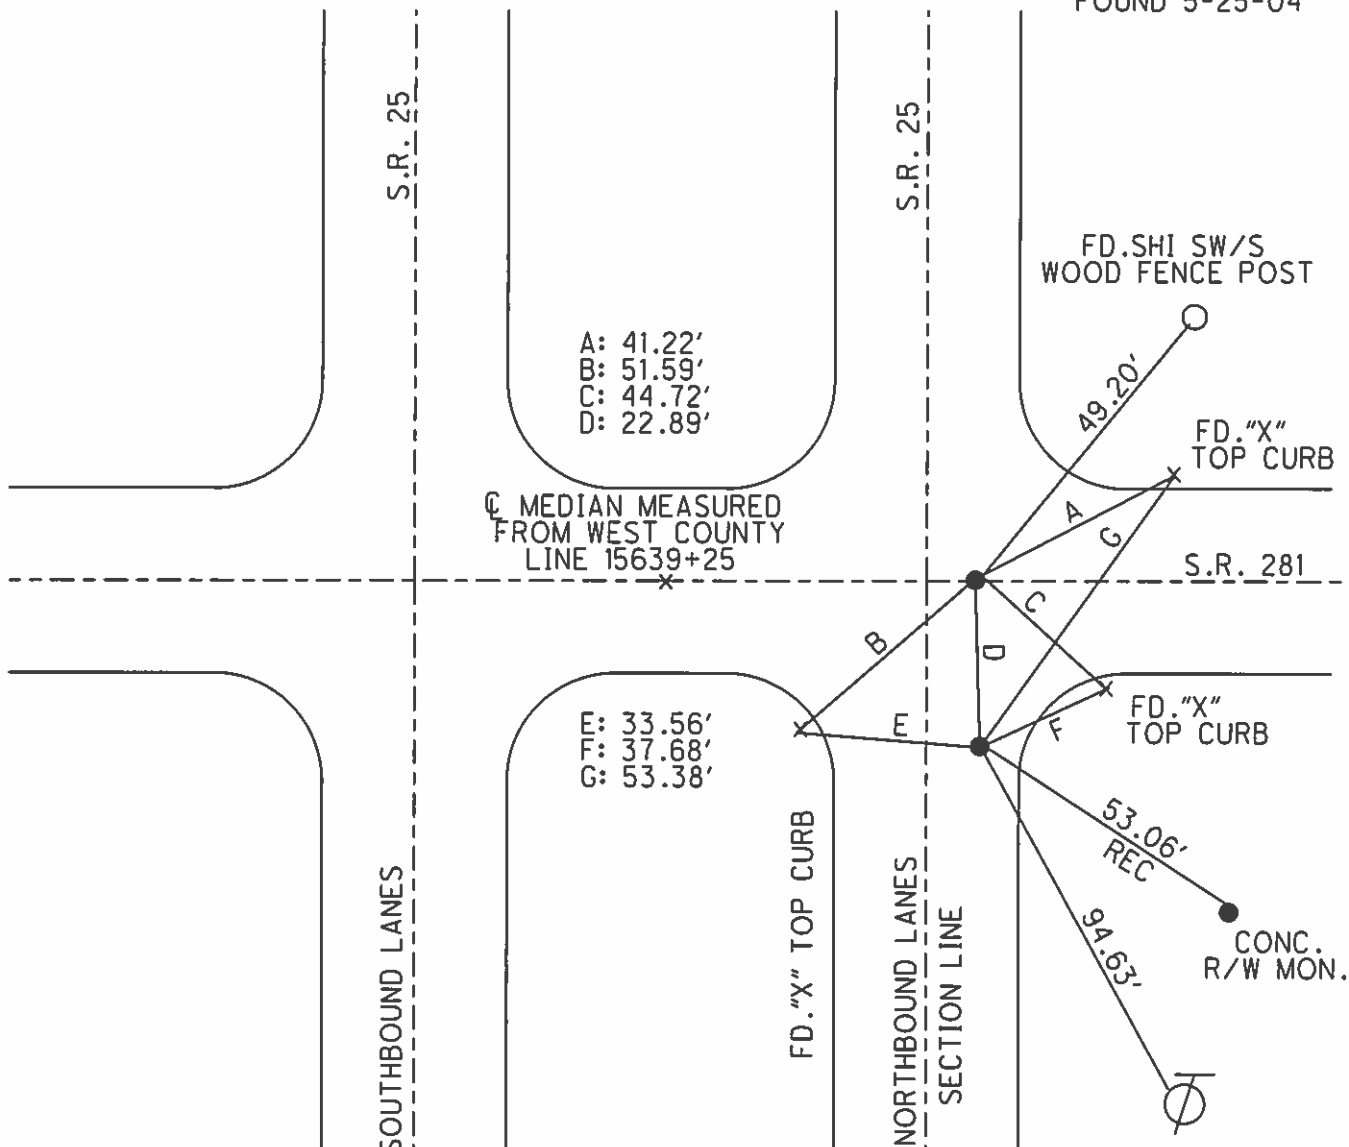

O.D.O.T. DISTRICT 2 SURVEY OFFICE

PERSONNEL

REFERENCE NO. 26 & 27

SHEET 1 OF 11

NOTES HOFFMAN

H.C. LOEBRUCKE

R.C. BARNHISEL

DATE 6-5-90

WEATHER CLEAR

TEMP. 68°

ROUTE SR 25 at SR 281

COUNTY Wood

TOWNSHIP LIBERTY - Portage

SECTION 24 - 19

T4 NR 10/11 G

TYPE MONUMENT P.K.'S/WASHER

ON SURFACE - ~~BELOW~~ YES

~~LEFT - C PAV'T. - RIGHT~~ 2.2 of SR25

TO _____ EDGE PAVEMENT

S.L.M. SR 281 = 639 + 50


24	19
25	30

LIBERTY
TWP

Portage
Twp

N

• E

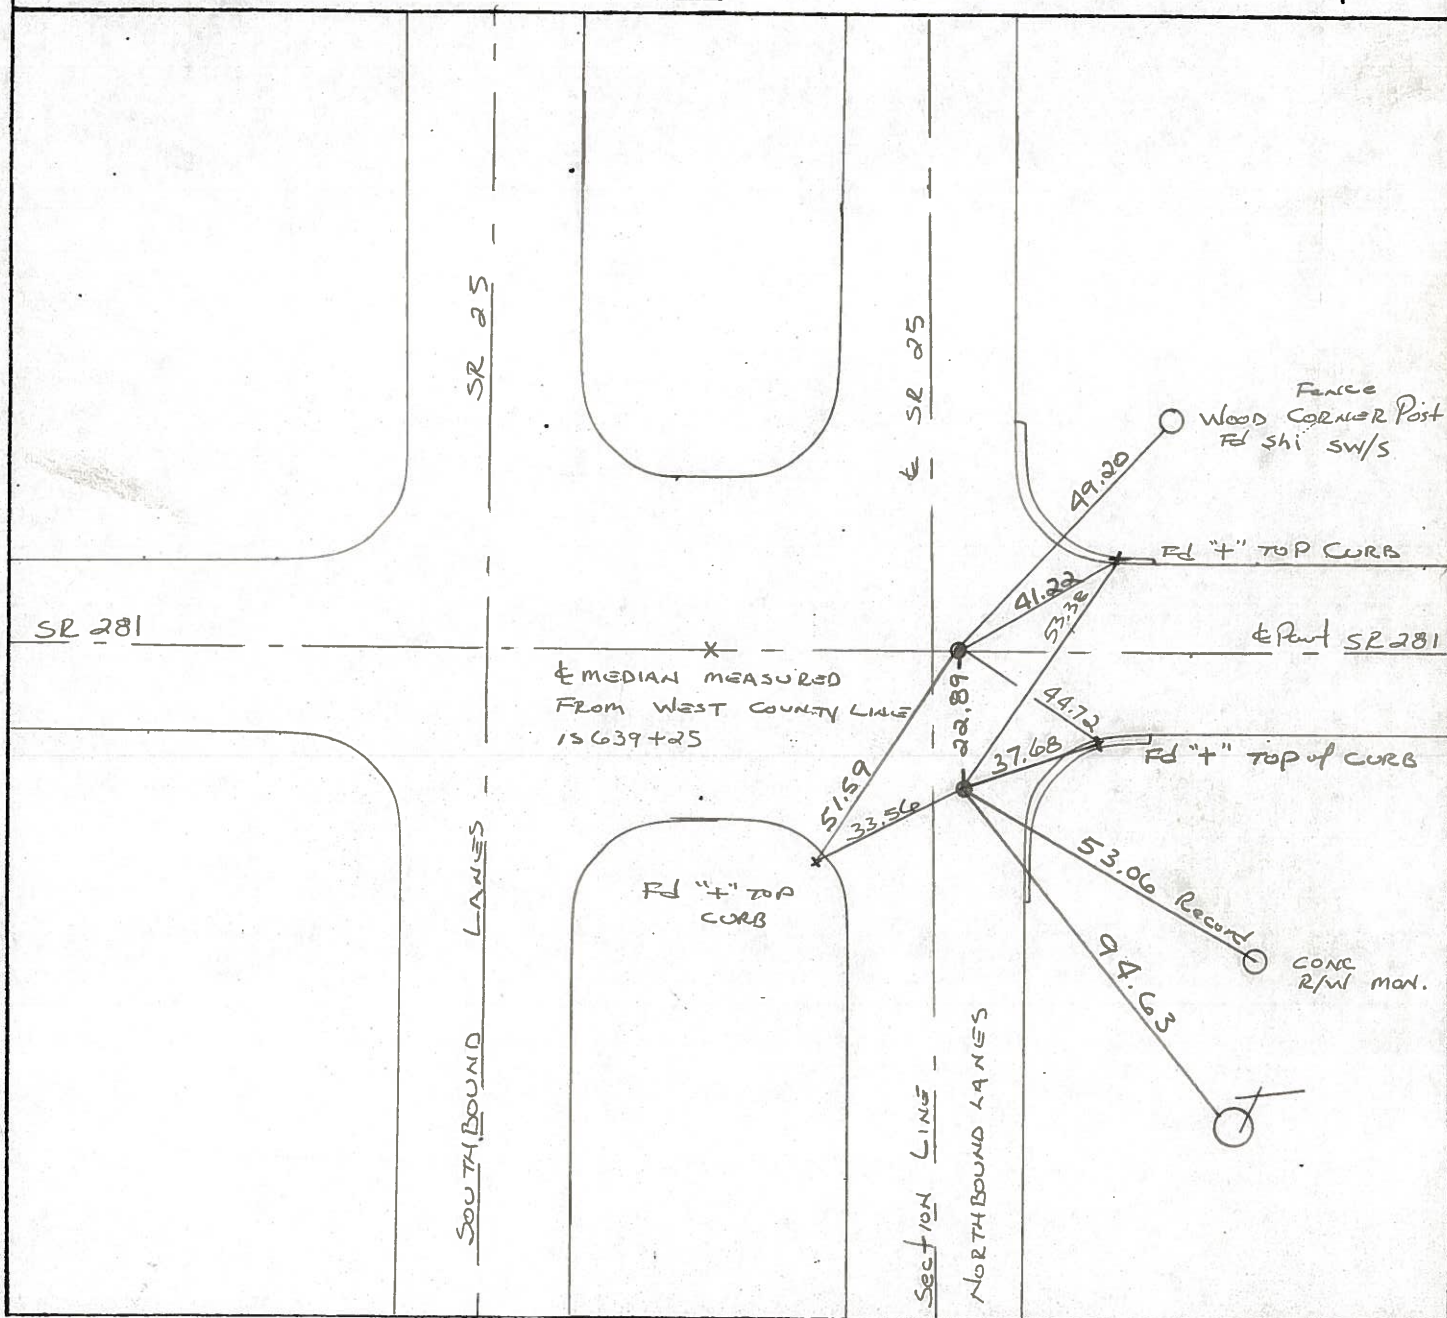

Sht. 15 of

Date 5-2-1979


Weather Clear

Temp. 68°

Liberty	
2	4

19
Portage Twp

26 & 27

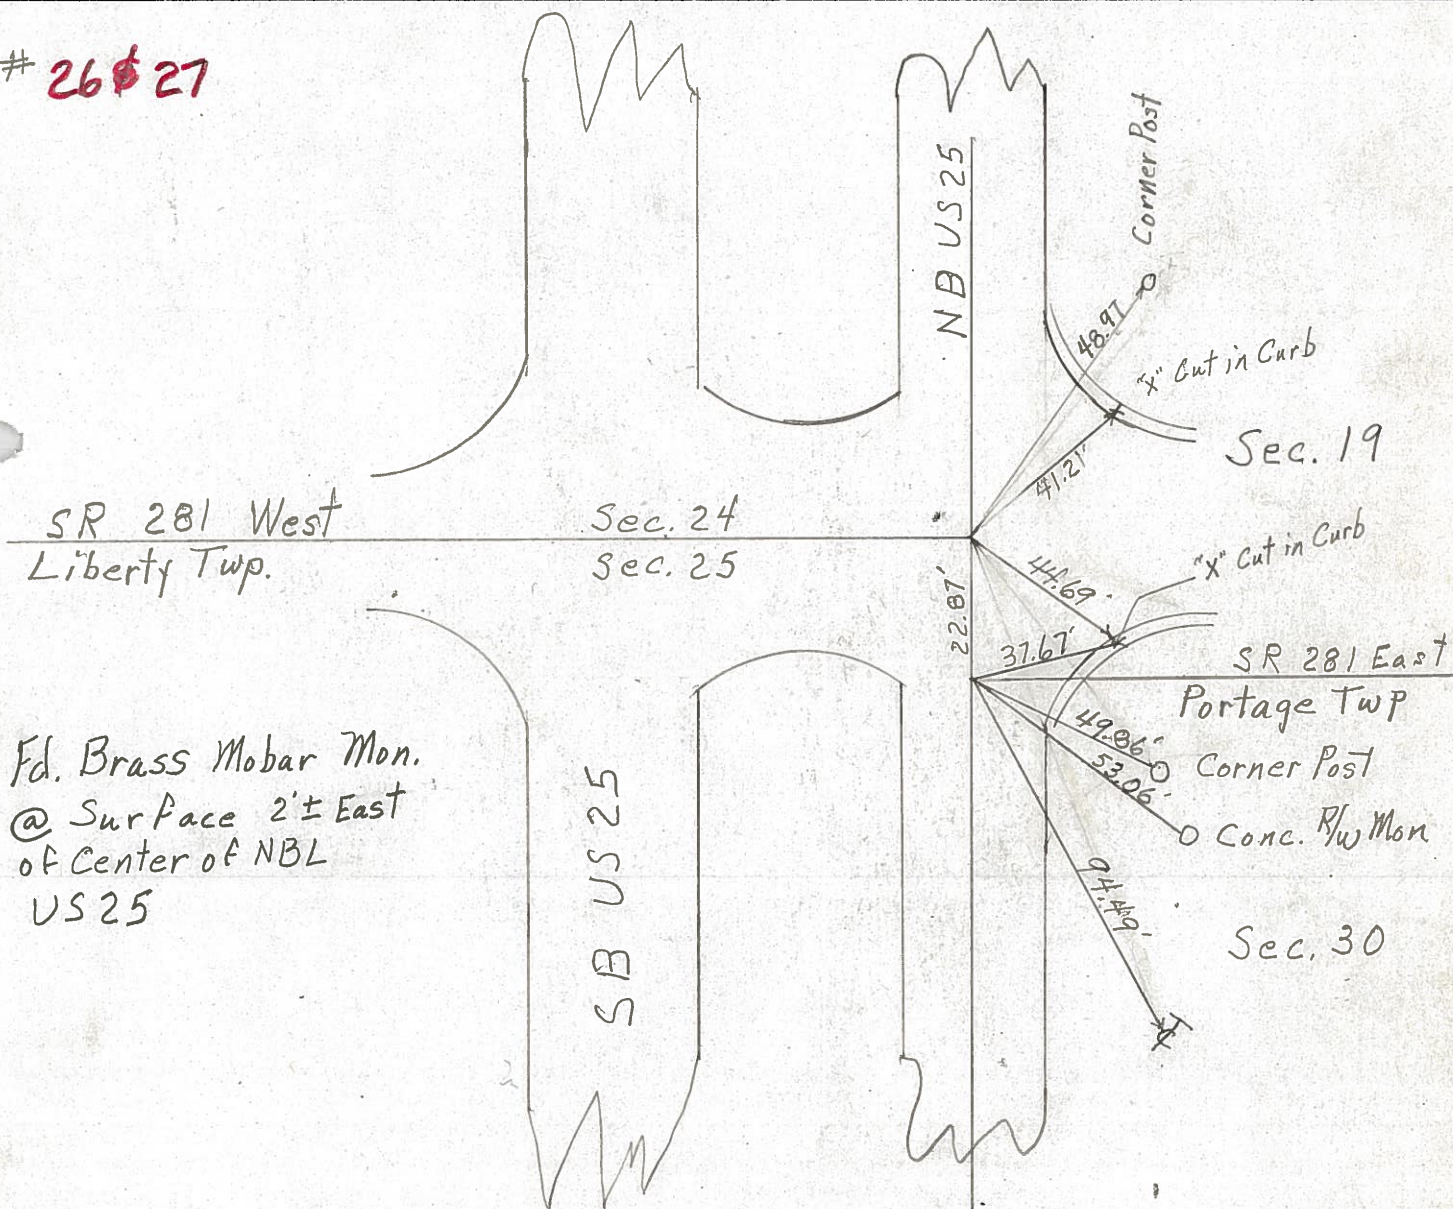

Q.D.O.T. DISTRICT 2 SURVEY OFFICE

Sht. 15 of

County Wood SR 281

Date 5-2-1979

Township Liberty & Portage

Weather Clear

Section SE Corner Sec. 24 SW Corner Sec. 19

Temp. 68°

T4N, R10E Liberty Portage Twp. T4N R11E

Personnel Smith

Liberty	
2	4

19
Portage Twp

26 & 27

calc: $SLM 12.12 = 639+93.6$

meas from previous job

from the west = $639+25$

USE THIS sta.

SR 281 West
Liberty Twp.

Sec. 24
Sec. 25

Fd. Brass Mobar Mon.
@ Surface 2'± East
of Center of NBL 2.2'
US 25 639+50

SB US 25

Median

NB US 25

Corner Post

"X" Cut in Curb

Sec. 19
53.38

"X" Cut in Curb

SR 281 East
Portage Twp.

Corner Post

Conc. P/W Mon
Rec

Sec. 30

Fd. Sht. xwds
Rec

PERSONNEL	TITLE	PERSONNEL	TITLE	COUNTY	DATE
BURNSIDE				WOOD	
SMITH				S. R. #281 & 25	WEATHER
HOLCOMBE				SEC. 24 & 30	TEMP.
BOWERS					

DESCRIPTION	LEFT	CENTER LINE	RIGHT	JOB NO.
-------------	------	-------------	-------	---------

STA. 429+61.95 = U.S. #25
 S.E. COR. SEC. 24
 LIBERTY TWP.
 BRASS MON.

#27

SHI. IN END FENCE POST N.E. 48.18'
 SHI. IN T. POLE N.E. 50.34'
 FACE STEEL LIGHT POLE N.E. 40.22'
 4" TOP CURB RADIUS E.S.E. 44.64'
 SHI. IN END FENCE POST S.E. 66.26'
 CONC. R/W MON S.E. 70.20'

NOTE: 22.84' BETWEEN POINTS

STA. 429+39.2 = U.S. #25
 N.W. COR. SEC. 30
 PORTAGE TWP.
 BRASS MON.

#26

SHI. IN END FENCE POST N.E. 65.74'
 SHI. IN T. POLE N.E. 67.20'
 FACE STEEL LIGHT POLE N.E. 59.91'
 4" TOP CURB RADIUS E. 37.63'
 SHI. IN END FENCE POST S.E. 49.84'
 CONC. R/W MON S.E. 53.10'

PERSONNEL TITLE PERSONNEL TITLE

COUNTY Wood

DATE OK 12-4-57

11-3-60

W.F.K.

S. R. #281

WEATHER
Silvester 2-28-64

SEC.

TEMP

DESCRIPTION

LEFT

CENTER LINE

RIGHT

JOB NO.

Sta. 266+21.9

S.W. cor. sec. 24 Liberty

Twp. Stone with Iron Rod - P.K. & Shiner
on top. $\Delta = 0^\circ - 16' L$

Eudolph Rd.

#165

(24)

Shiner in T.P. N.E. 38.3

Shiner in P.P. S.E. 56.3

Shiner in P.P. S.W. 37.02 36.9

Conc. mon. (plumbed) NW. 38.3

Conc. mon. S.W. 36.91 36.9

X in Iron Cor. post S.W. 35.74 35.6
35.98

Sta. 292+80.65

S.W. post sec. 24

Liberty Twp.

1/2 mile W. of U.S. 25 #68

 $\Delta = 0^\circ - 06' R$ Stone with iron bolt - P.K. & Shiner
on top.

#166

(25)

Shiner in T.P. N.N.E. 40.4

Shiner in P.P. S.E. 41.1

Shiner in 10' Syamore S.S.W. 37.0

N.E. cor. House fdn. S.W. 101.55 101.5

Shiner in 6' maple S.S.W. 47.2

Notes

For S.E. cor. sec. 24

Liberty Twp. sec

#284 S. 1/4 20 sec. E.

& U.S. #25 & SE #281

(26)

Shiner in T.P. N.E. 47.4

Shiner in P.P. S.W. 49.3

X on E. pt Hdwl. W.N.W. 51.2

Conc. R/W. mon. S.E. 69.8