

O.D.O.T. DISTRICT 2 SURVEY OFFICE (USE ONLY)

PERSONNEL

REFERENCE NO. 28 C

SHEET 19 OF 36

NOTES O'DONNELL

DATE 3/14/22

ROUTE SR 281

H.C. AUBLE

WEATHER SUNNY

COUNTY WOOD

R.C. NIESE

TEMP. 35°

TOWNSHIP PORTAGE

DWG BY RHOADES

PID 94340

SECTION 19

T 4 N R 11 E

TYPE MONUMENT MONBOX W/ 1" IPIN

ON SURFACE - ~~BELOW~~ ON

OFFSET Q PAVEMENT 0.4' LT : ~~RT~~

11.2' TO RT EDGE PAVEMENT


STATION: 680+24.45

HORZ.DATUM: NAD83 2011


GEOID: NAVD88 2018

GRID: NORTHING: 590751.134

EASTING: 1656500.331

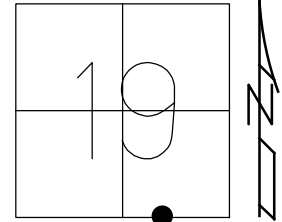

RECORD:
COULD NOT OPEN BOX
TIES TO CTR LID
6-5-90, CL
FD MONBOX
9-27-00
7-8-04, RGN
FD MONBOX
W/1" IPIN
REFC28
3-19-18, JLL

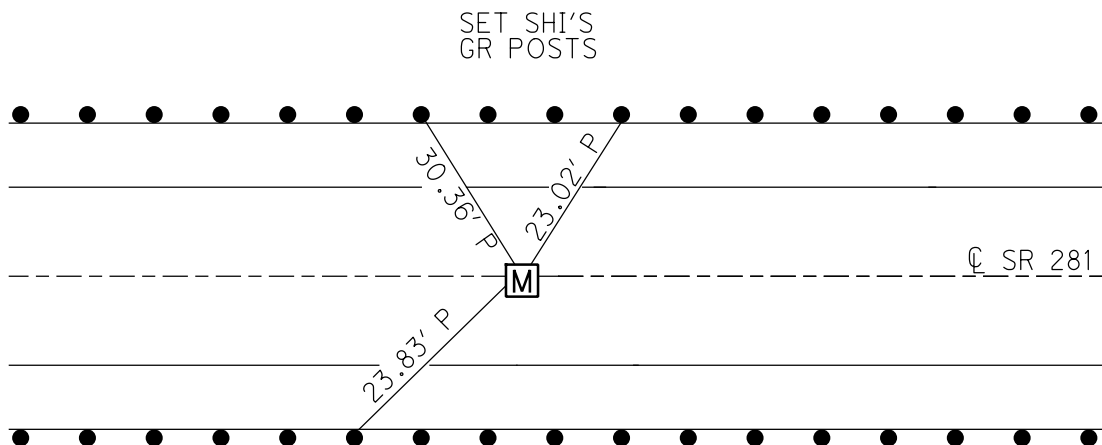

O.D.O.T. DISTRICT 2 SURVEY OFFICE (USE ONLY)

PERSONNEL

REFERENCE NO. 28 C

SHEET 19 OF 27

NOTES NUHFER

DATE 5-25-04

ROUTE SR 281

H.C. HOMAN

WEATHER CLEAR

COUNTY WOOD

R.C. ADKINS

TEMP. 68°

TOWNSHIP PORTAGE

DWG BY JAMES

PID 97957

SECTION 19

T 4 N R 11 E

TYPE MONUMENT MONBOX

ON SURFACE - ~~BELOW~~ ON

OFFSET Q PAVEMENT 0.4' ~~LT~~ : RT

11.4' TO RT EDGE PAVEMENT


STATION: 682+34.19

HORIZ.DATUM: NAD83 2011

GEOID: NAVD88 2012A


GRID: NORTHING: 590751.134

EASTING: 1656500.331

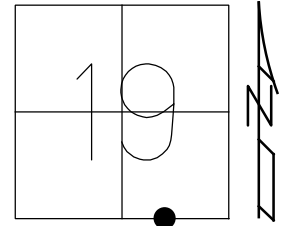

RECORD:
COULD NOT OPEN BOX
TIES TO CTR LID
6-5-90, CL
FD MONBOX
9-27-00
7-8-04, RGN
FD MONBOX
W/1" IPIN
REFC28
3-19-18, JLL

FD "X" CUTS
WINGWALLS

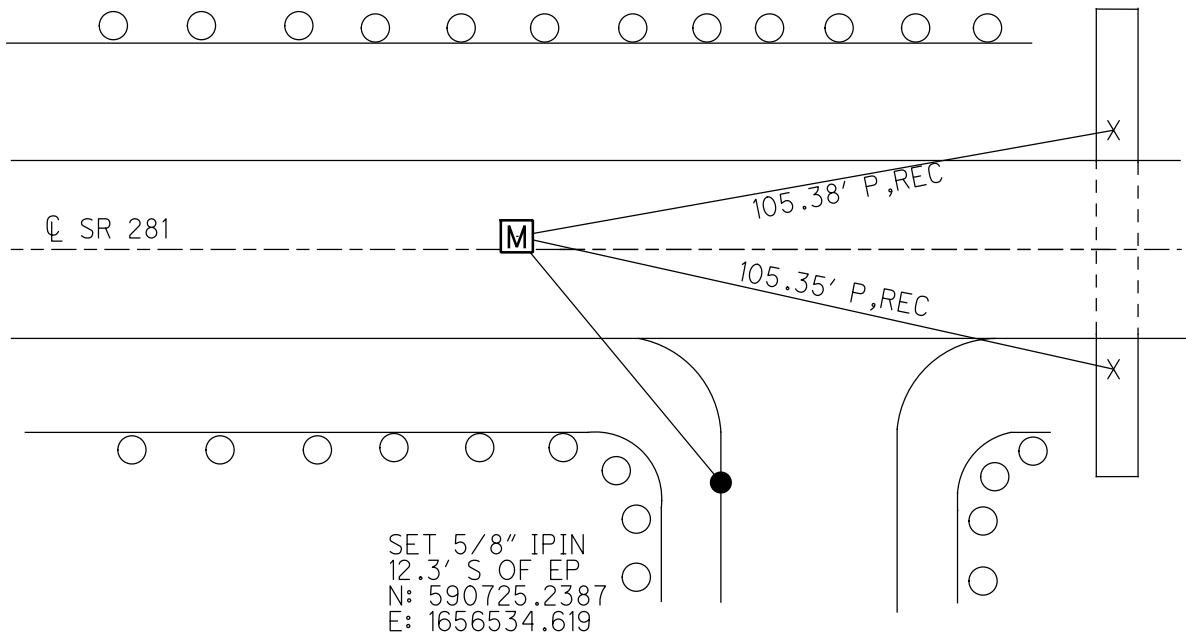

O.D.O.T. DISTRICT 2 SURVEY OFFICE (USE ONLY)

PERSONNEL

REFERENCE NO. 28-C

SHEET 19 OF 25

NOTES NUHFER

DATE 5-25-04

ROUTE S.R. 281

H.C. HOMAN

WEATHER CLEAR

COUNTY WOOD

R.C. ADKINS

TEMP. +68°

TOWNSHIP PORTAGE

SECTION 19

T 4 N R 11 E

TYPE MONUMENT MONUMENT BOX


ON SURFACE - ~~BELOW~~ YES

~~BELOW~~ - CL PAV'T - RIGHT 0.4'

11.4' TO RT. EDGE PAVEMENT


S.L.M. 680+68

Grid: Northing: _____ Easting: _____

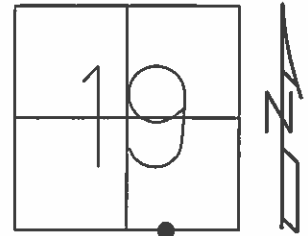

DID NOT OPEN BOX
TIES TO CTR OF LID
(COULD NOT OPEN)

NOTE: MON BOX VISIBLE
7-8-04
RGN

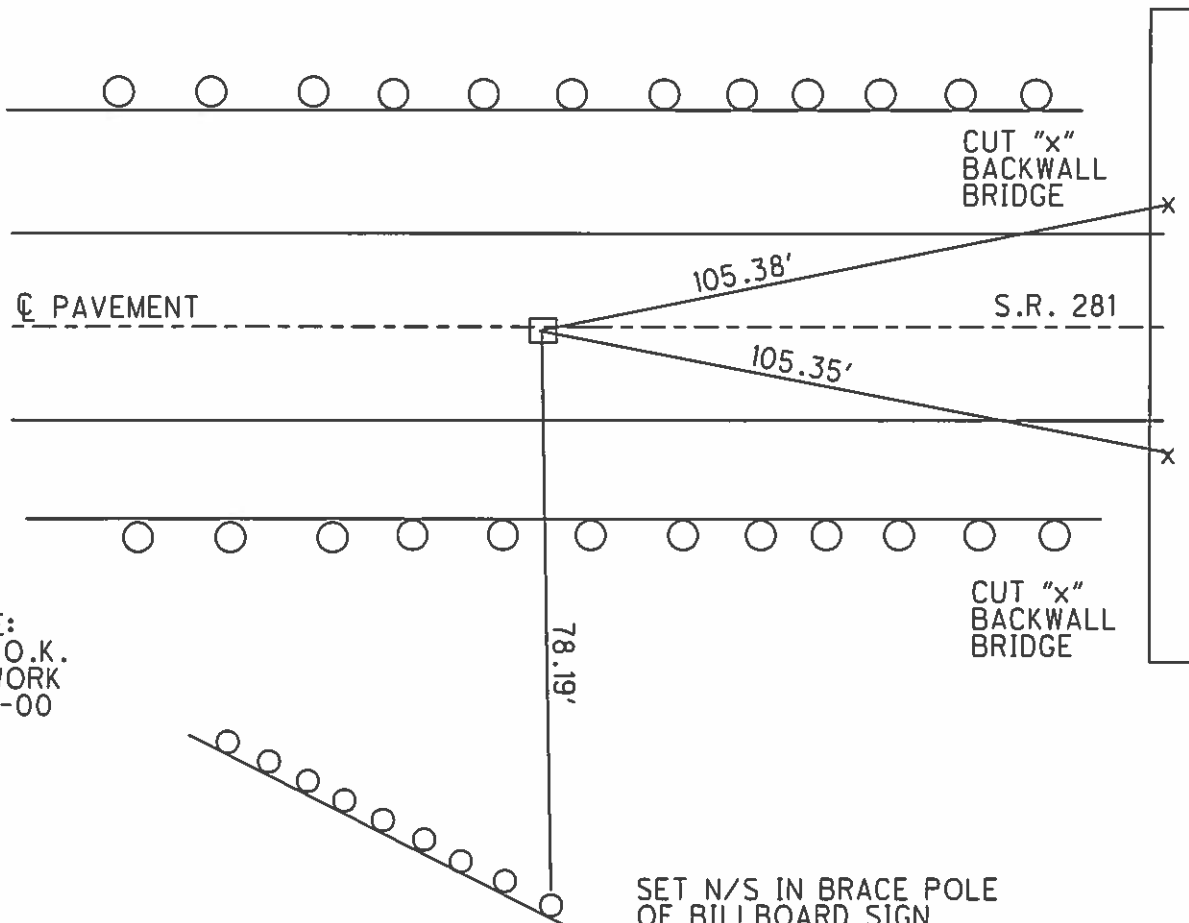

NOTE:
BOX O.K.
NO WORK
9-27-00

O.D.O.T. DISTRICT 2 SURVEY OFFICE

PERSONNEL

REFERENCE NO. 28-C

SHEET 5 OF 11

NOTES HOFFMAN

H.C. LOGHANS

DATE 6-5-90

ROUTE SR 281

R.C. BARNHILL

WEATHER CLEAR

COUNTY WOOD

TEMP. 68°

TOWNSHIP PORTAGE

SECTION 19

T. 4 N. R. 11 E.


TYPE MONUMENT MONUMENT BOX

ON SURFACE - BELOW YES


LEFT- & PAV'T. - RIGHT YES

11.9 TO RT. EDGE PAVEMENT

S.L.M. 680 + 68

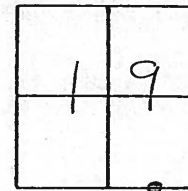

DID NOT OPEN BOX
TIES TO CTR of LID

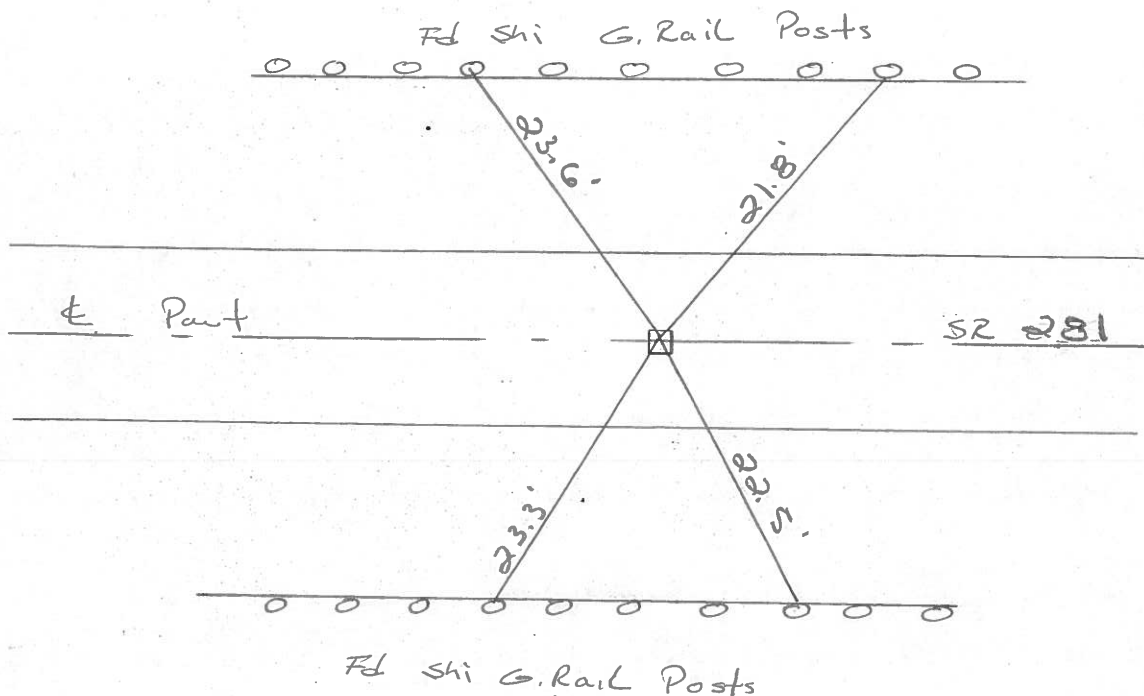

NOTE!
BOX O.K.
NO WORK.
9-27-00

ODOT. DISTRICT 2 SURVEY OFFICE

SHEET _____ OF _____

County WOOD S.R. 281

Date MARCH 28, 83

Township PORTAGE


Weather OVERCAST - WINDY

Section 19

Temp. +30°

T4N, R11E

Personnel HOFFMAN

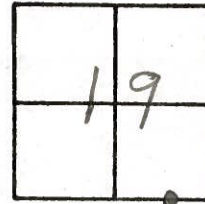

LOHRKE

HOUSEHOLDER


BARNHISEL

26-0

Fd ☐ MON. BOX @ SURFACE 5/25/83
ON PAUT

SLM 681+15

DID NOT OPEN BOX -
TIES TO CTR OF RD.

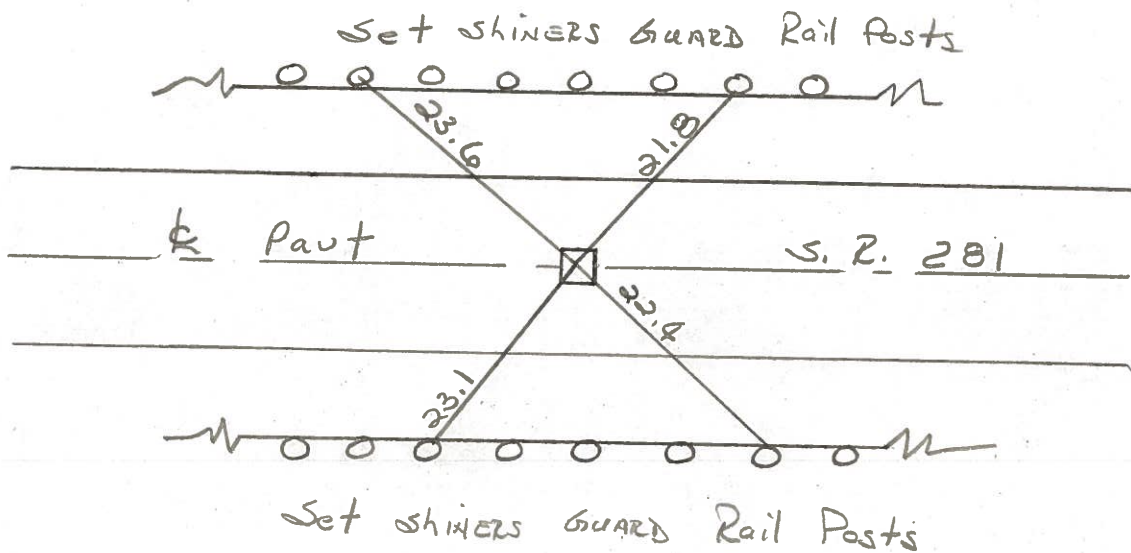

ODOT. DISTRICT 2 SURVEY OFFICE

SHEET _____ OF _____

County WOOD S.R. 281

Township PORTAGE

Section 19

T4N, R11E

Personnel HOFFMAN

LOEHRKE

HOUSEHOLDER


BARNHISEL

26-0

Date MARCH 28, 83

Weather OVERCAST - WINDY

Temp. +30°

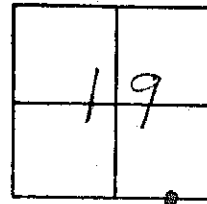





Fd ☐ MON. Box @ SURFACE 5/25/83
ON PAUT

SLM 681+15

DID NOT OPEN BOX -
TIES TO CTR OF LID.

680+68
ONE
11.9 R+67

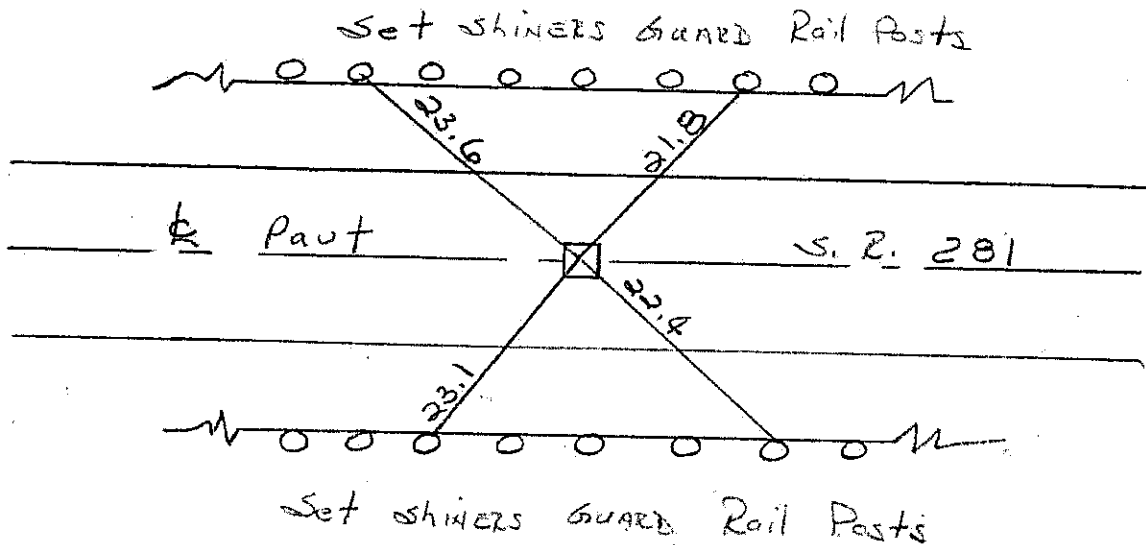

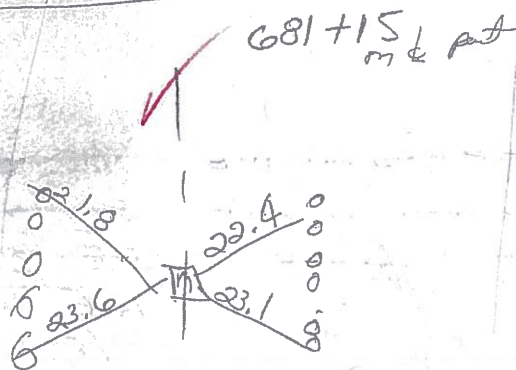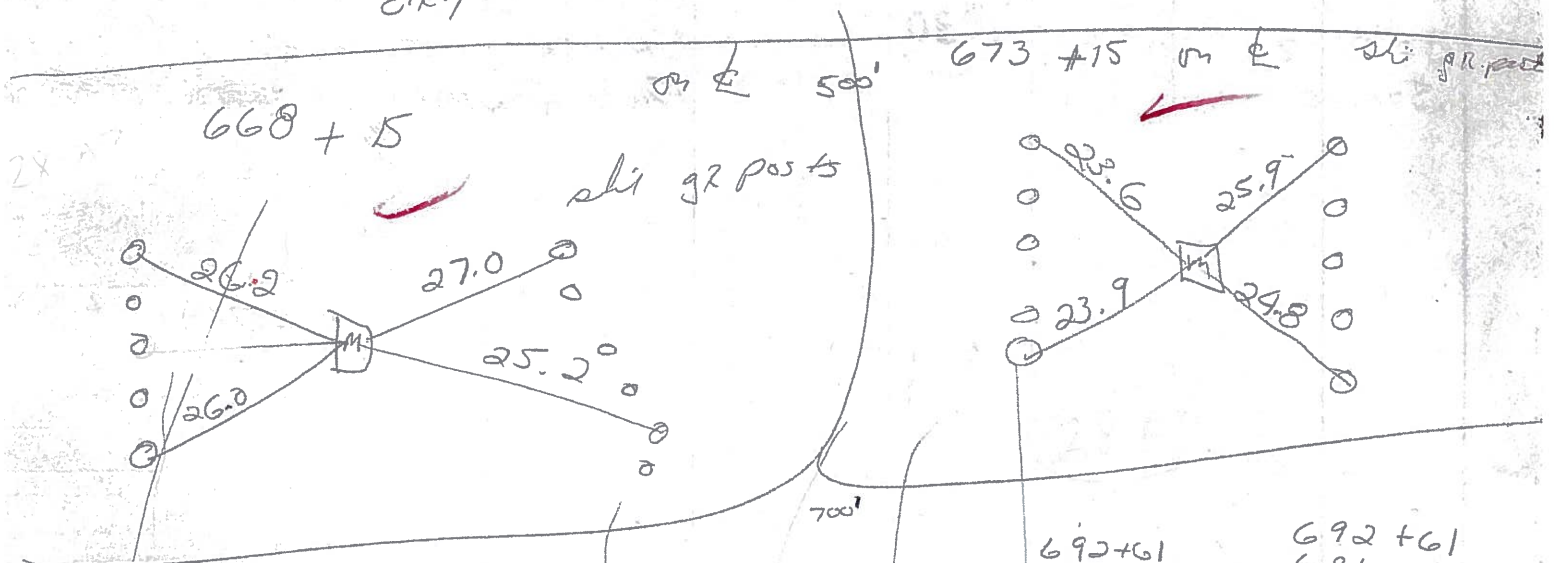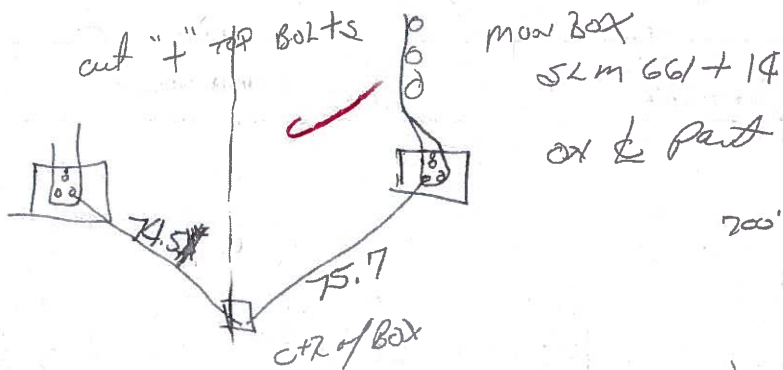

28-C

$$\begin{array}{r} 692 + 61 \\ 661 + 14 \\ \hline 31 + 47 \end{array}$$

$$36 + 40$$

$$\begin{array}{r} 692 + 61 \\ 681 + 15 \\ \hline 11 + 46 \end{array}$$

$$\begin{array}{r} 692 + 61 \\ 668 + 15 \\ \hline 24 + 46 \end{array}$$