

O.D.O.T. DISTRICT 2 SURVEY OFFICE (USE ONLY)

PERSONNEL

REFERENCE NO. 30

SHEET 21 OF 36

NOTES PRESTON-COLVIN

DATE 8/2/24

ROUTE SR 281

H.C. ASTON

WEATHER CLOUDY

COUNTY WOOD

R.C. NEISE

TEMP. 73°

TOWNSHIP PORTAGE

SECTION 20

DWG BY PRESTON-COLVIN PID CHIP SEAL

T 4 N R 11 E

TYPE MONUMENT SHANK

ON SURFACE - ~~BELOW~~ ON

OFFSET 13.6' TO RT. EDGE PAVEMENT LT : ~~RT~~

STATION: 718+62

HORIZ.DATUM: NAD83 2011


GEOID: NAVD88 2018

GRID: NORTHING: 590687.234

EASTING: 1660250.213

LDP: NORTHING: 412633.15

EASTING: 171846.05

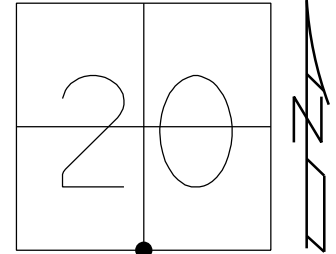

SET P.K./WASHER
7-2-90, SWH

FD PK/WASHER
7-8-04, RGN


FD P.K.NAIL
GPS, REF30

SET MAG/WASHER
GPS, NEWREF30
1/7/13, DCH

FD SHANK
REF30
8-2-24, TDN

SET MAG/WASHER
10-4-24, TDN

RECORD:
FD P.K.NAIL
SET BY OTHERS
6/5/90, CL

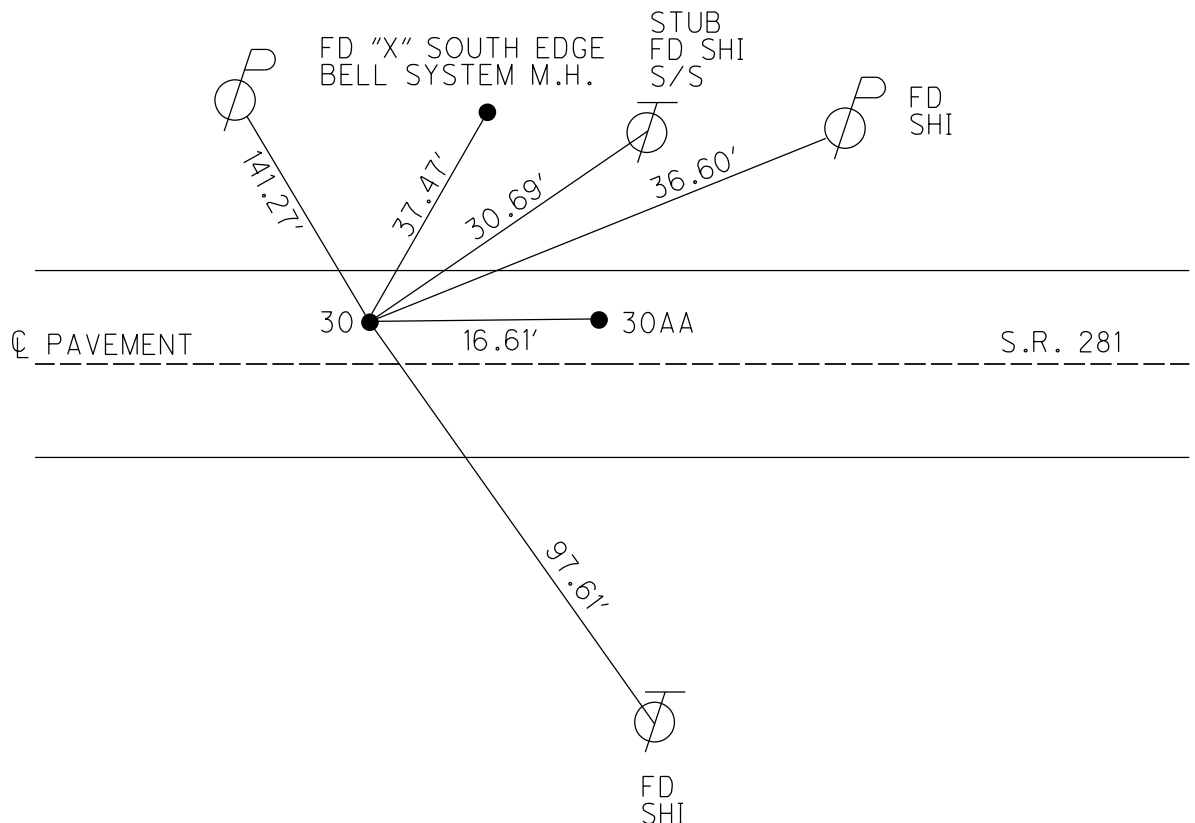

O.D.O.T. DISTRICT 2 SURVEY OFFICE (USE ONLY)

PERSONNEL

REFERENCE NO. 30

SHEET 21 OF 25

NOTES NUHFER

DATE 5-25-04

ROUTE S.R. 281

H.C. HOMAN

WEATHER CLEAR

COUNTY WOOD

R.C. ADKINS

TEMP. +68°

TOWNSHIP PORTAGE

SECTION 20

T 4 N R 11 E

TYPE MONUMENT P.K./WASHER


ON SURFACE - ~~BELOW~~ YES

LEFT - Q PAV'T ~~RIGHT~~ 2.7'

13.6' TO RT. EDGE PAVEMENT

S.L.M. 718+62

Grid: Northing: _____ Easting: _____

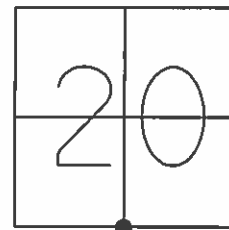


SET P.K./WASHER
7-2-90 SWH

FD PK/WASHER AND PK
RGN
7-8-04

RECORD:

STA 78+86.0
SV4 POST SEC. 20
DELTA = 0°-22'-30" RT.
STONE - R.R. SPIKE

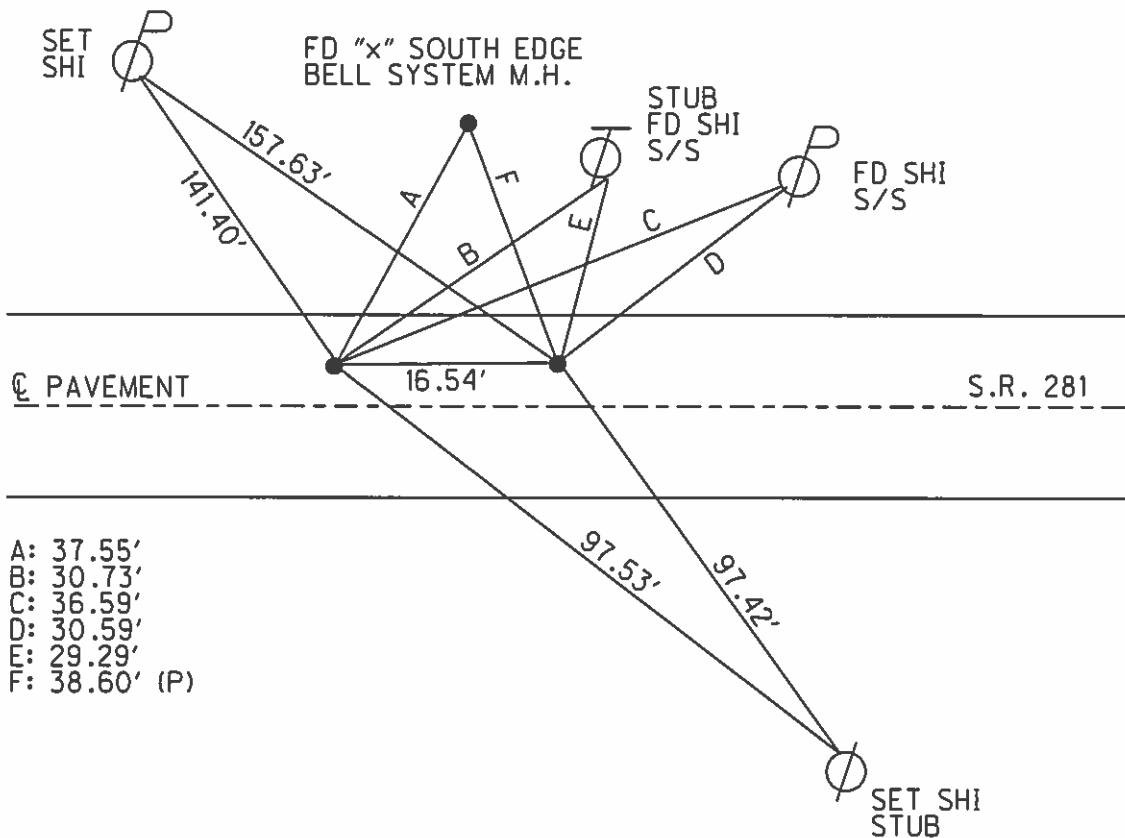

O.D.O.T. DISTRICT 2 SURVEY OFFICE

PERSONNEL

REFERENCE NO. 30

SHEET 7 OF 11

NOTES HOFFMAN

H.C. LOSHKOW

R.C. BARNHISEL

DATE 6-5-90

WEATHER CLEAR

TEMP. 68°

ROUTE SR 281

COUNTY WOOD

TOWNSHIP PORTAGE

SECTION 20

T 4 N R 11 E


TYPE MONUMENT P.K. / WASHER

ON SURFACE - BELOW YES

LEFT - C PAV'T. - RIGHT 3.1

7.5 TO LT. EDGE PAVEMENT

S.L.M. 718 + 62

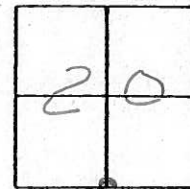

Set P.K. / WASHER
7-2-90 SWA


RECORD:

Sta. 78 + 86.0

SV4 Post Sec. 20

$\Delta = 0^\circ - 22' - 30''$ R.T.

STAKE - R.R. SPR

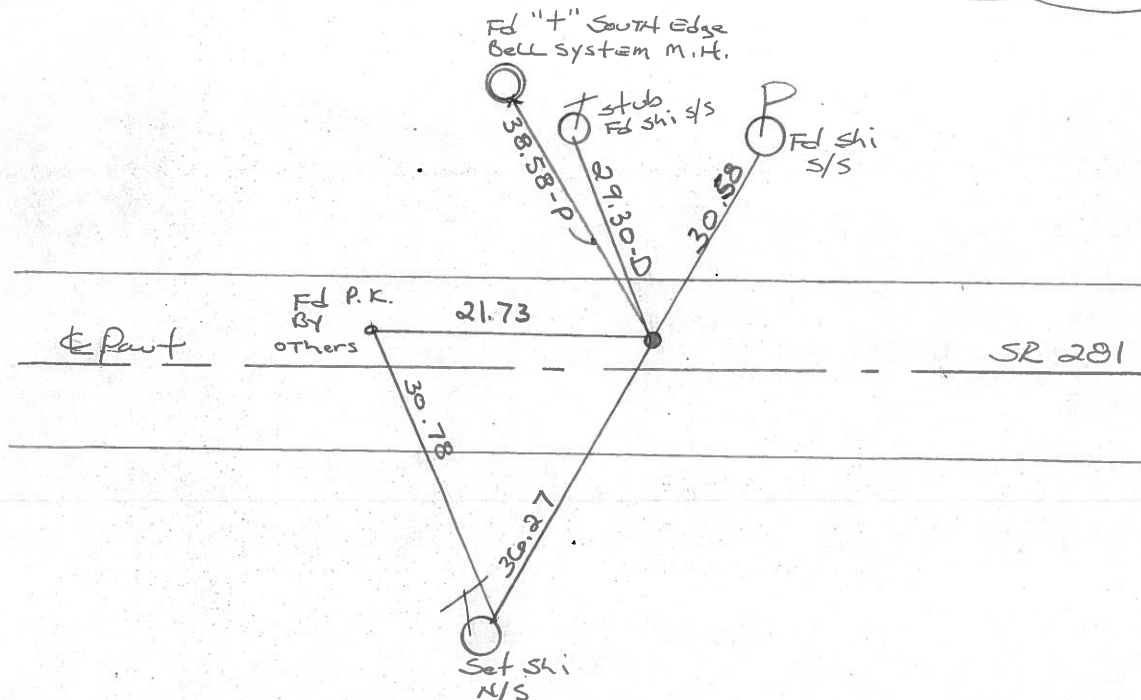

Q.D.O.T. DISTRICT 2 SURVEY OFFICE

SHEET _____ OF _____

County Wood S.R. 281

Township PORTAGE

Section 20

T4N, R1E

Personnel Hoffman

HOUSEHOLDER


LOEHMKE

BARNHISEL

Date April 7, 83

Weather RAIN

Temp. +45°

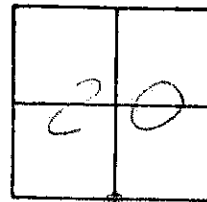

#30

Fd R.R. SPK @ SURFACE

3.4' Lt. of & Post.

5.9' TO N.E.P.

12.3' TO S.E.P.

SET P.K./WASHER
5/25/83
S.W.H.

SLM 718 + 84

Record!

STA. 78 + 86.0

1/4 Post Sec 20

$\Delta = 0^{\circ} - 22' - 30''$ Rt

STOXIE - R.R. SPK

3.1' Lt

7.5' Lt EP

718 + 82

PK/WASHER


cut "t"
South Edge
Rim M.H.

bell system m.H.

cable MARKER

set shi
s/s

Fd shi s/s

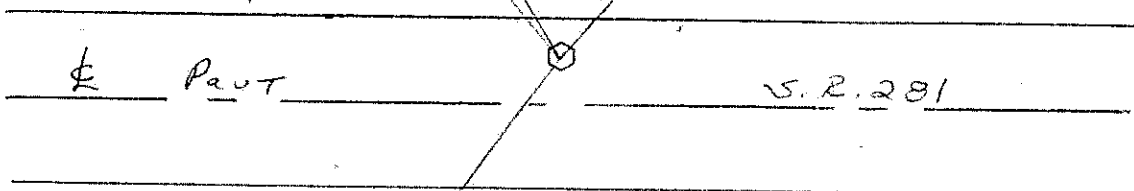

36.21

Fd shi N.E.P.

pde is leaning & loose