

O.D.O.T. DISTRICT 2 SURVEY OFFICE (USE ONLY)

PERSONNEL

REFERENCE NO. 30-A

SHEET 23 OF 36

NOTES PRESTON-COLVIN

DATE 8/2/24

ROUTE SR 281

H.C. ASTON

WEATHER CLOUDY

COUNTY WOOD

R.C. NEISE

TEMP. 73°

TOWNSHIP PORTAGE

SECTION 20

DWG BY PRESTON-COLVIN

PID CHIP SEAL

T 4 N R 11 E

TYPE MONUMENT MAG/WASHER

ON SURFACE - ~~BELOW~~ ON

OFFSET Q PAVEMENT 0.8' ~~LF~~ : RT

9.9' TO RT EDGE PAVEMENT

STATION: 733+27.30

HORIZ.DATUM: NAD83 2011


GEOID: NAVD88 2018

GRID: NORTHING: 590670.863

EASTING: 1661592.040

LDP: NORTHING: 412634.48

EASTING: 173188.01

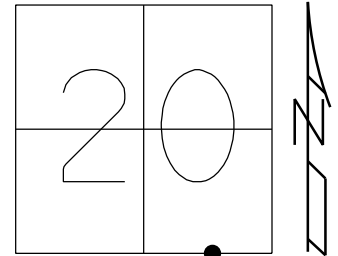

POINT NOT ESTABLISHED BY O.D.O.T.


SET P.K./WASHER
7-2-90, SWH

FD PK/WASHER
7-8-04, RGN

FD P.K.NAIL
GPS, REF32

SET MAG/WASHER
GPS, NEWREF32
1/7/13, DCH

FD MAG/WASHER
REF30-A
8-2-24, TDN

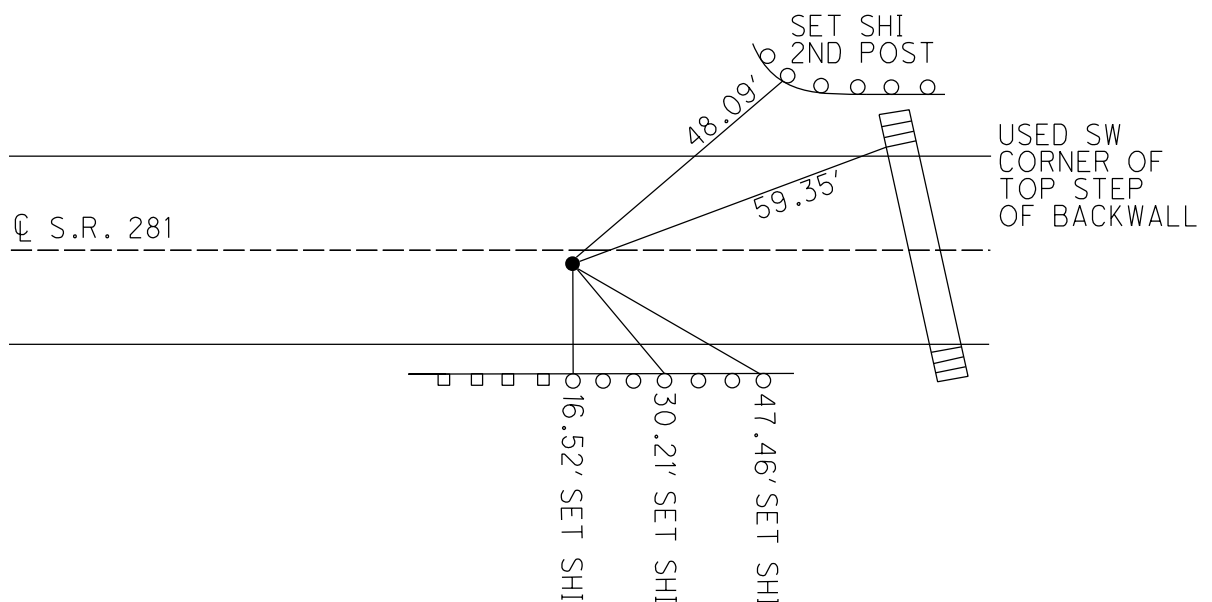

O.D.O.T. DISTRICT 2 SURVEY OFFICE (USE ONLY)

PERSONNEL

REFERENCE NO. 31

SHEET 23 OF 25

NOTES NUHFER

DATE 5-25-04

ROUTE S.R. 281

H.C. HOMAN

WEATHER CLEAR/CLOUDY

COUNTY WOOD

R.C. ADKINS

TEMP. +68°

TOWNSHIP PORTAGE

SECTION 21

T 4 N R 11 E

TYPE MONUMENT MON. BOX w/ 1" IRON PIN


ON SURFACE - ~~BELLOW~~ YES

LEFT - CL PAV'T ~~RIGHT~~ 1.0'

12.1' TO RT. EDGE PAVEMENT


S.L.M. 744+39

Grid: Northing: _____ Easting: _____

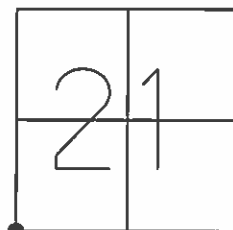

FD MON BOX
SURFACE MICROSURFACE
7-8-04 RGN

RECORD:
STA 104+85.9
SW COR. SEC. 21
DELTA = 1°-20' RT.
(MON. BOX "IN SIGHT")

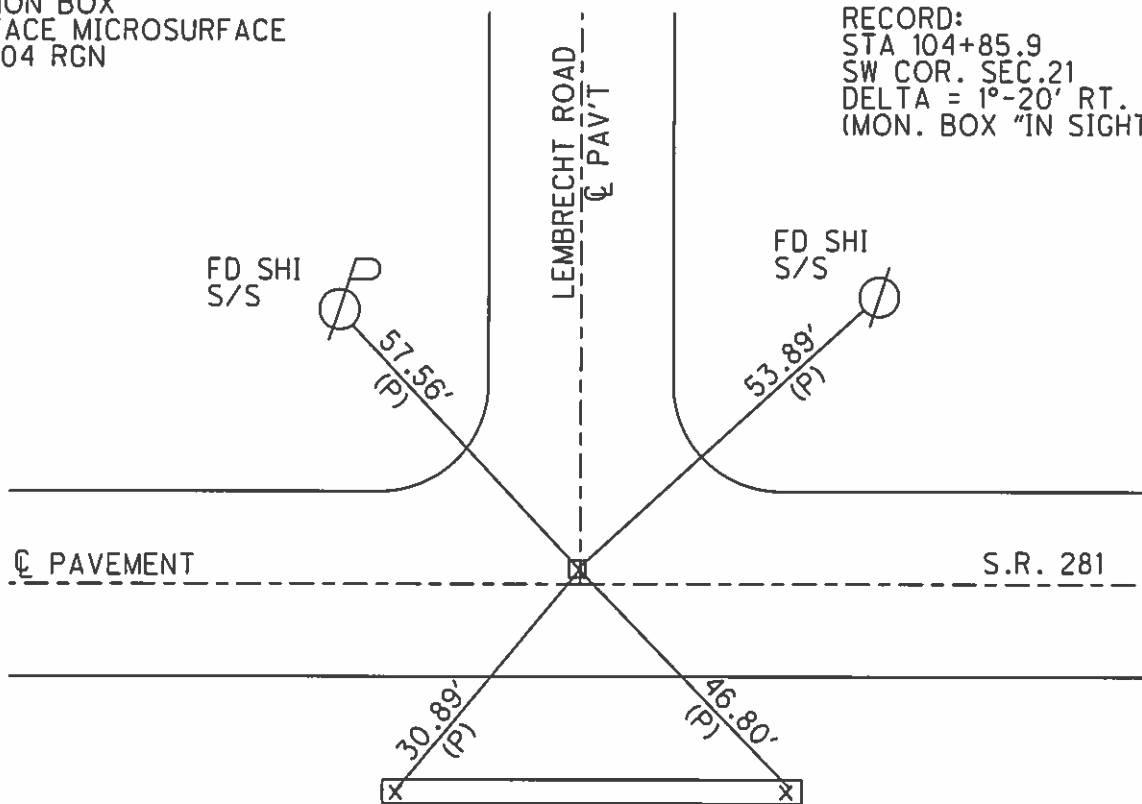

RE-CUT "X" TOP BOTH ENDS
30" RCP UNDER DRIVE

NOTE:
RE-SET WITH
NEW BOX
9-27-00

O.D.O.T. DISTRICT 2 SURVEY OFFICE

PERSONNEL

REFERENCE NO. 31

SHEET 9 OF 11

NOTES HOFFMAN

H.C. LOCHRIE

DATE 6-5-90

ROUTE SR 281

R.C. BARNHISEL

WEATHER CLEAR

COUNTY WOOD

TEMP. 68°

TOWNSHIP PORTAGE

SECTION 21

T4 NR 11 E


TYPE MONUMENT MONUMENT BOX

ON SURFACE - BELOW YES

LEFT - PAV'T. - RIGHT 1.6

12.5 TO RT EDGE PAVEMENT

S.L.M. 744+39

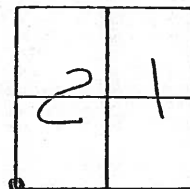

DID NOT OPEN BOX
TIES TO CTR. of LID


RECORD!

STA. 104+85.9

SW COR. SEC. 21

$\Delta = 1^{\circ}-20' RT$

(MON. BOX "IN SIGHT")

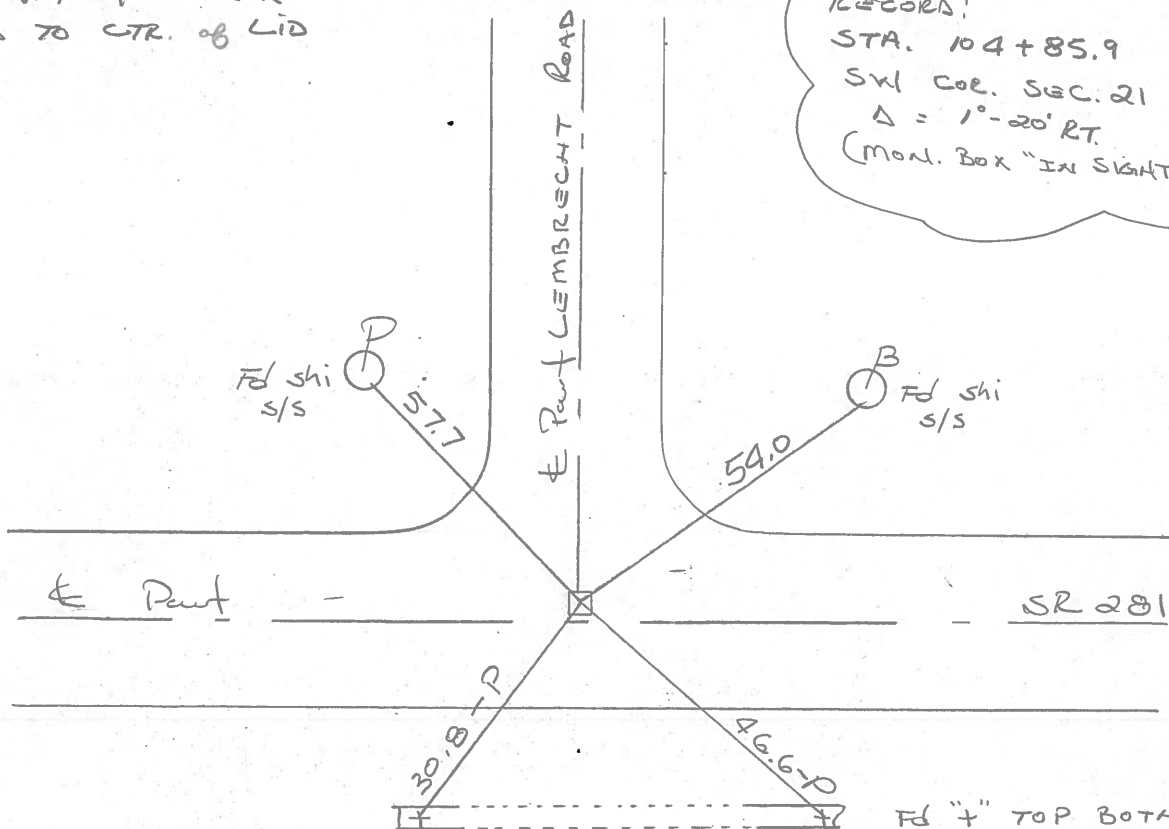

FD "4" TOP BOTH ENDS
30" R.C.P. UNDER DRIVE

NOTE!
Re-set with
New Box.
9-27-00

Q.D.O.T. DISTRICT 2 SURVEY OFFICE

SHEET _____ OF _____

County WOOD S.R. 281

Date April 7, 83

Township PORTAGE


Weather RAIN

Section 21

Temp. +45°

T4N, R11E

Personnel HOFFMAN

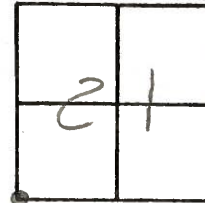

HOUSEHOLDER

LOEHRKE


BARNHISEL

#31

Fd ☐ MON. Box @ SURFACE ✓ 5/25/83
DID NOT OPEN BOX
TIES TO CTR of BOX
1.2' Lt of & PAUT SR281
10.8' TO S.E.P.

SLM 744+85

Record:
STA. 104+85.9
SW COR sec 21
Δ = 10-20' RT
MON. Box "IN SIGHT"

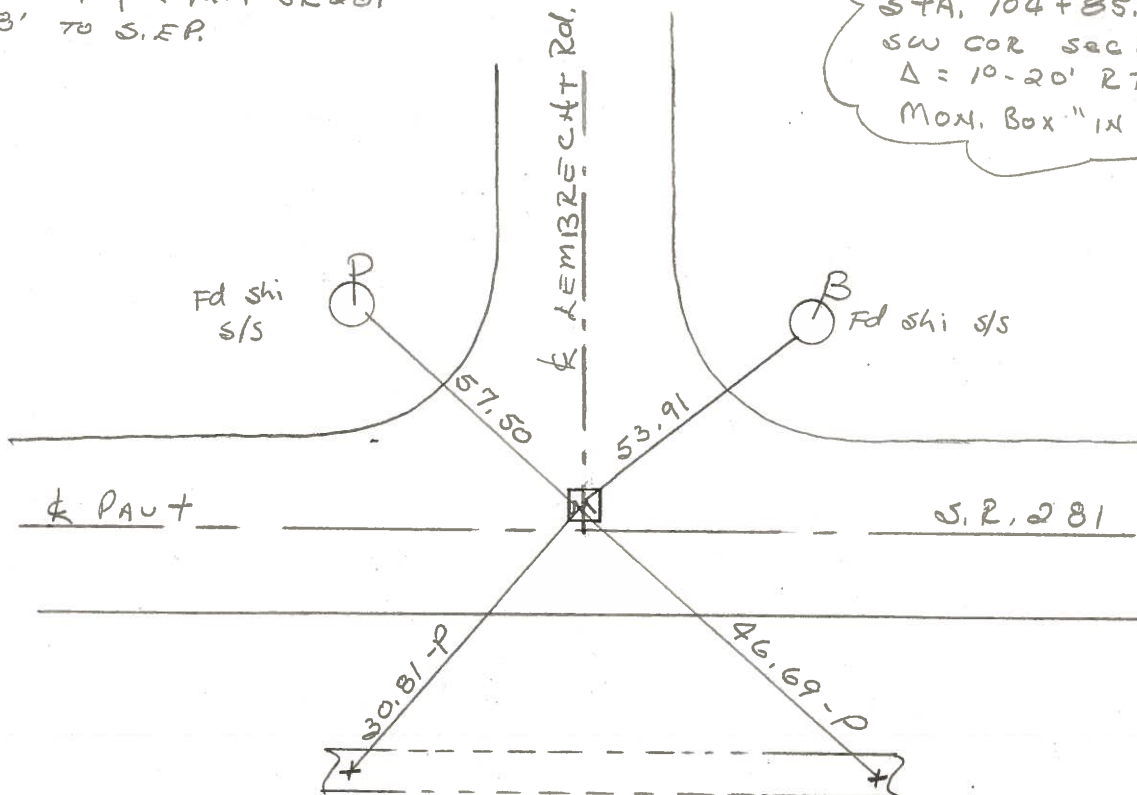

Fd "t" TOP E & W ENDS
of 30" CONC PIPE

PERSONNEL	TITLE	PERSONNEL	TITLE	COUNTY	DATE	WEATHER
CK. BY				WOOD	OK-8-17-69	
SILVESTER				S. R. #281		
BURNSIDE				SEC. 21		
SMITH						

DESCRIPTION CONTROL TIES

LEFT CENTER LINE RIGHT

JOB NO.

STA. 131+23.3
 5 1/4 Post SEC. 21
 PORTAGE TWP.
 R.R. Spk.
 $\Delta = 0^\circ - 16' \text{ LT.}$

#171

MEARS ROAD


Bent opp

#32

NEW
TIES

"X" IN 2ND STONE DOWN FROM TOP
 @ W. END S. CULVERT WALL S.W. 29.27'
 "X" IN 4TH STONE DOWN FROM TOP @
 W. END N. CULVERT WALL N.W. 30.45'

S.W. COR. MASONRY HOWL. N.W. 30.63'
 N.W. COR. MASONRY HOWL S.W. 29.36'
 N.E. COR. MASONRY HOWL S.S.W. 26.13'
 S.E. COR. MASONRY HOWL N.N.W. 26.56'

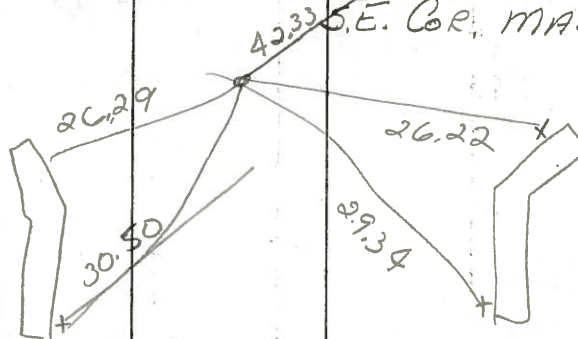

SLM 771+23
 0.5' RT &
 9.9 N &
 9.0 S &


STA. 104+85.9
 S.W. COR. SEC. 21
 PORTAGE TWP.
 $\Delta = 1^\circ - 20' \text{ RT.}$
 MON. BOX "IN SIGHT"

#31

"+" TOP E. END 30" TILE S.E. 46.63' (D)
 "+" TOP W. END 30" TILE S.W. 30.75' (P)
 SHI. IN GUY POLE N.E. 53.95'
 R.R. Spk. IN P. POLE N.W. 57.43'

LEMBRECHT ROAD

#170

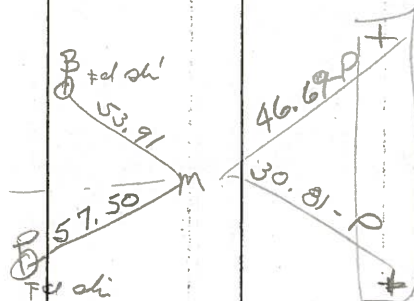

1.2 2' &
 10.8 SEP
 SLM

+85

did not open box

PERSONNEL TITLE PERSONNEL TITLE

CK. BY

COUNTY WOOD

DATE OK-B-11-69

SILVESTER

S. R. #281

WEATHER

BURNSIDE

SEC. 21

TEMP.

SMITH

DESCRIPTION

CONTROL TIES

JOB NO.

LEFT

CENTER LINE

RIGHT

STA. 131+23.3

S 1/4 Post SEC. 21

PORTAGE Twp.

R.R. Spk.

 $\Delta = 0^\circ - 16' \text{ LT.}$

#171

MEARS ROAD

NEW
TIES

#32

"X" IN 2ND STONE DOWN FROM TOP
@ W. END S. CULVERT WALL S.W. 29.27'
"X" IN 4TH STONE DOWN FROM TOP @
W. END N. CULVERT WALL N.W. 30.45'

S.W. COR. MASONRY HOWL. N.W. 30.63'

N.W. COR. MASONRY HOWL. S.W. 29.36'

N.E. COR. MASONRY HOWL. S.S.W. 26.13'

S.E. COR. MASONRY HOWL. N.N.W. 26.56

STA. 104+85.9

S.W. COR. SEC. 21

PORTAGE Twp.

 $\Delta = 1^\circ - 20' \text{ RT.}$

MON. BOX "IN SIGHT"

#170

LEMBRECHT ROAD

" + " TOP E. END 30" TILE S.E. 46.63' ^(D)" + " TOP W. END 30" TILE S.W. 30.75' ^(P)

SHI. IN GUY POLE N.E. 53.95'

R.R. SPK. IN P. POLE N.W. 57.43'

PERSONNEL

TITLE

PERSONNEL

TITLE

COUNTY Wood.DATE April 28, 1969S. R. #281WEATHER Cloudy.SEC. Dixie East.TEMP +70°DESCRIPTION Ties to Control Points


JOB NO. _____

LEFT


CENTER LINE

RIGHT


(29)
NE Cor Sec #30 Portage Twp.
Cor. SE #281 & Solether Road.

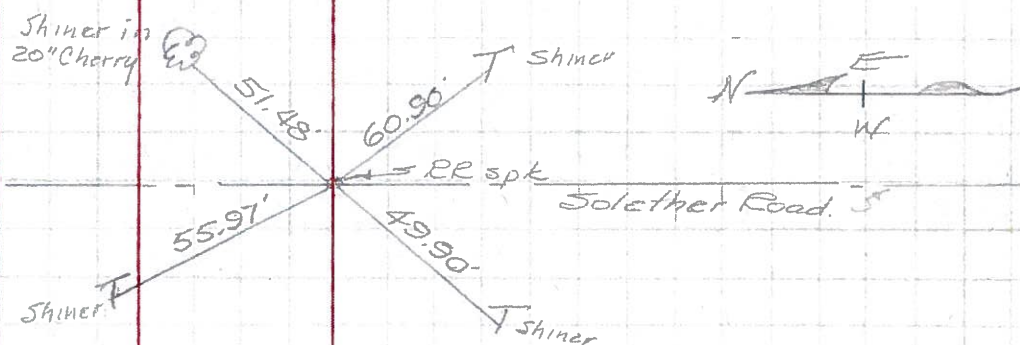

(30)
N 1/4 Sec #29 Portage Twp.

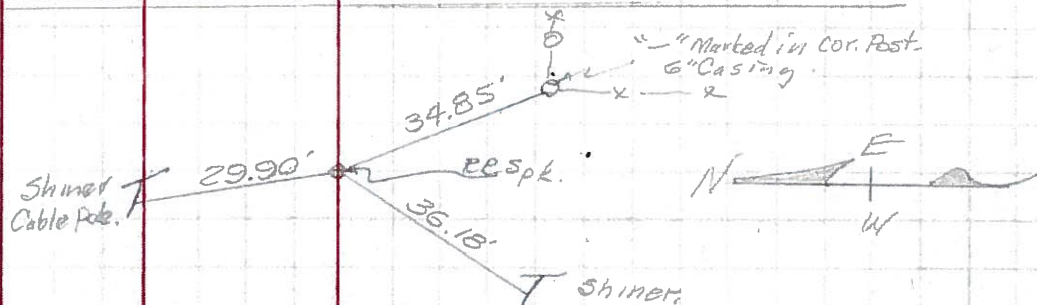

(31)
NE Cor. Sec. #29 portage twp.
Lembrecht Road.

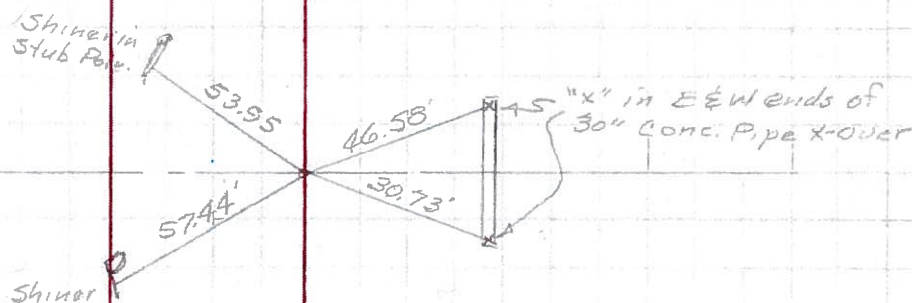

PERSONNEL TITLE PERSONNEL TITLE

COUNTY Wood

DATE OK 12-5-57

3-29-60

S. R. #281

WEATHER Snow

8-24-62

SEC. H, I, B & A

TEMP. Moore/so

10-31-62

DESCRIPTION

LEFT

CENTER LINE

RIGHT

JOB NO. S. Ivester 2-28-64

Resurfaced 10-62

No. 167

S.E. cor. sec. 19 Portage

S.E. #281 & So. leather Ed.

R.R. spike - Iron Pin Ed. OK

Set. R.R. Spk. 11-1-62

(29)

#168

Shiner 12" cherry

N.E.

51.5

Power Pole

S.W.

43.5

Conc. man.

S.E. 51.32' 51.2

U.S.G.S. man.

N.E.

42.6

Face iron Cor. post

N.E. 46.62' 46.6

Shiner in T. Pole

E.S.E.

60.9

Shiner in T. Pole

S.S.W.

43.5

Sta. 78+8.1

S.W. pos sec. 2 Portage

Twp. Stone - R.R. Spk. Set 11/1/62

 $\Delta = 0^\circ - 22\frac{1}{2}'$ Pt.

OK

Shiner in T.P.

S.W.

36.1

Cable pole

N.W.

29.4

X in 6" steel cor. post S.E. 34.82' 34.8

Shiner in P.P.

N.E.

30.5

Face of 6" steel Br. post S.E. 38.12

E.S.E. 38.00

Sta. 104+85.9

S.W. cor. sec. 1 Portage OK

Twp. Set. R.R. Spk. over Stone 11-1-62

 $\Delta = 10^\circ - 20'$ Pt. Fd. large

Lembrecht Rd Iron Pin 4" below Part.

P. Pole

N.W.

36.4

Br. Pole

N.E. 47.75' 47.7

S.W. cor. S.W. Hdw. S.W. P. 32.1

S.E. cor. S.E. Hdw. S.E. 31.6

Shiner in P.P. S.W. 42.15' 42.2

(31)

#170

Q.D.O.T. DISTRICT 2 SURVEY OFFICE

SHEET _____ OF _____

County WOOD S.R. 281

Township PORTAGE

Section 21

T4N, R11E

Personnel HOFFMAN

HOUSEHOLDER

LOHRKE


BARNHISEL

#31

Date April 7 93

Weather RAIN

Temp. +45°

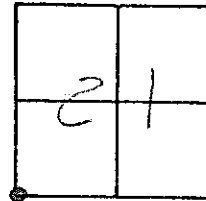

Fd ☐ MON. BOX @ SURFACE ✓ 5/25/93

DID NOT OPEN BOX

TIES TO CTR of BOX

1.2' LT of & PAUT SR 281

10.8' TO S.E.P.

SLM

744+85

Record!

STA. 104+85.9

SW COR SEC 21

Δ = 10.20' RT

MON. BOX "IN SIGHT"

744+39

1.6' LT of &
surface

12.5' S.E.P.


Fd shi
S/S



LEMBRECHT Rd.



Fd shi S/S

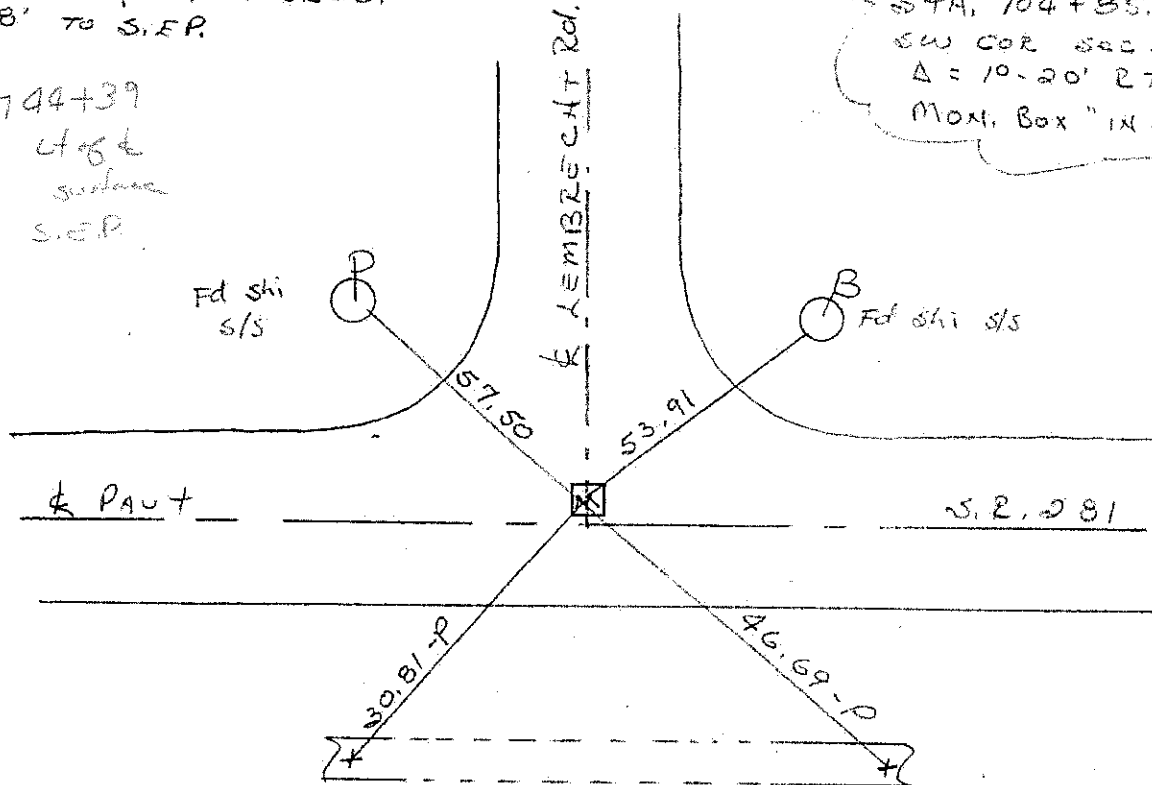

Fd "+" TOP E & W ENDS

of 30" CONC PIPE