

O.D.O.T. DISTRICT 2 SURVEY OFFICE (USE ONLY)

PERSONNEL

REFERENCE NO. 42

SHEET 25 OF 36

NOTES PRESTON-COLVIN

H.C. NIESE

R.C. ASTON

DATE 7/18/24

WEATHER SUNNY

TEMP. 77°

ROUTE SR 281

COUNTY WOOD

TOWNSHIP PORTAGE

SECTION 19

DWG BY BARRIERE PID CHIP SEAL

T 4 N R 12 E

TYPE MONUMENT MAG/WASHER

ON SURFACE - ~~BELOW~~ ON

OFFSET Q PAVEMENT 5.6' RT ~~LT~~ : RT

TO EDGE PAVEMENT

STATION: 1011+28

HORIZ.DATUM: NAD83 2011


GEOID: 18

GRID: NORTHING: 590314.423


EASTING: 1689466.715

LDP: NORTHING: 412645.690

EASTING: 201067.280

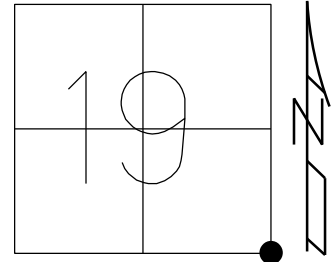

RECORD:
FD SM.R.R.SPIKE
7/1/02, TMR
SET MAG/WASHER
2/20/03, DCH
FD MAG NAIL
REF42
11/15/16, DCH, JLL
SET MAG/WASHER
9/5/19, JLL
FD MAG/WASHER
NEWREF42
7/18/24, TDN

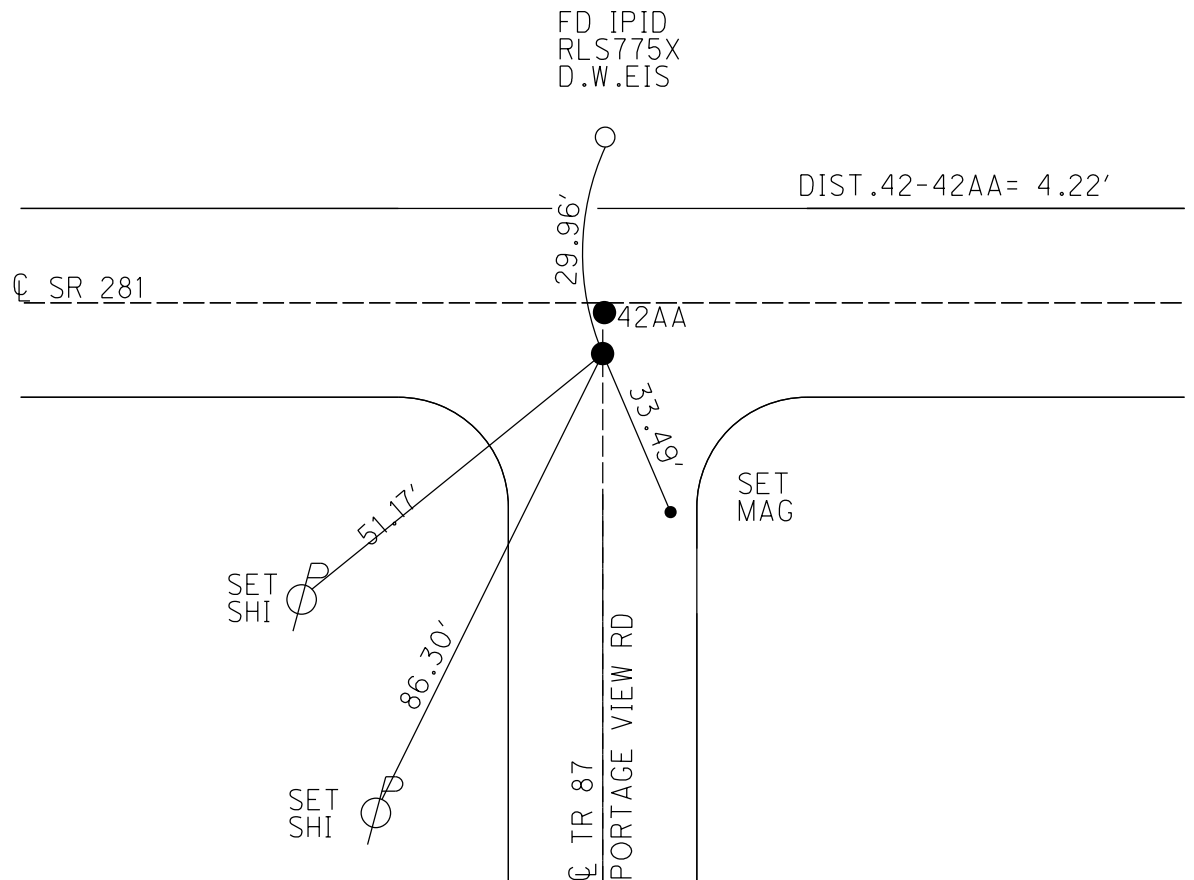

O.D.O.T. DISTRICT 2 SURVEY OFFICE (USE ONLY)

PERSONNEL

REFERENCE NO. 42

SHEET 9 OF 10

NOTES JAMES

DATE 4/25/19

ROUTE SR 281

H.C. LEU

WEATHER SUNNY

COUNTY WOOD

R.C. JAMES

TEMP. 66°

TOWNSHIP MONTGOMERY

SECTION 19

DWG BY NIESE

PID 102824

T 4 N R 12 E

TYPE MONUMENT MAG NAIL

ON SURFACE - ~~BELOW~~ ON

OFFSET Q PAVEMENT 5.6' LT : RT

- TO - EDGE PAVEMENT


STATION: 1011+28

HORIZ.DATUM: NAD83(2011)

GEOID: 2012A

GRID: NORTHING: 590314.428

EASTING: 1689466.738

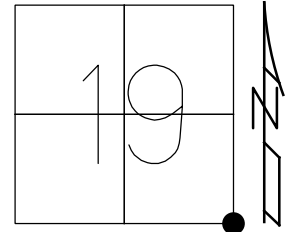

RECORD:

FD SM.R.R.SPIKE

7/1/02, TMR

SET MAG/WASHER

2/20/03, DCH

FD MAG NAIL


REF42

11/15/16, DCH, JLL

SET MAG/WASHER

9/5/19, JLL


FD IPID
RLS775X
D.W.EIS

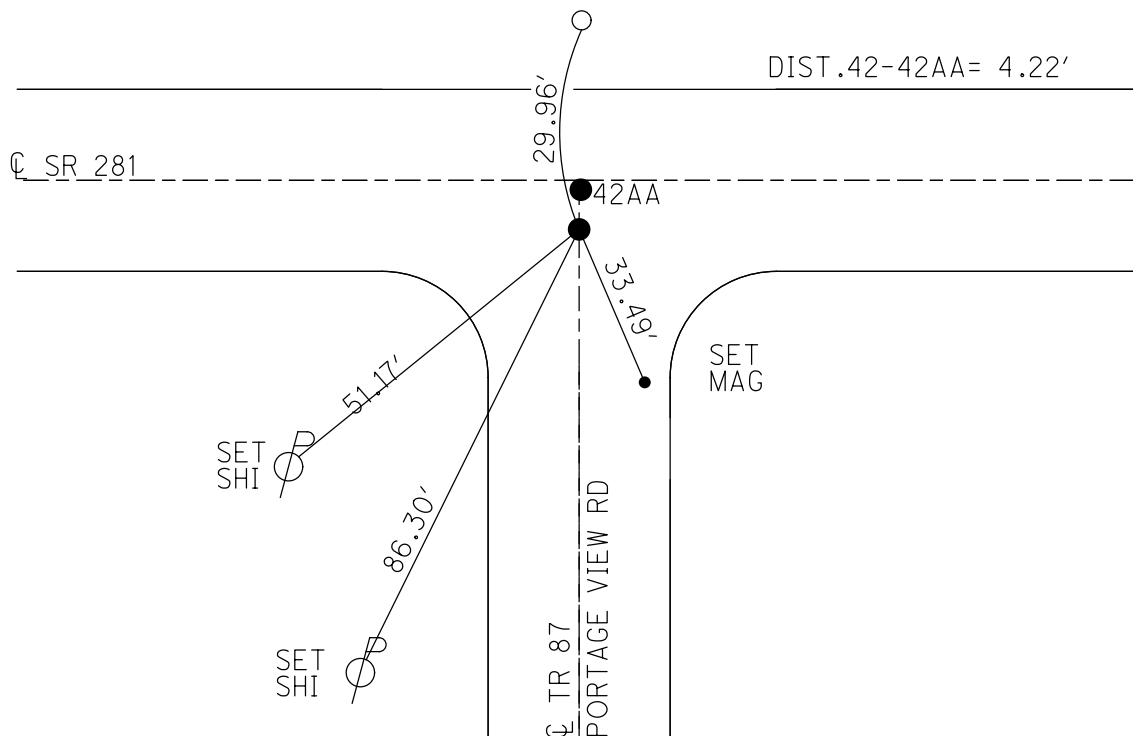

O.D.O.T. DISTRICT 2 SURVEY OFFICE (USE ONLY)


PERSONNEL	REFERENCE NO. <u>42</u>	SHEET <u>9</u> OF <u>9</u>	
NOTES	DATE <u>7/1/02</u>	ROUTE <u>SR 281</u>	
H.C. <u>ROUSOS</u>	WEATHER <u>SUNNY</u>	COUNTY <u>WOOD</u>	
R.C. <u>HOMAN</u>	TEMP. <u>95°</u>	TOWNSHIP <u>MONTGOMERY</u>	
		SECTION <u>19</u>	
		T <u>4</u> N R <u>12</u> E	

TYPE MONUMENT SM.R.R.SPIKE
 ON SURFACE - ~~BELOW~~ ON
~~LEFT~~ - CL PAV'T - RIGHT 4.2'
- TO - EDGE PAVEMENT
 S.L.M. 1011+28

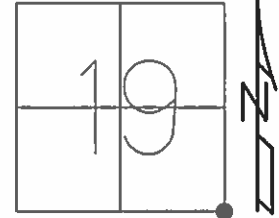

Grid: Northing: _____ Easting: _____

SET MAG/WASHER
2/20/03, DCH

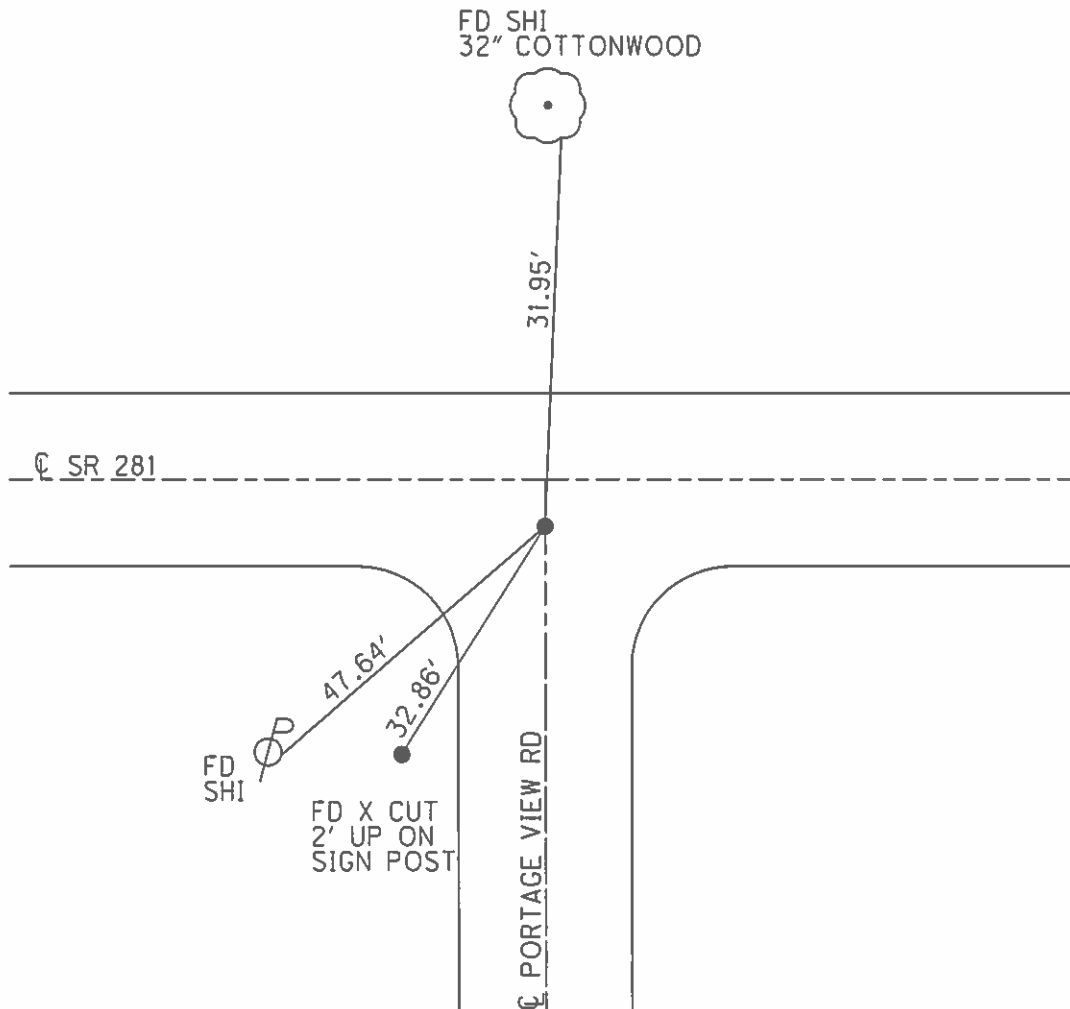

O.D.O.T. DISTRICT 2 SURVEY OFFICE

PERSONNEL

REFERENCE NO. 42

SHEET ____ OF ____

NOTES BARNHISEL

H.C. HOFFMAN

R.C. Sockman

DATE 4-27-87

WEATHER SUNNY

TEMP. +55°

ROUTE 281

COUNTY WOOD

TOWNSHIP MontgomerySECTION 19

T 4 N R 12 E


TYPE MONUMENT Lg RR Spk

ON SURFACE - BELOW 1 1/2"

LEFT - & PAN'T. - RIGHT 4.2

 - JO - EDGE PAVEMENT


S.L.M. 1011 + 28 ON & Por

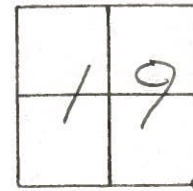

5-6-87
Set Sm RR SpK
MDS

set shi
s/s

32" Cottonwood

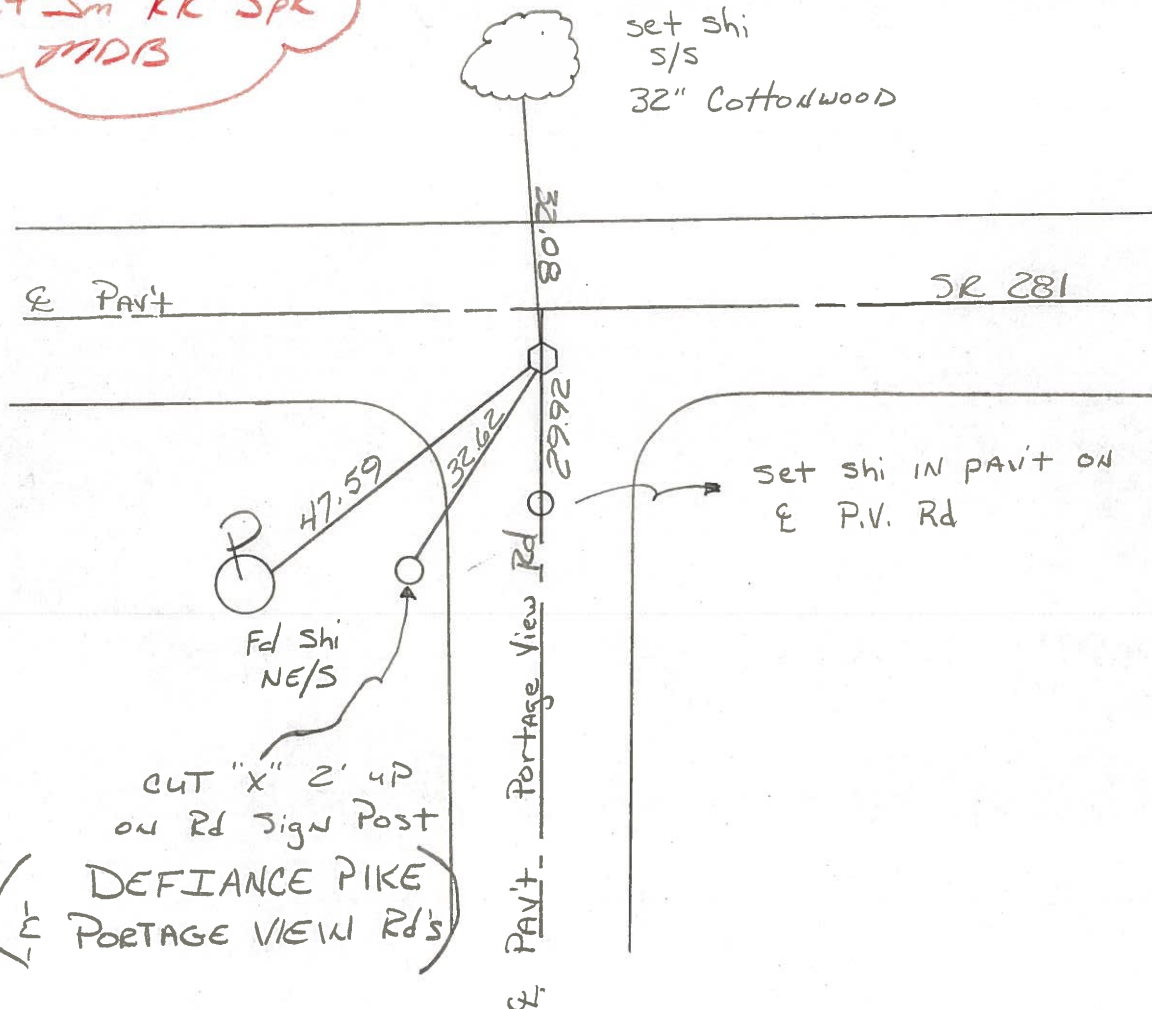

Set shi IN PAVIT ON
£ P.V. Rd

CUT "X" 2' UP
ON Rd Sign Post

(DEFIANCE PIKE
& PORTAGE VIEW RD'S)

HOFFMAN

19.51 To 25.55 - 1984 RESURFACING

SHEET NO. 21

PERSONNEL TITLE PERSONNEL TITLE

COUNTY Wood

DATE OK-8-11-69

S. R. #281

WEATHER

SEC. 29

TEMP

DESCRIPTION

LEFT

CENTER LINE

RIGHT

JOB NO.

N. 1/4 Post SEC. 29
MONTGOMERY Twp.
FD. I. PIN - SET R.R. Spk.

#43

SHINER IN P. POLE S.E. 55.90
SHINER IN T. POLE N.W. 30.56
NEAR EDGE SIGN POST S.S.E. 18.47
NEAR EDGE SIGN POST N.N.E. 17.48
12-12-83 overcast +40°

#182

Fd RR opt surface

RTCP 9.5

LTCP 10.4

0.6 RT &

cut hole

1.5 up

27.26

55.96

1038 + 05

DID NOT DIG

N.W. COR. SEC. 29

MONTGOMERY Twp.

STONE - R.R. Spk.

DID NOT TRY TO LOCATE
DO NOT WANT TO DIG good part.
PORTAGE VIEW ROAD

#42

~~SHINER IN T. POLE N. 28.95~~
~~FD SHINER IN P. POLE S.W. 47.58~~
~~SHINER IN T. POLE S.E. 71.10~~

#181

PERSONNEL TITLE PERSONNEL TITLE

COUNTY Wood

DATE OK-8-11-69

S. R. #281

WEATHER

SEC. 29

TEMP.

DESCRIPTION

LEFT

CENTER LINE

RIGHT

JOB NO.

N. 1/4 Post SEC. 29
MONTGOMERY Twp.
FD. I. PIN - SET R.R. Spk.

#43

SHINER IN P. POLE S.E. 55.90'
SHINER IN T. POLE N.W. 30.56'
NEAR EDGE SIGN Post S.S.E. 18.47'
NEAR EDGE SIGN Post N.N.E. 17.48'

#182

SEE



BEGIN POINT CHECK
12-83 BY S.W.H.

N.W. COR. SEC. 29
MONTGOMERY Twp.
STONE - R.R. Spk.

#42

SHINER IN T. POLE N. 28.95'
SHINER IN P. POLE S.W. 47.58'
SHINER IN T. POLE S.S.E. 71.10'

PORTAGE VIEW ROAD

#181

PERSONNEL TITLE PERSONNEL TITLE

COUNTY

Wood

DATE

OK 12-5-57

S. R.

#281

WEATHER

8-24-62

SEC.

TEMP

Swenson 2-10-64

DESCRIPTION

LEFT

CENTER LINE

RIGHT

JOB NO.

N.W. cor. Sec. 29 Montgomery
Twp. Stone - R.R. spike ~~set~~
Portage View Road.

OK ✓

Shiner in T.P. N. 28.95' 18.32'
~~Shiner in Br. P. S.E. 38.60'~~
Shiner in P.P. S.W. 47.58' 41.95'
Shiner in T.P. S.E. 71.10'

(42)

#181

N/4 post sec. 29 Montgomery
Twp. Found iron pin - Set small
for corner. R.R. Spk.

OK ✓

Shiner in P.P. S.E. 55.90
Shiner in T.P. N.W. 30.53 30.85
~~Shiner in 24" stump S. gone 40.24~~
~~Shiner in 40" oak S. 40.28~~
" " old stump S. 41.22'

(43)

#182

Approximately .35 N.E.
from Angle cor. sec. 20
T-4-N R-12-E. iron pipe ~~Fd.~~
Set R.R. Spk.

OK ✓

N.E. cor. house And. N.W. 76.36
S.E. cor. house Fdn. N.W. 72.22
~~N.E. to shiner in butternut tree (gone) 28.65~~
S.W. To shiner in P. Pole 57.73
N.E. To shiner int. Pole 30.38
Shiner in 12" Maple N. 76.35'

(45)

#184

1013.83 E. of N. 1/4 post
sec. 29 T-4-N R-12-E
Set R.R. spike ~~Fd.~~

OK ✓

Shiner in cor fence post S.E. 28.22
Shiner in 2nd post S. of cor. 78.35
Post S.W. 78.35
Shiner in 3rd post S. of cor. post
S.E. 48.16 48.06

(44)

#183

Shiner in t.P. N.N.W. 46.77 46.71
Shiner in t.P. N.E. 65.70 65.75
Shiner in t.P. S.E. 39.94