

O.D.O.T. DISTRICT 2 SURVEY OFFICE (USE ONLY)

PERSONNEL

REFERENCE NO. 42AA

SHEET 25 OF 36

NOTES PRESTON-COLVIN

H.C. NIESE

R.C. ASTON

DATE 7/18/24

WEATHER SUNNY

TEMP. 77°

ROUTE SR 281

COUNTY WOOD

TOWNSHIP PORTAGE

SECTION 19

DWG BY BARRIERE

PID CHIP SEAL

T 4 N R 12 E

TYPE MONUMENT MAG/WASHER

ON SURFACE - ~~BELOW~~ ON

OFFSET $\varnothing$ PAVEMENT 5.6' RT ~~LT~~ : RT

TO EDGE PAVEMENT

STATION: 1011+28

HORIZ.DATUM: NAD83 2011


GEOID: 18

GRID: NORTHING: 590318.609


EASTING: 1689466.861

LDP: NORTHING: 412649.878

EASTING: 201067.371

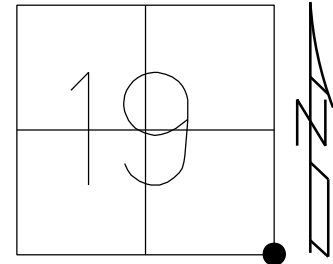

RECORD:
SET MAG/WASHER
2/20/03, DCH
FD P.K.NAIL
11/15/16, JLL
SET MAG/WASHER
9/5/19, JLL
FD MAG/WASHER
NEWREF42
7/18/24, TDN

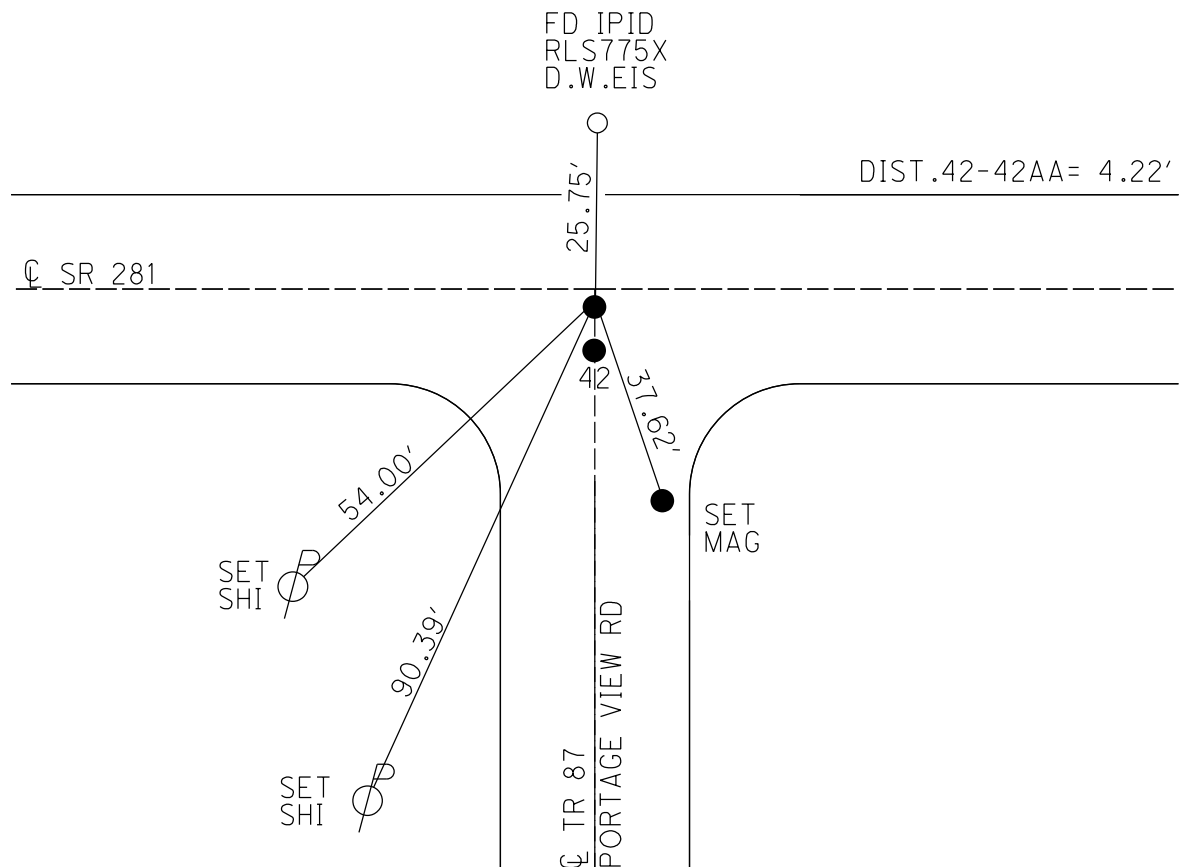

O.D.O.T. DISTRICT 2 SURVEY OFFICE (USE ONLY)

PERSONNEL

REFERENCE NO. 42 AA

SHEET 10 OF 10

NOTES JAMES

DATE 4/25/19

ROUTE SR 281

H.C. LEU

WEATHER SUNNY

COUNTY WOOD

R.C. JAMES

TEMP. 66°

TOWNSHIP MONTGOMERY

SECTION 19

DWG BY NIESE

PID 102824

T 4 N R 12 E

TYPE MONUMENT P.K. NAIL

ON SURFACE - ~~BELOW~~ ON

OFFSET CL PAVEMENT 1.4' ~~LT~~ : RT

- TO - EDGE PAVEMENT


STATION: 1011+28

HORIZ.DATUM: NAD83(2011)

GEOID: 2012A

GRID: NORTHING: 590318.636

EASTING: 1689466.868

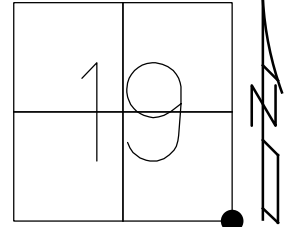

RECORD:
SET MAG/WASHER
2/20/03, DCH
FD P.K.NAIL
11/15/16, JLL
SET MAG/WASHER
9/5/19, JLL

