

O.D.O.T. DISTRICT 2 SURVEY OFFICE (USE ONLY)

PERSONNEL

REFERENCE NO. 43

SHEET 25 OF 36

NOTES PRESTON-COLVIN

DATE 7/18/24

ROUTE SR 281

H.C. NIESE

WEATHER SUNNY

COUNTY WOOD

R.C. ASTON

TEMP. 77°

TOWNSHIP PORTAGE

SECTION 29

DWG BY BARRIERE PID 113719

T 4 N R 12 E

TYPE MONUMENT SM. R.R. SPIKE

ON SURFACE - ~~BELOW~~ 2.5' DOWN

OFFSET $\varnothing$ PAVEMENT 0.3' RT ~~LT~~ : RT

TO EDGE PAVEMENT

STATION: 1038+05

HORIZ.DATUM: NAD83 2011


GEOID: 18

GRID: NORTHING: 590305.318


EASTING: 1692072.229

LDP: NORTHING: 412670.960

EASTING: 203672.898

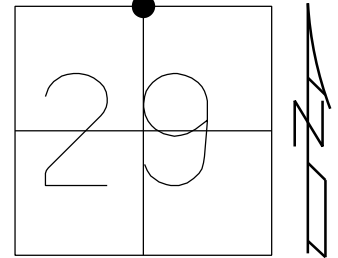

RECORD:
SET P.K./WASHER
9/9/91, MB
FD P.K. SHANK
SV43
11/2/10
FD P.K./WASHER
0.15' DOWN
3/19/12, MC
SET N/SHI
7/24/12
REF 43
7/30/12, MC
FD SM.R.R.SPIKE
2.5" DOWN
REF43
6/14/23, DSA
10/20/23, DSA
7/18/24, TDN

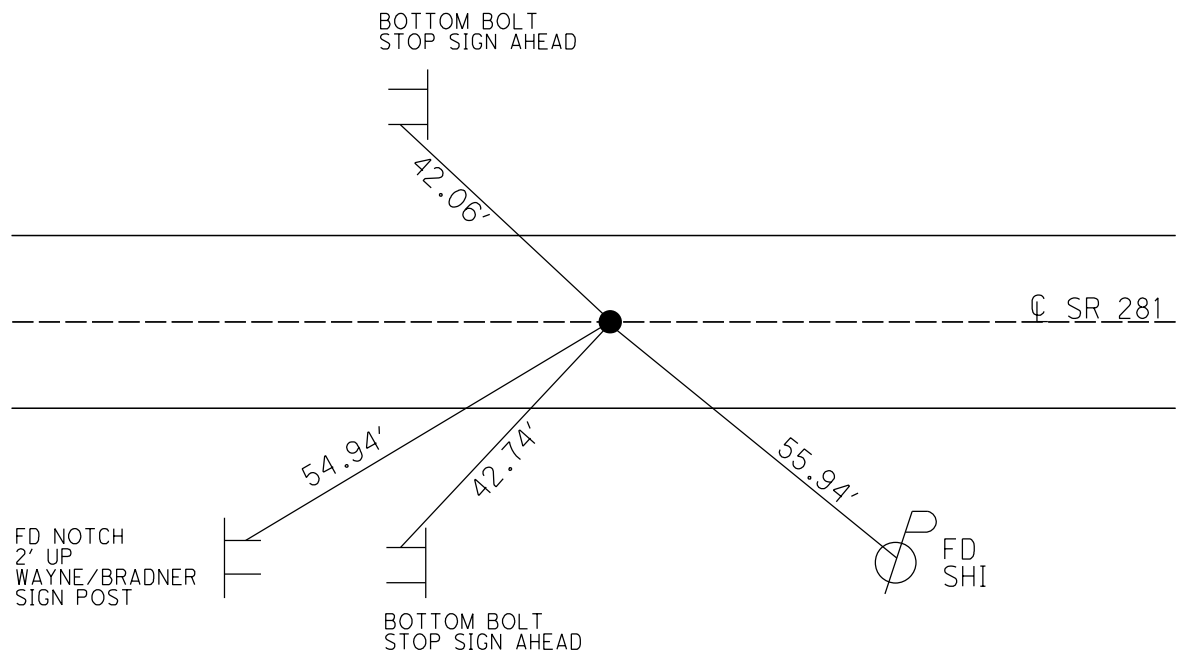

O.D.O.T. DISTRICT 2 SURVEY OFFICE (USE ONLY)

PERSONNEL

REFERENCE NO. 43

SHEET 2 OF 51

NOTES MILLER
H.C. AUBLE
R.C. NIESE
BEJARANO

DATE 6/14/23
WEATHER BREEZY
TEMP. 57°

ROUTE SR 281
COUNTY WOOD
TOWNSHIP MONTGOMERY
SECTION 29
T 4 N R 12 E

DWG BY RHOADES PID CHIP SEAL

TYPE MONUMENT SM.R.R.SPIKE

~~ON SURFACE~~ - BELOW 2.5"

OFFSET CL PAVEMENT 0.3' ~~LT~~ : RT

9.7' TO RT EDGE PAVEMENT


STATION: 1038+05

HORIZ.DATUM: NAD83 2011

GEOID: NADV88 2018


GRID: NORTHING: 590305.308

EASTING: 1692072.245

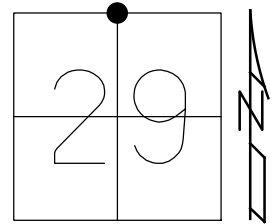

RECORD:
SET P.K./WASHER
9/9/91, MB
FD P.K. SHANK
SV43
11/2/10
FD P.K./WASHER
0.15' DOWN
3/19/12, MC
SET N/SHI
7/24/12
REF 43
7/30/12, MC
FD SM.R.R.SPIKE
2.5" DOWN
REF43
6/14/23, DSA
10/20/23, DSA

WOOD LPD:
N: 412670.951
E: 203672.913

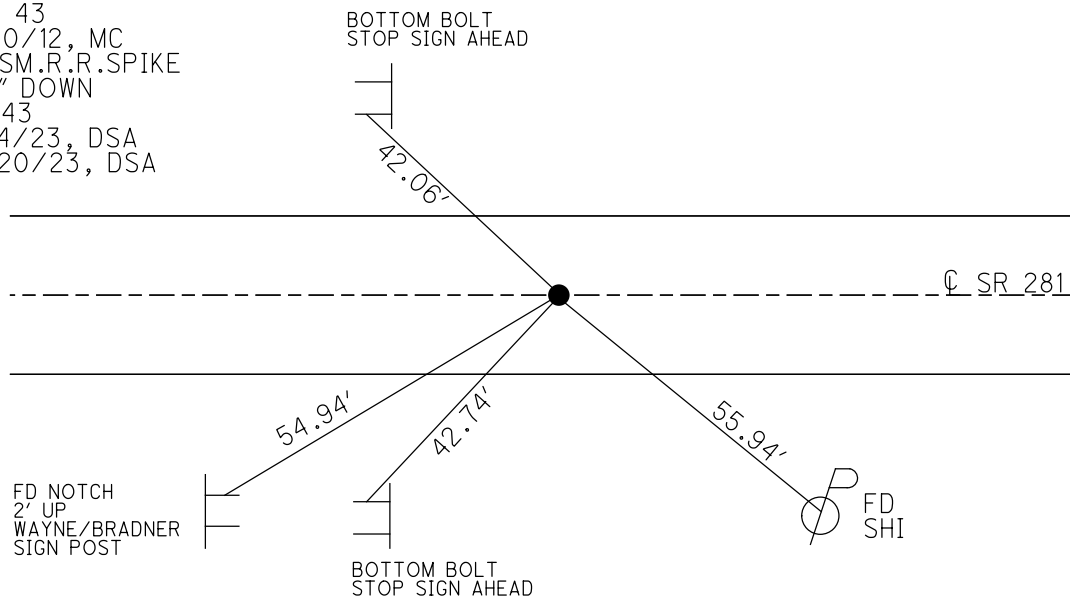

O.D.O.T. DISTRICT 2 SURVEY OFFICE (USE ONLY)

PERSONNEL

REFERENCE NO. 43

SHEET 2 OF 49

NOTES HUSS

DATE 3/19/12

ROUTE SR 281

H.C. CANTERBURY

WEATHER CLEAR

COUNTY WOOD

R.C. HUSS

TEMP. 66°

TOWNSHIP MONTGOMERY

SECTION 29

T 4 N R 12 E

TYPE MONUMENT P.K./WASHER


~~ON SURFACE~~ - BELOW 0.15'

LEFT - Q PAV'T - RIGHT ON

9.7' TO RT EDGE PAVEMENT

S.L.M. 1038+05


Grid: Northing: 590305.275 Easting: 1692072.117

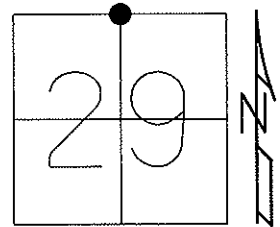

SET PK/WASHER
9/9/91, MB

FD PK/SHANK 7/6/10
SV 43, P.K.F. 11/2/10
SET N/SHI 7/24/12

FINAL GPS, REF 43
7/30/12

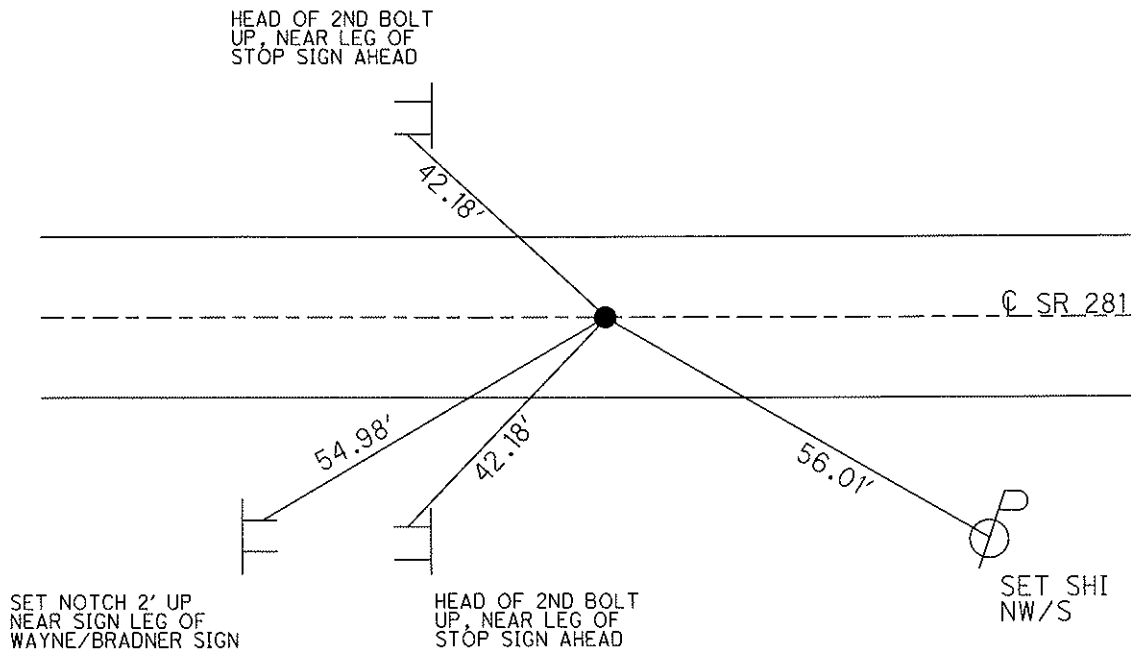

O.D.O.T. DISTRICT 2 SURVEY OFFICE

PERSONNEL

REFERENCE NO. 43

SHEET OF

NOTES BAERHAISEL

H.C. VAN DUSEN

R.C. KUSZ

DATE 7-18-91

WEATHER CLEAR

TEMP. +80°

ROUTE 281

COUNTY WOOD

TOWNSHIP MONTGOMERY

SECTION 29

T 4 N R 12 E


TYPE MONUMENT P.K. & Washer

ON SURFACE - ~~BELOW~~ YES


LEFT - & PAV'T. - RIGHT 0.4

10.9 TO RT EDGE PAVEMENT

S.L.M. 1038+05

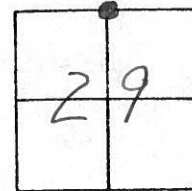

SET P.K. & Washer
 9-9-91
 MB

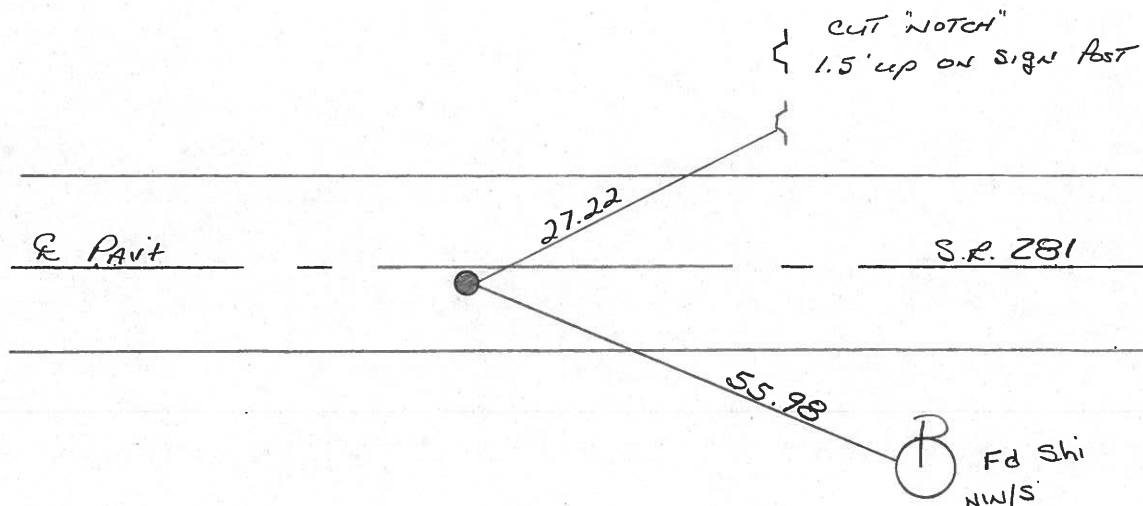

ODOT. DISTRICT 2 SURVEY OFFICE

SHEET _____ OF _____

County Wood S.R. 281

Township MONTGOMERY

Section 29

T4N, R12E

Personnel HOFFMAN

KOEHRE


BARNHISEL

#43

Date 12 - 12 - 83

Weather OVERCAST

Temp. +40°

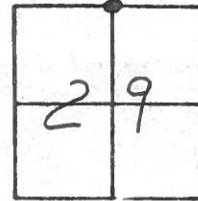

Fd P.P. SPK @ SURFACE

S.L.M. 1038+05

0.6' RT of & PAUT


9.5' TO RT. EP

10.4' TO LT. EP

SET P.K./WASHER

8/15/84

S.W.H.

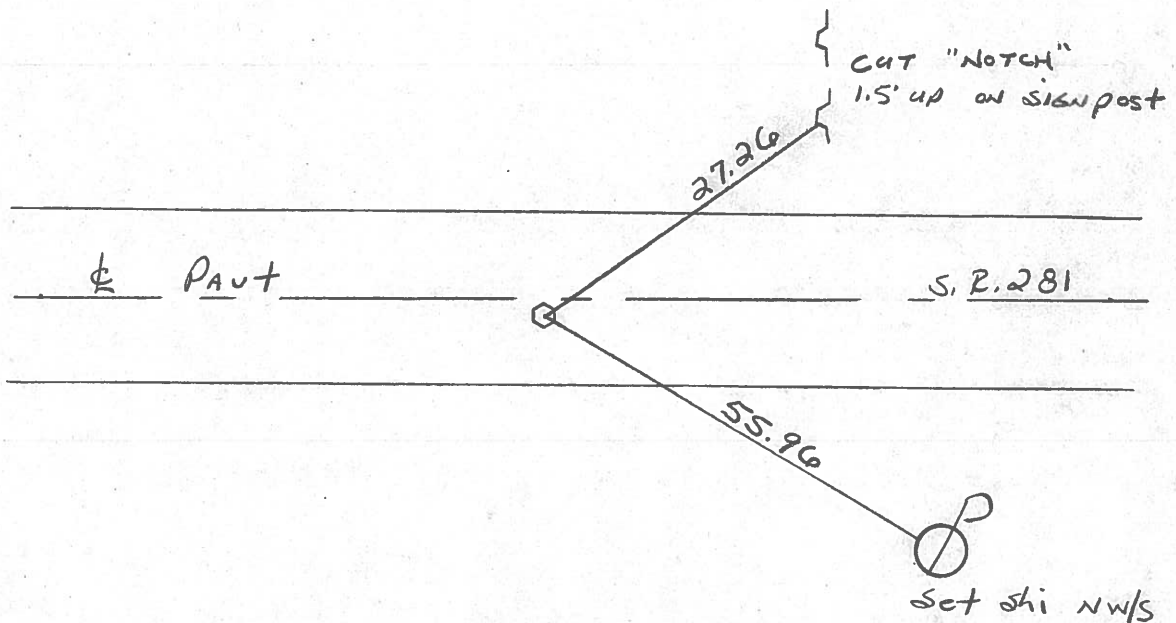

PERSONNEL TITLE PERSONNEL TITLE

COUNTY WOOD

DATE OK-8-11-69

S. R. #281

WEATHER

SEC. 29

TEMP.

DESCRIPTION

LEFT

CENTER LINE

RIGHT

JOB NO.

N. 1/4 Post SEC. 29
MONTGOMERY Twp.
FD. I. PIN - SET R.R. Spk.

#43

SHINER IN P. POLE S.E. 55.9
SHINER IN T. POLE N.W. 30.56
NEAR EDGE SIGN POST S.S.E. 18.4
NEAR EDGE SIGN POST N.N.E. 17.48
12-12-83 overcast +40°

E102

Fd 22.96 surface

RTCP 9.5

LTCP 10.4

0.6 RT &

cut hole

1.5 up

27.26

55.96

1038 + 05

N.W. COR. SEC. 29
MONTGOMERY Twp.
STONE - R.R. Spk.

#42

DID NOT DIG

DID NOT TRY TO LOCATE
DO NOT WANT TO DIG good part.
PORTAGE VIEW ROAD

E181

~~SHINER IN T. POLE N. 28.9~~
FD SHINER IN P. POLE S.W. 47.58
~~SHINER IN T. POLE S.E. 71.10~~

SHEET NO. 21

PERSONNEL TITLE PERSONNEL TITLE

COUNTY Wood

DATE OK-8-11-69

S. R. #281

WEATHER

SEC. 29

TEMP.

DESCRIPTION

LEFT

CENTER LINE

RIGHT

JOB NO.

N. 1/4 Post SEC. 29
 MONTGOMERY Twp.
 FO. I. PIN - SET R.R. Spk.

#43

SHINER IN P. POLE S.E. 55.90
 SHINER IN T. POLE N.W. 30.56
 NEAR EDGE SIGN POST S.S.E. 18.47
 NEAR EDGE SIGN POST N.N.E. 17.48

#182



BEGIN POINT CHECK
 12-83 BY S.W.H.

N.W. COR. SEC. 29
 MONTGOMERY Twp.
 STONE - R.R. Spk.

#42

SHINER IN T. POLE N. 28.95
 SHINER IN P. POLE S.W. 47.50
 SHINER IN T. POLE S.S.E. 71.10

PORTAGE VIEW ROAD

#181

PERSONNEL TITLE PERSONNEL TITLE

COUNTY Wood

DATE OK 12-5-57

Sworden 3-29-60

S. R. #281

WEATHER 8-24-62

Morse 11-1-62

SEC.

TEMP. Worden 2-10-64

DESCRIPTION

LEFT

CENTER LINE

RIGHT

JOB NO.

N.W. cor. sec. 29 Montgomery
Twp. Stone - R.R. spike set
Portage View Road.

OK ✓

Shiner in T.P. N. 28.75' 12.32
~~Shiner in Br. P. S.E.~~ 38.6
Shiner in P.P. S.W. 47.58' 41.9
Shiner in T.P. S.E. 71.14

(42)

#181

N/4 post sec. 29 Montgomery
Twp. Found iron pin - set small
for corner.

R.R. spike

OK ✓

Shiner in P.P. S.E. 55.9
Shiner in T.P. N.W. 30.58' 30.8
~~Shiner in 24" stump S. gone~~ 40.2
~~Shiner in 40" oak S.~~ 44.2
" " old stump S. 41.22

(43)

#182

Approximately .35 N.E.
from Angle cor. sec. 20
T-4-N R-12-E. iron pipe set
set R.R. spike

OK ✓

N.E. cor. house And. N.W. 76.3
S.E. cor. house fdn. N.W. 72.2
~~N.E. to shiner in butternut tree~~
(gone) 28.6
S. W. To shiner in P. Pole 57.7
N.E. To shiner int. Pole 30.3
Shiner in 12" Maple N. 76.35

(45)

#184

1013.83 E. of N/4 post
sec. 29 T-4-N R-12-E
set R.R. spike

OK ✓

Shiner in fence post S.E. 28.
Shiner in 2nd post S. of cor.
Post S.W. 78.3
Shiner in 3rd post S. of cor. post
S.E. 48.16' 18.6

(44)

#183

Shiner in T.P. N.W. 46.77' 46.7
Shiner int. P. N.E. 65.70' 65.7
Shiner in T.P. S.E. 39.9