

O.D.O.T. DISTRICT 2 SURVEY OFFICE (USE ONLY)

PERSONNEL

REFERENCE NO. 2

SHEET 2 OF 25

NOTES MILLER
H.C. MILLER
R.C. BARRIERE
BLUBAUGH

DATE 8/6/24
WEATHER CLOUDY
TEMP. 75°

ROUTE SR 582
COUNTY WOOD
TOWNSHIP MIDDLETON
SECTION 20
T 6 N R 10 E

DWG BY BARRIERE PID 114849

TYPE MONUMENT 1 3/4" IRON PIPE

ON SURFACE - ~~BELOW~~ 4" BELOW

OFFSET Q PAVEMENT 20' LT : ~~RT~~

13.0' TO LT EDGE PAVEMENT

STATION: 04+34

HORIZ.DATUM: NAD83 (2011)


GEOID: 18

GRID: NORTHING: 656735.960


EASTING: 1626786.944

LDP: NORTHING: 478239.680

EASTING: 137512.548

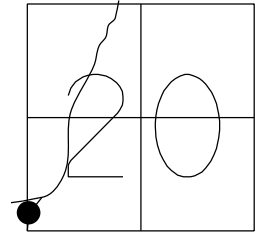

RECORD:
FD STONE WITH 1" IRON PIPE
21' ± EAST OF Q SR 582
433' ± S. OF INTER. OF SR 65
GPS, REF2
4/8/14, TMR
NOT COVERED
7/25/14, EBW
FD 1 3/4" IPIPE 4" DOWN
REF2
12/7/23, JAM
8/6/24, JAM

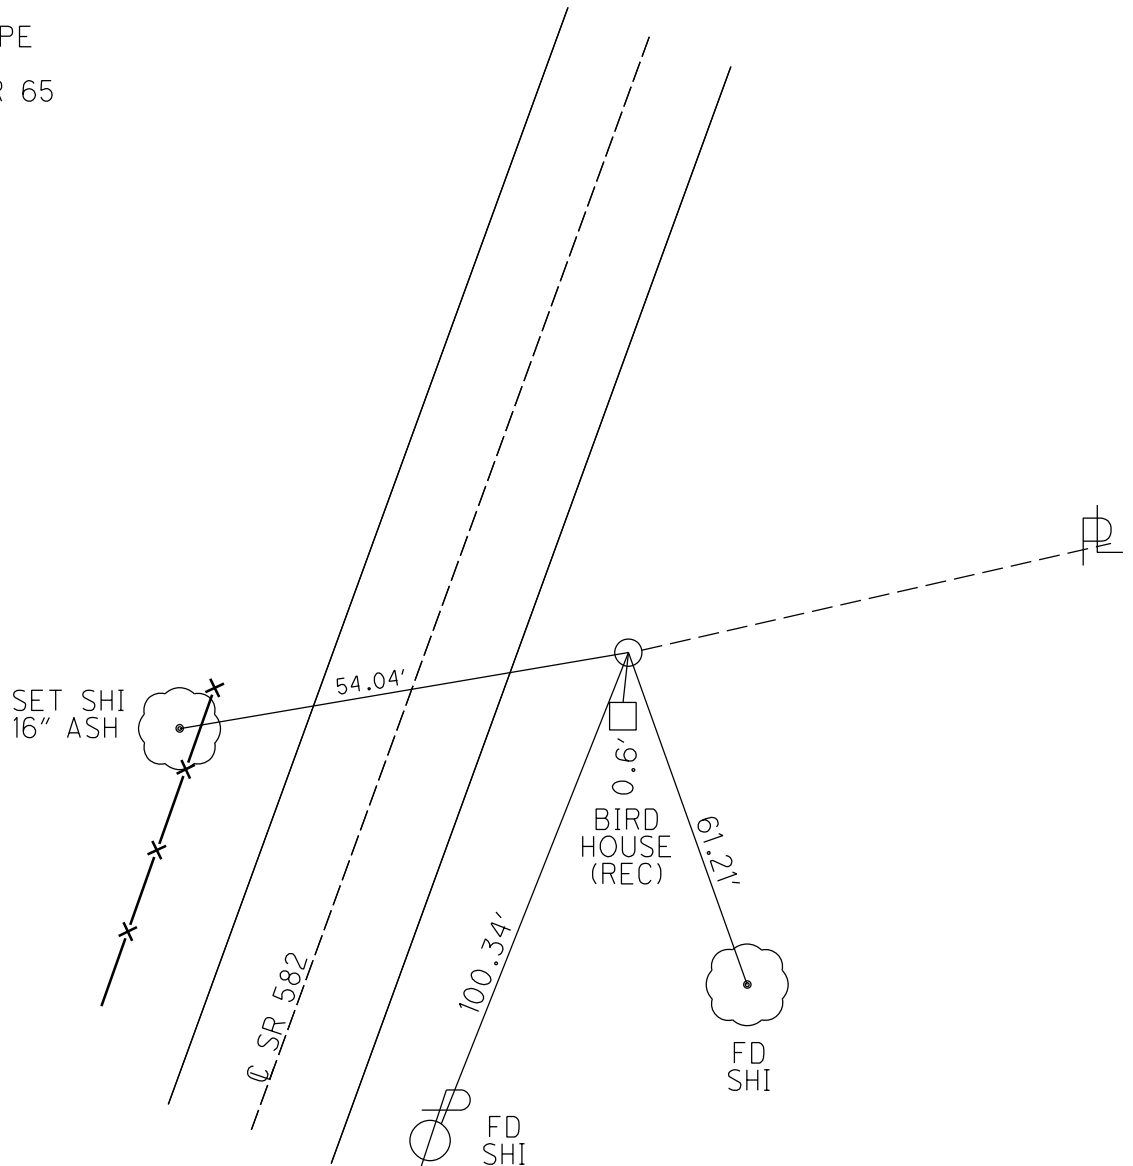

O.D.O.T. DISTRICT 2 SURVEY OFFICE (USE ONLY)

PERSONNEL

REFERENCE NO.

2

SHEET

2

OF

25

NOTES RHOADES

DATE 4/8/14

ROUTE SR 582

H.C. ROUSOS

WEATHER FAIR

COUNTY WOOD

R.C. RHOADES

TEMP. 44°

TOWNSHIP MIDDLETON

SECTION 20

T 6 N R 10 E

TYPE MONUMENT 1" IRON PIPE


~~ON SURFACE~~ - BELOW 4", BENT TO NORTH

LEFT - Q PAV'T - ~~RIGHT~~ 20'

13.0' TO LT EDGE PAVEMENT

S.L.M. 4+34

Grid: Northing: 656735.960 Easting: 1626786.944

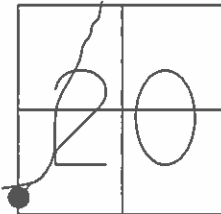

RECORD:

FD STONE WITH 1" IRON PIPE

21' ± EAST OF Q SR 582


433' ± S. OF INTER. OF SR 65

GPS, REF2

4/8/14, TMR

NOT COVERED

7/25/14, EBW

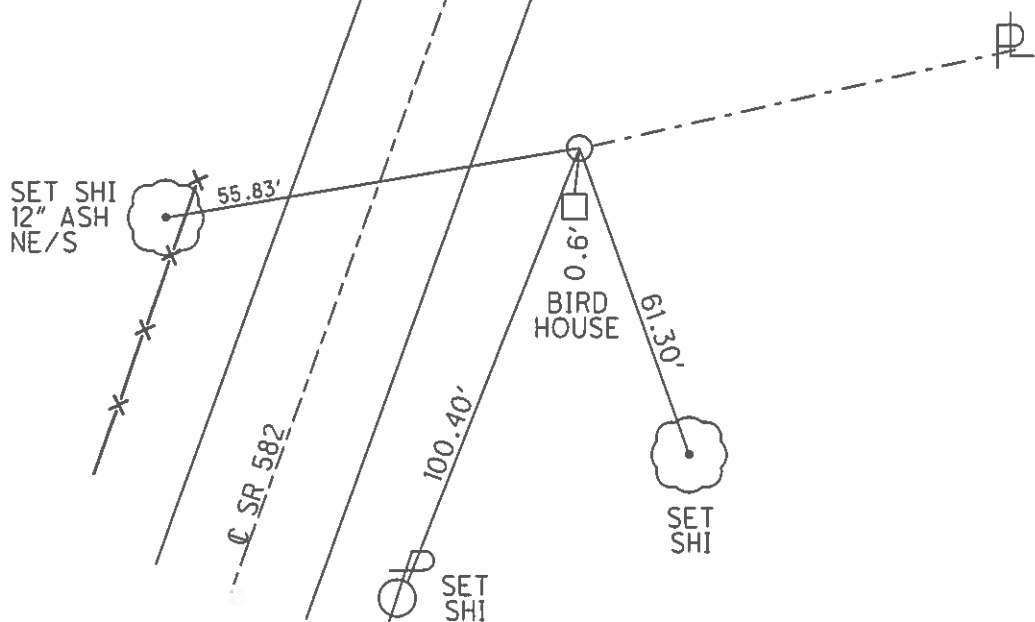

O.D.O.T. DISTRICT 2 SURVEY OFFICE

PERSONNEL

REFERENCE NO. 2

SHEET OF

NOTES BARNHISEL

H.C. Hoffman

R.C. Loehrke

GRAMZA

DATE 3-26-86

WEATHER cloudy

TEMP. +65°

ROUTE 582

COUNTY Wood

TOWNSHIP Middleton

SECTION 20

T6 N R 10 E


TYPE MONUMENT 1" IRON PIPE

~~ON~~ SURFACE - BELOW 4" Bent to North

LEFT- & PAV'T. - RIGHT 20.0

13.0 TO Lt EDGE PAVEMENT

S.L.M. 4+34

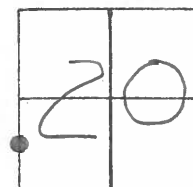


Record


FD Stone with 1" Iron Pipe

21' ± East of & 582


433 ± S of Intersection

SE 45°

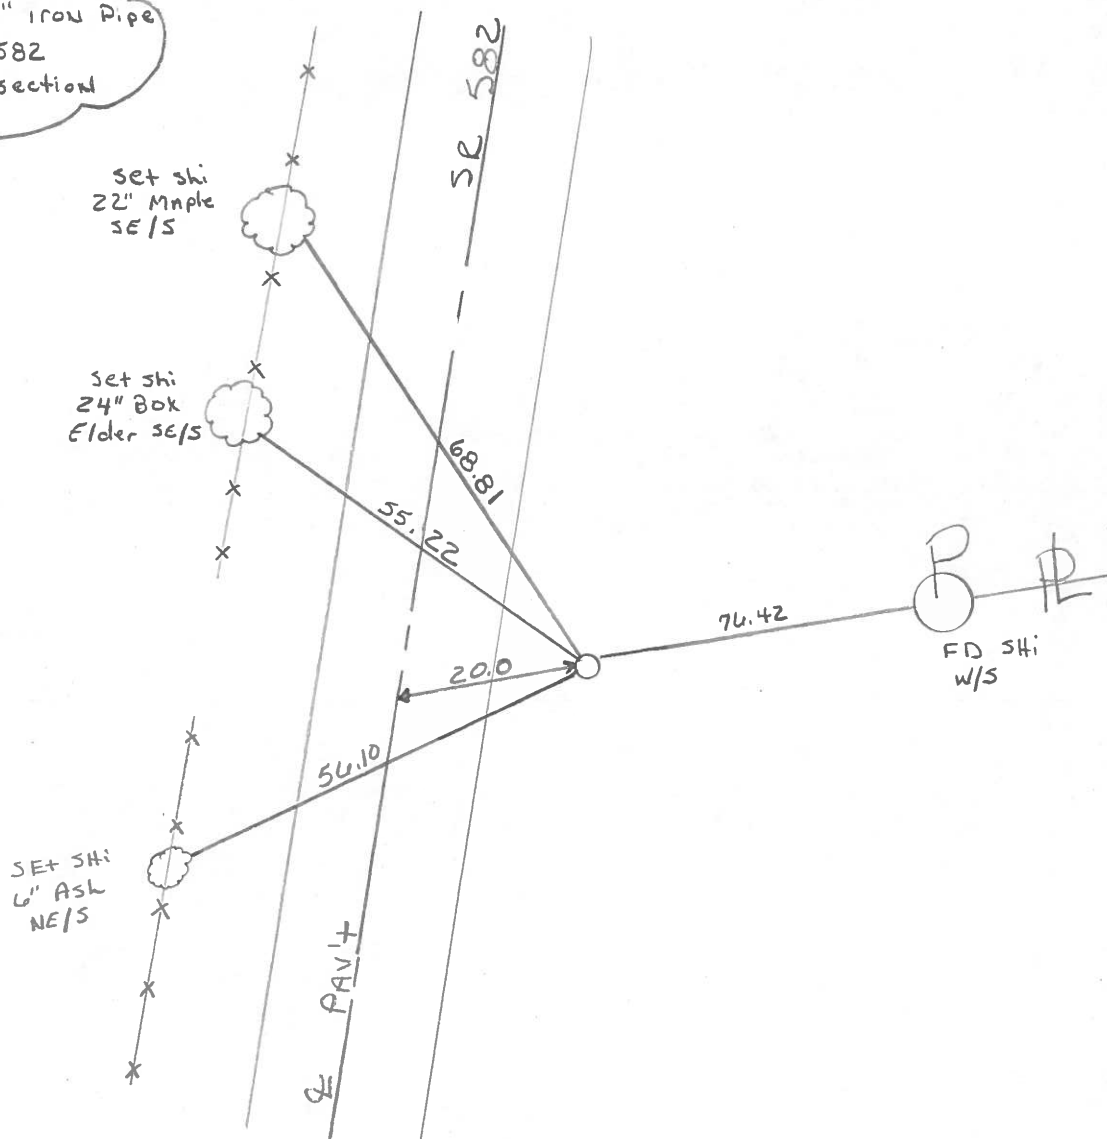

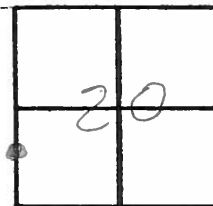
County Wood S.R. 582Date 5-10-1979Township MiddletonWeather Partly CloudySection 20Temp. 82°T6N, R10EPersonnel SmithKnapeBowersMead

(2)

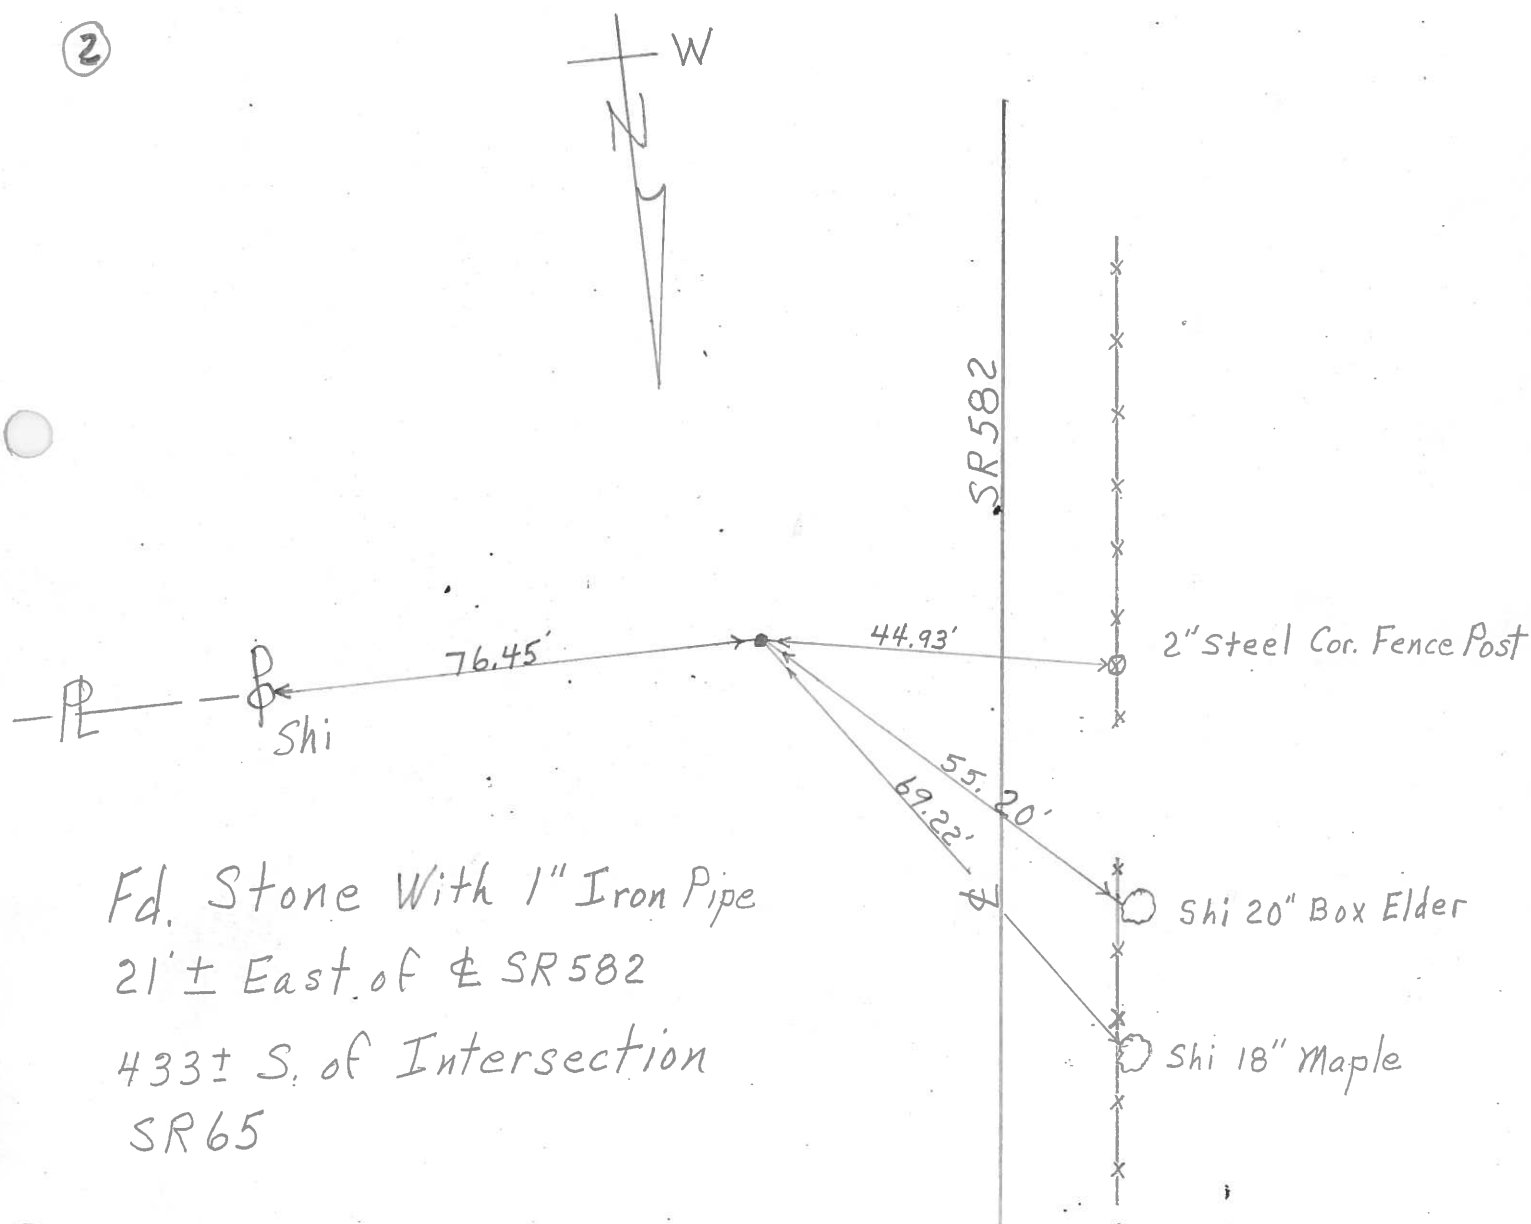

PERSONNEL	TITLE	PERSONNEL	TITLE	COUNTY	DATE	WEATHER	TEMP.
BURNSIDE				WOOD	5-25-71	LT. Rain	+60°
SMITH				S. R. 582			
BOWERS				SEC.			
HOLCOMBE							

DESCRIPTION	LEFT	CENTER LINE	RIGHT	JOB NO.
-------------	------	-------------	-------	---------

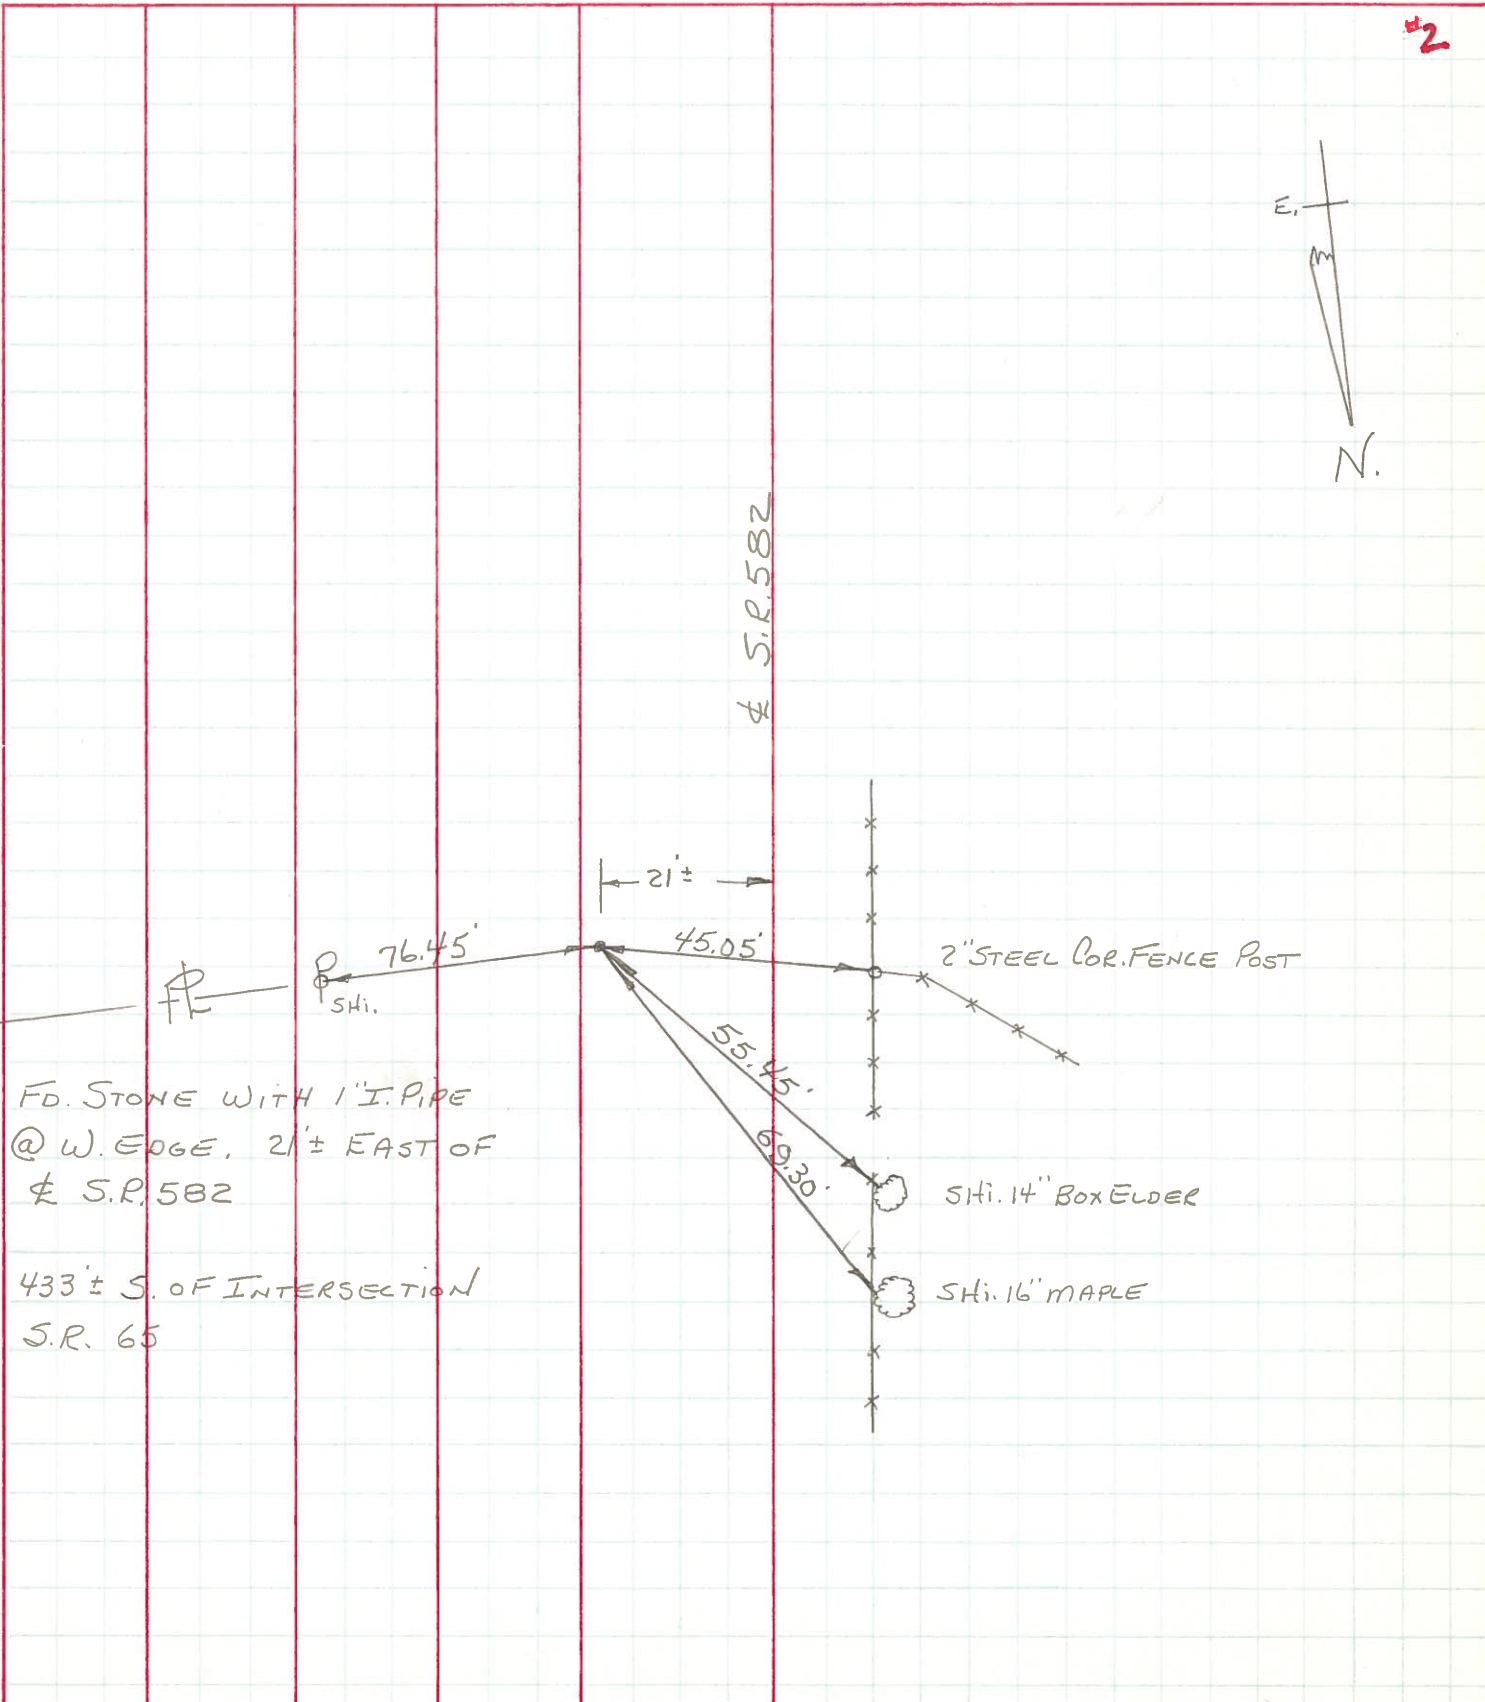

PERSONNEL	TITLE	PERSONNEL	TITLE

COUNTY Wood DATE 12-27-57
Sworden 4-4-60
 S. R. #582 WEATHER _____
 SEC. A, B, C, D TEMP. _____

DESCRIPTION LEFT CENTER LINE RIGHT JOB NO.

433' S. of intersection of
 S.H. 984 & S.H. 53.
 Stone, mon. 25.7' E. of
 center of road. **2**

#431

Shiner in 30' Elm S. 6.9'
 Steel Cor. post W. 44.97'
 Shiner in cor. post E. 21.2'
 (New) Shiner in P.P. E. 76.59'

Stone, 3' of 2" pipe on top.
 S.R. 582 & Tontogany Ck. Rd.

#432

3

O.K.

Conc. marker N. & 1.0' W. 23.30'
 S.W. Cor. S.W. Wing S.E. 23.57'
 S. Cor. E. end N. Hdwl. N.E. 31.25'
 Cor. of N. conc. wall E. of N. 32.60'
 Shiner P. Pole W. 28.25'

Steel rod set at S. edge of
 E. & W. pav't.
 Frost Rd.

#434

O.K.

Telephone Pole S of E. 10.57'
 Shiner in P.P. N.W. 34.45'
 Brace pole W. of South 27.8'
 P.P. N.E. 79.80'

S.R. #582 & Green Rd.
 Fd. Iron Pin
 Co. 1963 - Set R.R. spk.

#435

S.E. To N.W. Cor. E. Wing 13.08'
 S.W. To N.E. Cor. N. Wing 14.00'
 Shiner 24" Elm N.S.W. 80.64'
 Shiner in Tele Pole E.S.E. 80.55'
 N.W. Cor. E. Conc. Hdwl. S.E. 18.04'
 N.E. Cor. W. " " S.W. 11.36'
 1.5' N. of S. edge Pav't.

#436

on back of page